

This drawing is the property of Equilibrium Architects and copyright is reserved by them. This drawing is not to be copied or disclosed by or to any unauthorised persons without the prior written consent of Equilibrium Architects.


Do not scale from this drawing.

All dimensions are to be checked on site prior to construction, manufacture of any components and ordering of materials and equipment.


Any discrepancies are to be reported to the architect for clarification.

All materials and workmanship to be in accordance with the current British Standards and codes of practice.

This drawing is to be read in conjunction with all relevant Architectural, Structural Engineers, Mechanical Engineers, Electrical Engineers and Specialists drawings and specifications.

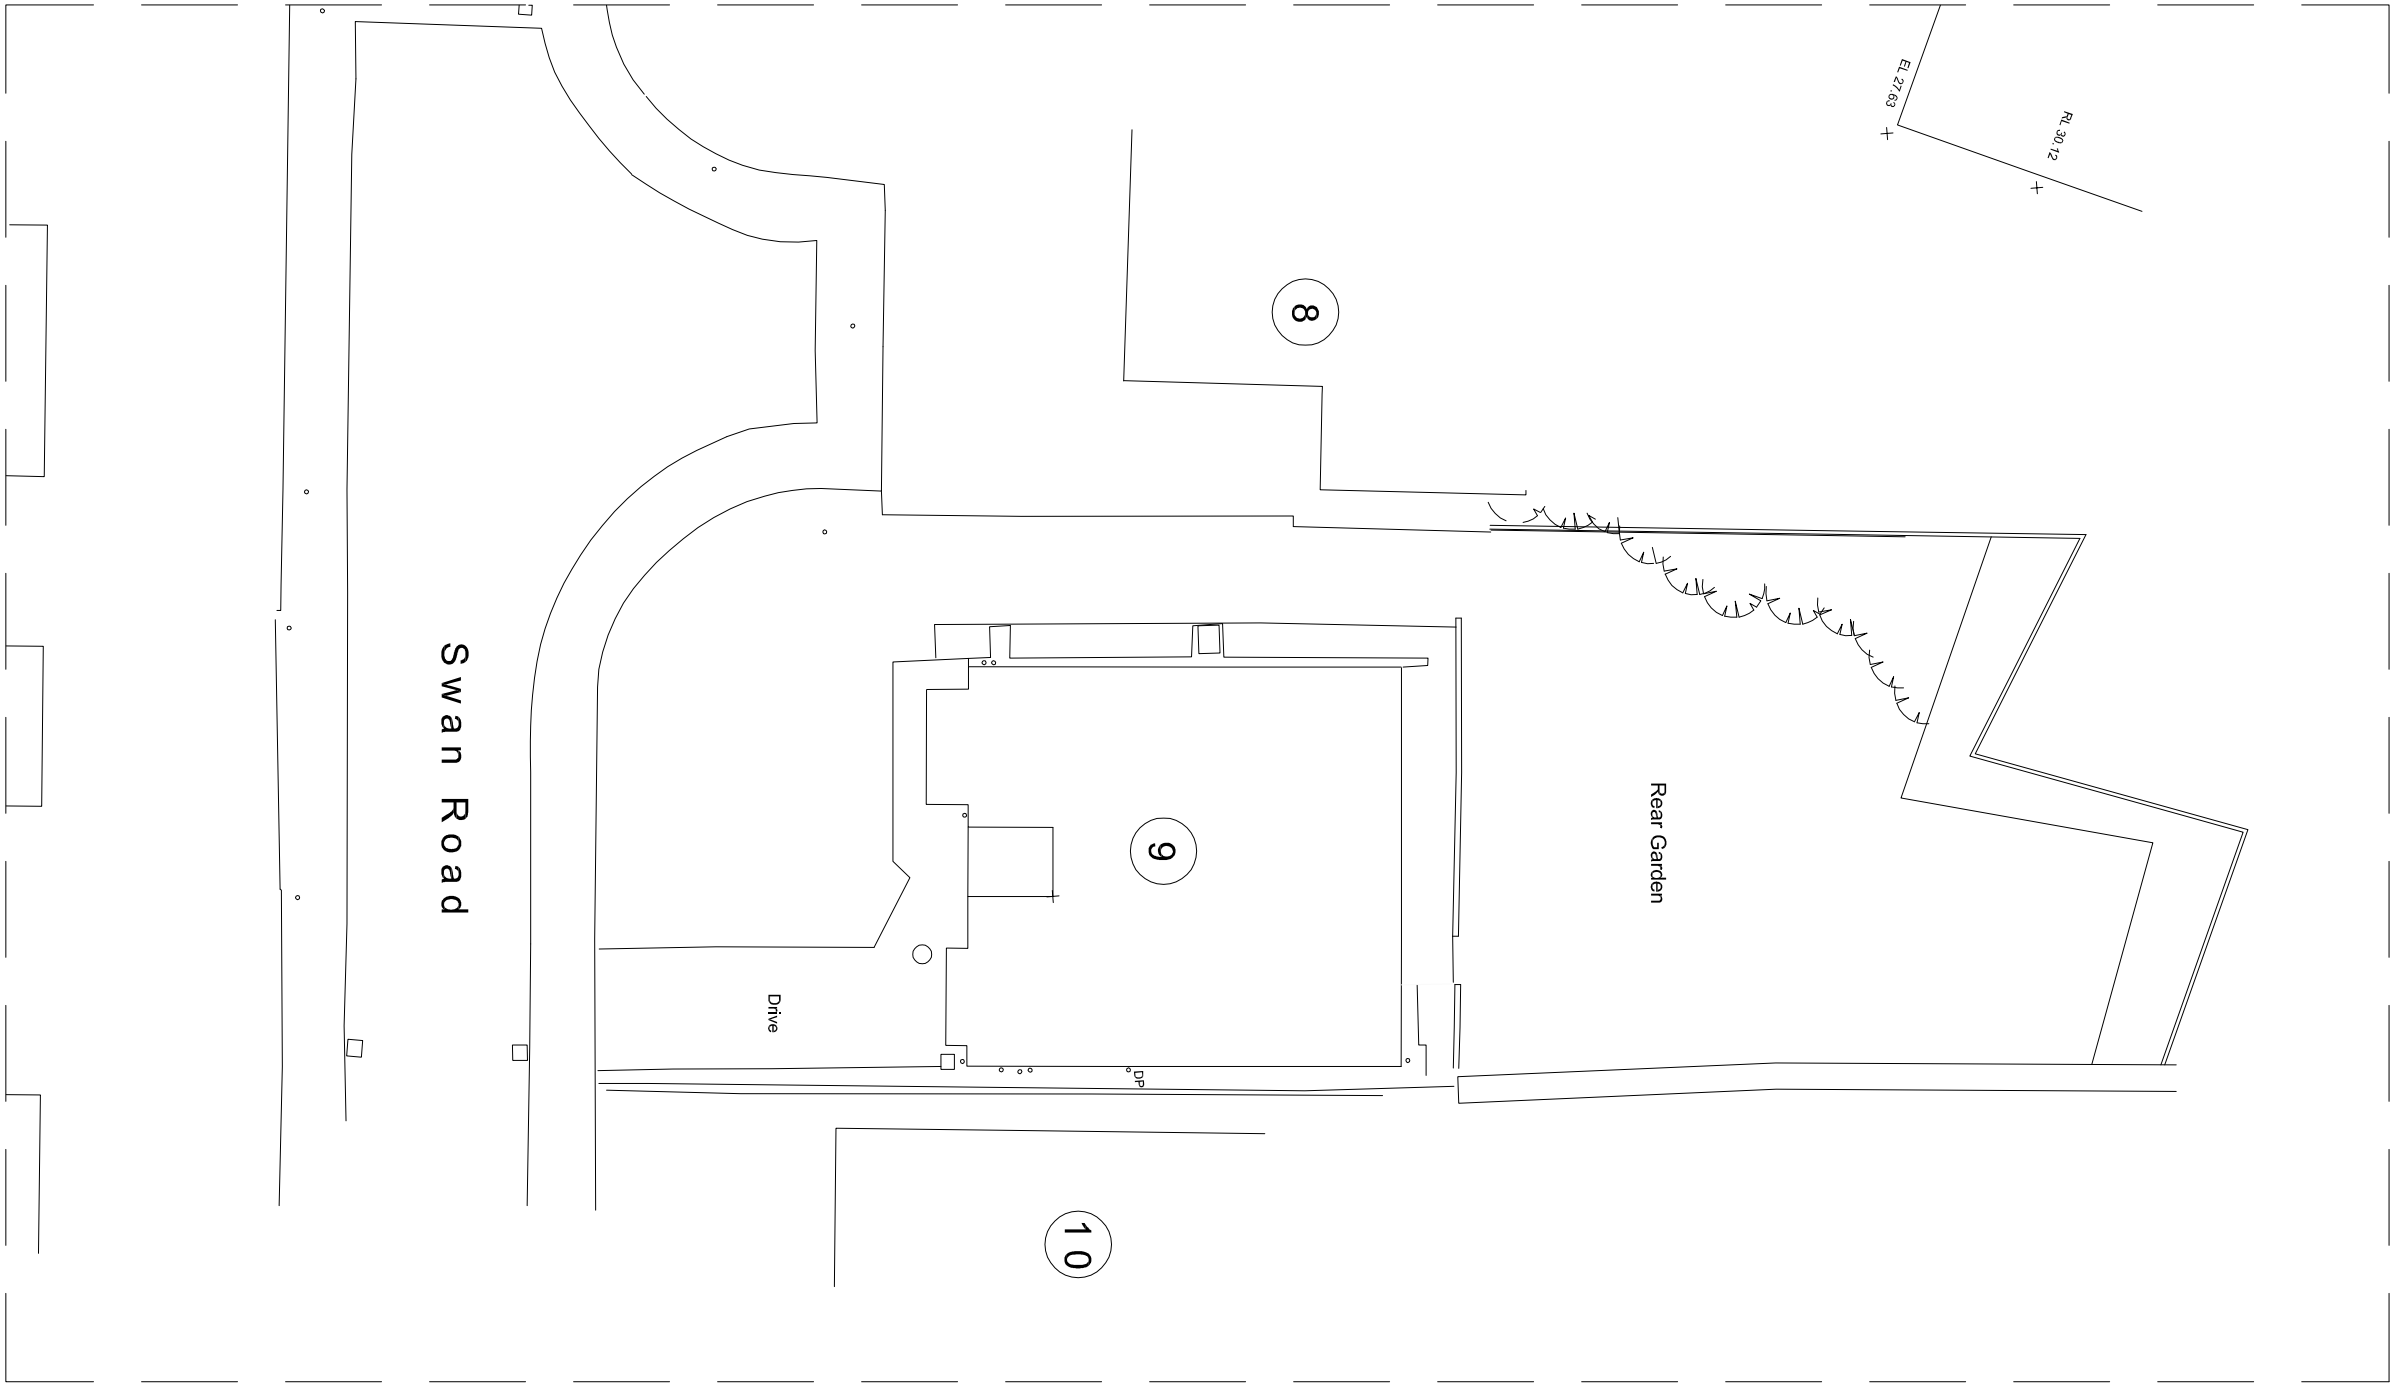

Existing Site Layout 1:200

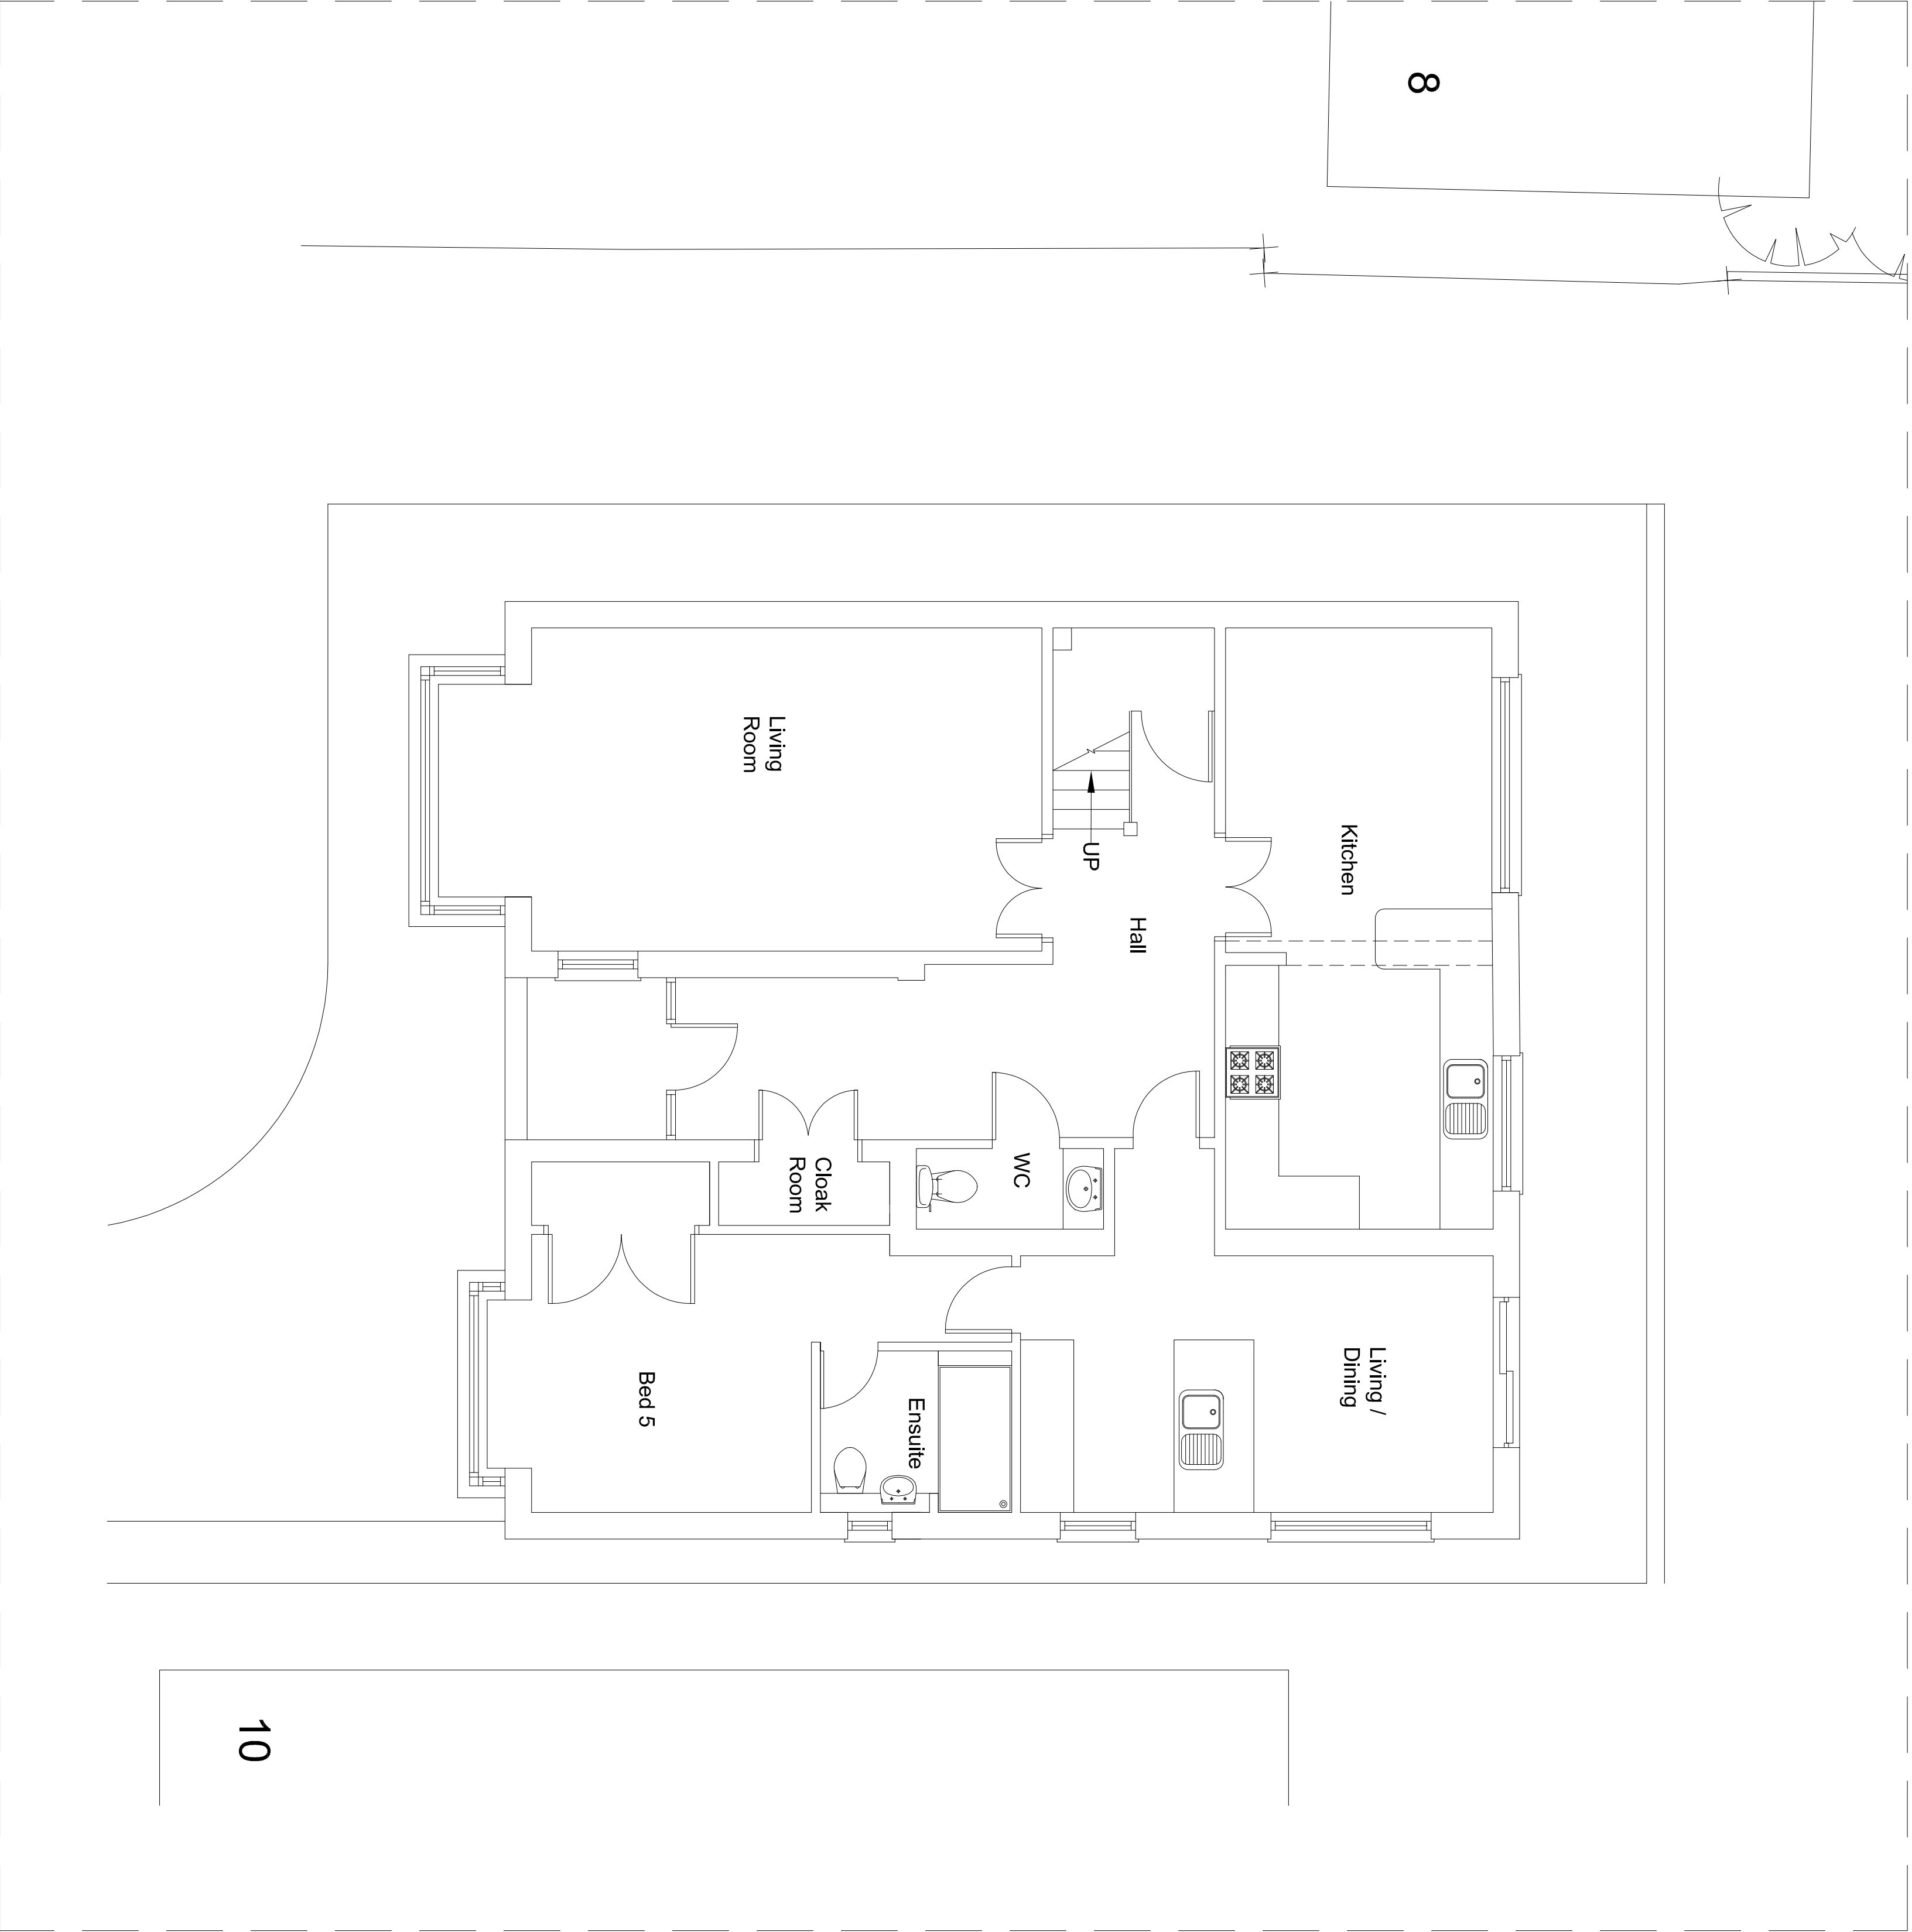

Existing Ground Floor Plan 1:50

10

A	Drawing updated	July 22
REV	DESCRIPTION	CHECK DATE

CLIENT

Mr & Mrs R Bennet

PROJECT

9 Swan Road, Greenmount, Bury, BL8 4ES

DRAWING

Existing Ground Floor Plan and Site Layout
As-Built

SCALE	DATE	DRAWN	CHECKED
A1 1:50	June 2021	LY	
DRAWING NO.	CAD REFERENCE NO.	REVISION	
R0469-09		A	