






Notes Copyright in all documents and drawings prepared by the architectural designer and any works executed from these documents and drawings shall, unless otherwise agreed, remain the property of the designer and must not be reproduced by, lent or disclosed to, a third party without the written consent of Zach Thorp.
Do not scale off this drawing
All dimensions are to be checked on site and any discrepancies to be referred to the designer before proceeding. All levels to be checked on site All discrepancies between information shown on the drawings and the information in the specification to be referred to the designer prior to proceeding. All component sizes and references to be checked before ordering
Position of existing drain runs to be confirmed prior to proceeding and drains checked as necessary. All relevant boundary positions are to be checked prior to proceeding
Building regulation drawings can be used for building estimates, however for an accurate quote builders must attend site as these drawings do not account for all aspects of the building works.

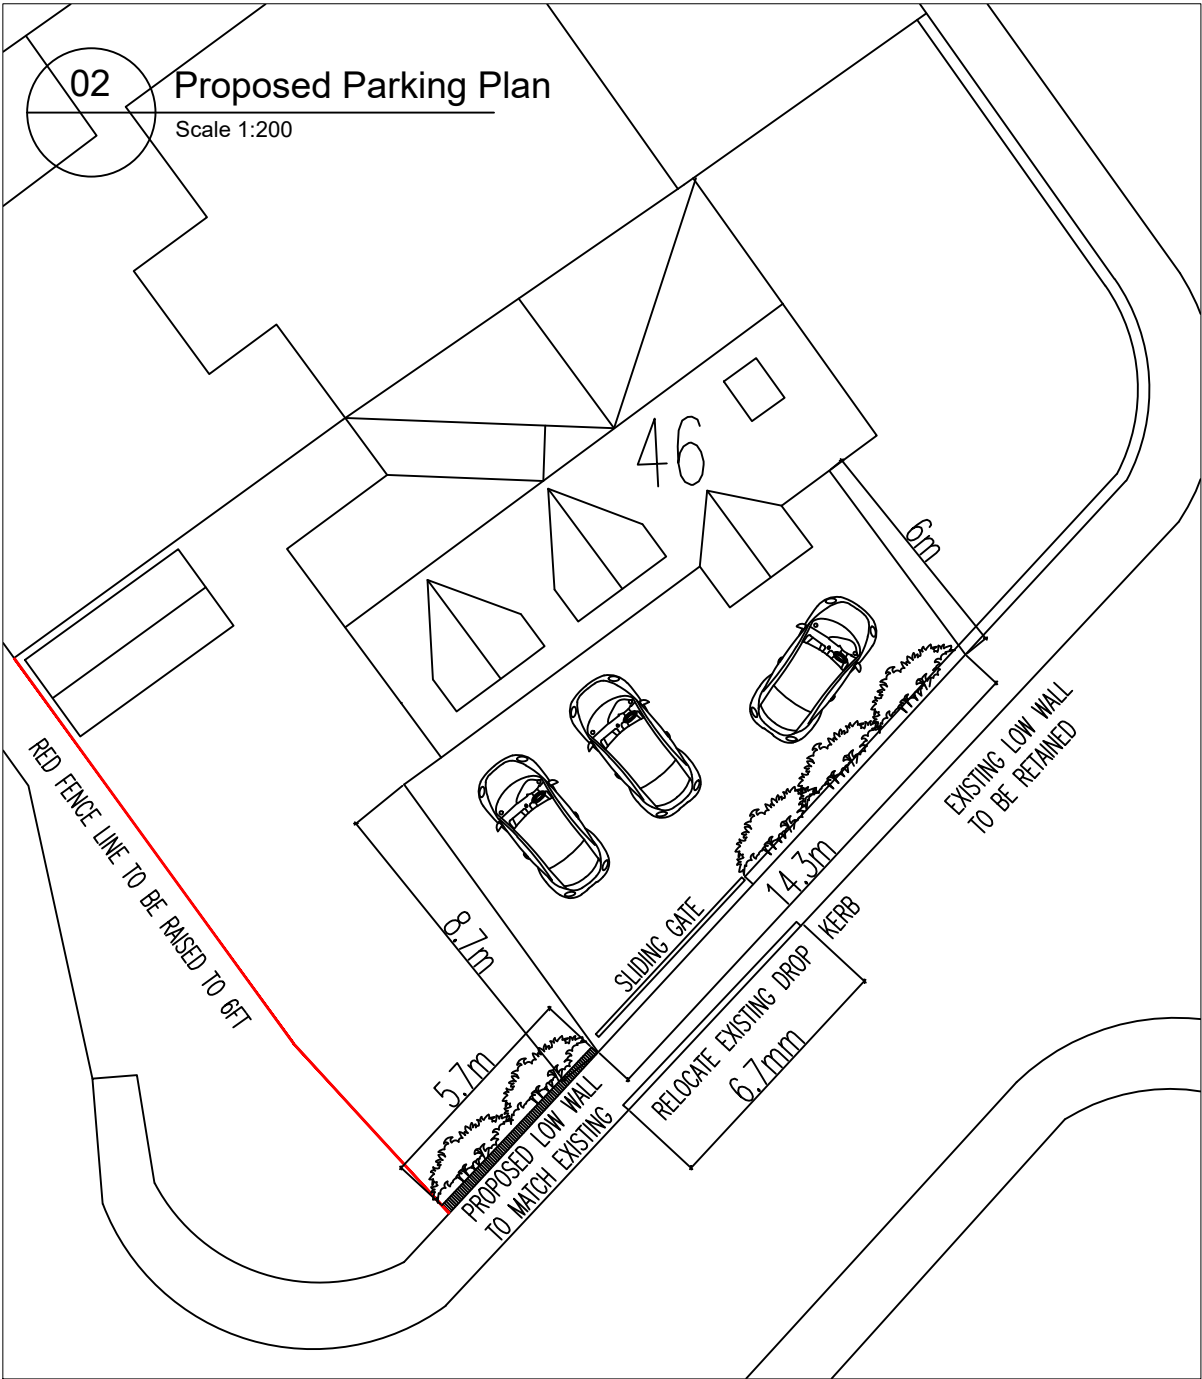

SURVEY ORIENTATED TO MAGNETIC NORTH

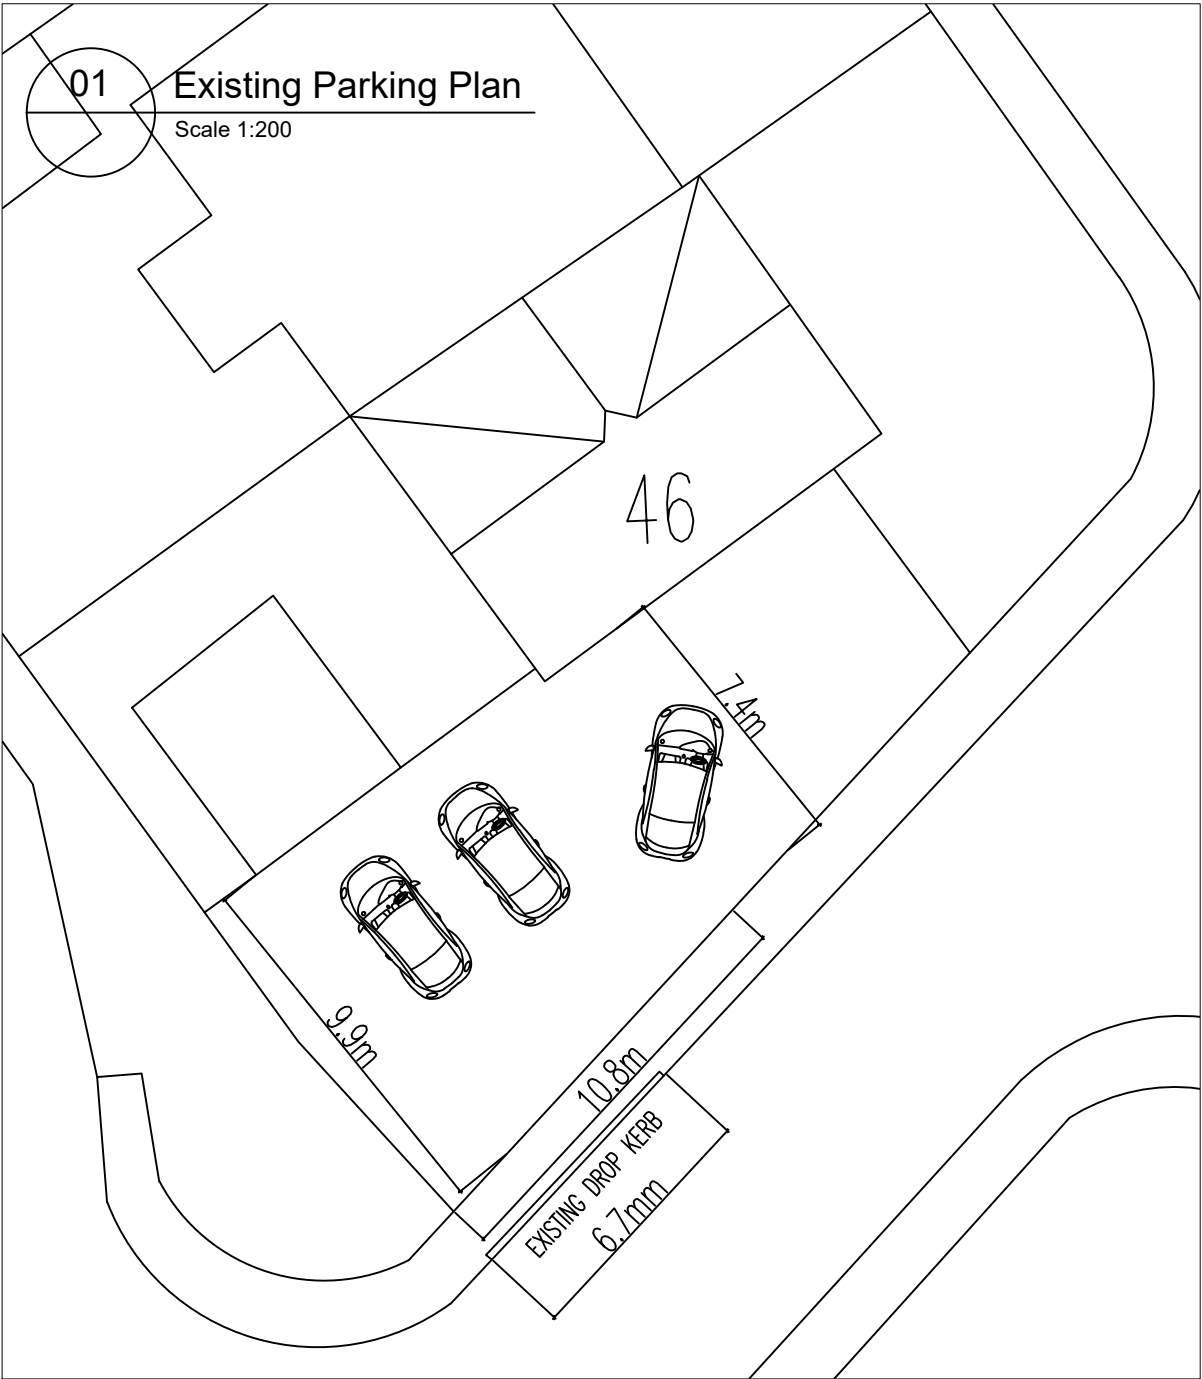


Proposed driveway gate to be similar to the attached picture, in either light wood colour, or painted grey to match the window colour

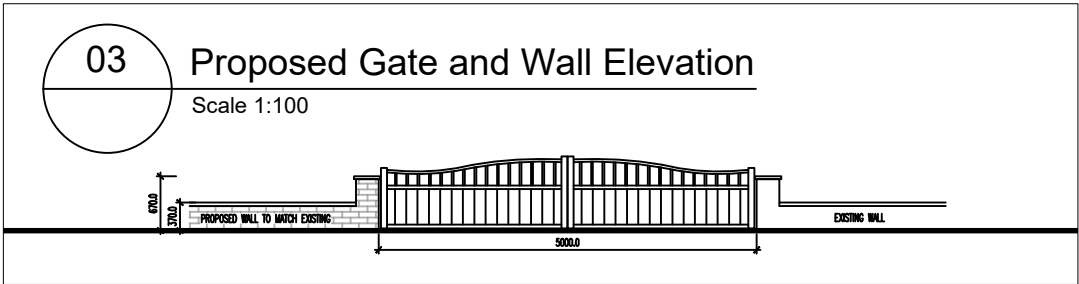

04 Side Fence Elevation

Scale 1:100

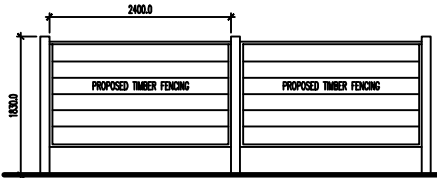

Rev	Description	Date	By	Chk
Status		Purpose for Issue		
Planning	☐ Tender	☐	PLANNING	
Construction	☒ As Built	☐		
Client				
Mr and Mrs Barnett				
46 Vernon Road, Greenmount				
Contract				
Proposed Demolition of Garage with the addition of Single Storey Side Extension, Front Porch and Loft Conversion with Front Dormers				
Drawing				
Existing and Proposed Parking Plan				
Drawing No.	ZT23-196-06	Revision	/	
Scales	1:200 @ A3	Date	June '23	
Drawn	ZTT	Checked		