


revision notes			
rev	date	by	description
01:			original issue
02:	02.10.25	lg	revised to suit inclusion of retaining walls to building D
03:	15.12.25	lg	revised to suit structural engineers foundation markup plans



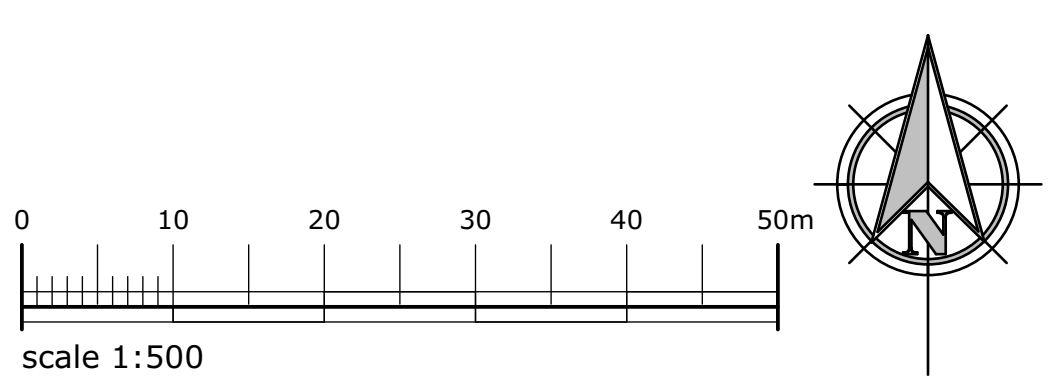

campbell driver partnership
Suite 25, Unit 2
Northlight House
Pendle Road
Brierfield
Widelson
BB9 5FL
01254 297700
www.cdparchitects.co.uk

client:	glic investments		
project:	warth industrial site warth road, bury, BL9 9TB		
sheet:	ground penetration markup		
drawing no:	24.100.01-CDP-00-DR-A-1003	P03	
scale:	1:500 @ A1	status:	WIP
date:	23.09.25	drawn by:	lg