





EXISTING EAST ELEVATION

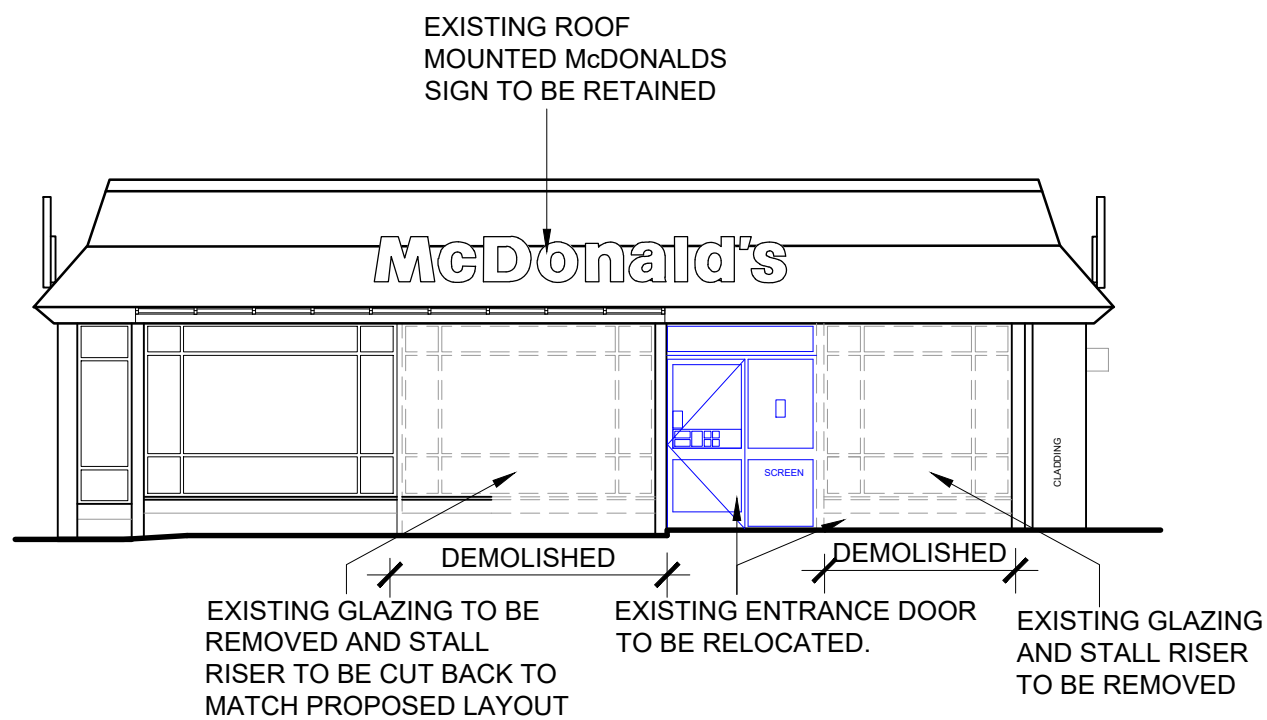


EXISTING WEST ELEVATION

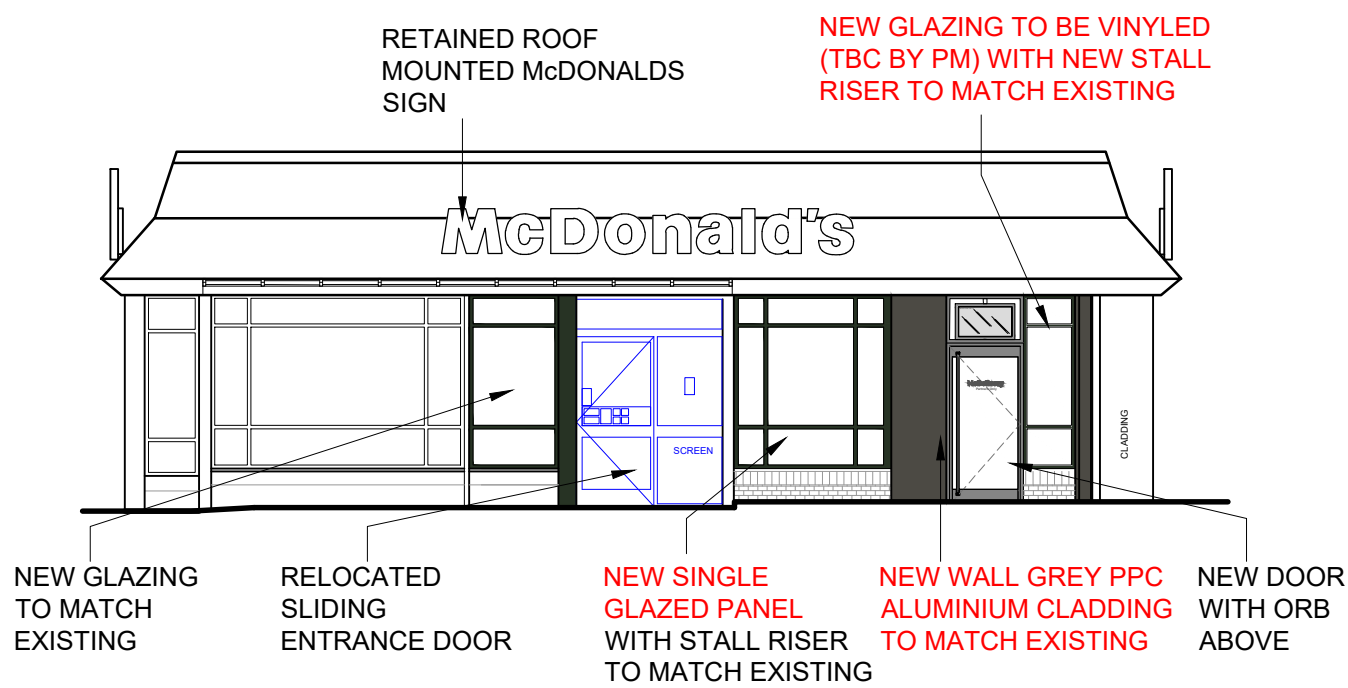

PROPOSED EAST ELEVATION




PROPOSED WEST ELEVATION

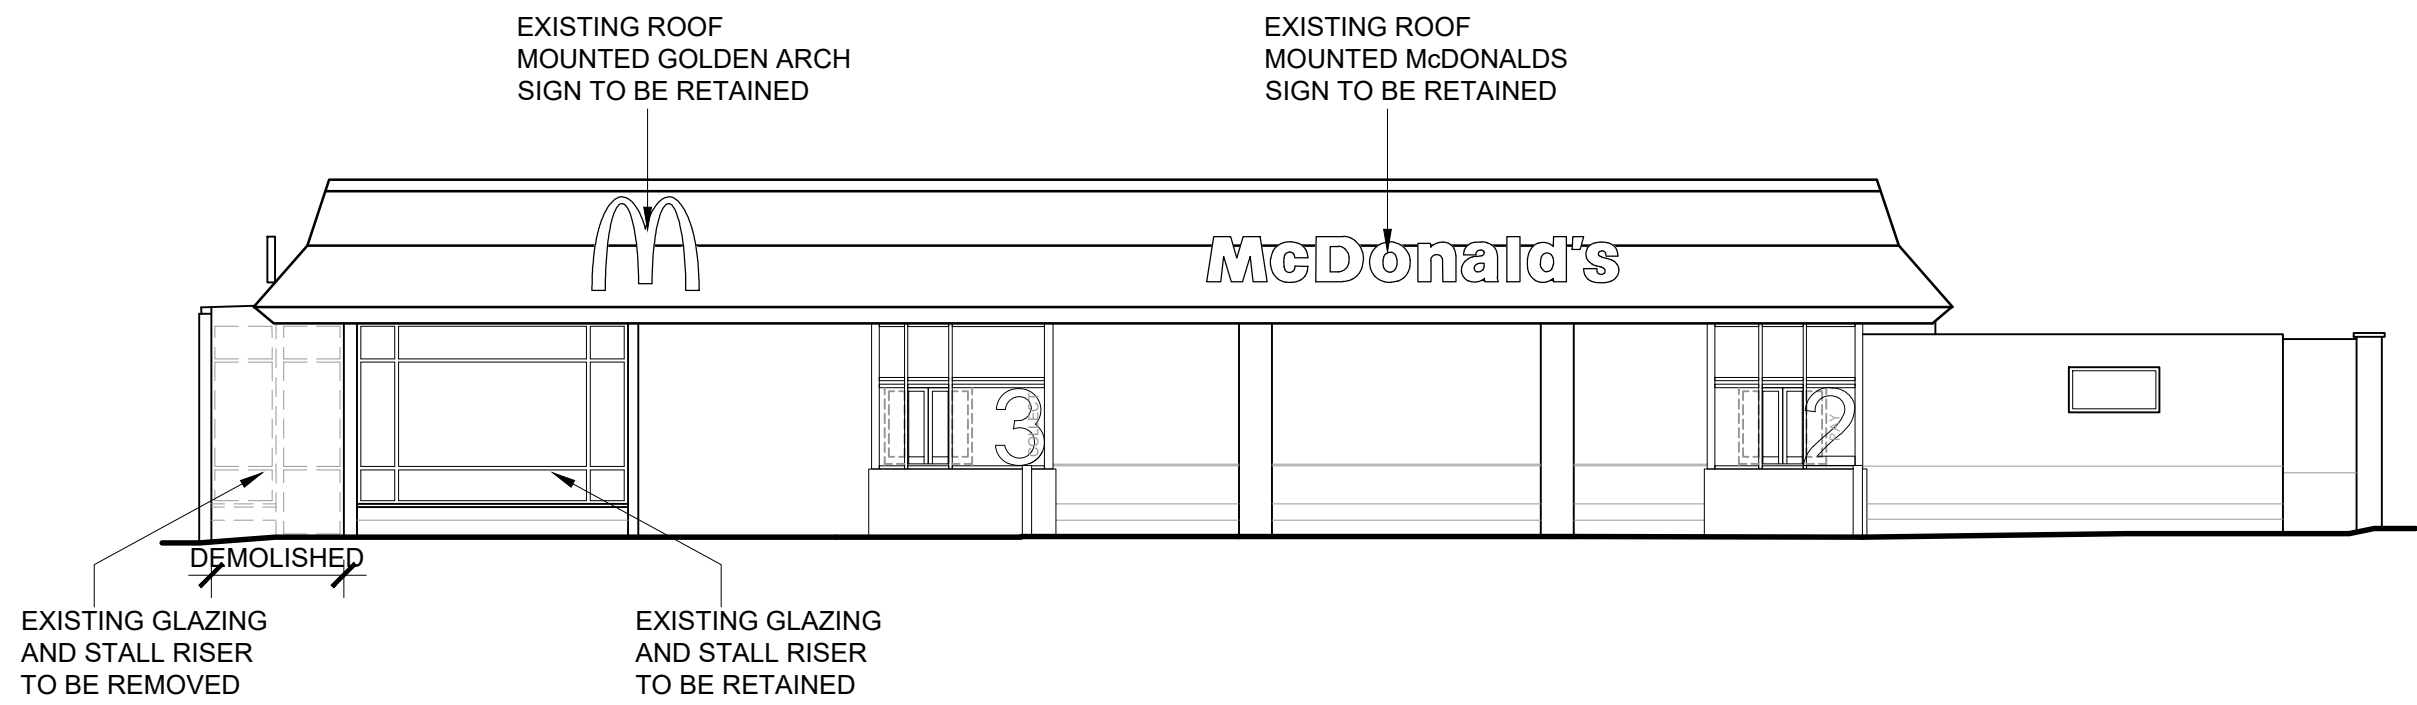

EXISTING NORTH ELEVATION



EXISTING SOUTH ELEVATION

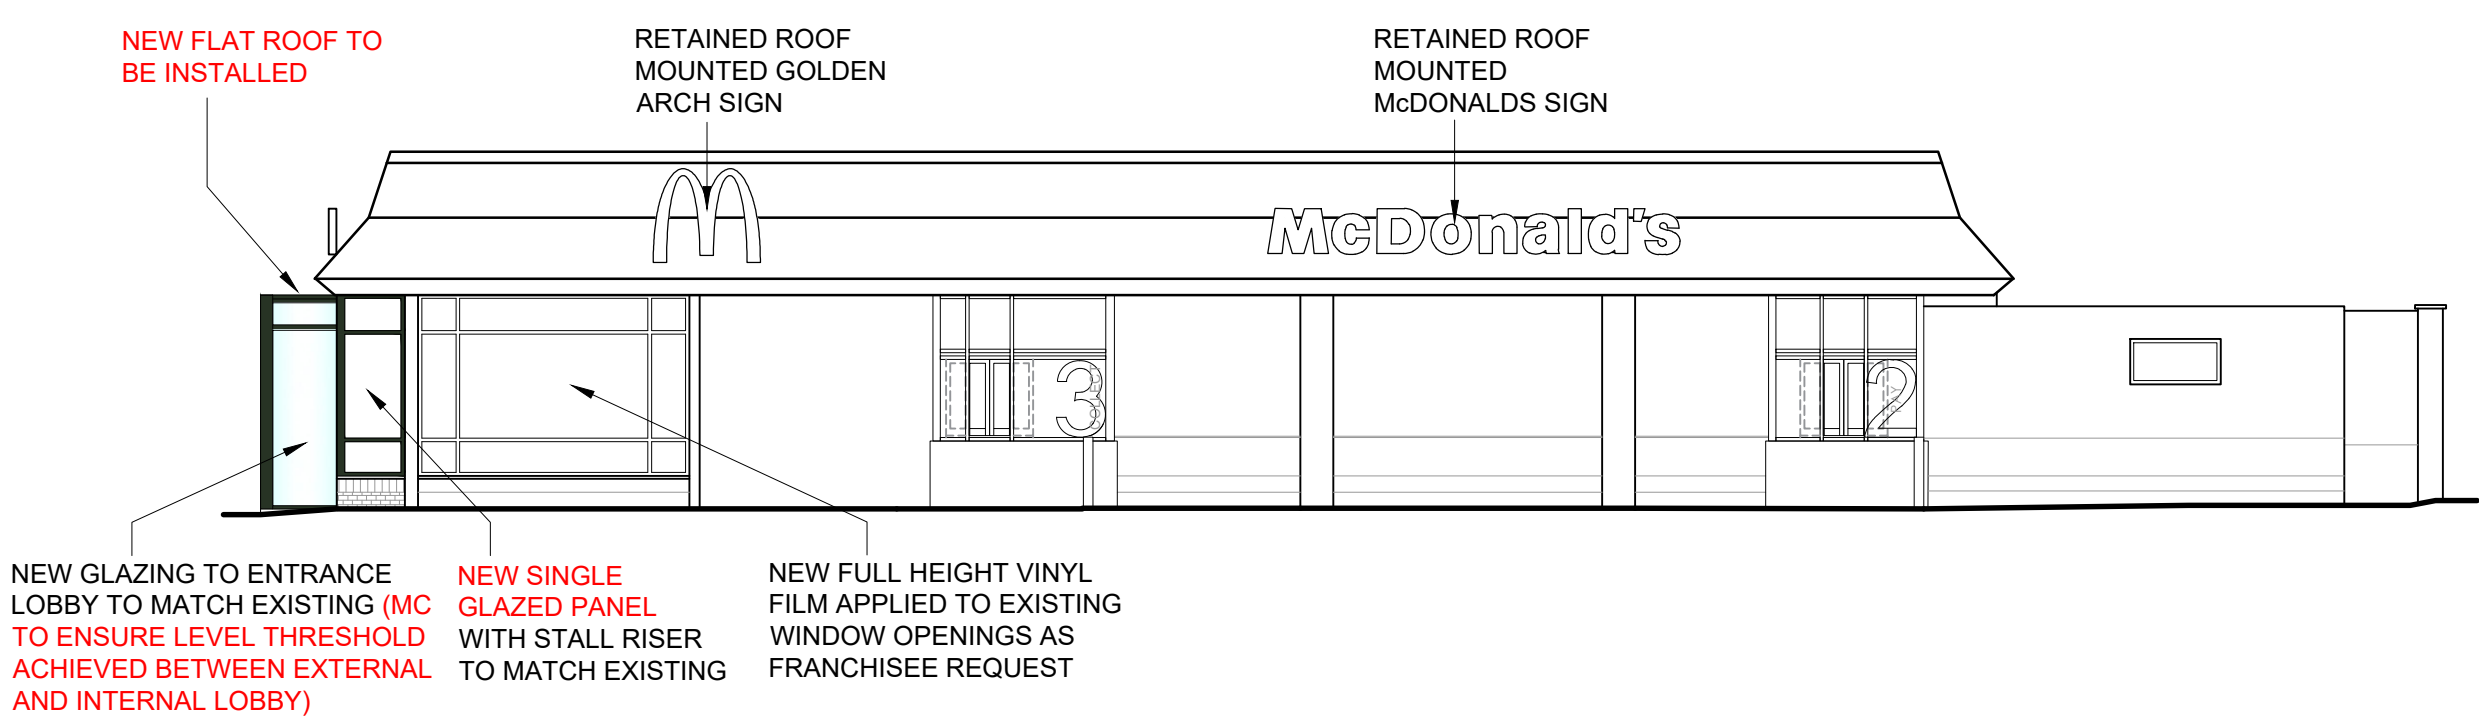

PROPOSED NORTH ELEVATION



PROPOSED SOUTH ELEVATION

NOTES

- All dimensions and levels are to be checked on site.
- Any discrepancies are to be reported to the architect before any work commences.
- This drawing shall not be scaled to ascertain any dimensions. Work to figured dims only.
- This drawing shall not be reproduced without express written permission from AEW.
- Title overlay drawings and ownership boundaries are produced using all reasonable endeavours. AEW cannot be responsible for the accuracy or scale discrepancy of base plans supplied to them.
- All works are to be undertaken in accordance with Building Regulations and the latest British Standards.
- All proprietary materials and products are to be used strictly in accordance with the manufacturers recommendations.

CDM 2015


Client notified of duties: **At Design Workshops**

Principal Designer: **CSS**

Unless noted below, all known hazards have been highlighted on the drawing.

Notes:

All drawings to be read in conjunction with all other drawings as noted on issue sheet.

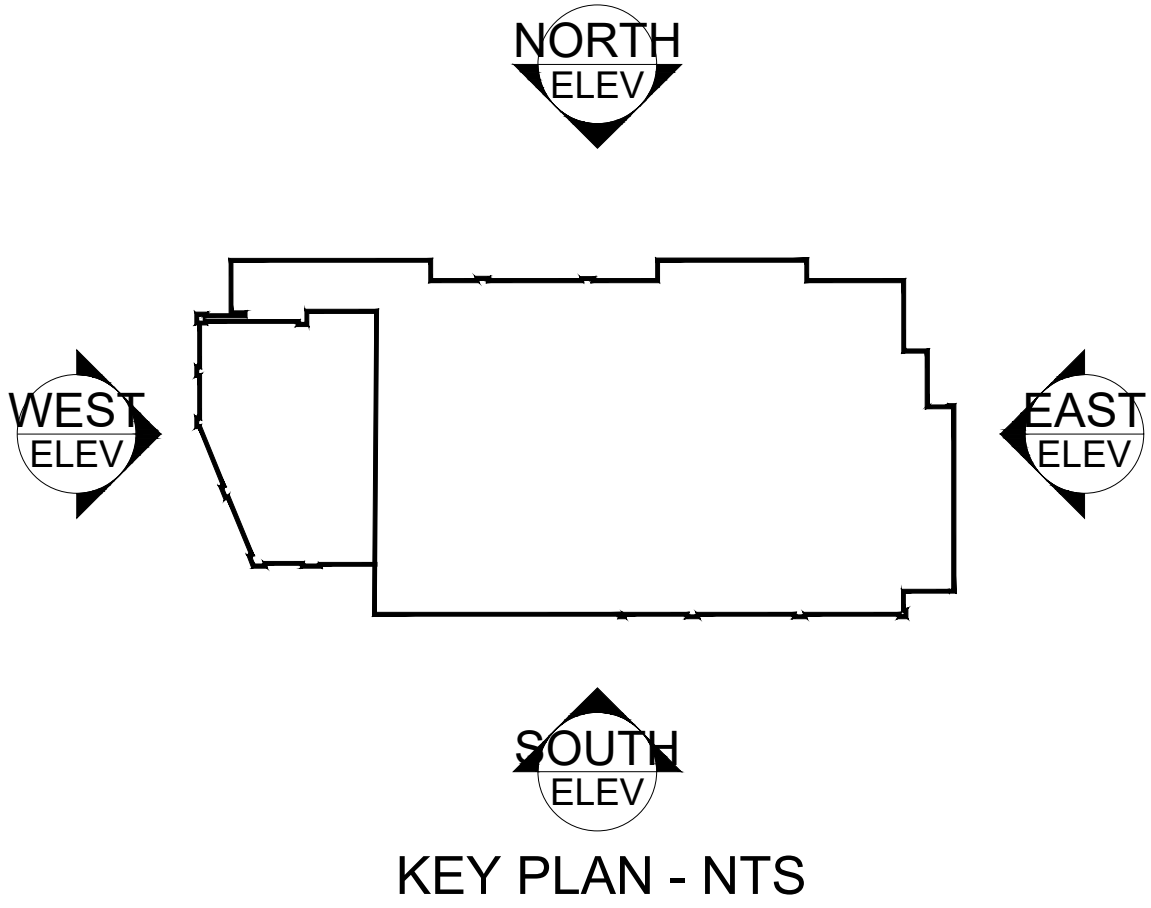

KEY PLAN - NTS

B 01/06/2022 HL LD
UPDATED FOLLOWING STAGE 2 MEETING
- NEW GLAZING + WALL TO EAST ELEVATION
UPDATES INDICATED IN RED TEXT

**DESIGN WORKING GROUP
APPROVED**

A 31/03/2022 HL LD
UPDATED TO STAGE 1 MEETING 22/03/22
-RELOCATED FRONT SLIDING DOOR
-OMIT WORKS TO SUIT 0004
-NEW VINYL FILM APPLIED TO WINDOW
DWG APPROVED STAMP ADDED
UPDATED NOTED IN RED

- 04/03/2022 HL DP
INITIAL ISSUE

REV Date Drawn by: - Checked by: -

Status Purpose of Issue
S2 For Information

drawing stage **PLANNING**


client
McDonald's Restaurants Ltd

project store
**RIVERSIDE RETAIL PARK
RADCLIFFE 0671**

drawing title
**EXISTING & PROPOSED
SITE ELEVATIONS**

date **22/02/2022** drawn **HL**
scale@A1 **1:100** checked **AB**

BUILDING FINISHES		
DESCRIPTION	EXISTING	PROPOSED
WALLS	BRICK WALL AND CLADDING	TO MATCH EXISTING
ROOF	TILES	AS EXISTING
WINDOW FRAMES	KHAKI GREEN	TO MATCH EXISTING
SOFFIT & FASCIAS	KHAKI GREEN	TO MATCH EXISTING
DOORS	KHAKI GREEN	TO MATCH EXISTING
BOOTH WINDOWS (inc surrounds)	NEW GREY PPC ALUMINIUM CLADDING TO BOOTHS & BOOTH WINDOW	AS EXISTING

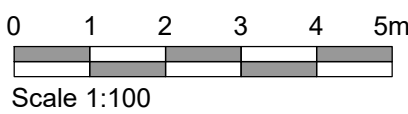

EXISTING & PROPOSED SITE ELEVATIONS 1:100

PLANNING