




Proposed Plan
Ground Floor

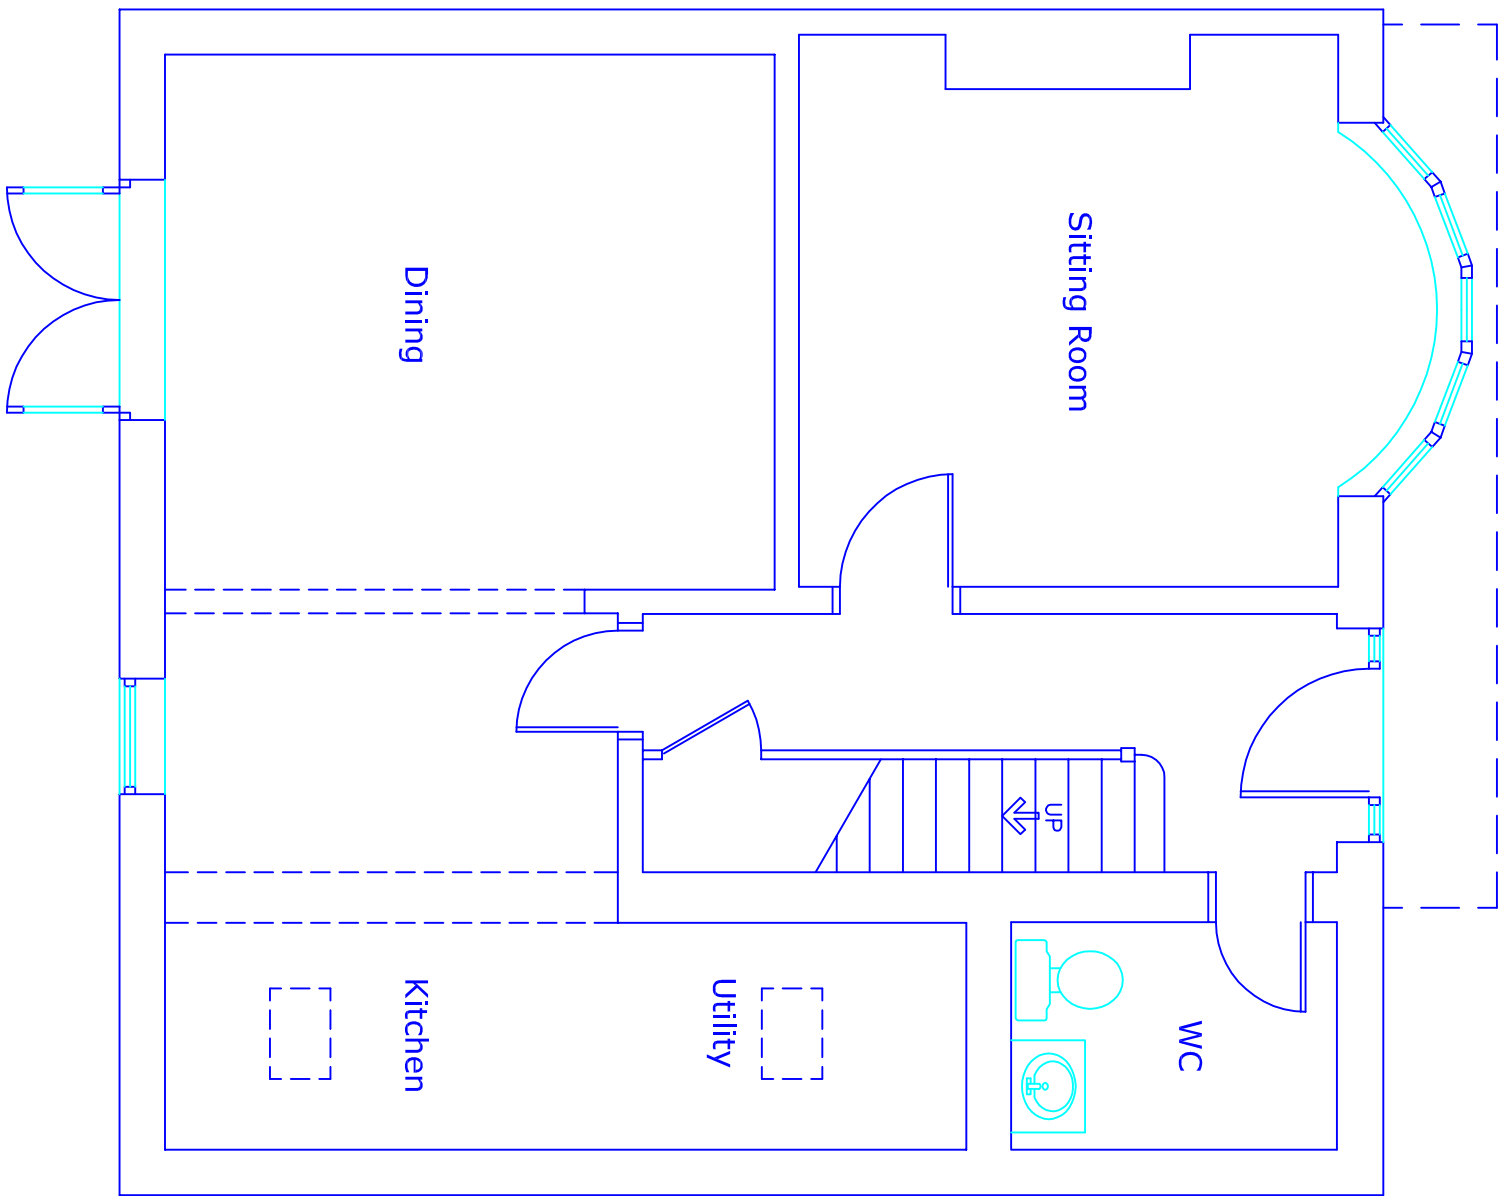

Proposed Plan
First Floor

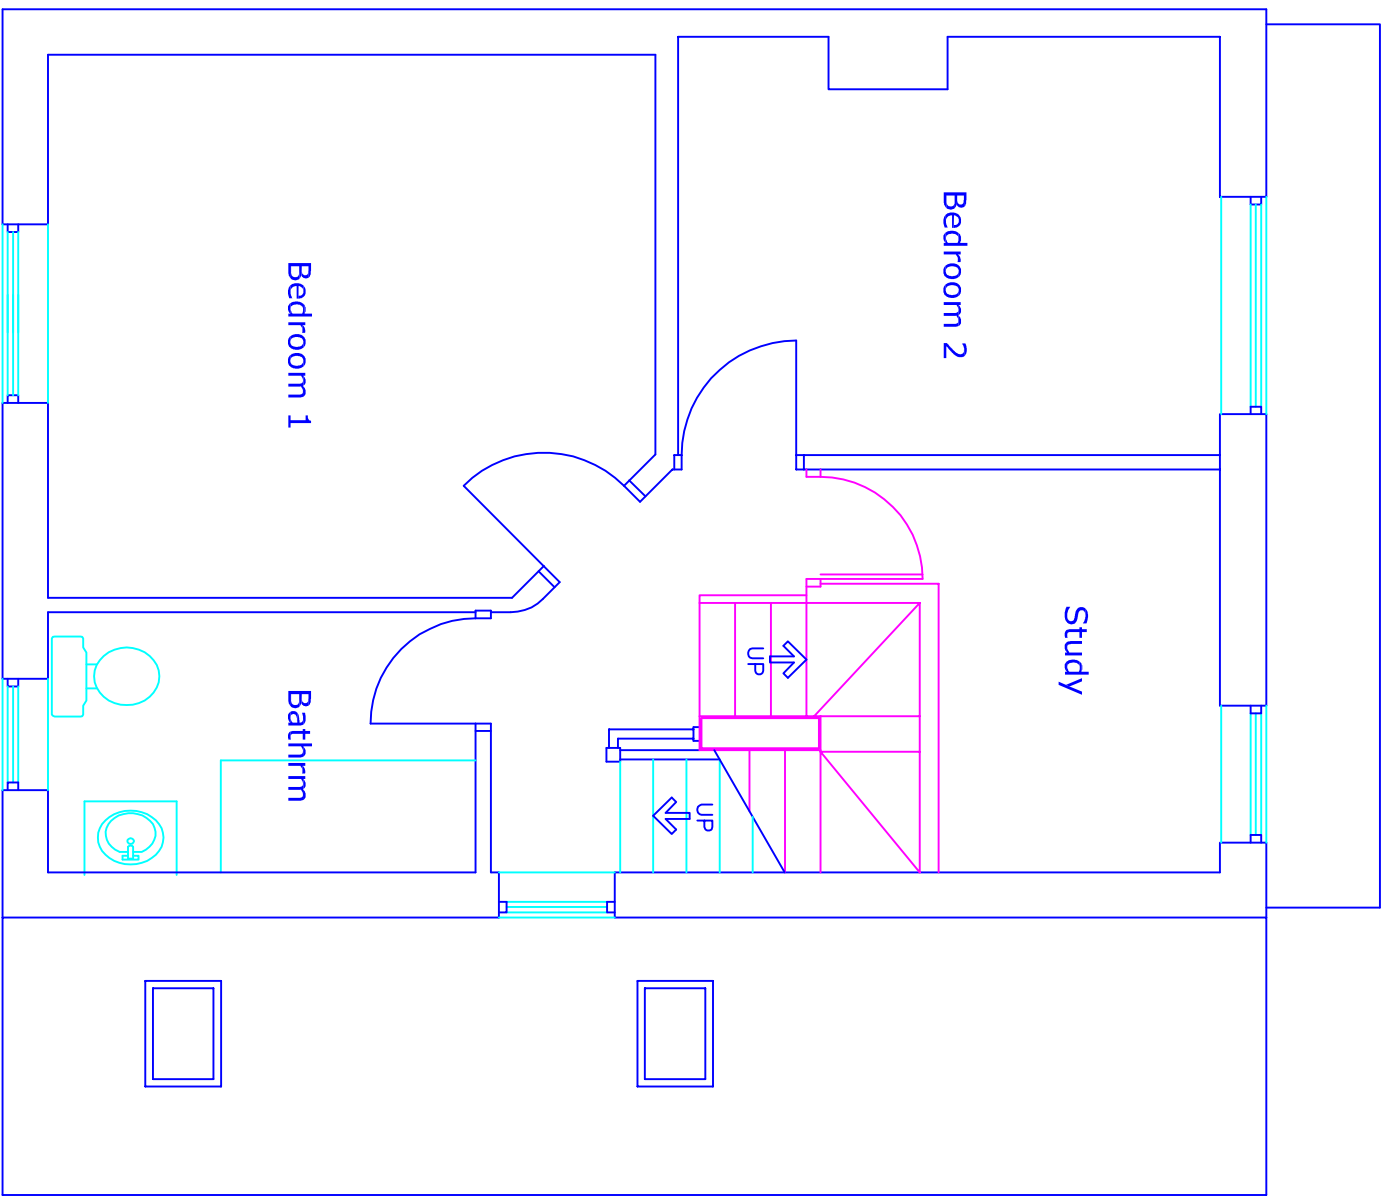


Proposed Plan
Loft Floor

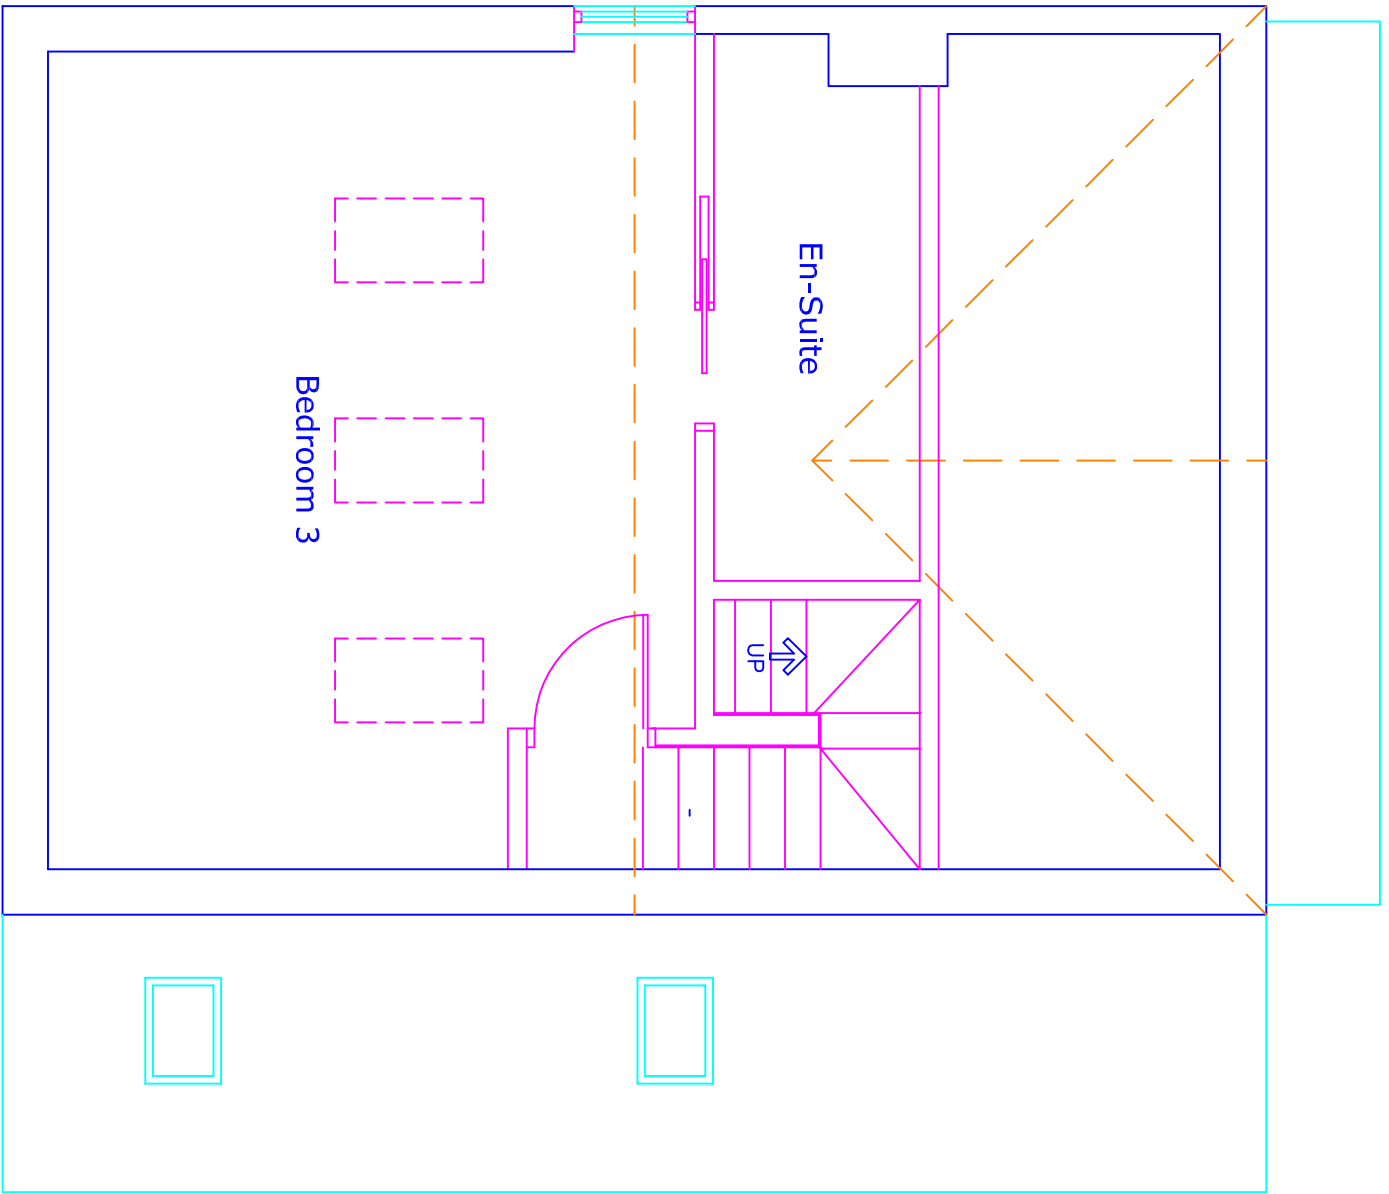


Proposed Materials

- Walls All elevations through coloured render – colour white or off white
- Roof Natural grey slate to match the existing
- Windows and doors Upvc colour white to match the existing


Proposed Rear Elevation

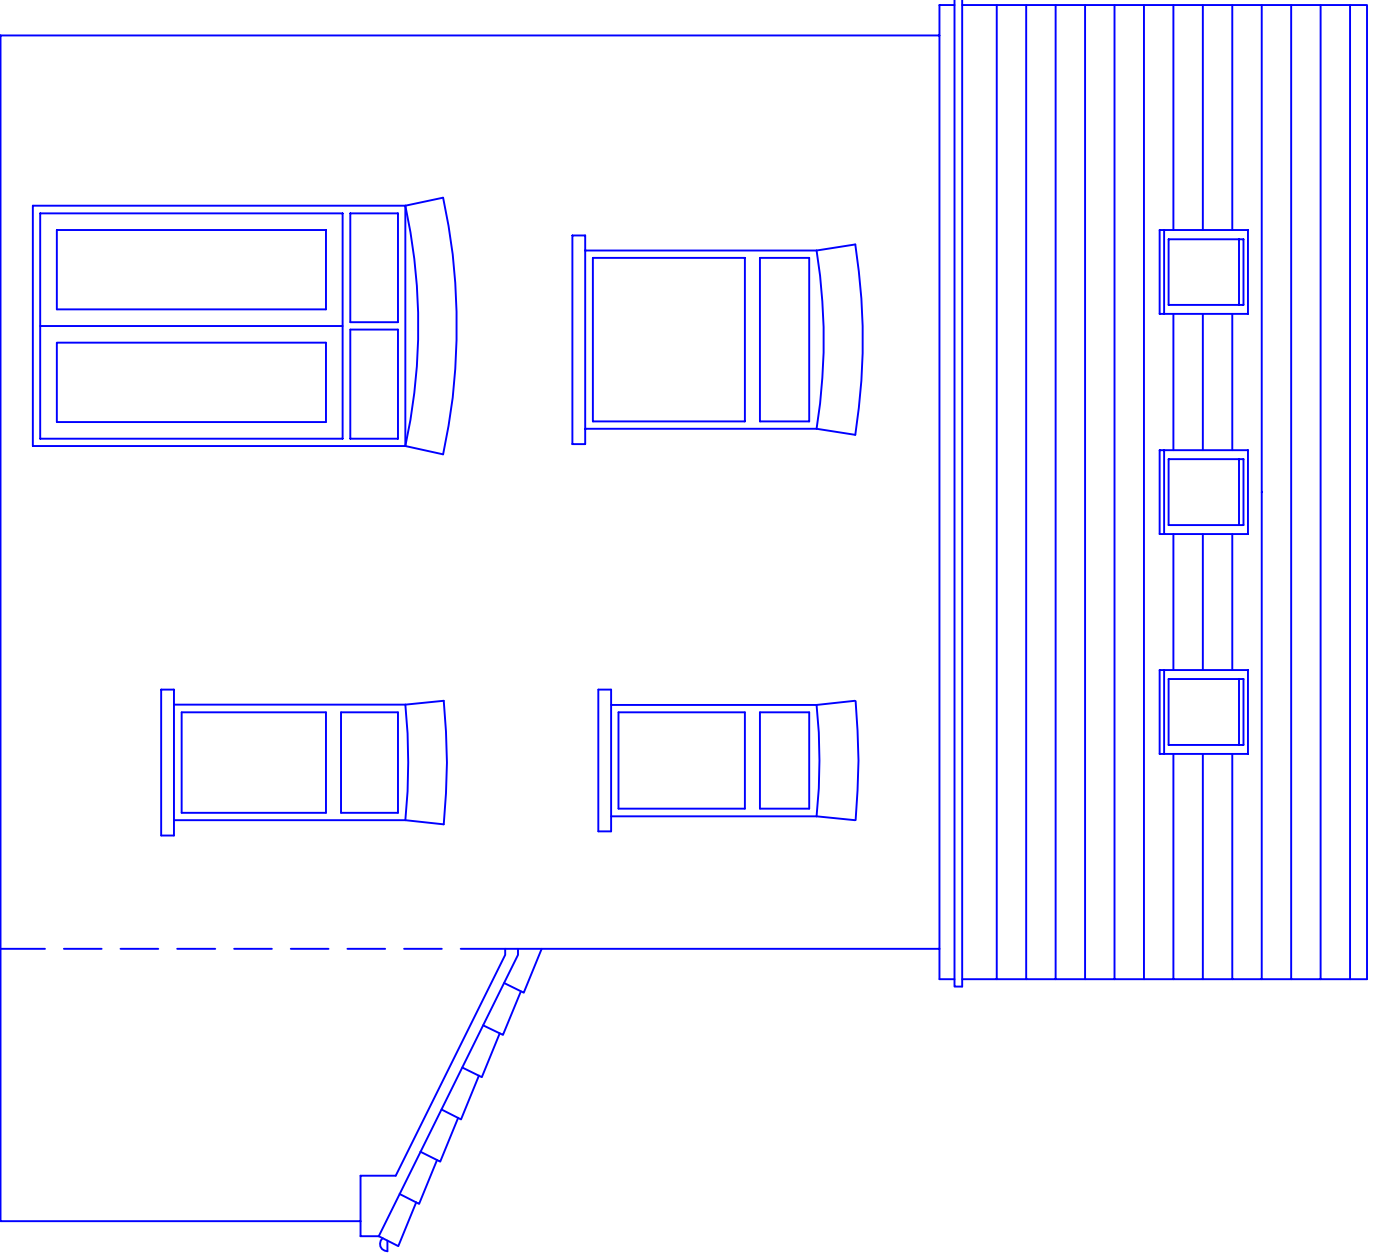


Proposed Side Elevation

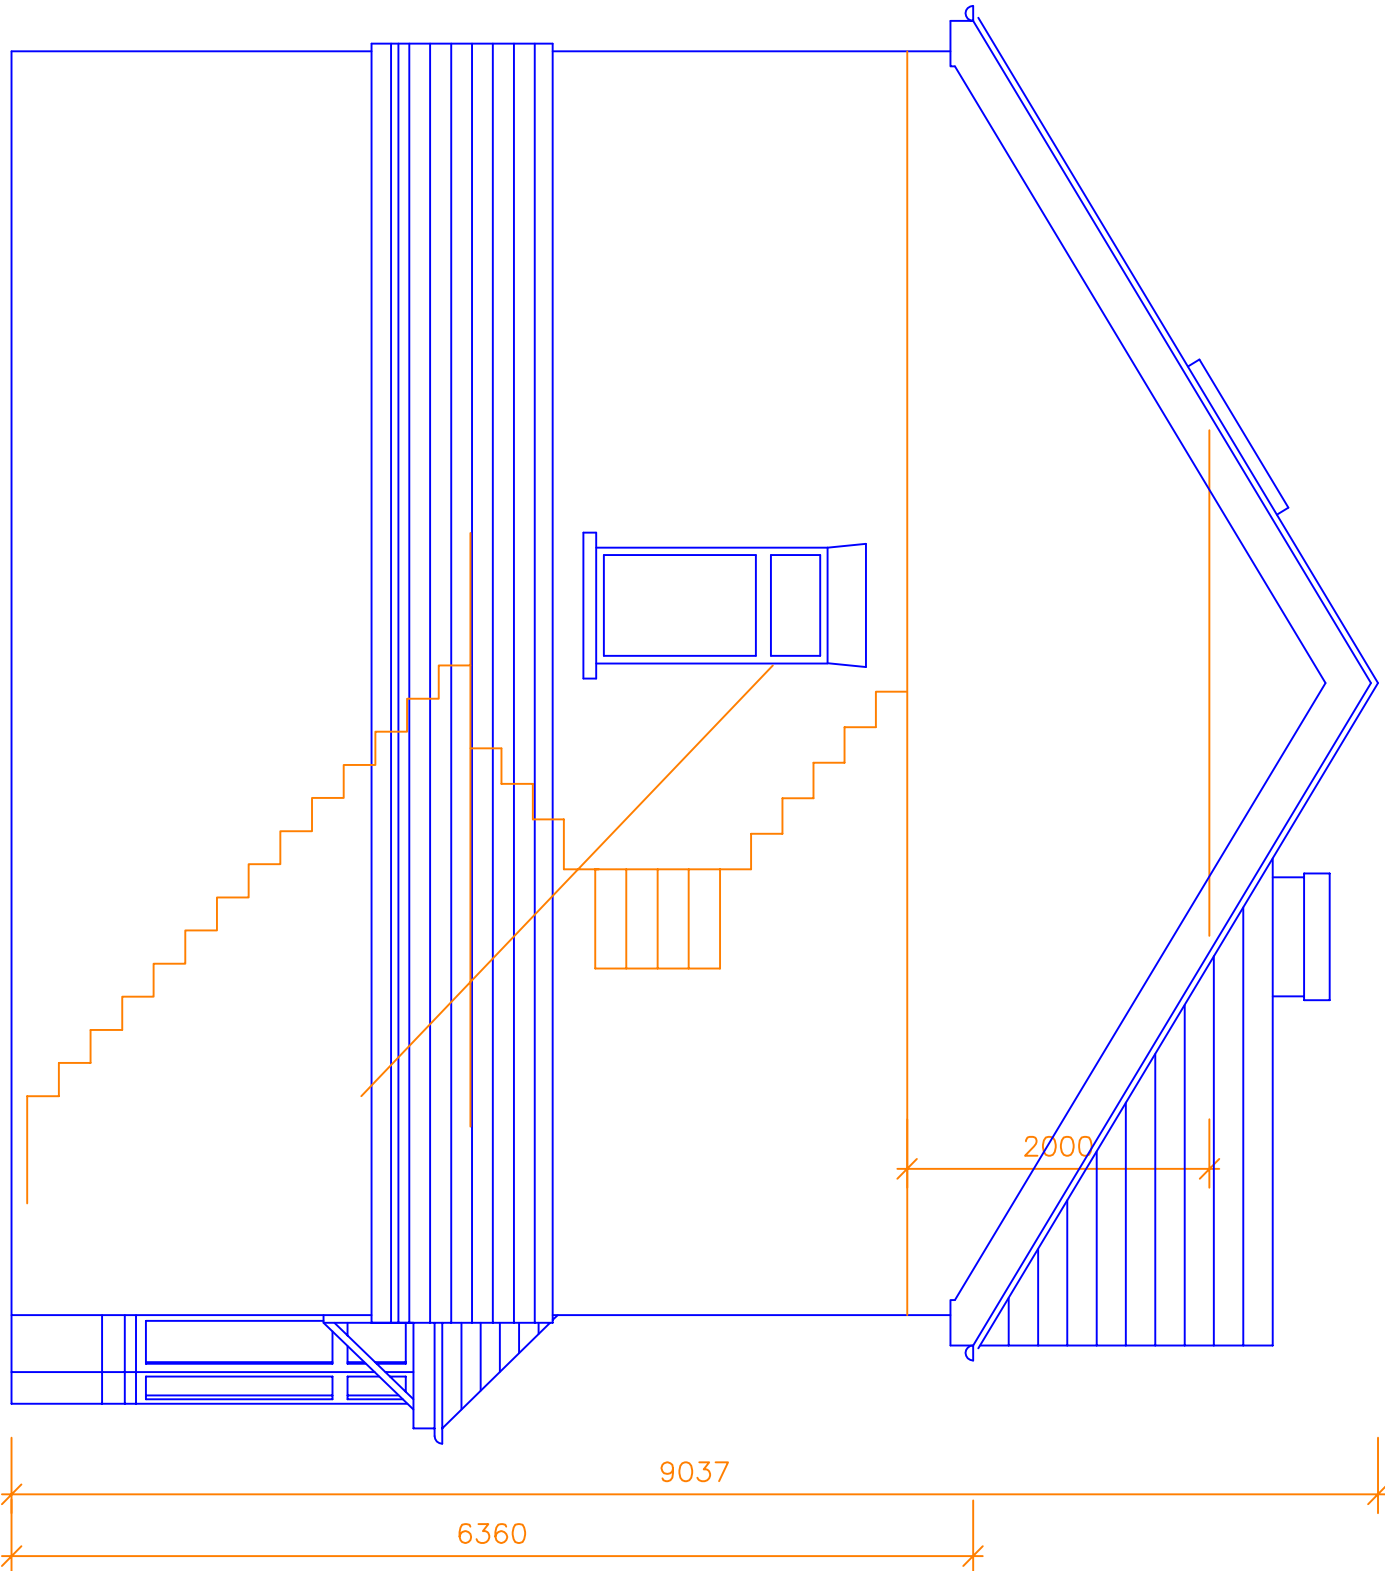

Proposed Front Elevation

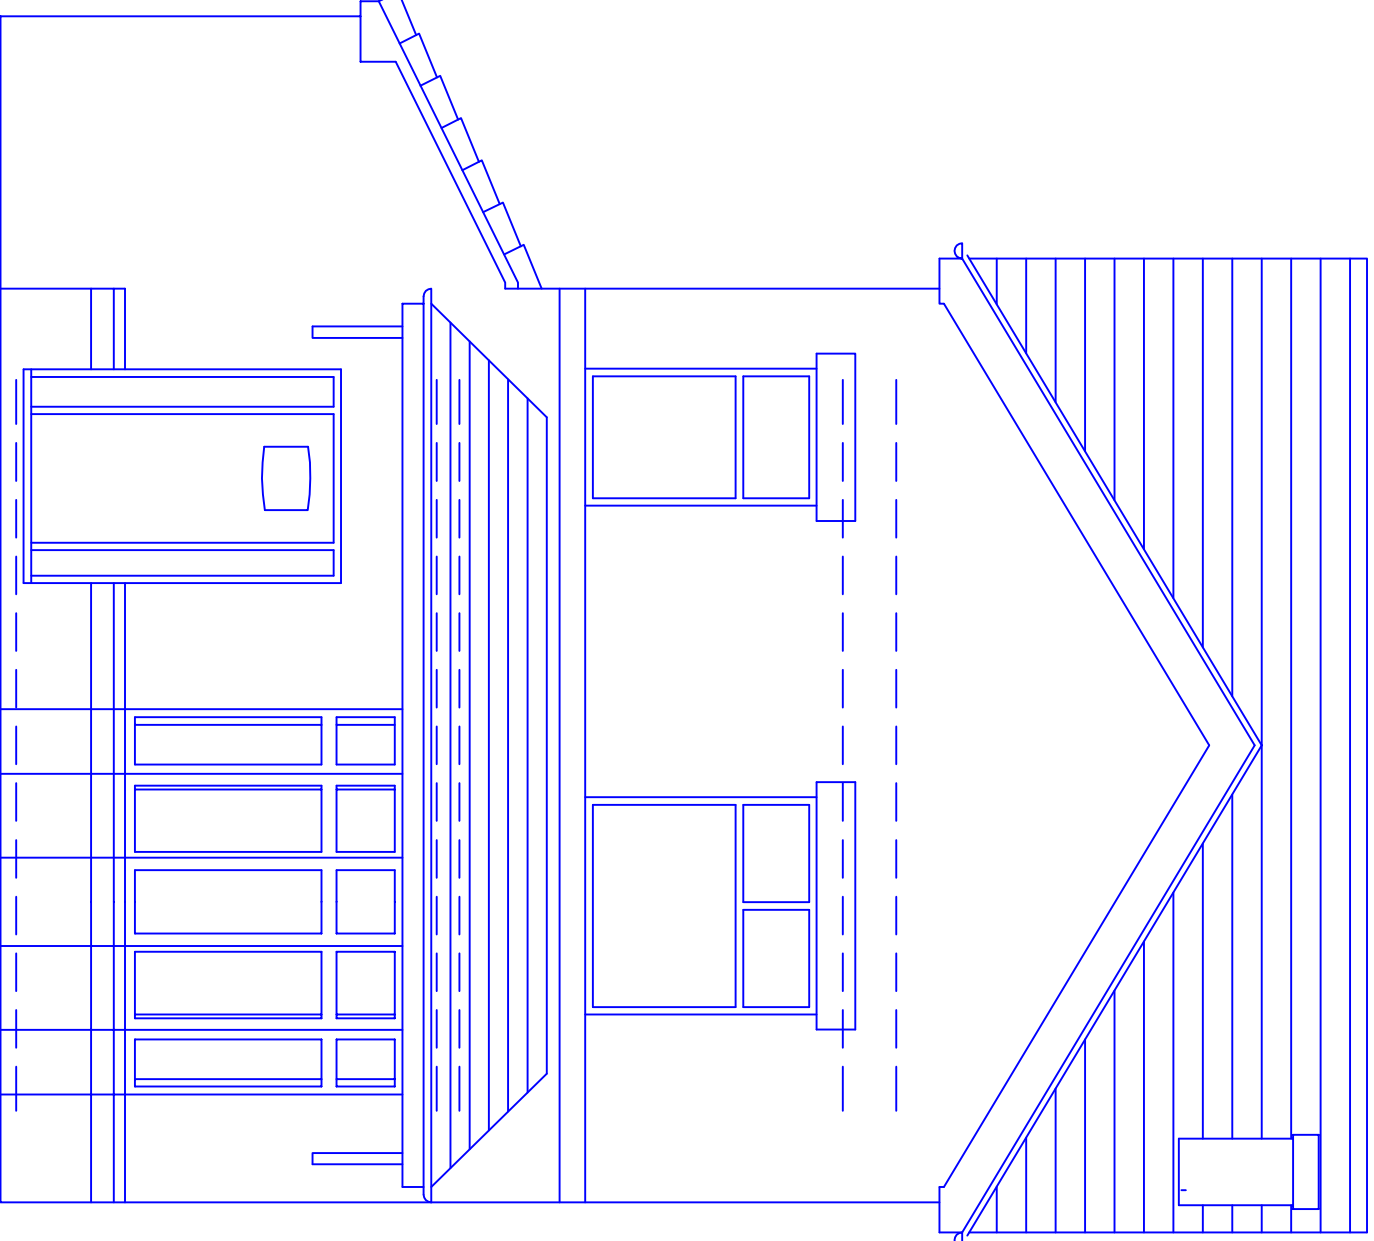

Proposed Side Elevation

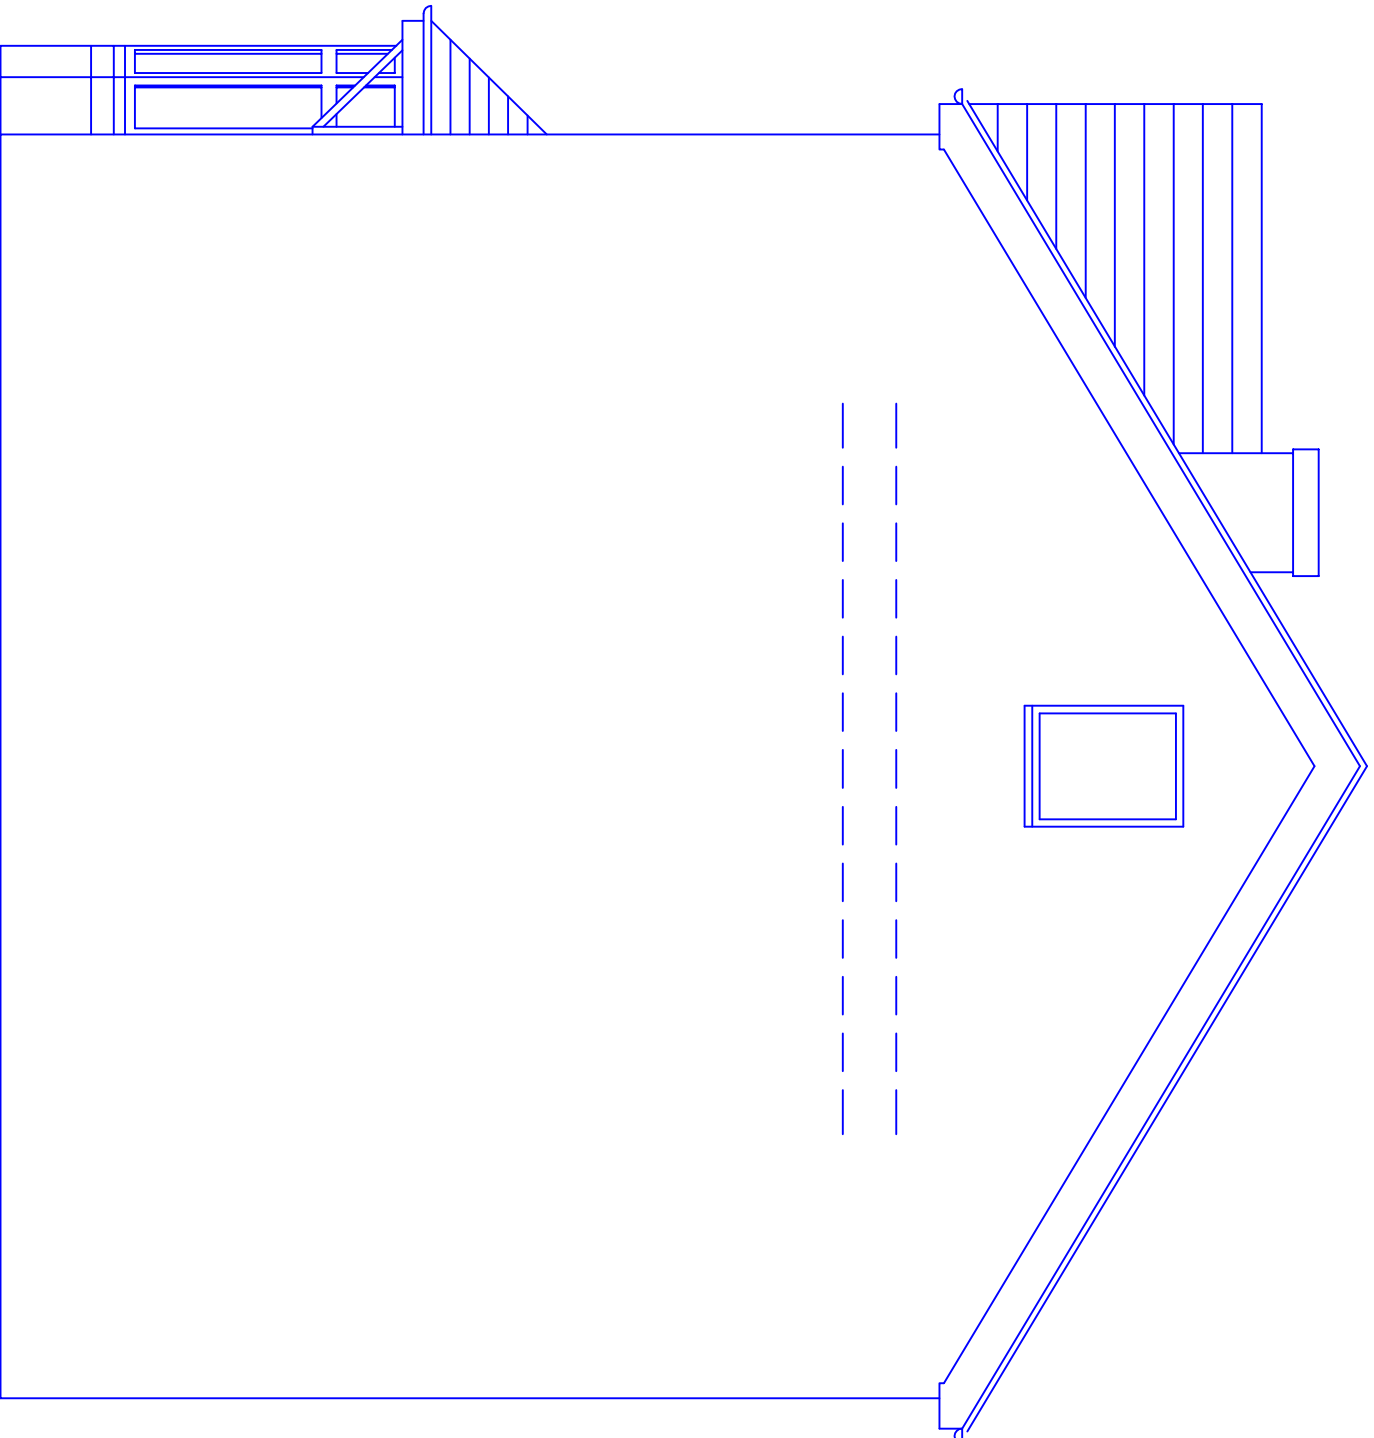

This drawing and design concept is the property of PPV design. It should not be reproduced without written permission

0 1 2 3 m

A As-built ridge increased by 257mm

B Roof raised 300mm

01.06.2024

09.04.2021

2 West View Grove

Whitefield

Manchester

M45 7NQ

scale 1:50 at A1

March 2021

Proposed Plans and Elevations

SM1-02B

PPV design Ltd

Garry Dearden (B&K home) DipArch RIBA

gar@ppv-design.co.uk www.ppv-design.co.uk

T. 0706 822751 M. 07712 669482