



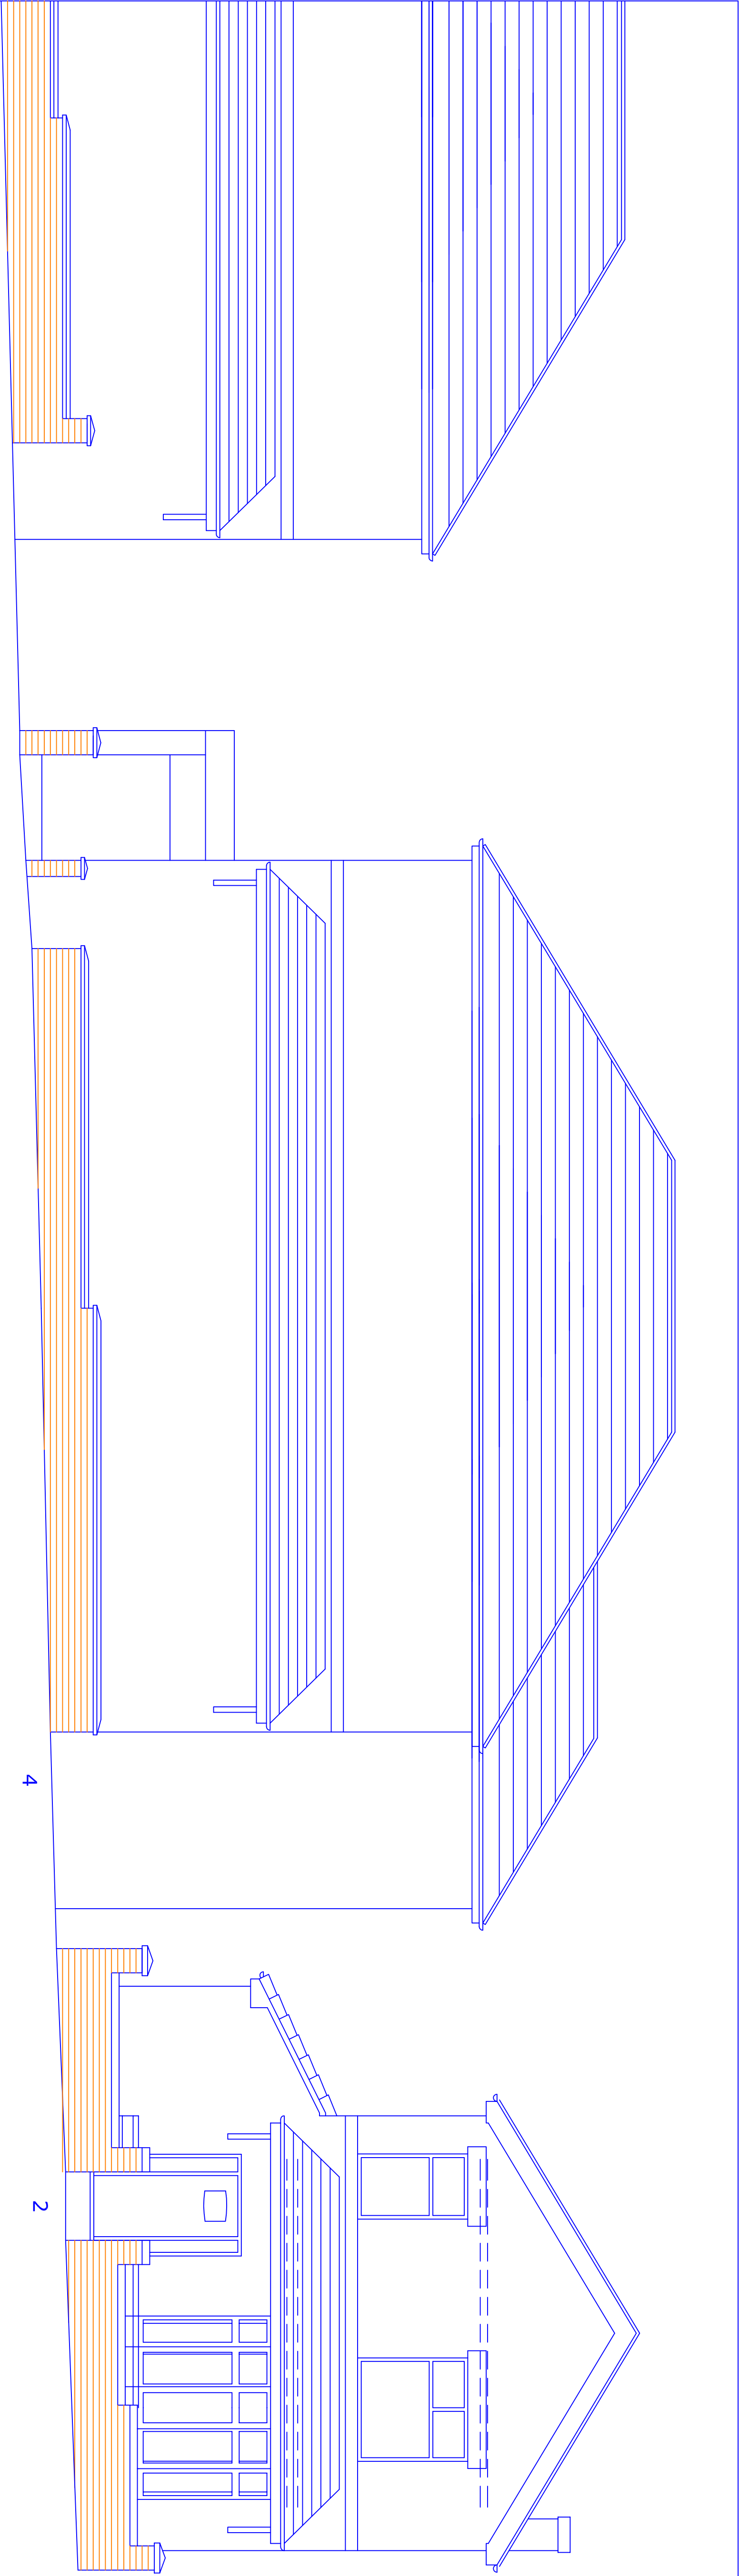

Existing Street Scene

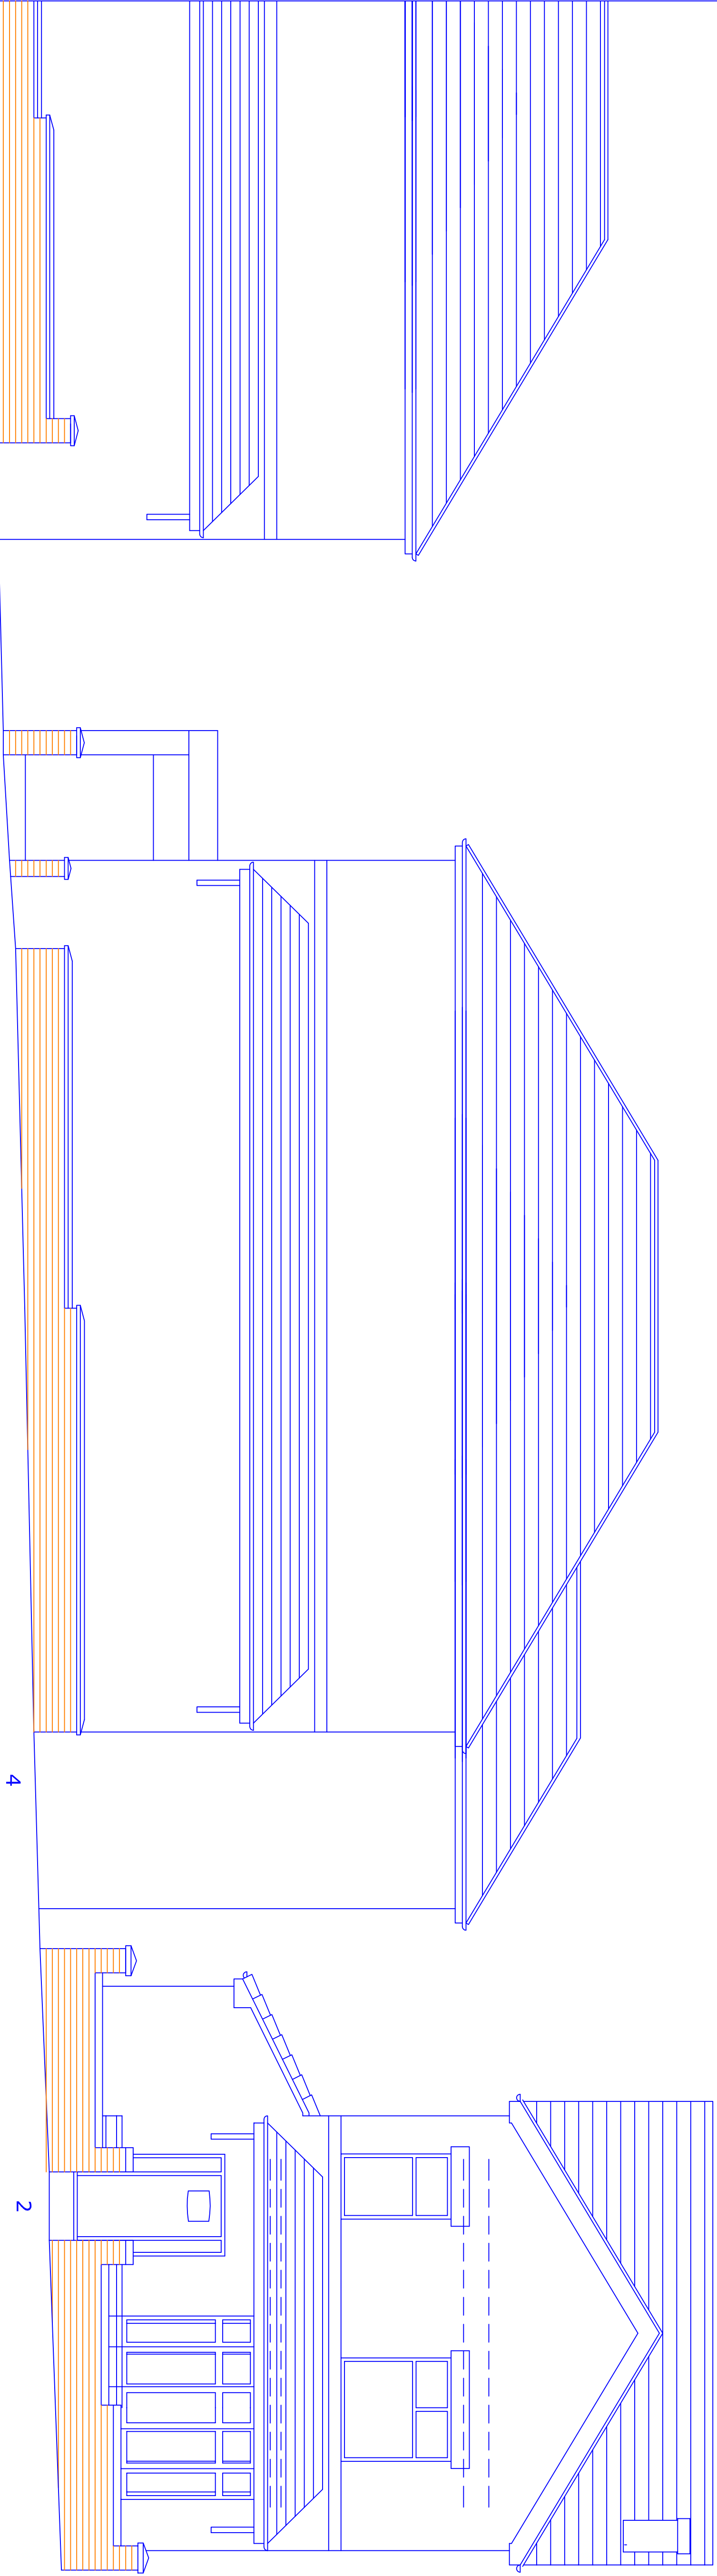

Proposed Street Scene

This drawing and design concept is the property of PPY design. It should not be reproduced without written permission

2 Helmshore Road, Holcombe Village Ramsbottom, Lancashire BL8 4PA

Clare Dearden (BA Hons) Director RIBA
cdearden@ppy-design.co.uk www.ppy-design.co.uk
T: 01706 822751 M: 07712 669462

As-built: ridge raised 257mm
A Roof raised 300mm

01.06.2024
09.04.2021

2 West View Grove
Whitefield
Manchester
M45 7NQ

scale 1:50 at A1
April 2021

SM1-05B

Existing and Proposed
Street Scenes

PPY design Ltd