


Floor Plan and Left Elevation Isolation Unit

Scale 1:100

Wall Thickness = 70mm

Scale = 1:100

Base sizes indicated in red

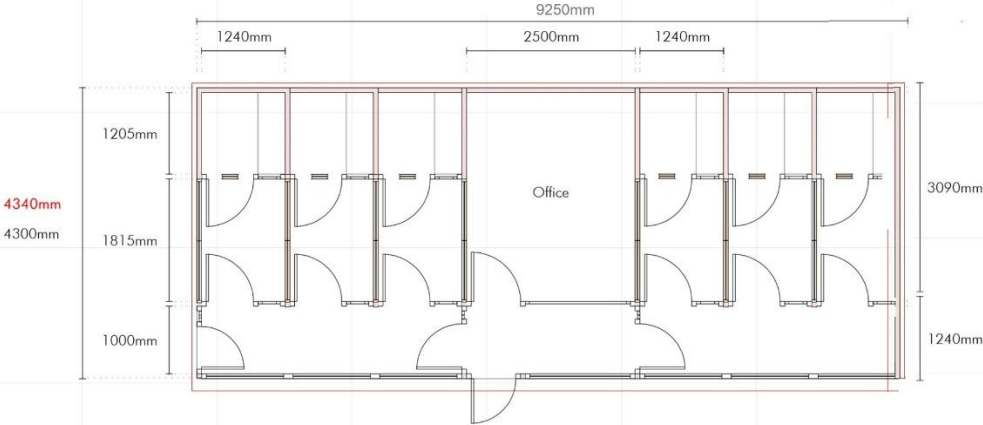

Left Elevation

Scale = 1:100

