




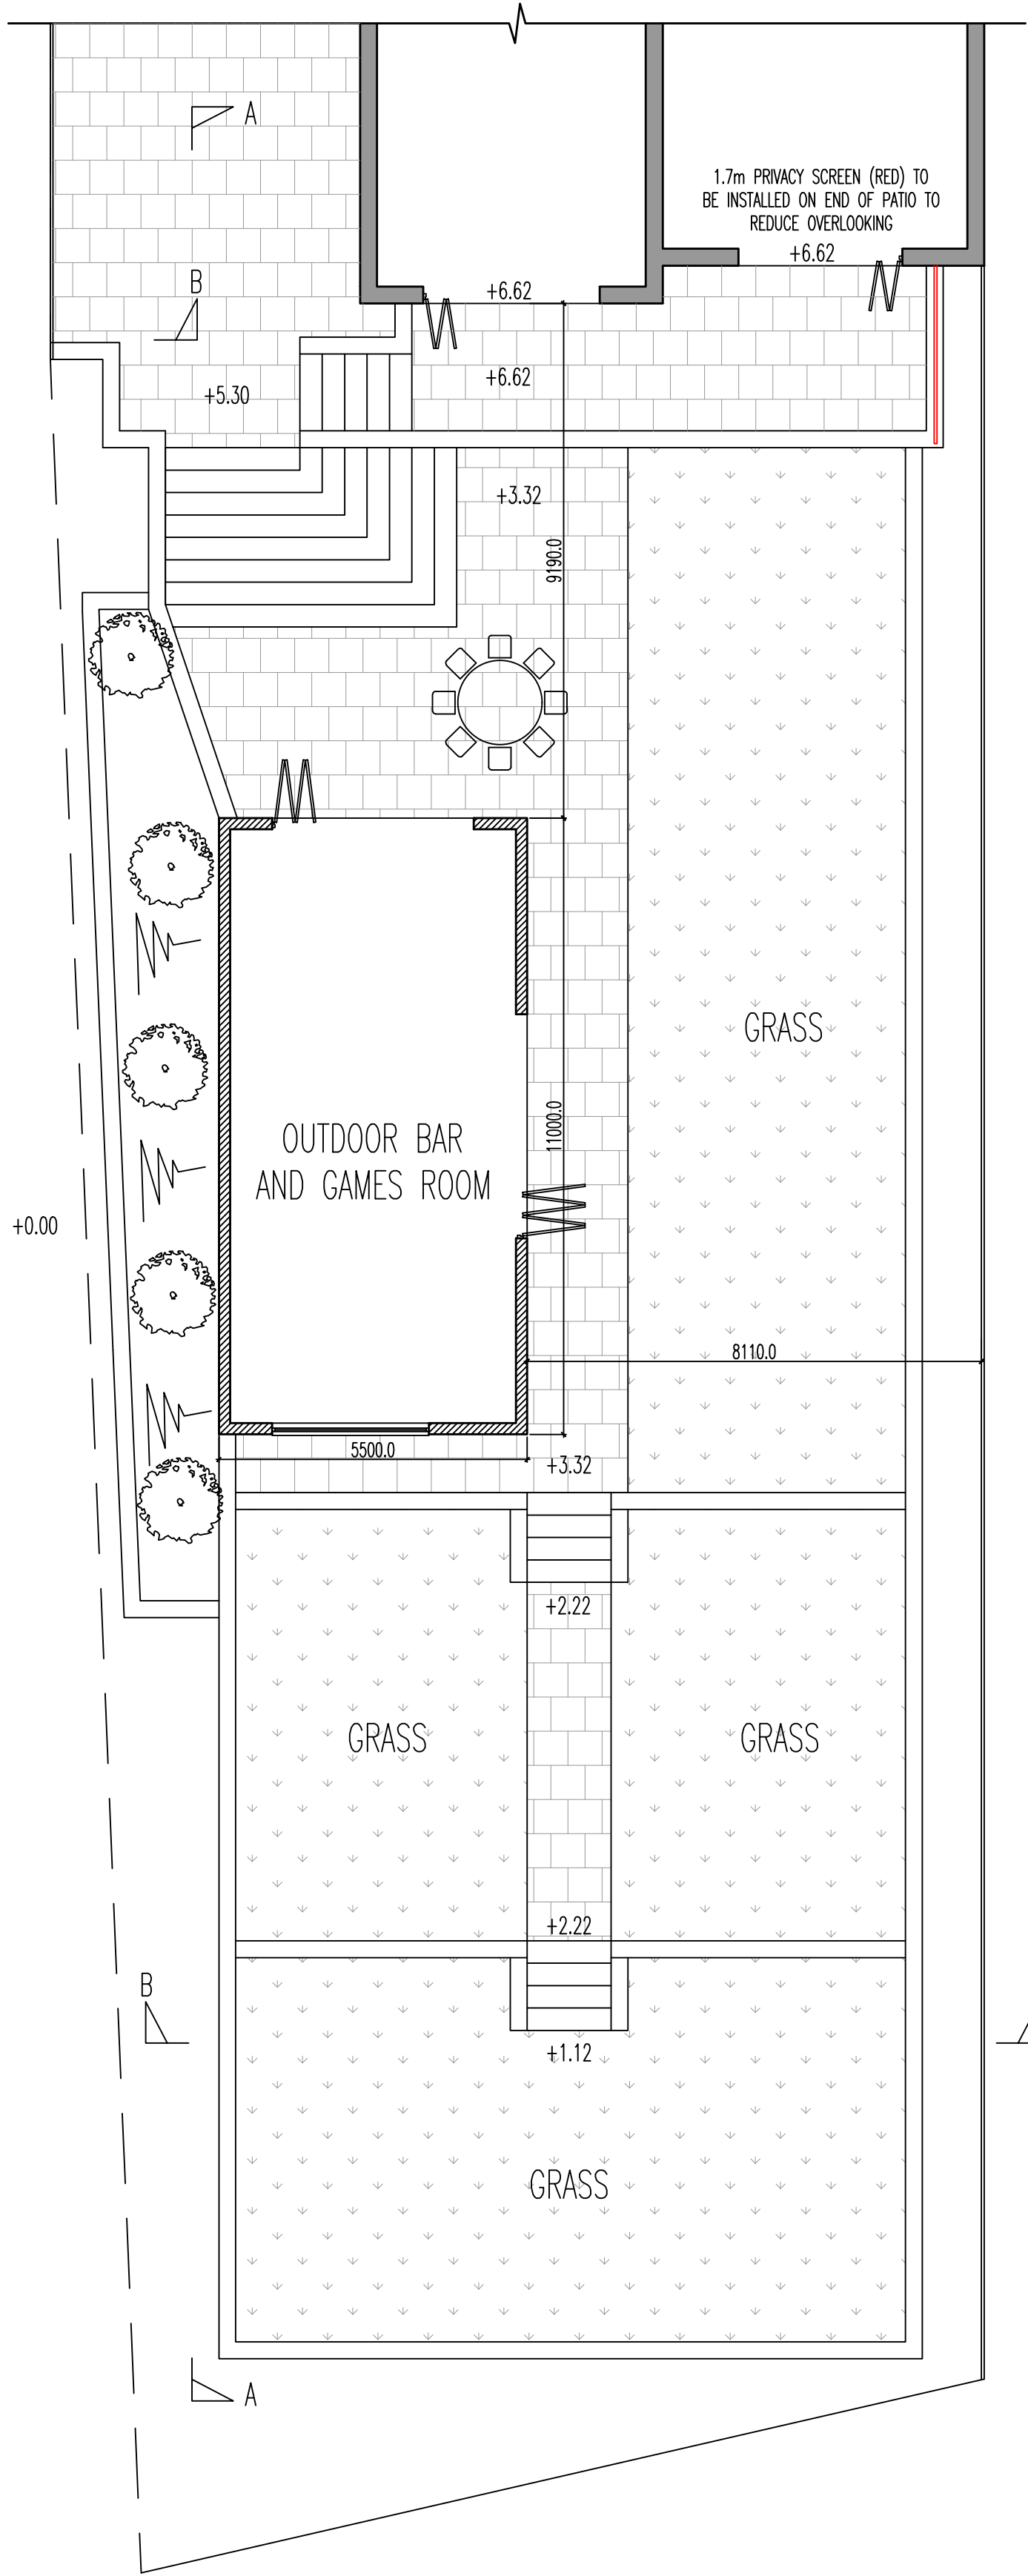


01 Proposed Garden Plan  
Scale 1:100

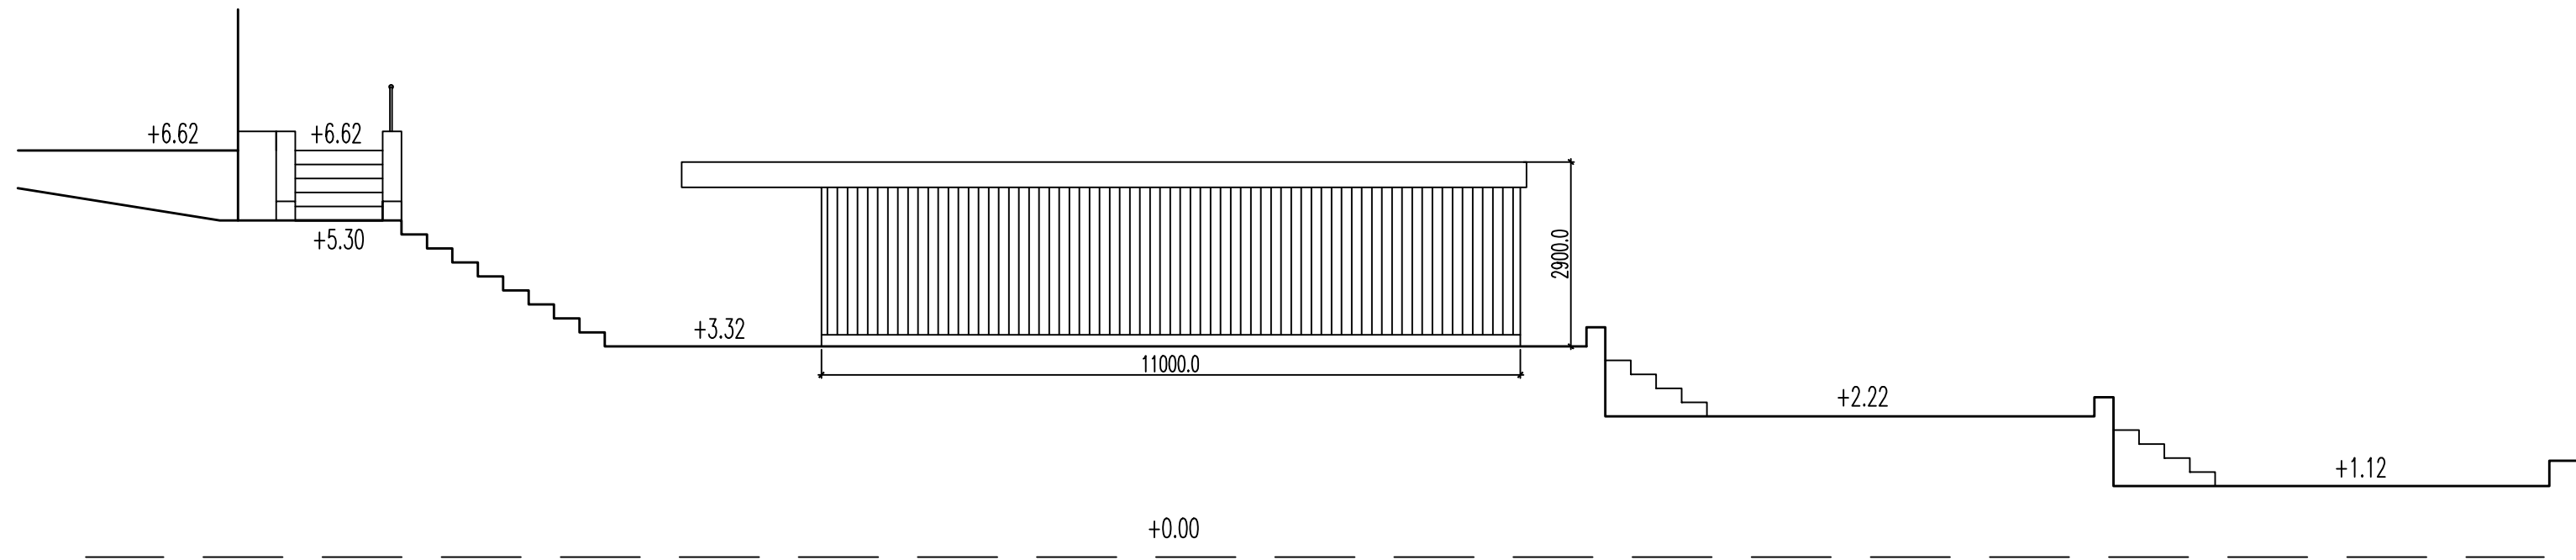


02 Proposed Section A-A  
Scale 1:100

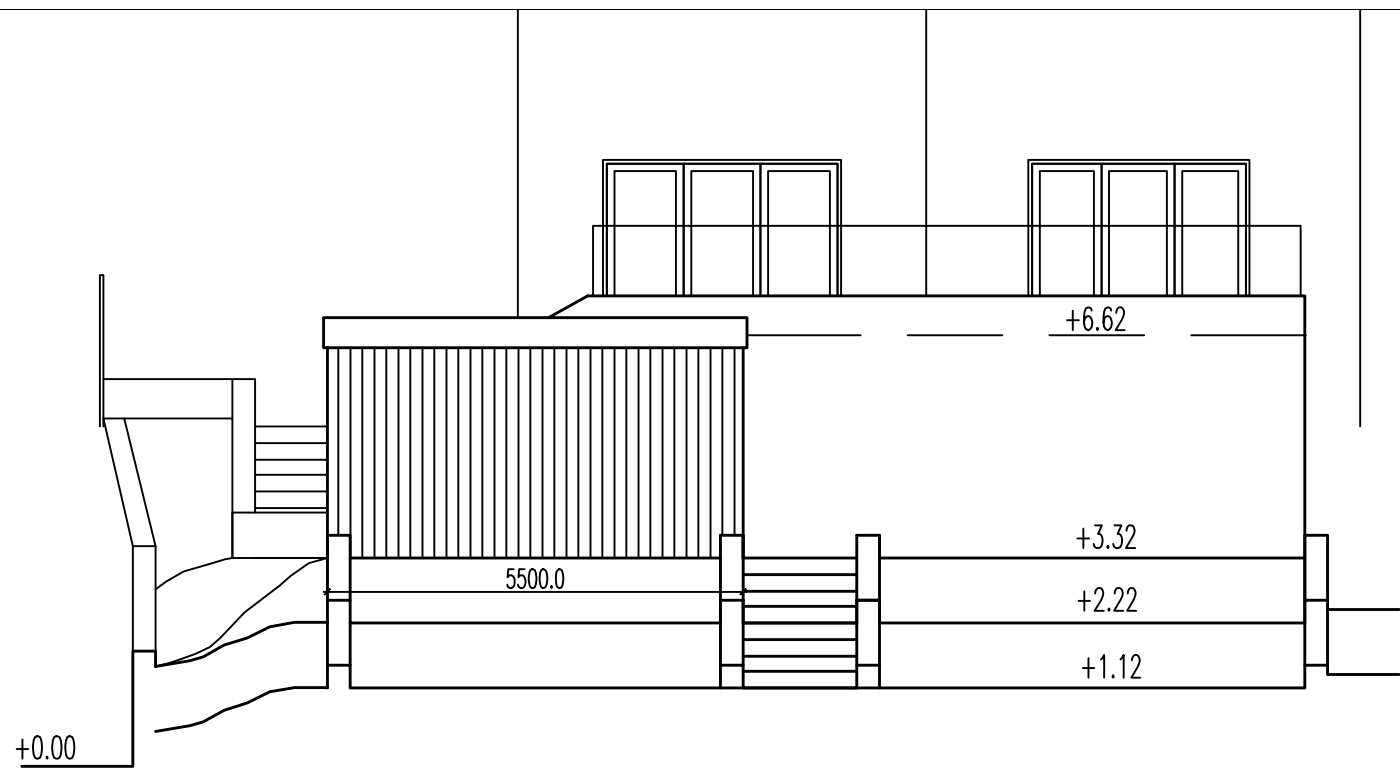


03 Proposed Section B-B  
Scale 1:100

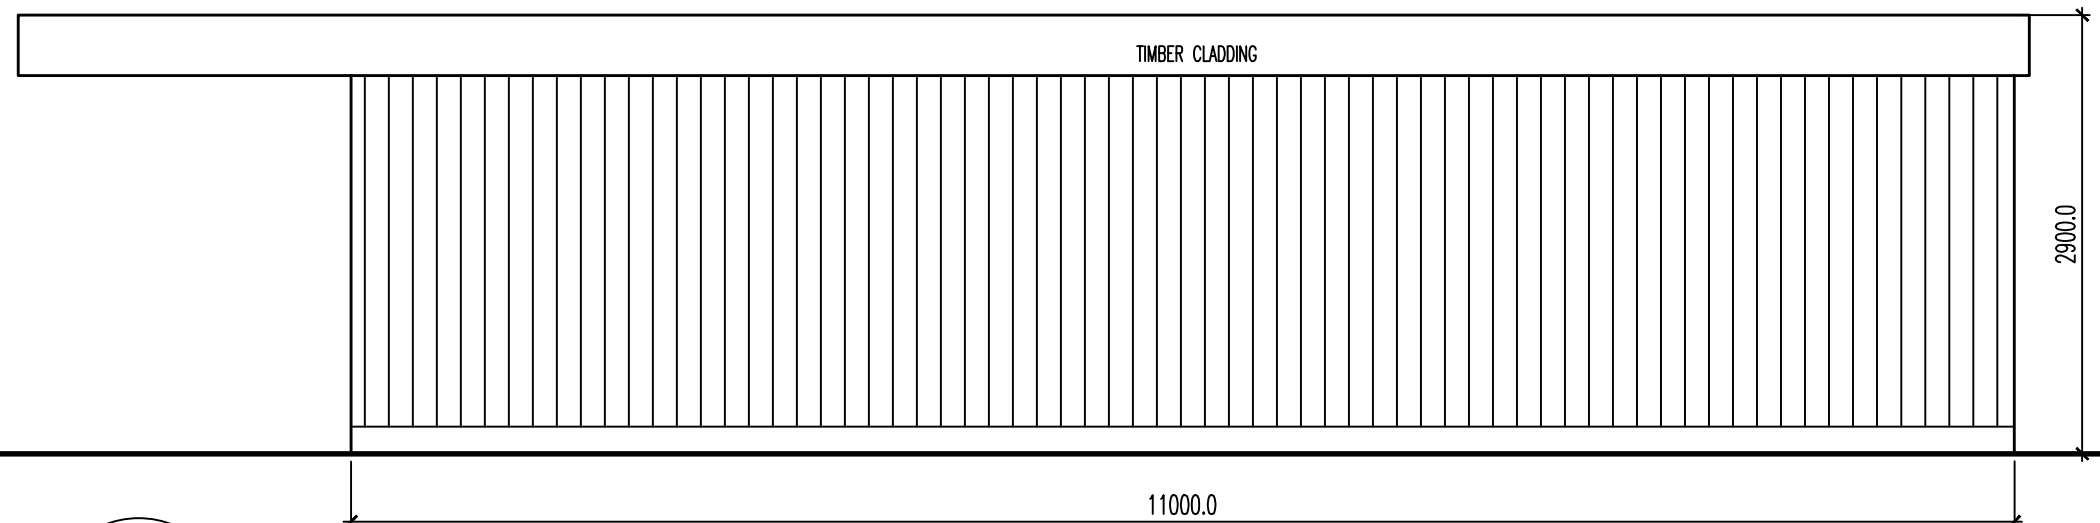


04 Proposed Side Elevation  
Scale 1:100

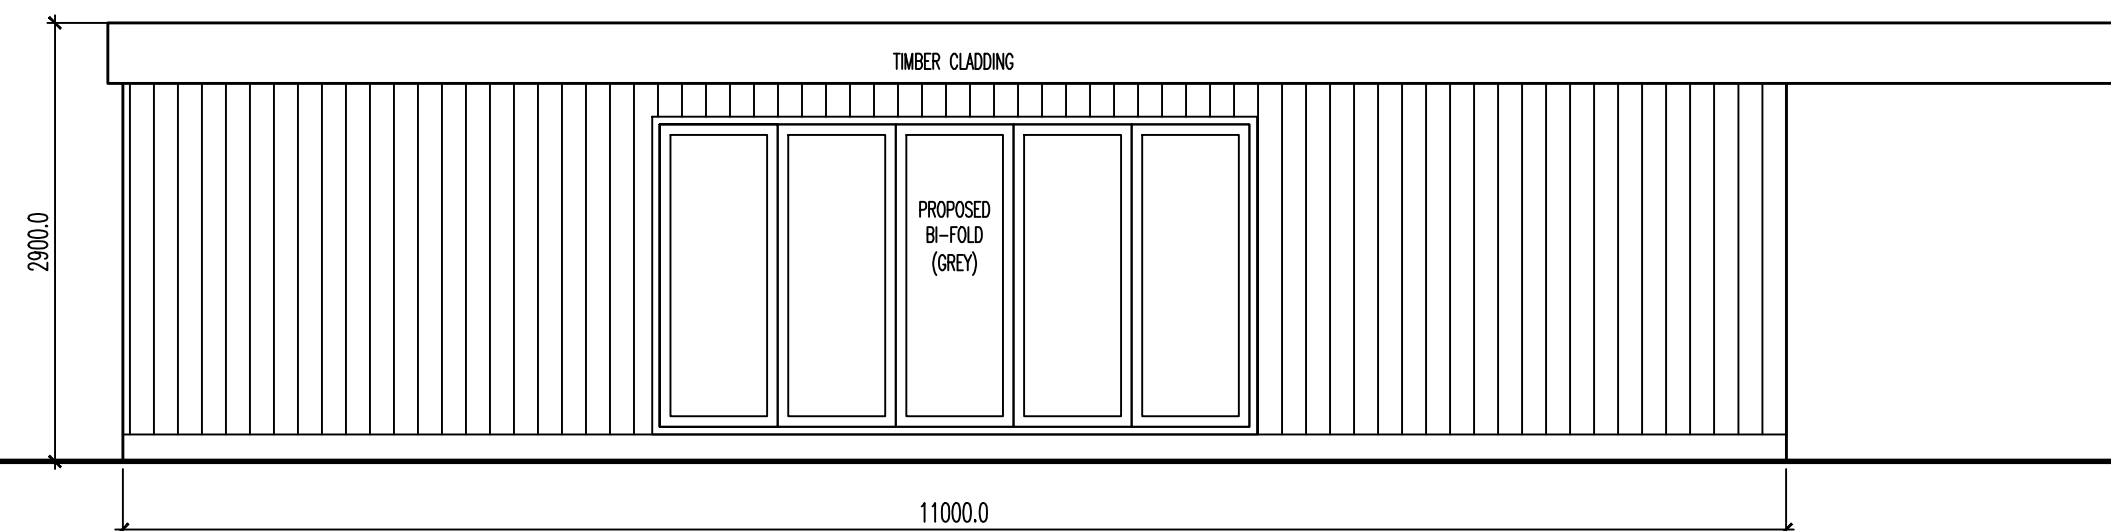

05 Proposed Side Elevation  
Scale 1:100

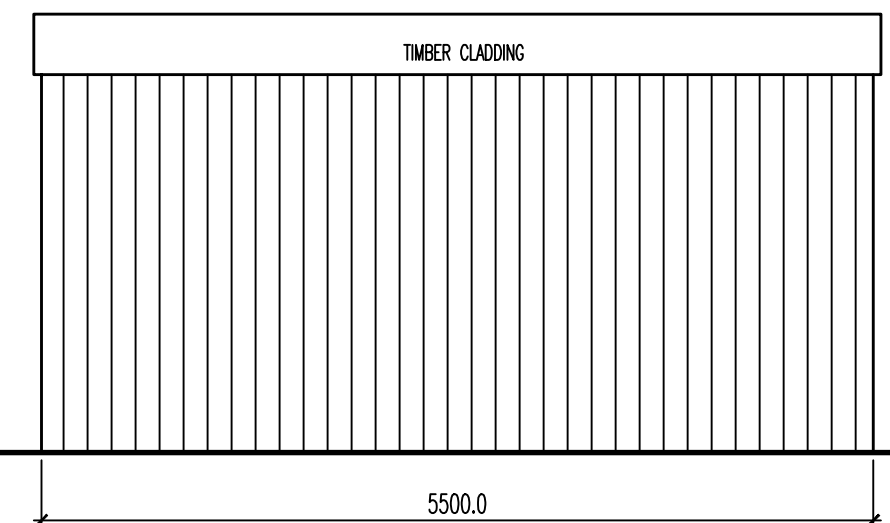

06 Proposed Rear Elevation  
Scale 1:100

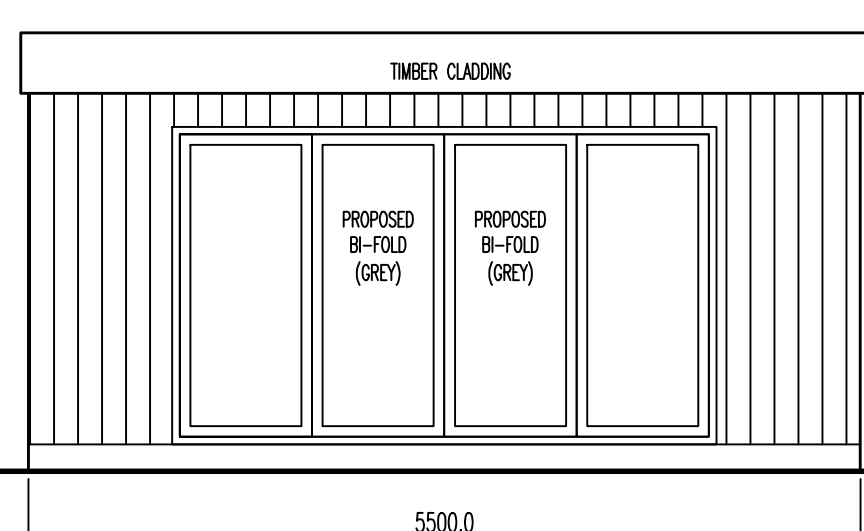

07 Proposed Front Elevation  
Scale 1:100

Notes Copyright in all documents and drawings prepared by the architectural designer and any works executed from these documents and drawings shall, unless otherwise agreed, remain the property of the designer and must not be reproduced by, lent or disclosed to, a third party without the written consent of Zach Thorp.

Do not scale off this drawing

All dimensions are to be checked on site and any discrepancies to be referred to the designer before proceeding. All levels to be checked on site All discrepancies between information shown on the drawings and the information in the specification to be referred to the designer prior to proceeding. All component sizes and references to be checked before ordering

Position of existing drain runs to be confirmed prior to proceeding and drains checked as necessary.

All relevant boundary positions are to be checked prior to proceeding

Building regulation drawings can be used for building estimates, however for an accurate quote builders must attend site as these drawings do not account for all aspects of the building works.

|                                                              |                                              |                          |         |    |
|--------------------------------------------------------------|----------------------------------------------|--------------------------|---------|----|
|                                                              |                                              |                          |         |    |
| Rev                                                          | Description                                  | Date                     | By      | Ch |
| Status                                                       |                                              | Purpose for Issue        |         |    |
| Survey                                                       | <input type="checkbox"/> Tender              | <input type="checkbox"/> |         |    |
| Construction                                                 | <input checked="" type="checkbox"/> As Built | <input type="checkbox"/> |         |    |
| Client                                                       |                                              |                          |         |    |
| Mr and Mrs Chinford<br>47 Ajax Drive, Whitefield             |                                              |                          |         |    |
| Contract                                                     |                                              |                          |         |    |
| Proposed Single Storey Rear Extension<br>and Loft Conversion |                                              |                          |         |    |
| Drawing                                                      |                                              |                          |         |    |
| Proposed Garden Plan and Site Sectional<br>Elevations        |                                              |                          |         |    |
| Drawing No. ZT22-196-04                                      |                                              | Revision                 | /       |    |
| Scales                                                       | 1:100                                        | Date                     | Apr '22 |    |
| Drawn                                                        | ZTT                                          | Checked                  |         |    |