



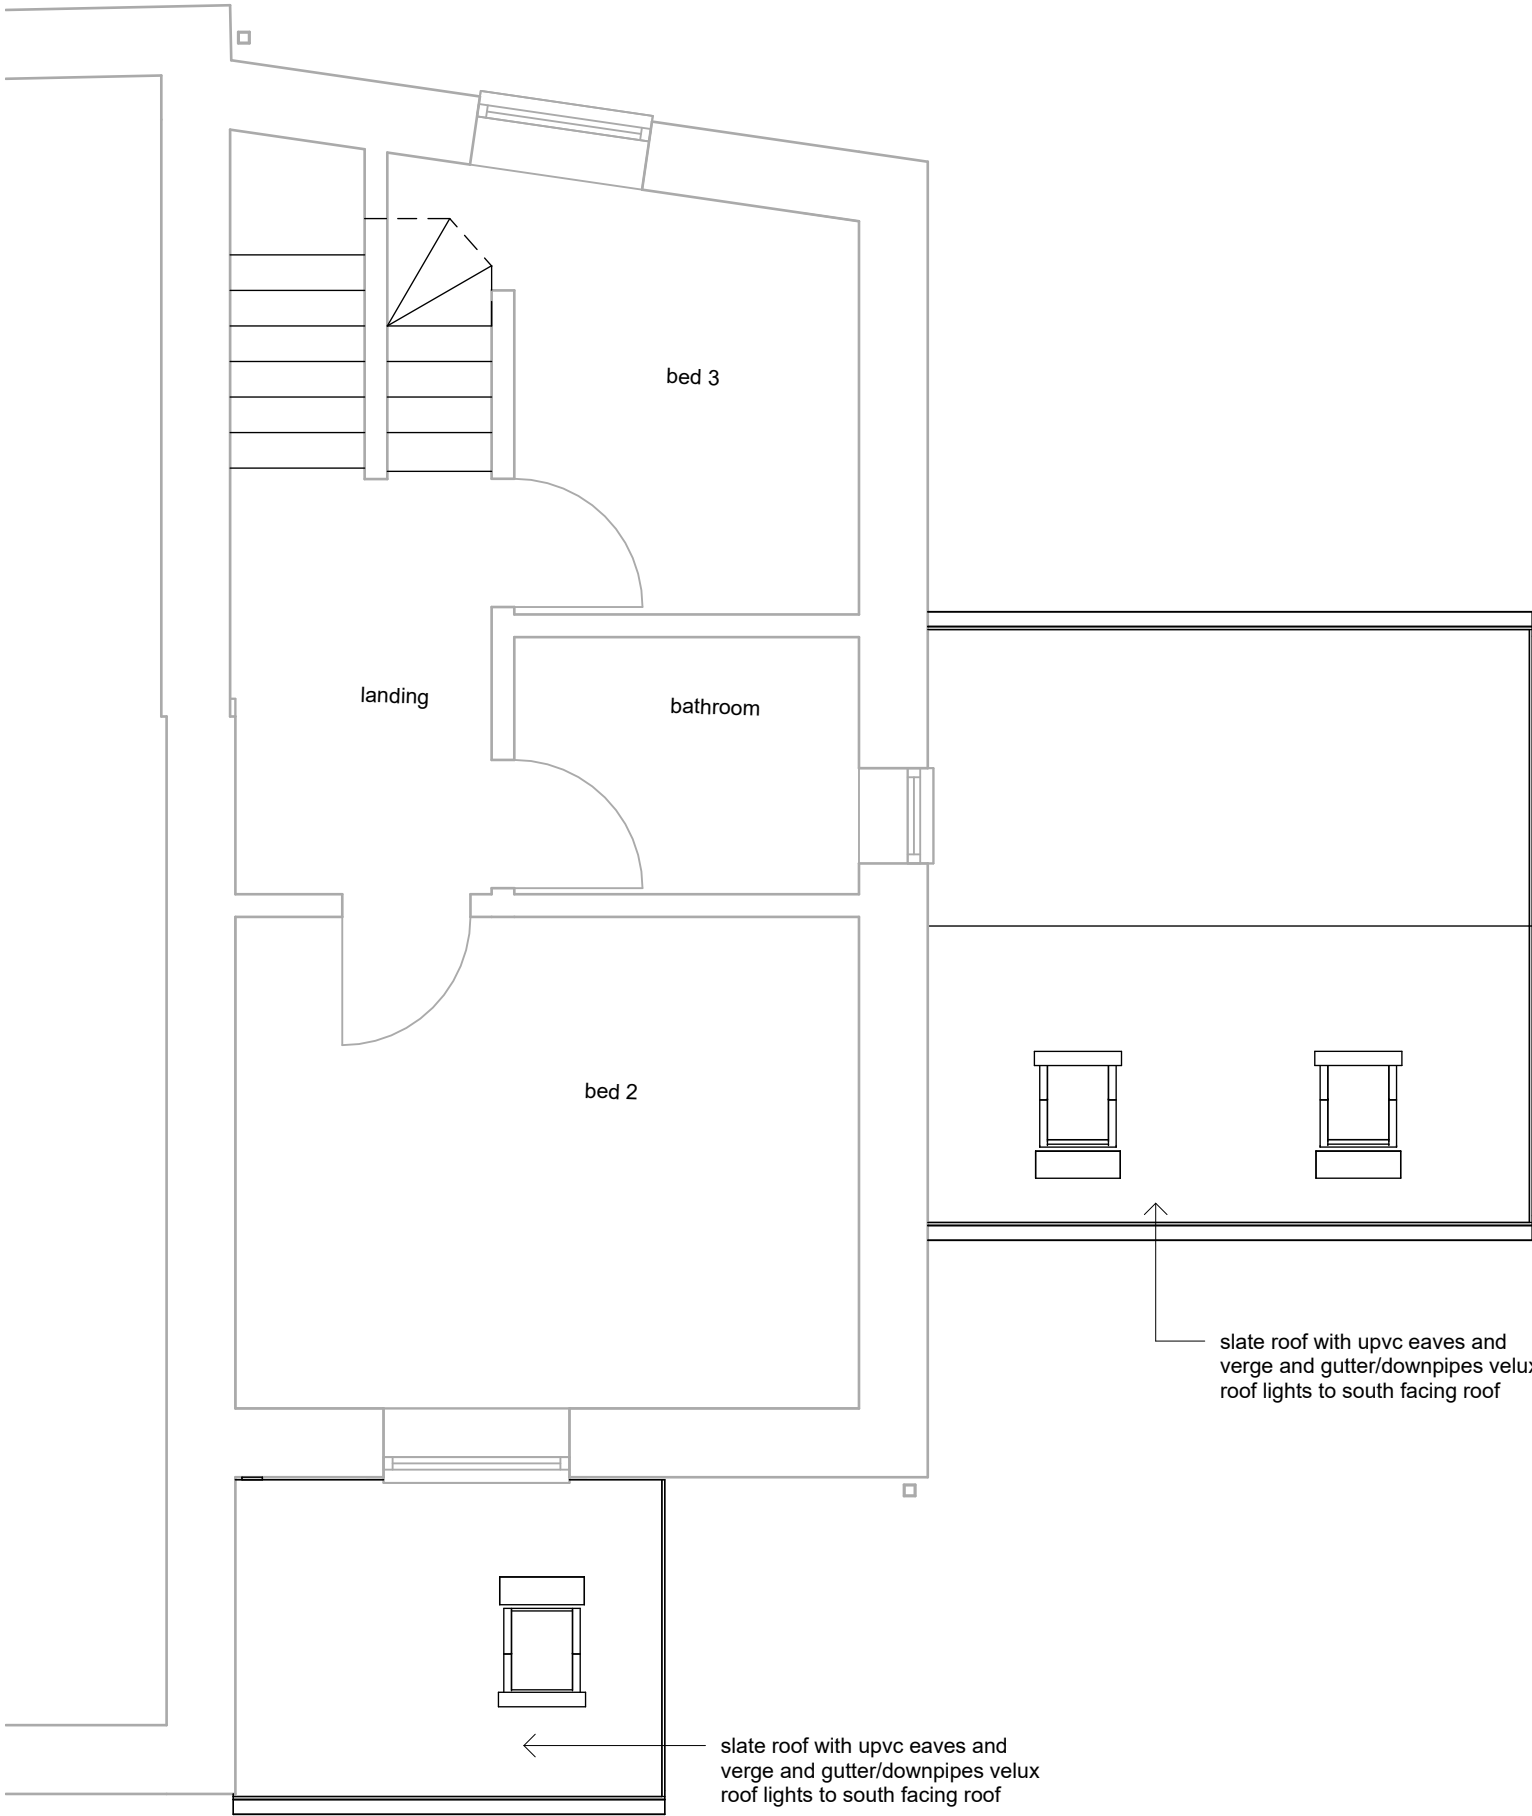

first floor


1 : 50

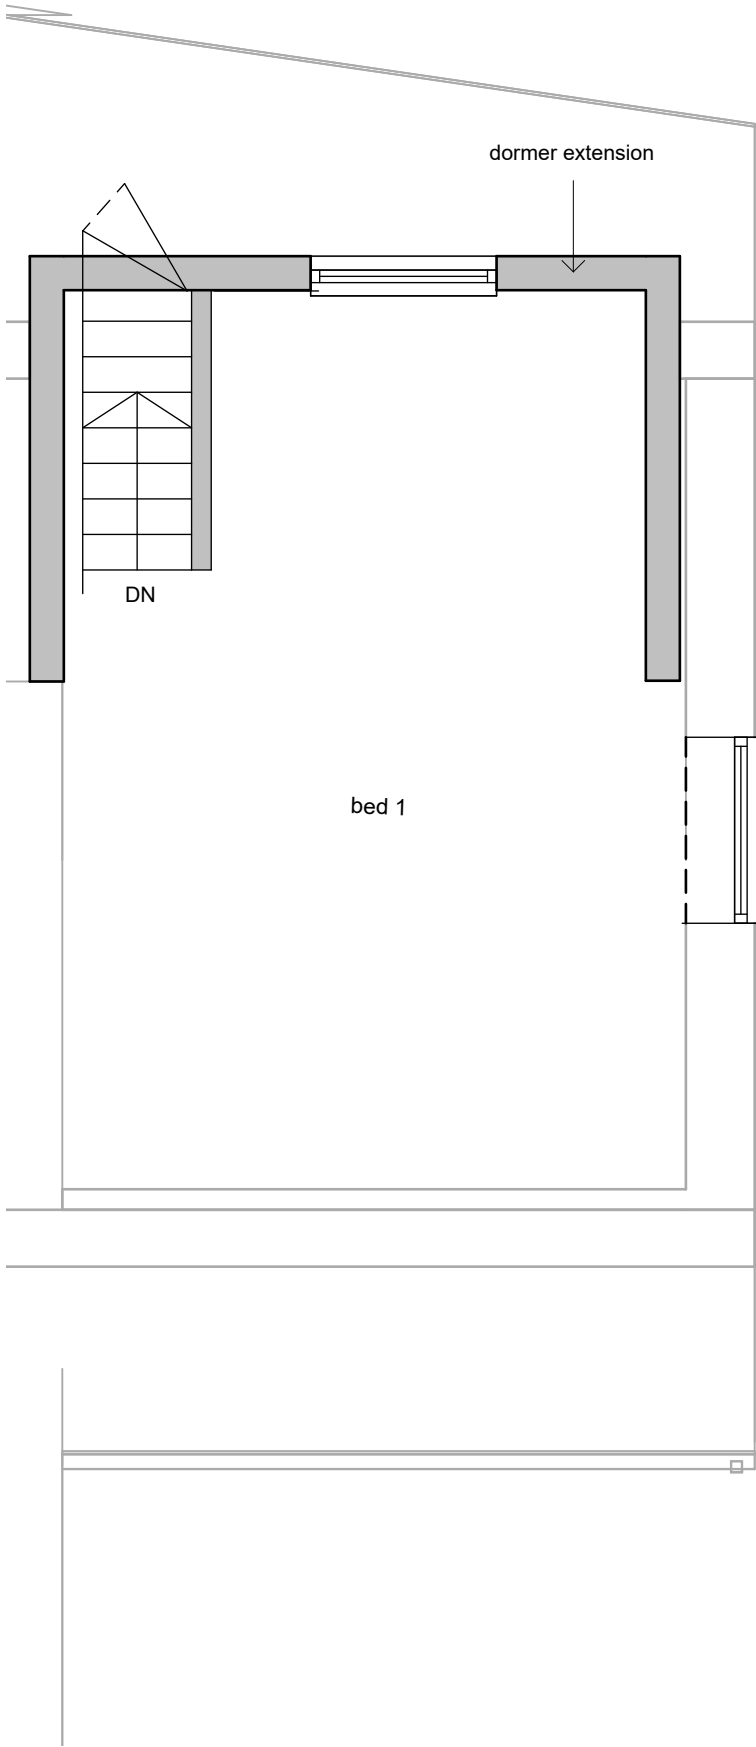

second floor

1 : 50

SCALE 1:50

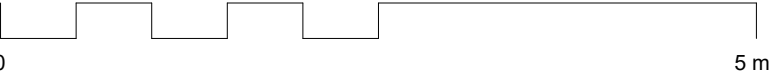

job no
21.01

drawing number
P3 D

title
**First Floor +
Second Floor**

scale
1 : 50

notes:
REV D: updated to indicate as built

planning

project
**House Extension
and Alterations**
**39 Bye Road,
Ramsbottom, Bury**
FORM ARCHITECTS Ltd

t - 0161 236 3669
e - info@formarchitects.co.uk

date
28/04/2023

do not scale this drawing

this drawing is the property of
FORM ARCHITECTS LTD and
copyright is reserved by them
the drawing is not to be copied or
disclosed to any unauthorized
person without express
and prior written consent