




THE BUILDER MUST CHECK THE SITE AND THE APPROVED DRAWINGS BEFORE COMMENCING THE WORKS AND MUST TAKE ANY WORKING MEASUREMENTS AS NECESSARY. ANY DISCREPANCY IN THE DRAWING MUST BE REPORTED TO THE CLIENT .

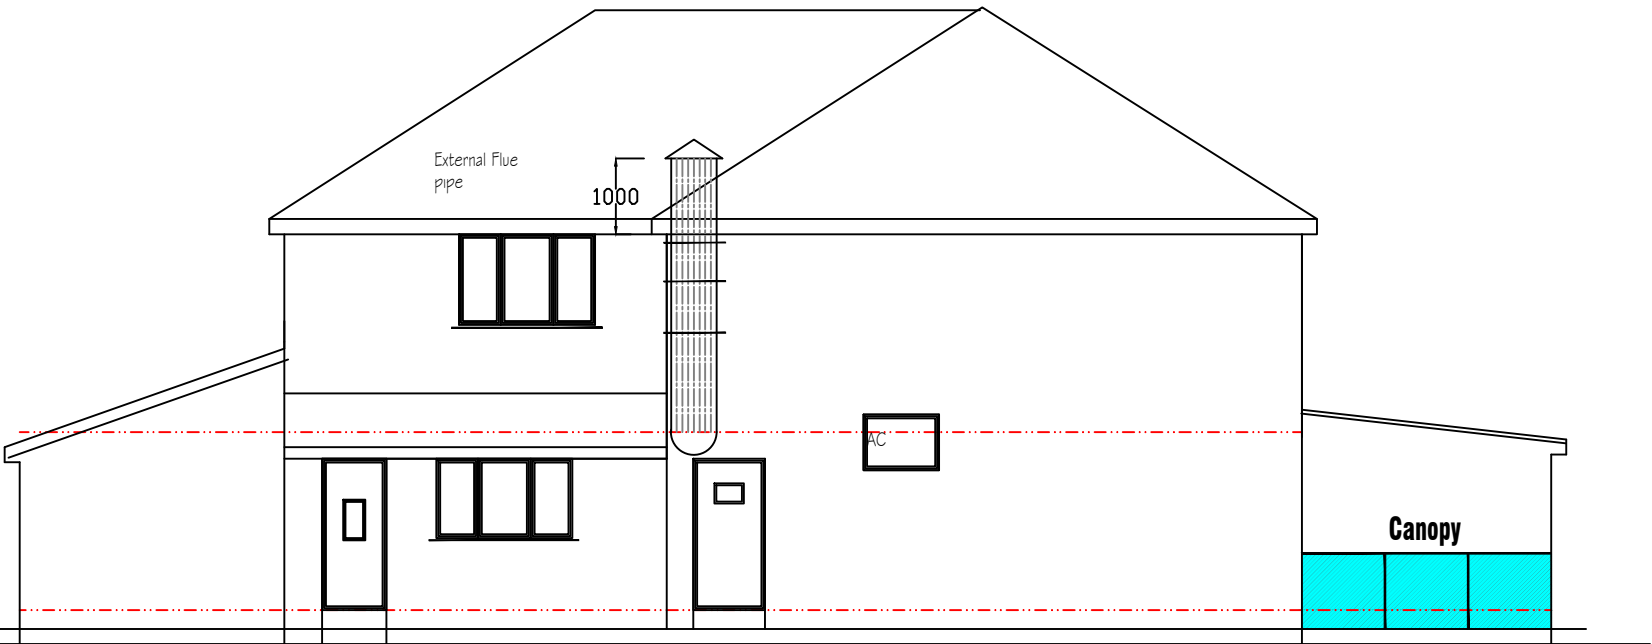


Side Elevation

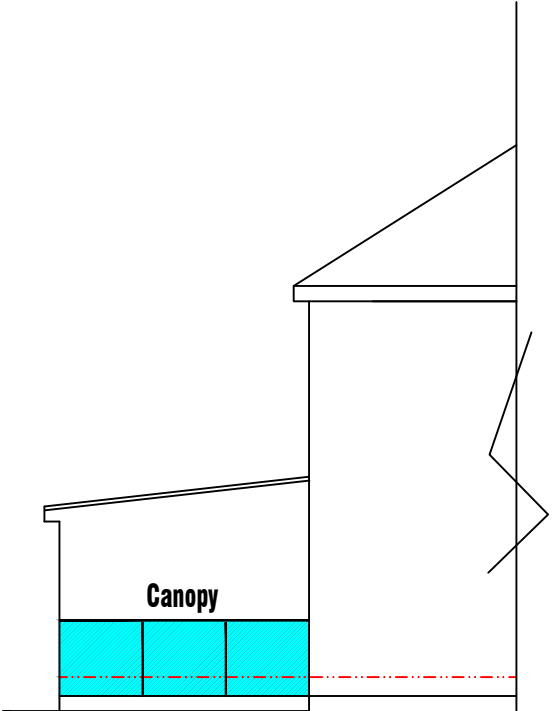

Elevation From No 67

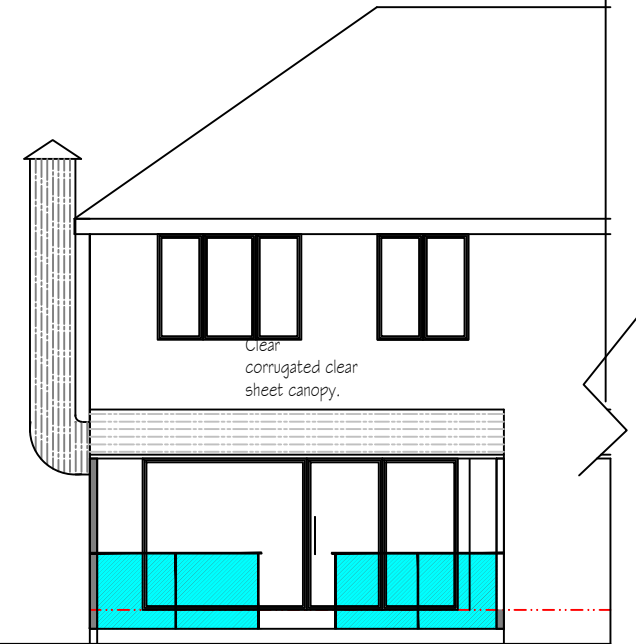

Front Elevation

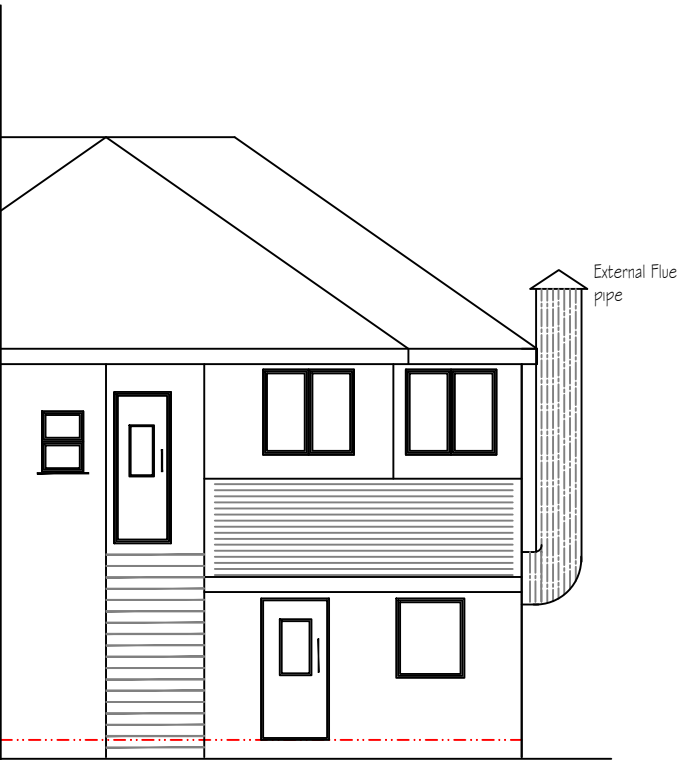

Rear Elevation

Date	Rev	Description	
25.9.23	A	Planning	
24.01.24	B	Planning	
25.01.24	C	Planning	
H S H Engineering Design Services Ltd 428 Cheetham Hill Road Cheetham Manchester M8 9LE. UK 0161 7956385, 07940197 333			
project title	Proposed change of the ground floor from a shop to restaurant including installation of an external flue pipe.		
client	Mr Asim Humza		
dwg. title	As Constructed		
dwg. no.	sheet no.	scale.	job no.
6D.		1:100 ● A3	
65 Windsor Road Pretwich M25 0DB			
drawn by.	checked by.	approved by.	date
TZ			March 2023