



THE BUILDER MUST CHECK THE SITE AND THE APPROVED DRAWINGS BEFORE COMMENCING THE WORKS AND MUST TAKE ANY WORKING MEASUREMENTS AS NECESSARY. ANY DISCREPANCY IN THE DRAWING MUST BE REPORTED TO THE CLIENT .

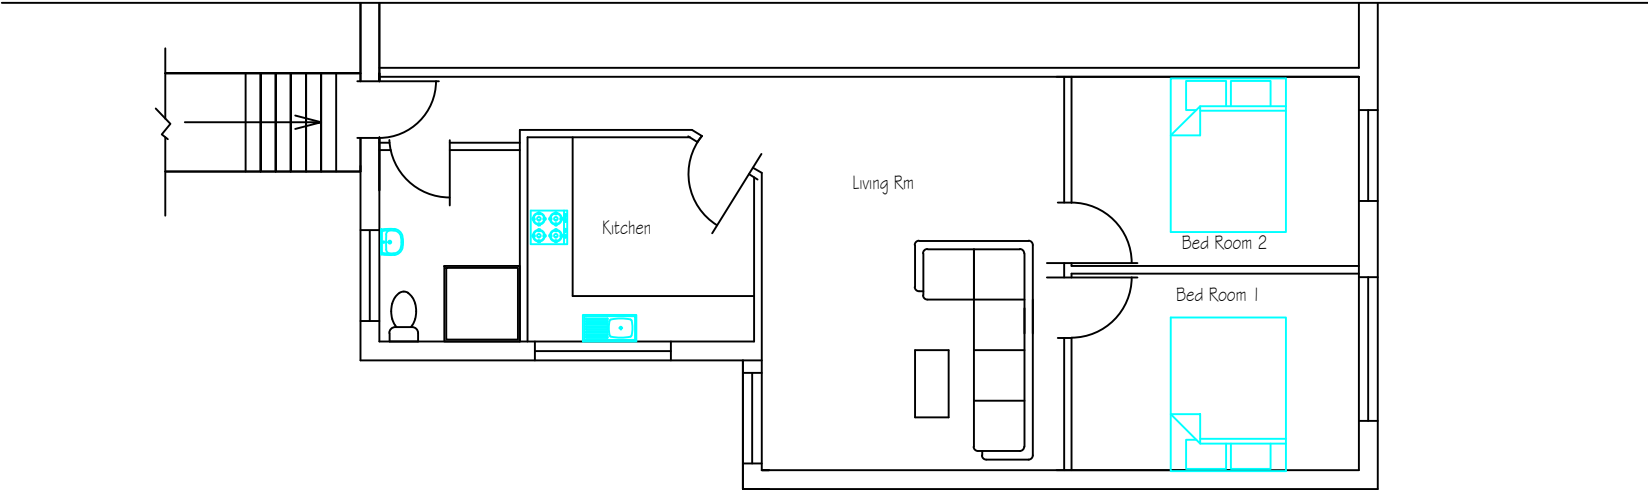

1st Floor Plan

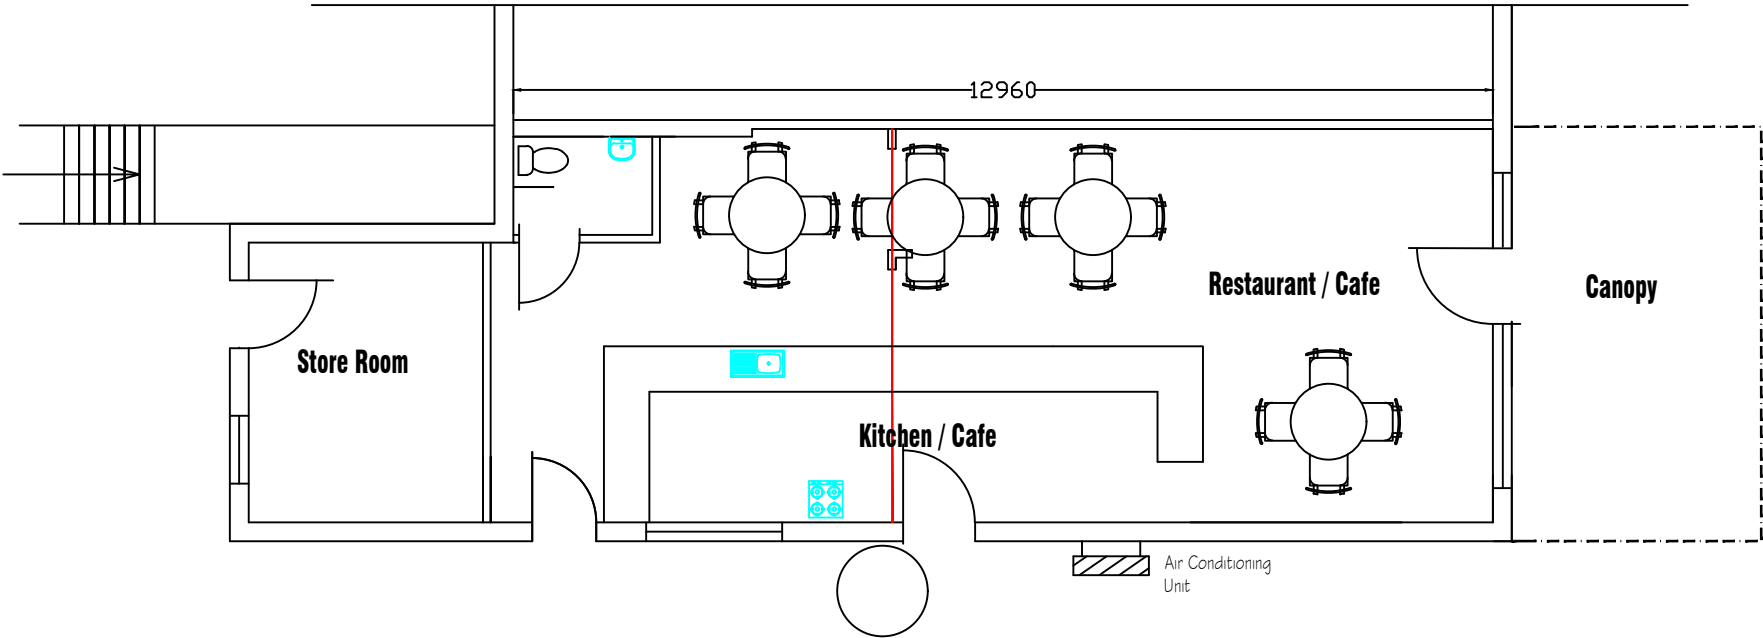

Ground Floor Plan

Date	Rev	Description	
25.9.23	A	Planning	
20/01/25	B	Planning	
16/03/25	C	Planning	
H S H Engineering Design Services Ltd 428 Cheetham Hill Road Cheetham Manchester M8 9LE. UK 01617956385,07940197 333			
project title	Proposed change of the ground floor from a shop to restaurant including installation of an external flue pipe.		
client	Mr Asim Humza		
dwg. title	As Constructed		
dwg.no.	sheet no.	scale.	job no.
5C		1:100 @ A3	
65 Windsor Road Pretwich M25 ODB			
drawn by.	checked by.	approved by.	date
TZ		-	March 2023