


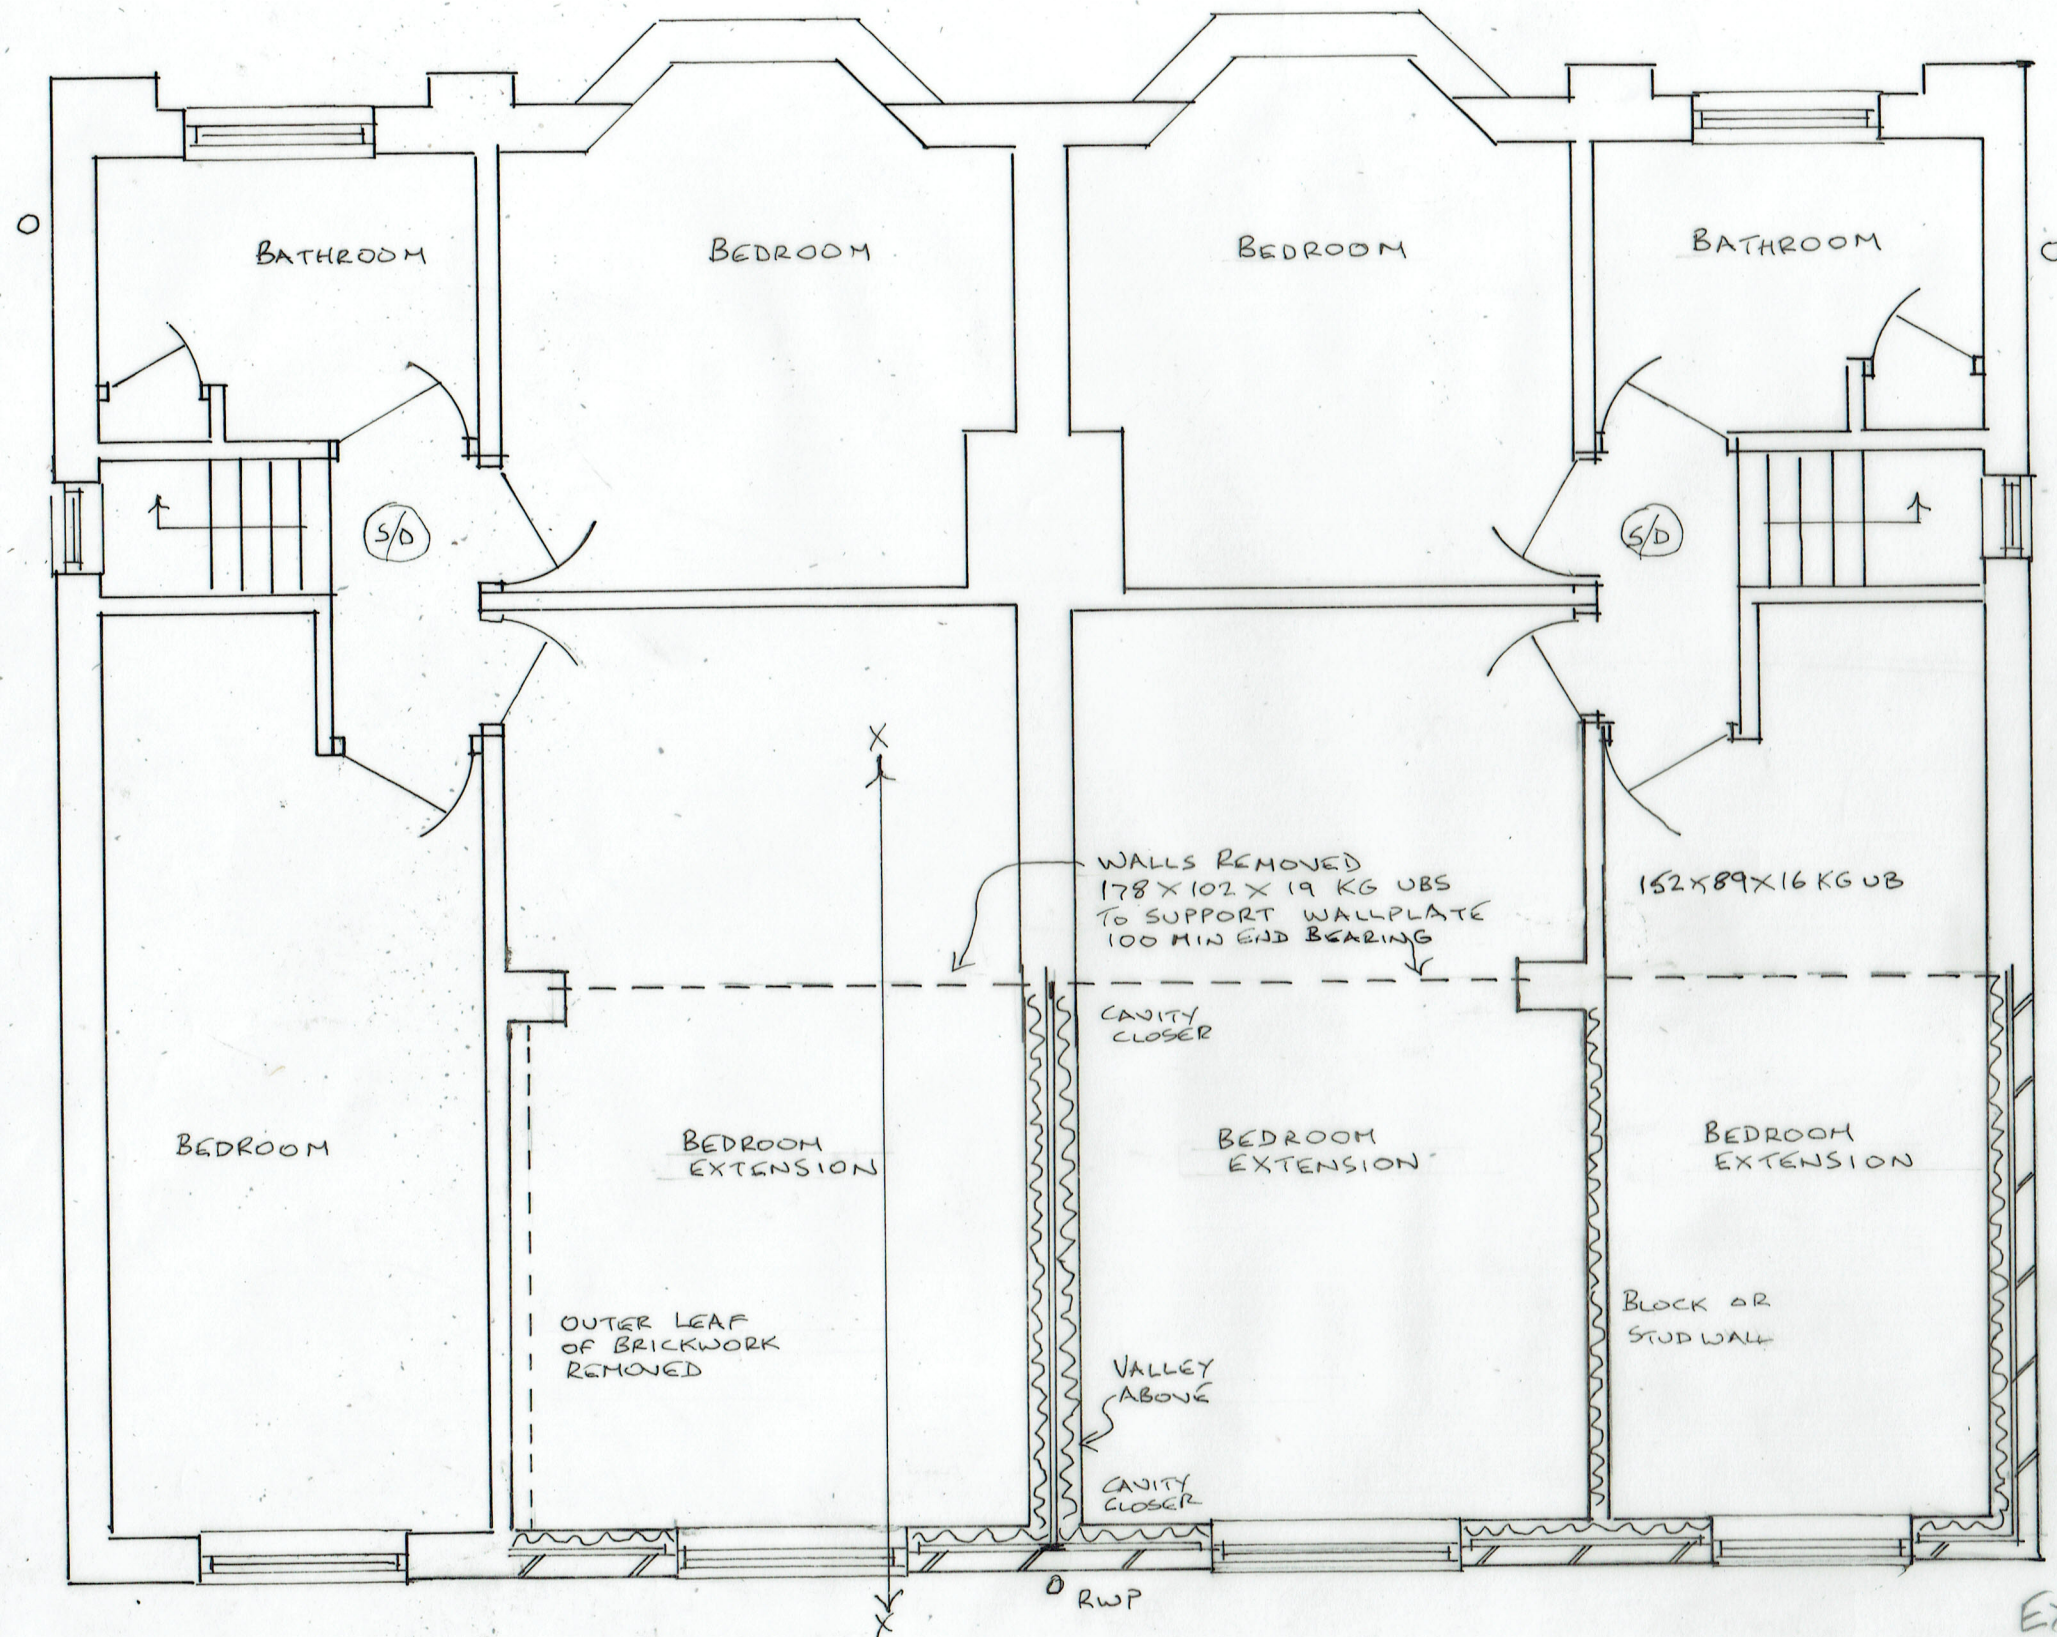

EXISTING
~~4A PROPOSED~~ FIRST FLOOR PLAN
 AS BUILT

18/07/2016 - REGS DETAIL ADDED
 11/05/2016

16/225/04A

TWO STOREY REAR EXTENSION
 183 & 185 PARKHILLS ROAD, BURY BL9 9AF

SCALE 1:50 @ A3