


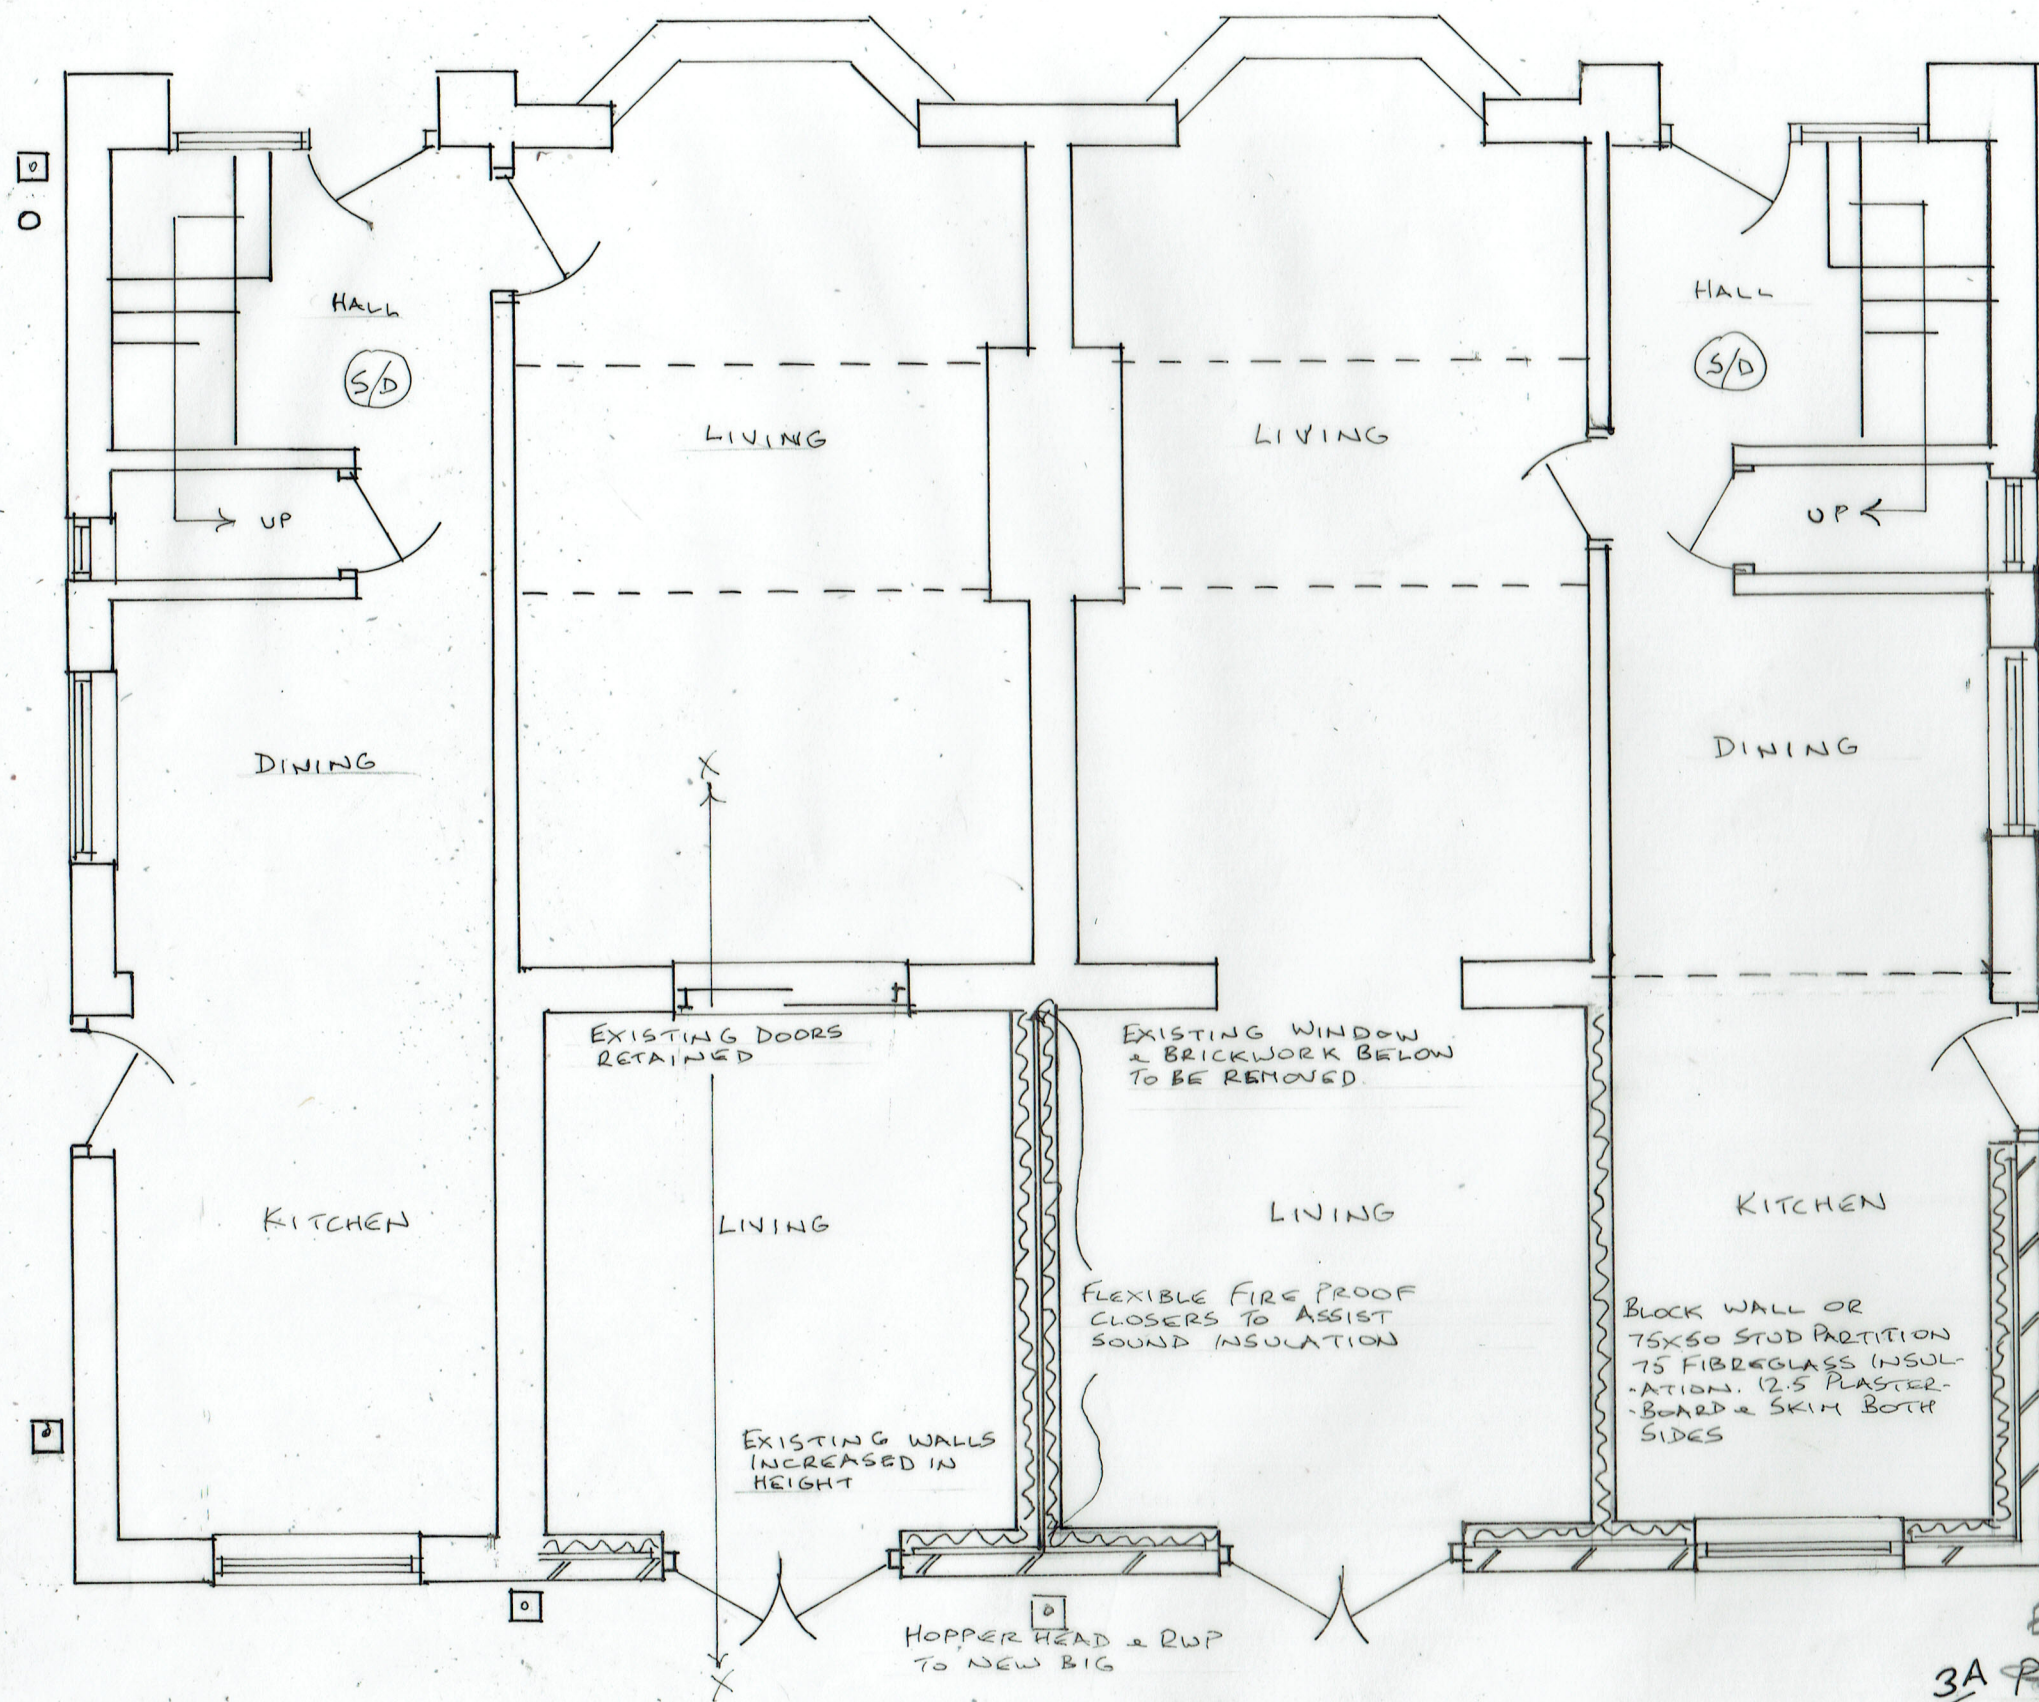

EXISTING WALL REMOVED
178X102X19 KG UB OVER
TO SUPPORT EXISTING &
PROPOSED FLOOR JOISTS
100 MIN END BEARING

38 UPVC SINK WASTE, 75 DEEP SEAL
ANTI-VAC TRAP TO RELOCATED B.I.G.
EXISTING COMBINED DRAINS. ROUTES
SUBJECT TO ON SITE INVESTIGATION

MECHANICAL VENTILATION MIN
60 LITRES/SEC

HEAT DETECTOR RECOMMENDED

EXISTING
3A PROPOSED GROUND FLOOR PLAN
AS BUILT

18/07/2016 - REGS DETAIL ADDED
11/05/2016

16/225/03

SCALE 1:50 @ A3

TWO STOREY REAR EXTENSION
183 & 185 PARKHILLS ROAD, BURY BL9 9AF