

job no

21.01

drawing number

P4 E

title


front elevation

scale

1 : 50

notes:

REV E: updated to indicate as built

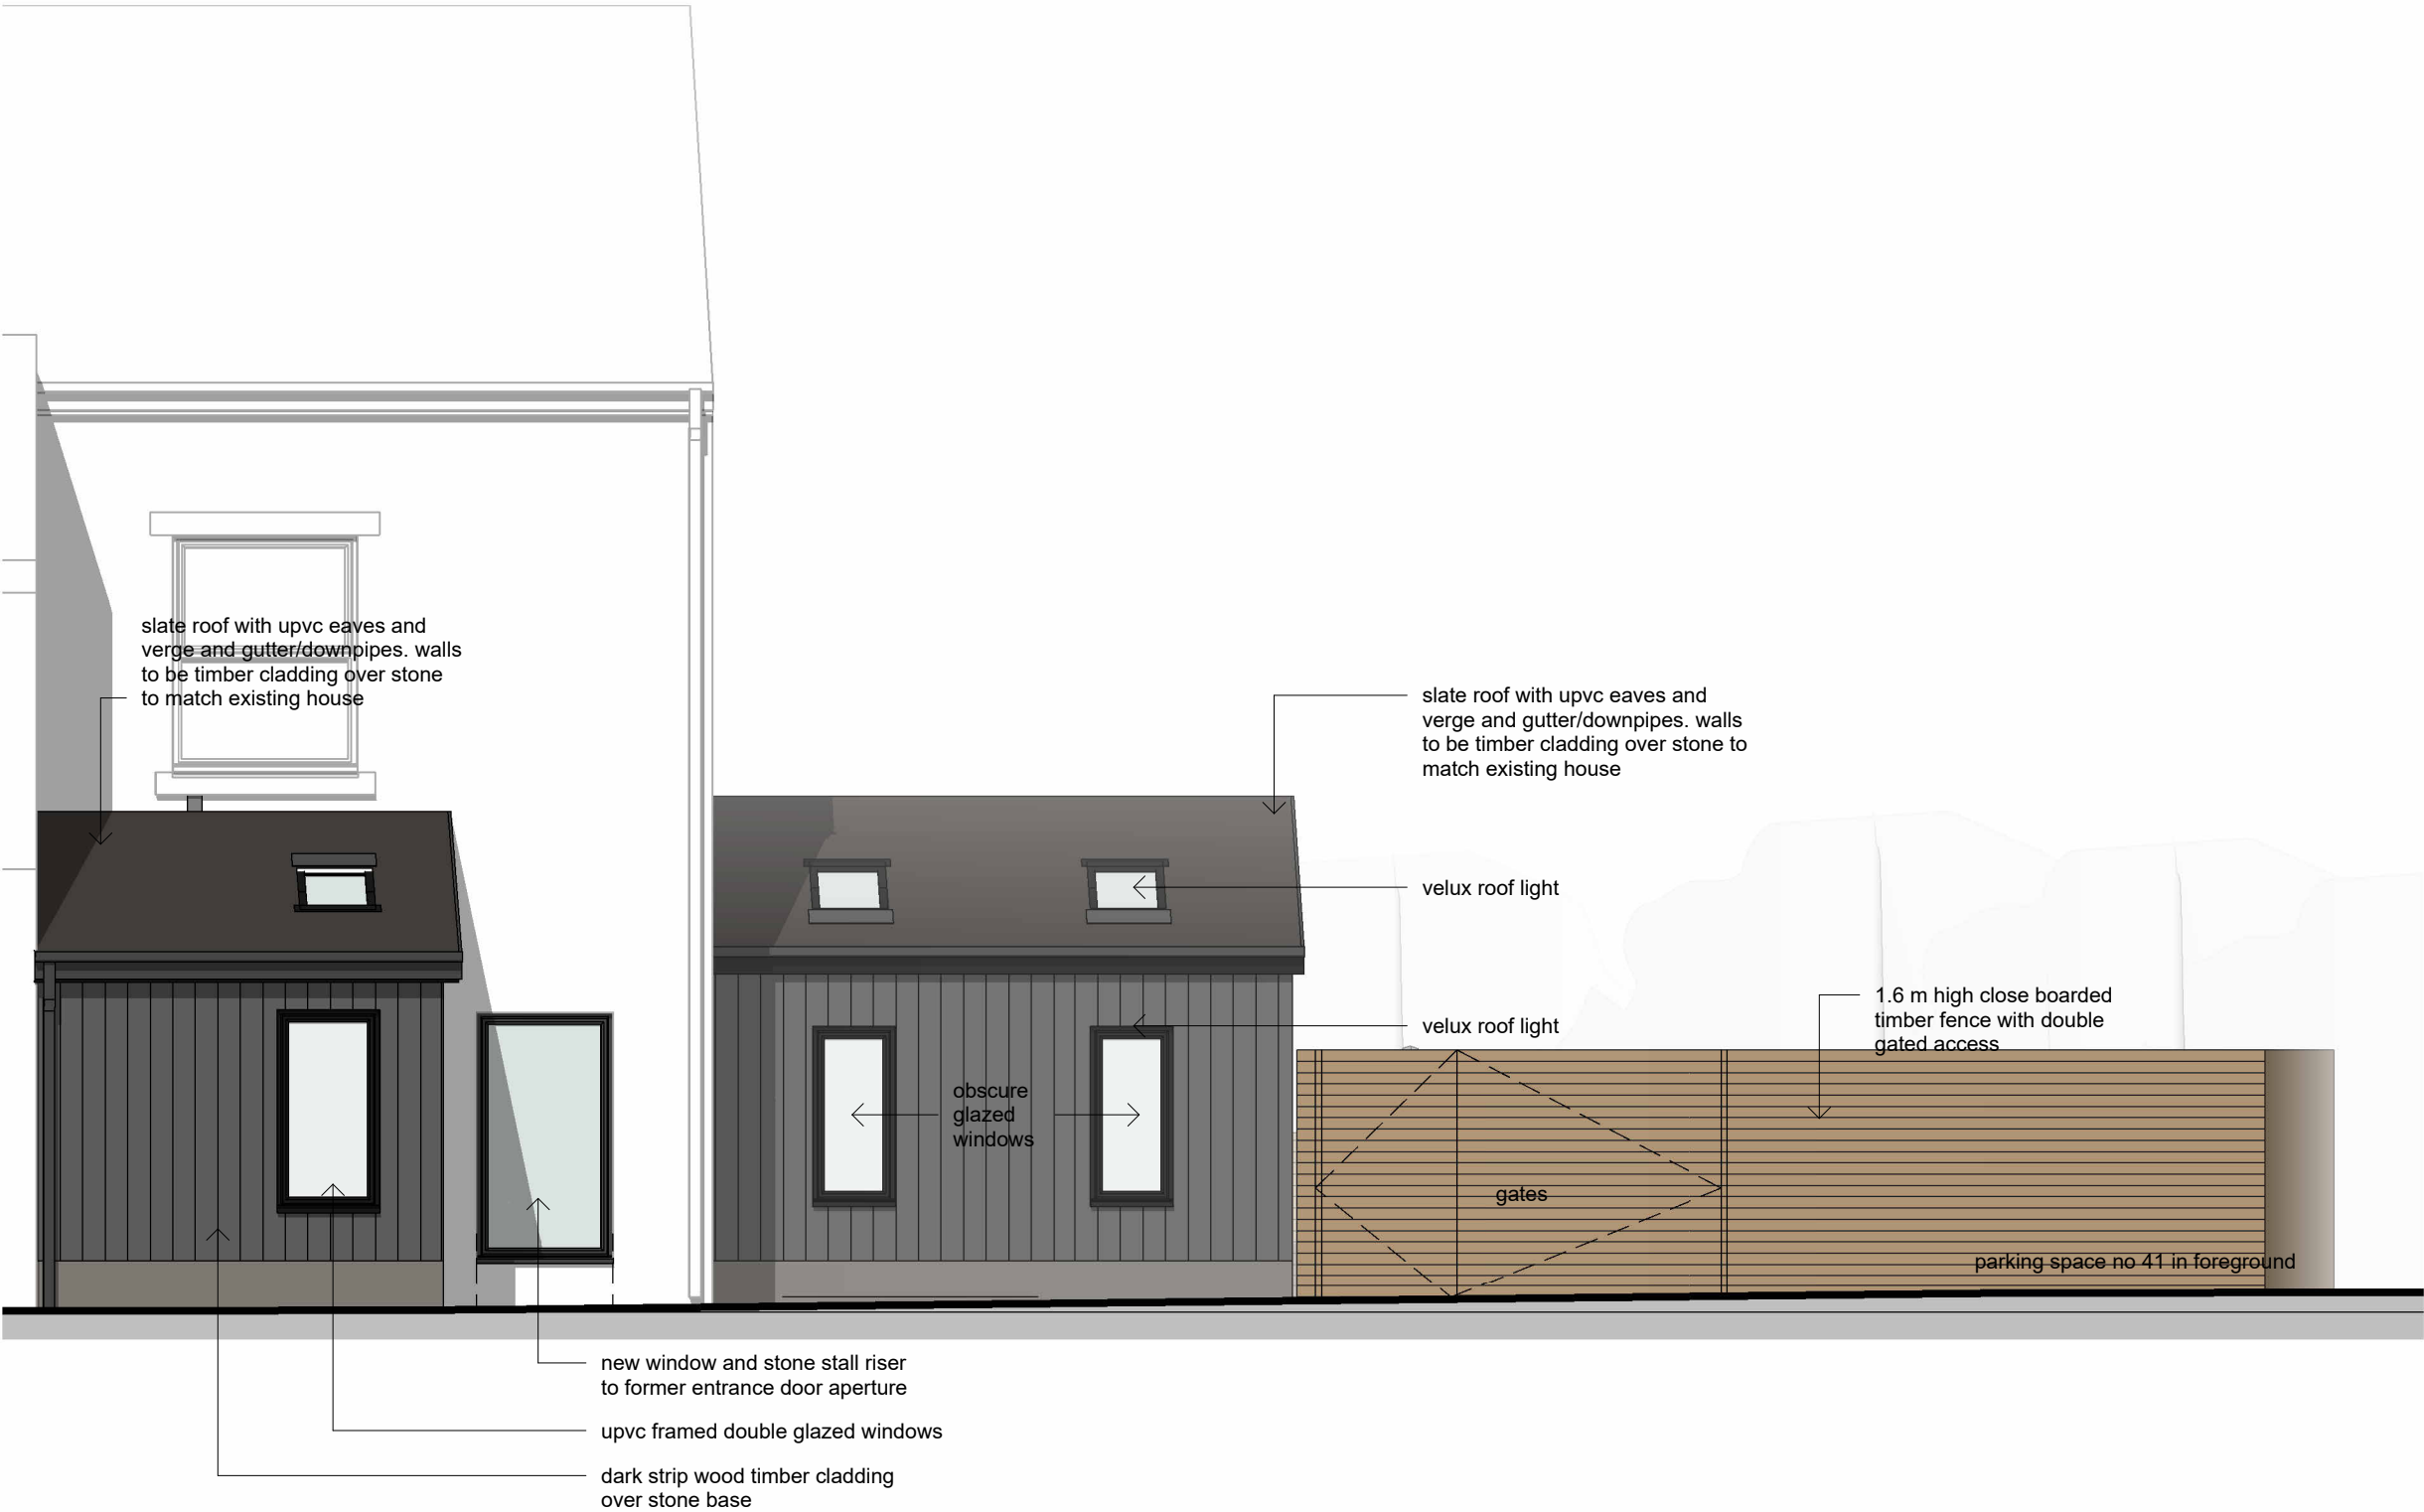

planning

project

House Extension and Alterations

39 Bye Road, Ramsbottom, Bury

FORM ARCHITECTS Ltd

t - 0161 236 3669

e - info@formarchitects.co.uk

date

28/04/2023

do not scale this drawing

this drawing is the property of FORM ARCHITECTS LTD and copyright is reserved by them the drawing is not to be copied or disclosed to any unauthorized person without express and prior written consent

SCALE 1:50

