

THIS DRAWING IS PROTECTED BY COPYRIGHT AND MUST NOT BE COPIED OR REPRODUCED WITHOUT THE WRITTEN CONSENT OF R G PARTNERSHIP LIMITED. NO DIMENSIONS ARE TO BE SCALED FROM THIS DRAWING. ALL DIMENSIONS AND SIZES TO BE CHECKED ON SITE. NORTH POINTS SHOWN ARE INDICATIVE. ©

SITE SPECIFIC HAZARDS

IN ACCORDANCE WITH THE REQUIREMENTS OF THE CDM REGULATIONS 2015 THE FOLLOWING SIGNIFICANT RESIDUAL HAZARDS HAVE NOT BEEN DESIGNED OUT OF THIS PROJECT AND MUST BE TAKEN INTO CONSIDERATION BY CONTRACTORS PLANNING TO UNDERTAKE THE WORKS SHOWN ON THIS DRAWING:

NOTES:

THIS DRAWING TO BE READ IN CONJUNCTION WITH ALL CONSULTANTS AND SPECIALIST DRAWINGS.

THIS DRAWING IS BASED UPON:

- 1) TOPOGRAPHICAL AND PLAN SURVEYS BY: G J BROOKES LTD
DRAWING REF: 210124 / TOP
DATE: JANUARY 2024
- 2) ORDNANCE SURVEY MAP
- 3) LAND REGISTRY PLAN PROVIDED BY CLIENT

THE FINISHED FLOOR LEVEL (FFL) IS BASED ON INITIAL TOPOGRAPHICAL SURVEY INFORMATION. IT IS STRONGLY ADVISED THAT A COMPREHENSIVE MEASURED SURVEY BE CONDUCTED BY A QUALIFIED CHARTERED LAND SURVEYOR PRIOR TO CONSTRUCTION TO ENSURE COMPLIANCE WITH REGULATORY STANDARDS.

NEW FOUNDATION AND STRUCTURES TO STRUCTURAL ENGINEER'S DESIGN AND DETAIL.

EXTERNAL MATERIALS AND FINISHES

A - RED FACING BRICKWORK.

B - FEATURE DARK / BLACK FACING BRICKWORK.

C - ROCKPANEL NATURAL STONES PREMIUM CLADDING, 11MM THICK, CONCEALED FIXING SYSTEM, COLOUR AMBER BROWN.

D - PPC ALUMINIUM CURTAIN WALLING AND ASSOCIATED FRAMING, ANTHRACITE GREY RAL 7016.

E - NEW AND REPLACEMENT WINDOWS, FRAME MATERIAL AND FINISH - PPC ALUMINIUM RAL 7016

F - NEW EXTERNAL DOORS, MATERIAL AND FINISH - PPC ALUMINIUM RAL 7016

G - NATURAL SLATE ROOF COVERING.

H - SINGLE-PLY MEMBRANE FLAT ROOF.

I - PROPRIETARY ROOFLIGHTS, GENERALLY VELUX MK06 OR EQUAL, LOCATED AS SHOWN.

J - PHOTOVOLTAIC PANELS LOCATED GENERALLY AS SHOWN ON THE ROOF PLAN.

K - PPC ALUMINIUM RAINWATER GOODS, ANTHRACITE GREY RAL 7016.

L - PPC ALUMINIUM SOIL VENT PIPES, ANTHRACITE GREY RAL 7016.

M - UPVC FASCIAS. ANTHRACITE GREY RAL 7016.

REV.	DATE	NOTES	INIT.
------	------	-------	-------

CLIENT / PROJECT

MRS. S. BEGUM
THE GATEHOUSE,
WOODHILL ROAD, BURY
DRAWING TITLE

PROPOSED VS EXISTING ELEVATIONS
(AS APPROVED "71598")

STATUS

PLANNING

DATE	DRAWN	SCALE @ A2
JULY '26	DB	1:100

PROJECT NUMBER	UNIT / BLOCK	CI / SFB CODE	TYPE & NUMBER	REVISION LETTER
11527				

DRAWING NO. PL10

Site Location Plans	L	GA Plans	P	Elevations	E
Sections	S	Details	D	Prefic, Colour	C

THE RATCLIFFE GROVES PARTNERSHIP
MANCHESTER
105 MANCHESTER ROAD
BURY LANCASHIRE BL9 0TD
T. 0161 797 6000 E. manchester@rgp.uk.com
www.rgp.uk.com

LONDON
19 BEDFORD ROW
LONDON WC1R 4EB
T. 020 7600 6666 E. london@rgp.uk.com




DASHED RED LINE DENOTES EXTENTS OF
APPROVED ELEVATION DRAWING
"71598-REVISED PLAN-02102025(2)"




FRONT ELEVATION

DASHED RED LINE DENOTES EXTENTS OF
APPROVED ELEVATION DRAWING
"71598-REVISED PLAN-02102025(2)"

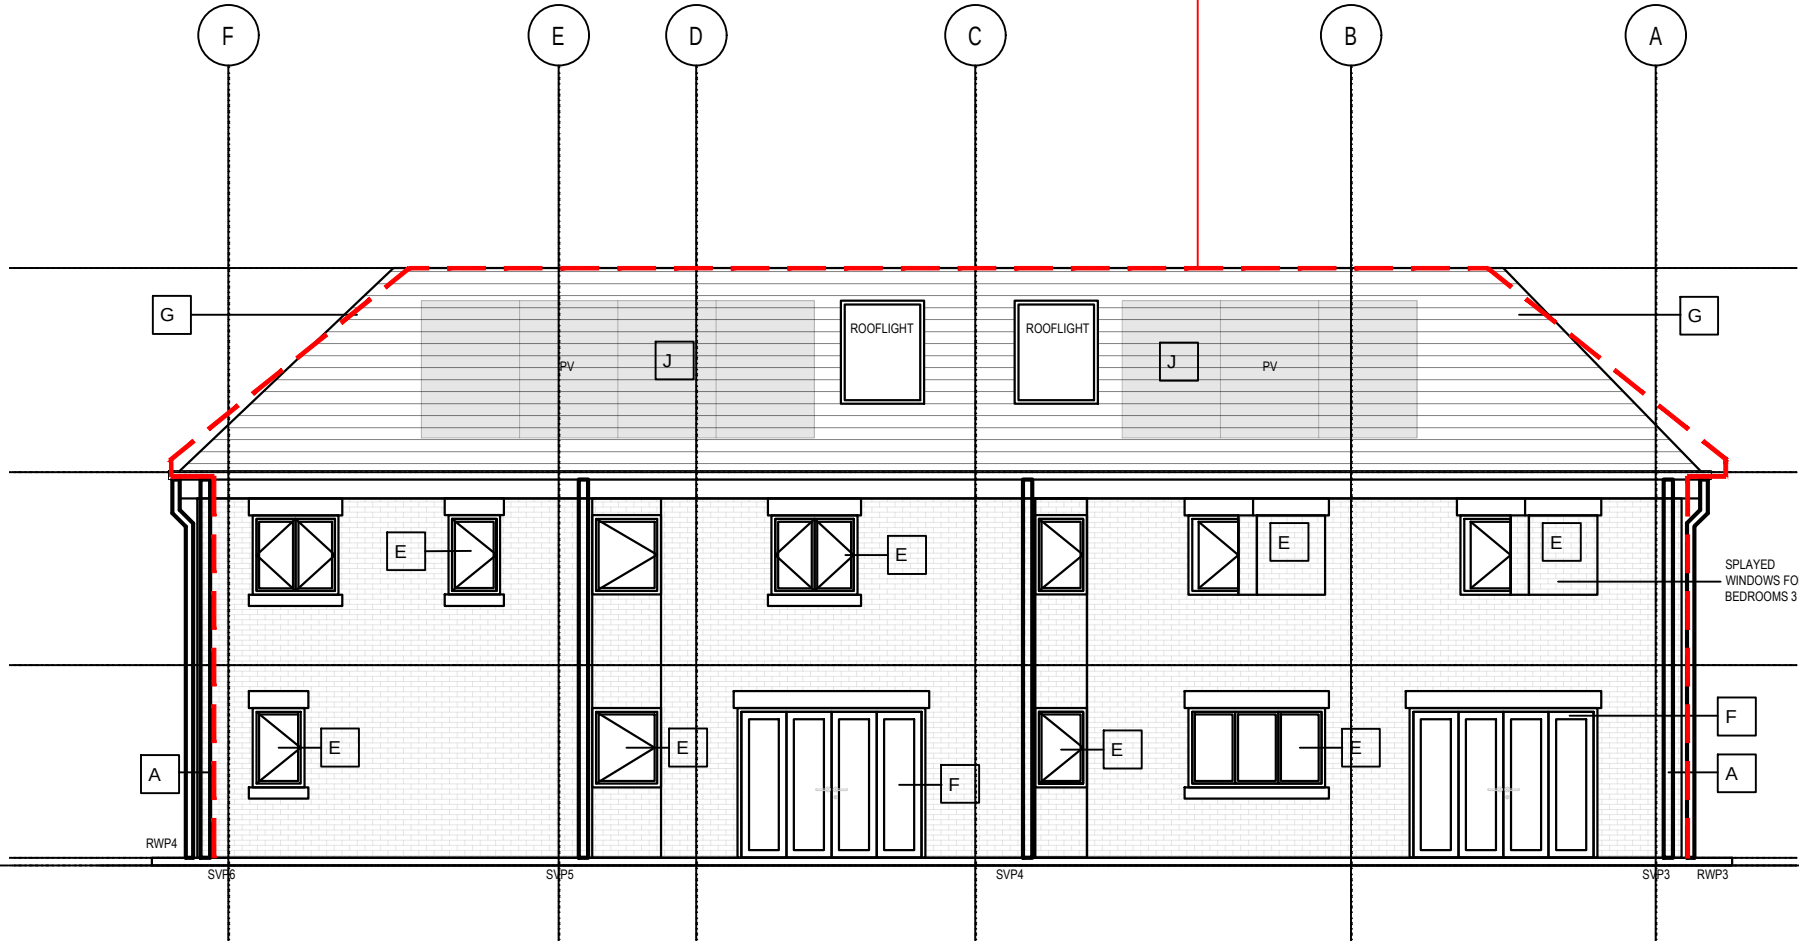


REAR ELEVATION

DASHED RED LINE DENOTES EXTENTS OF
APPROVED ELEVATION DRAWING
"71598-REVISED PLAN-02102025(2)"

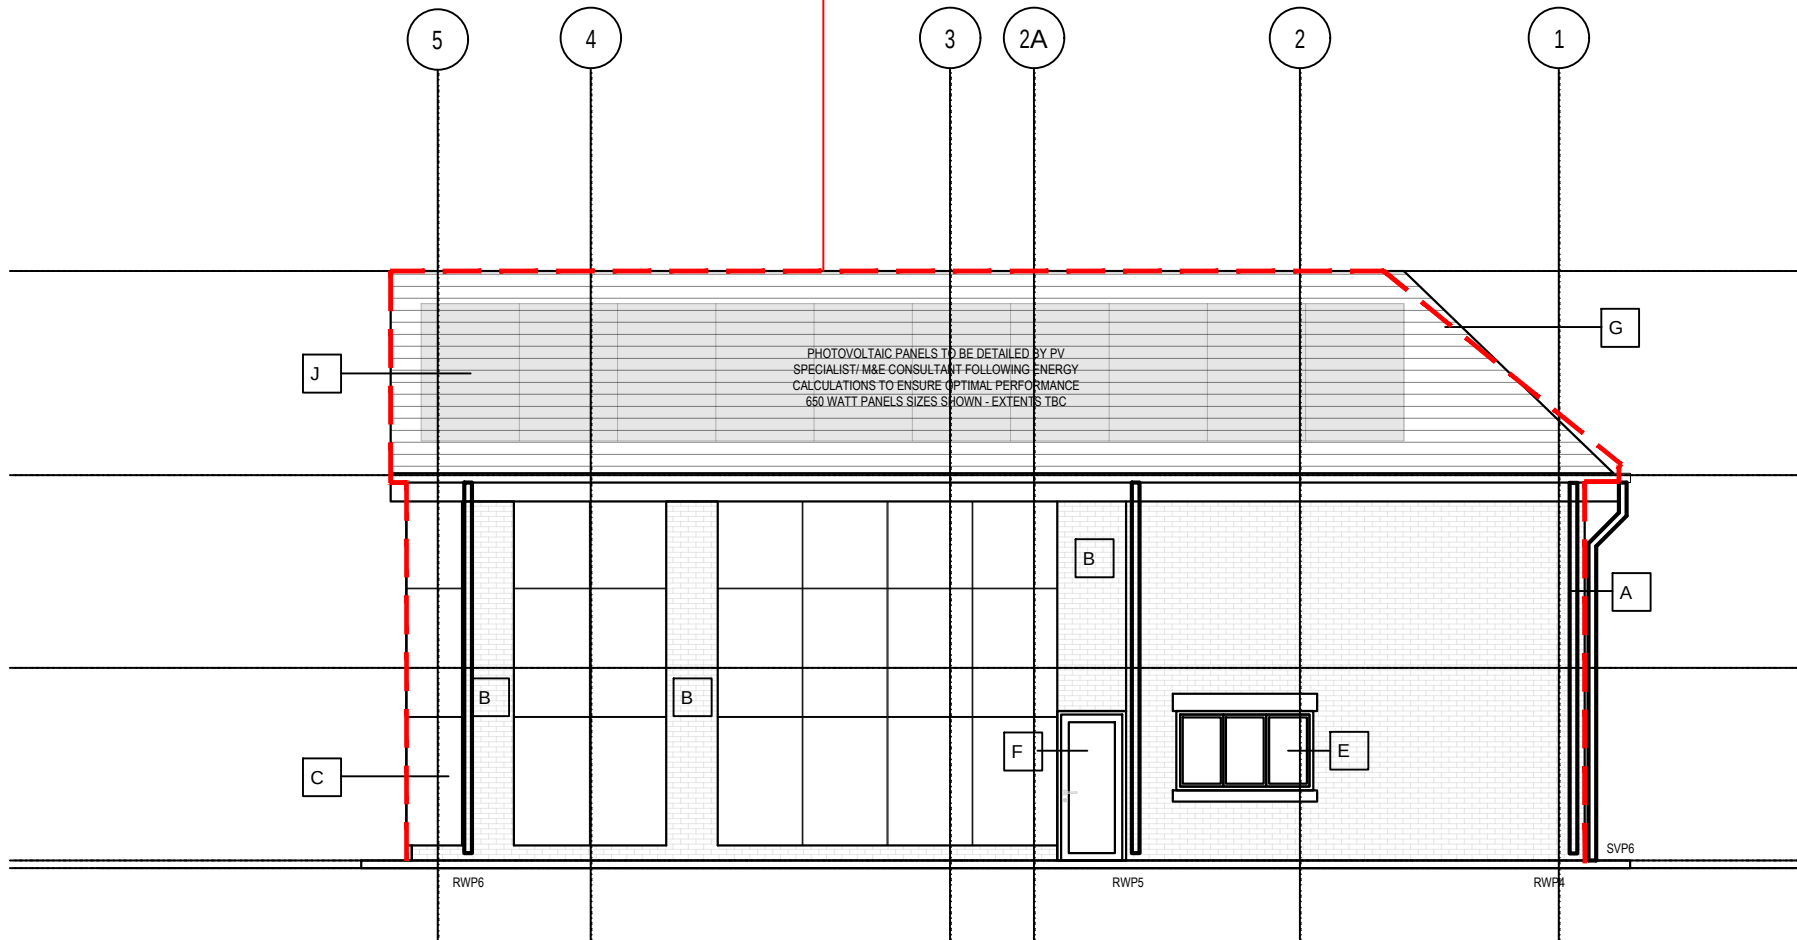

SIDE 1 ELEVATION

DASHED RED LINE DENOTES EXTENTS OF
APPROVED ELEVATION DRAWING
"71598-REVISED PLAN-02102025(2)"

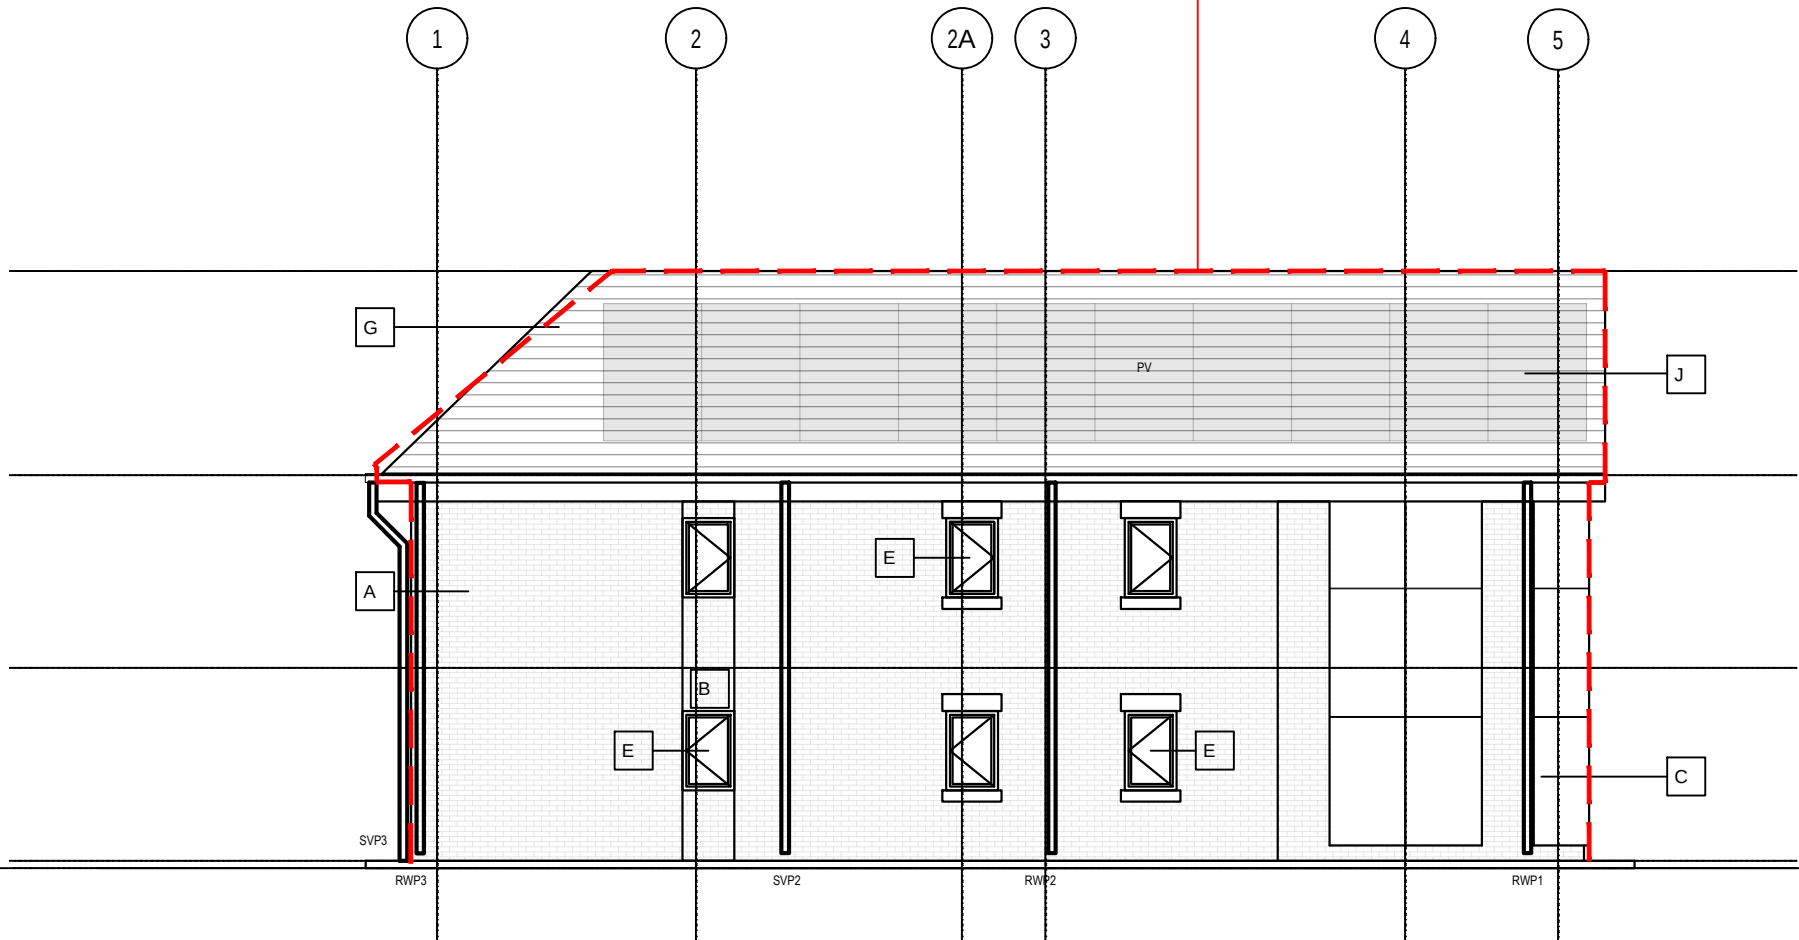

SIDE 2 ELEVATION

SCALE 1:100
0m 1 2 3 4 5 6