

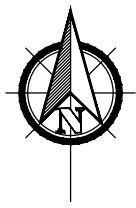


general notes:
copyright reserved to mck associates ltd. and this
drawing may not be used or reproduced without prior
written consent.

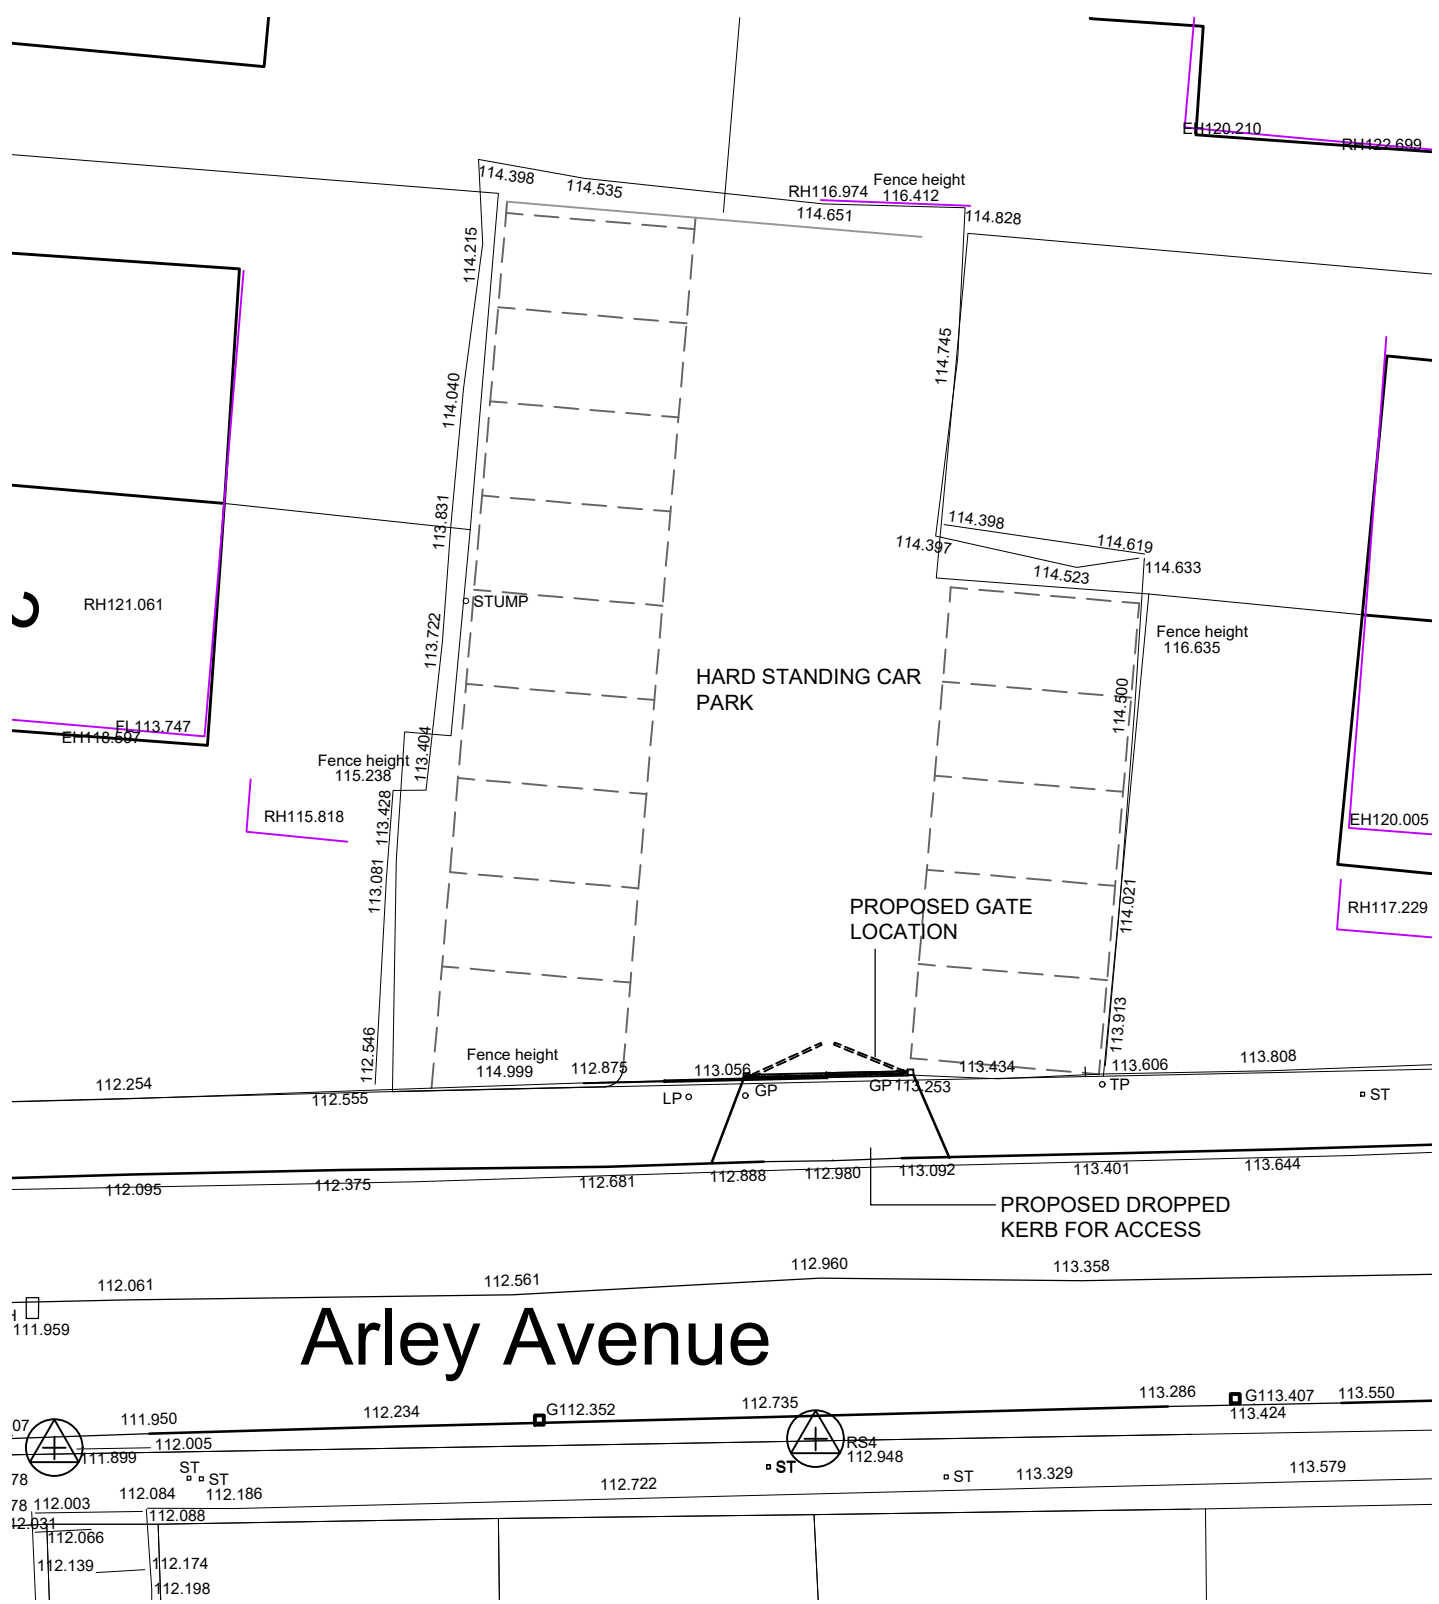


Arley Avenue


SITE PLAN
SCALE 1:200

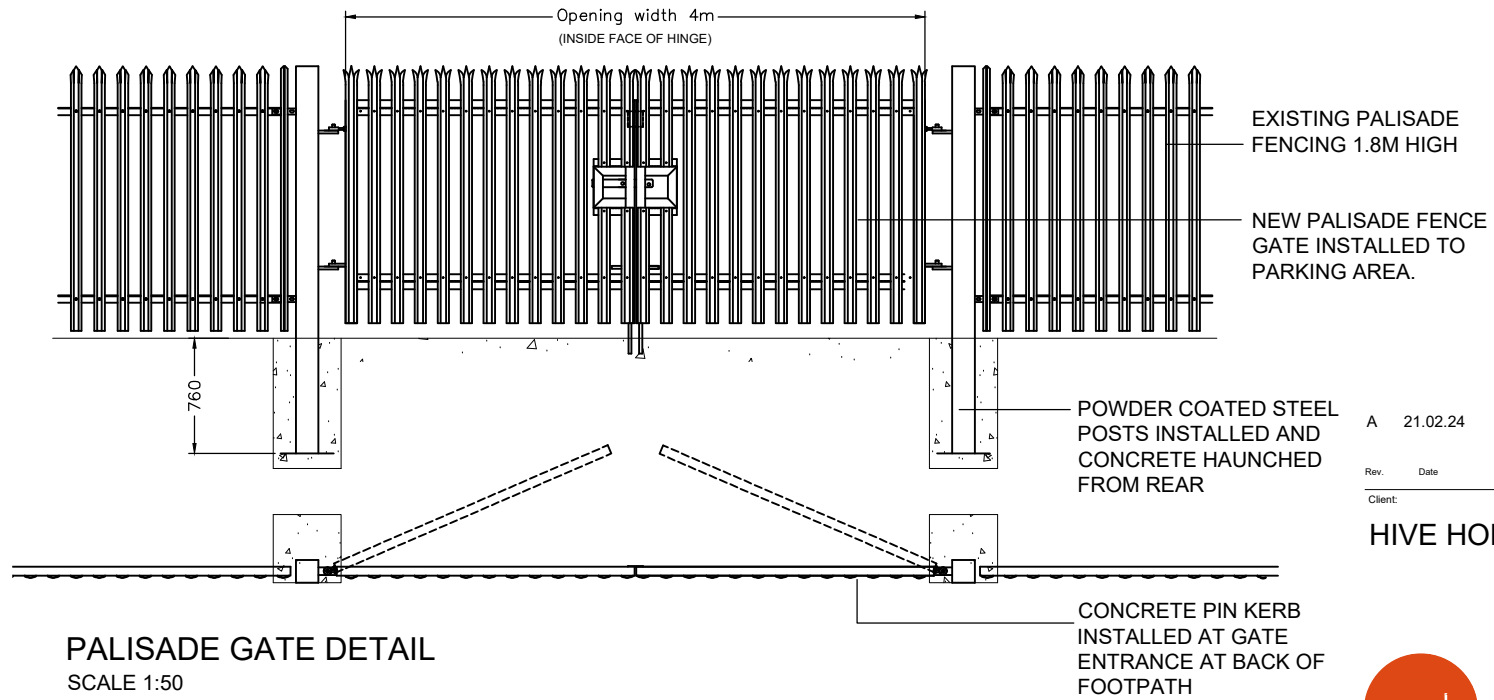

PALISADE GATE DETAIL
SCALE 1:50

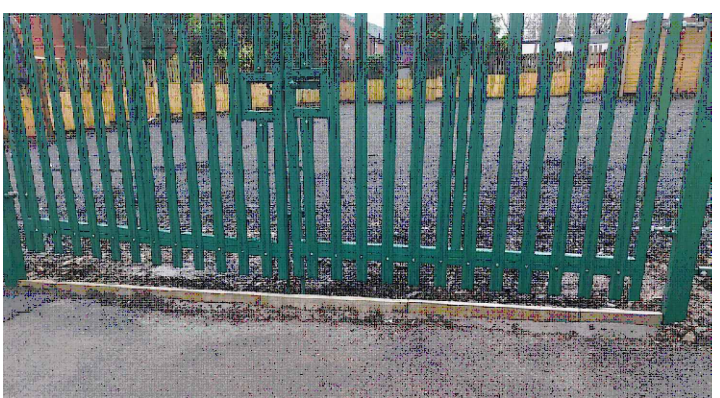

PROPOSED PALISADE GATE 1.8M HIGH
(AS INSTALLED)

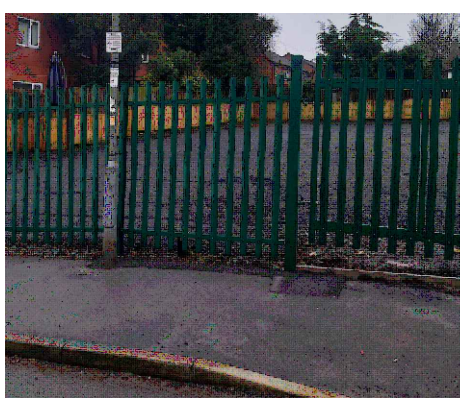

PROPOSED PALISADE GATE INSTALLED WITHIN
EXISTING FENCING 1.8M HIGH
(AS INSTALLED)

Rev.	21.02.24	AT	Updated parking arrangement and gate opening
------	----------	----	--

Client:	HIVE HOMES
---------	------------

mck associates limited
architecture ■ building surveying ■ urban design
burnaby villa ■ 48 watling street road ■ fulwood ■ preston ■ pr2 8bp
tel: 01772 774510 fax: 01772 774511 email mck@mckassociates.co.uk

Project:
ARLEY AVENUE
BURY

Drawing Title:
PROPOSED ACCESS GATE DETAILS

Drawn: SK	Checked:	Scale @ A3: 1:200 / 1:50	Date: JAN 24
Job No: 23-015	Drawing No: PL-DET-01	Rev: A	

A3

PLANNING