





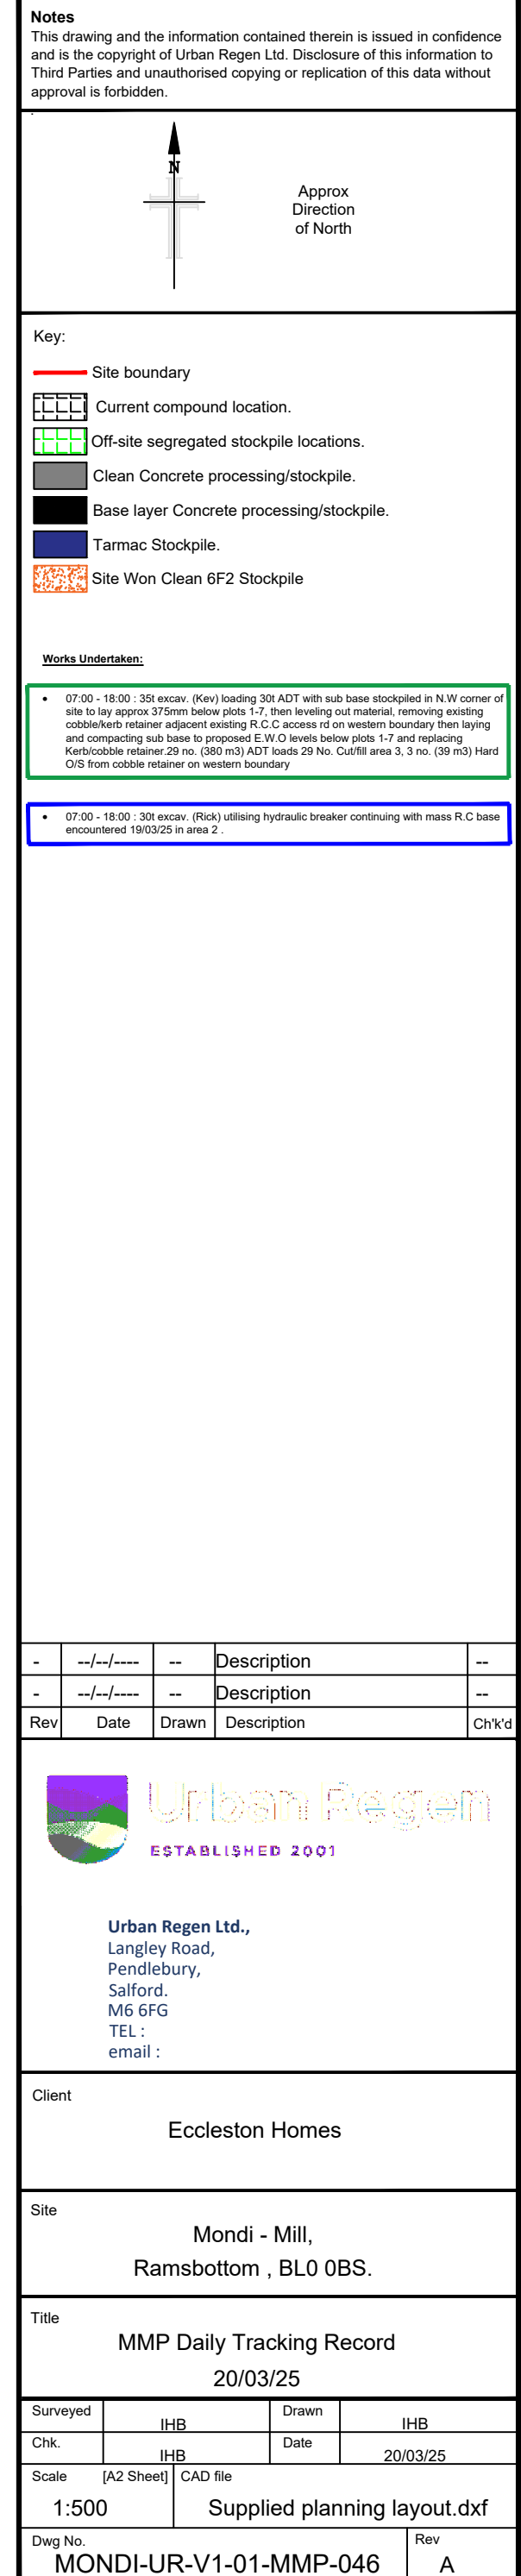

Notes
This drawing and the information contained therein is issued in confidence and is the copyright of Urban Regen Ltd. Disclosure of this information to Third Parties and unauthorised copying or replication of this data without approval is forbidden.

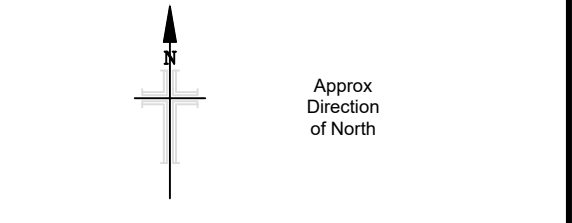

- Key:**
- Site boundary
 - Current compound location.
 - Off-site segregated stockpile locations.
 - Clean Concrete processing/stockpile.
 - Base layer Concrete processing/stockpile.
 - Tarmac Stockpile.
 - Site Won Clean 6F2 Stockpile

- Works Undertaken:**
- 07:00 - 17:00 : 3St excav. (Kev) completing leveling out fill material below plots 1-7 tidying sleepers and tyres deposited onto Got POS 20/03/25 then undertaking cutfill operation on proposed carpark in preparation of compound being relocated 28/03/25 utilising 3St ADT as required.
 - 07:00 - 17:00 : 3St excav. continuing with breakout of 6x7x3.5m deep mass filled concrete base encountered on the 19/03/25 (Over 36 hrs. with the hydraulic breaker), and loading breakout into 3St ADT. 11:00 leak noticed on breaker by operator, UR fitter's notified on site for 12:00 diagnosed as worn internal hydraulic hose, DT hydraulics notified , on site for 13:00 and repaired and back breaking for 14:30.

-	--/--/----	--	Description	--
-	--/--/----	--	Description	--
Rev	Date	Drawn	Description	Chk'd



Urban Regen
ESTABLISHED 2001


Urban Regen Ltd.,
Langley Road,
Pendlebury,
Salford,
M6 6FG
TEL :
email :

Client
Eccleston Homes

Site
Mondi - Mill,
Ramsbottom , BL0 OBS.


Title
MMP Daily Tracking Record
21/03/25

Surveyed	IHB	Drawn	IHB
Chk.	IHB	Date	21/03/25
Scale	[A2 Sheet]	CAD file	
1:500	Supplied planning layout.dxf		
Dwg No.	MONDI-UR-V1-01-MMP-047		Rev A

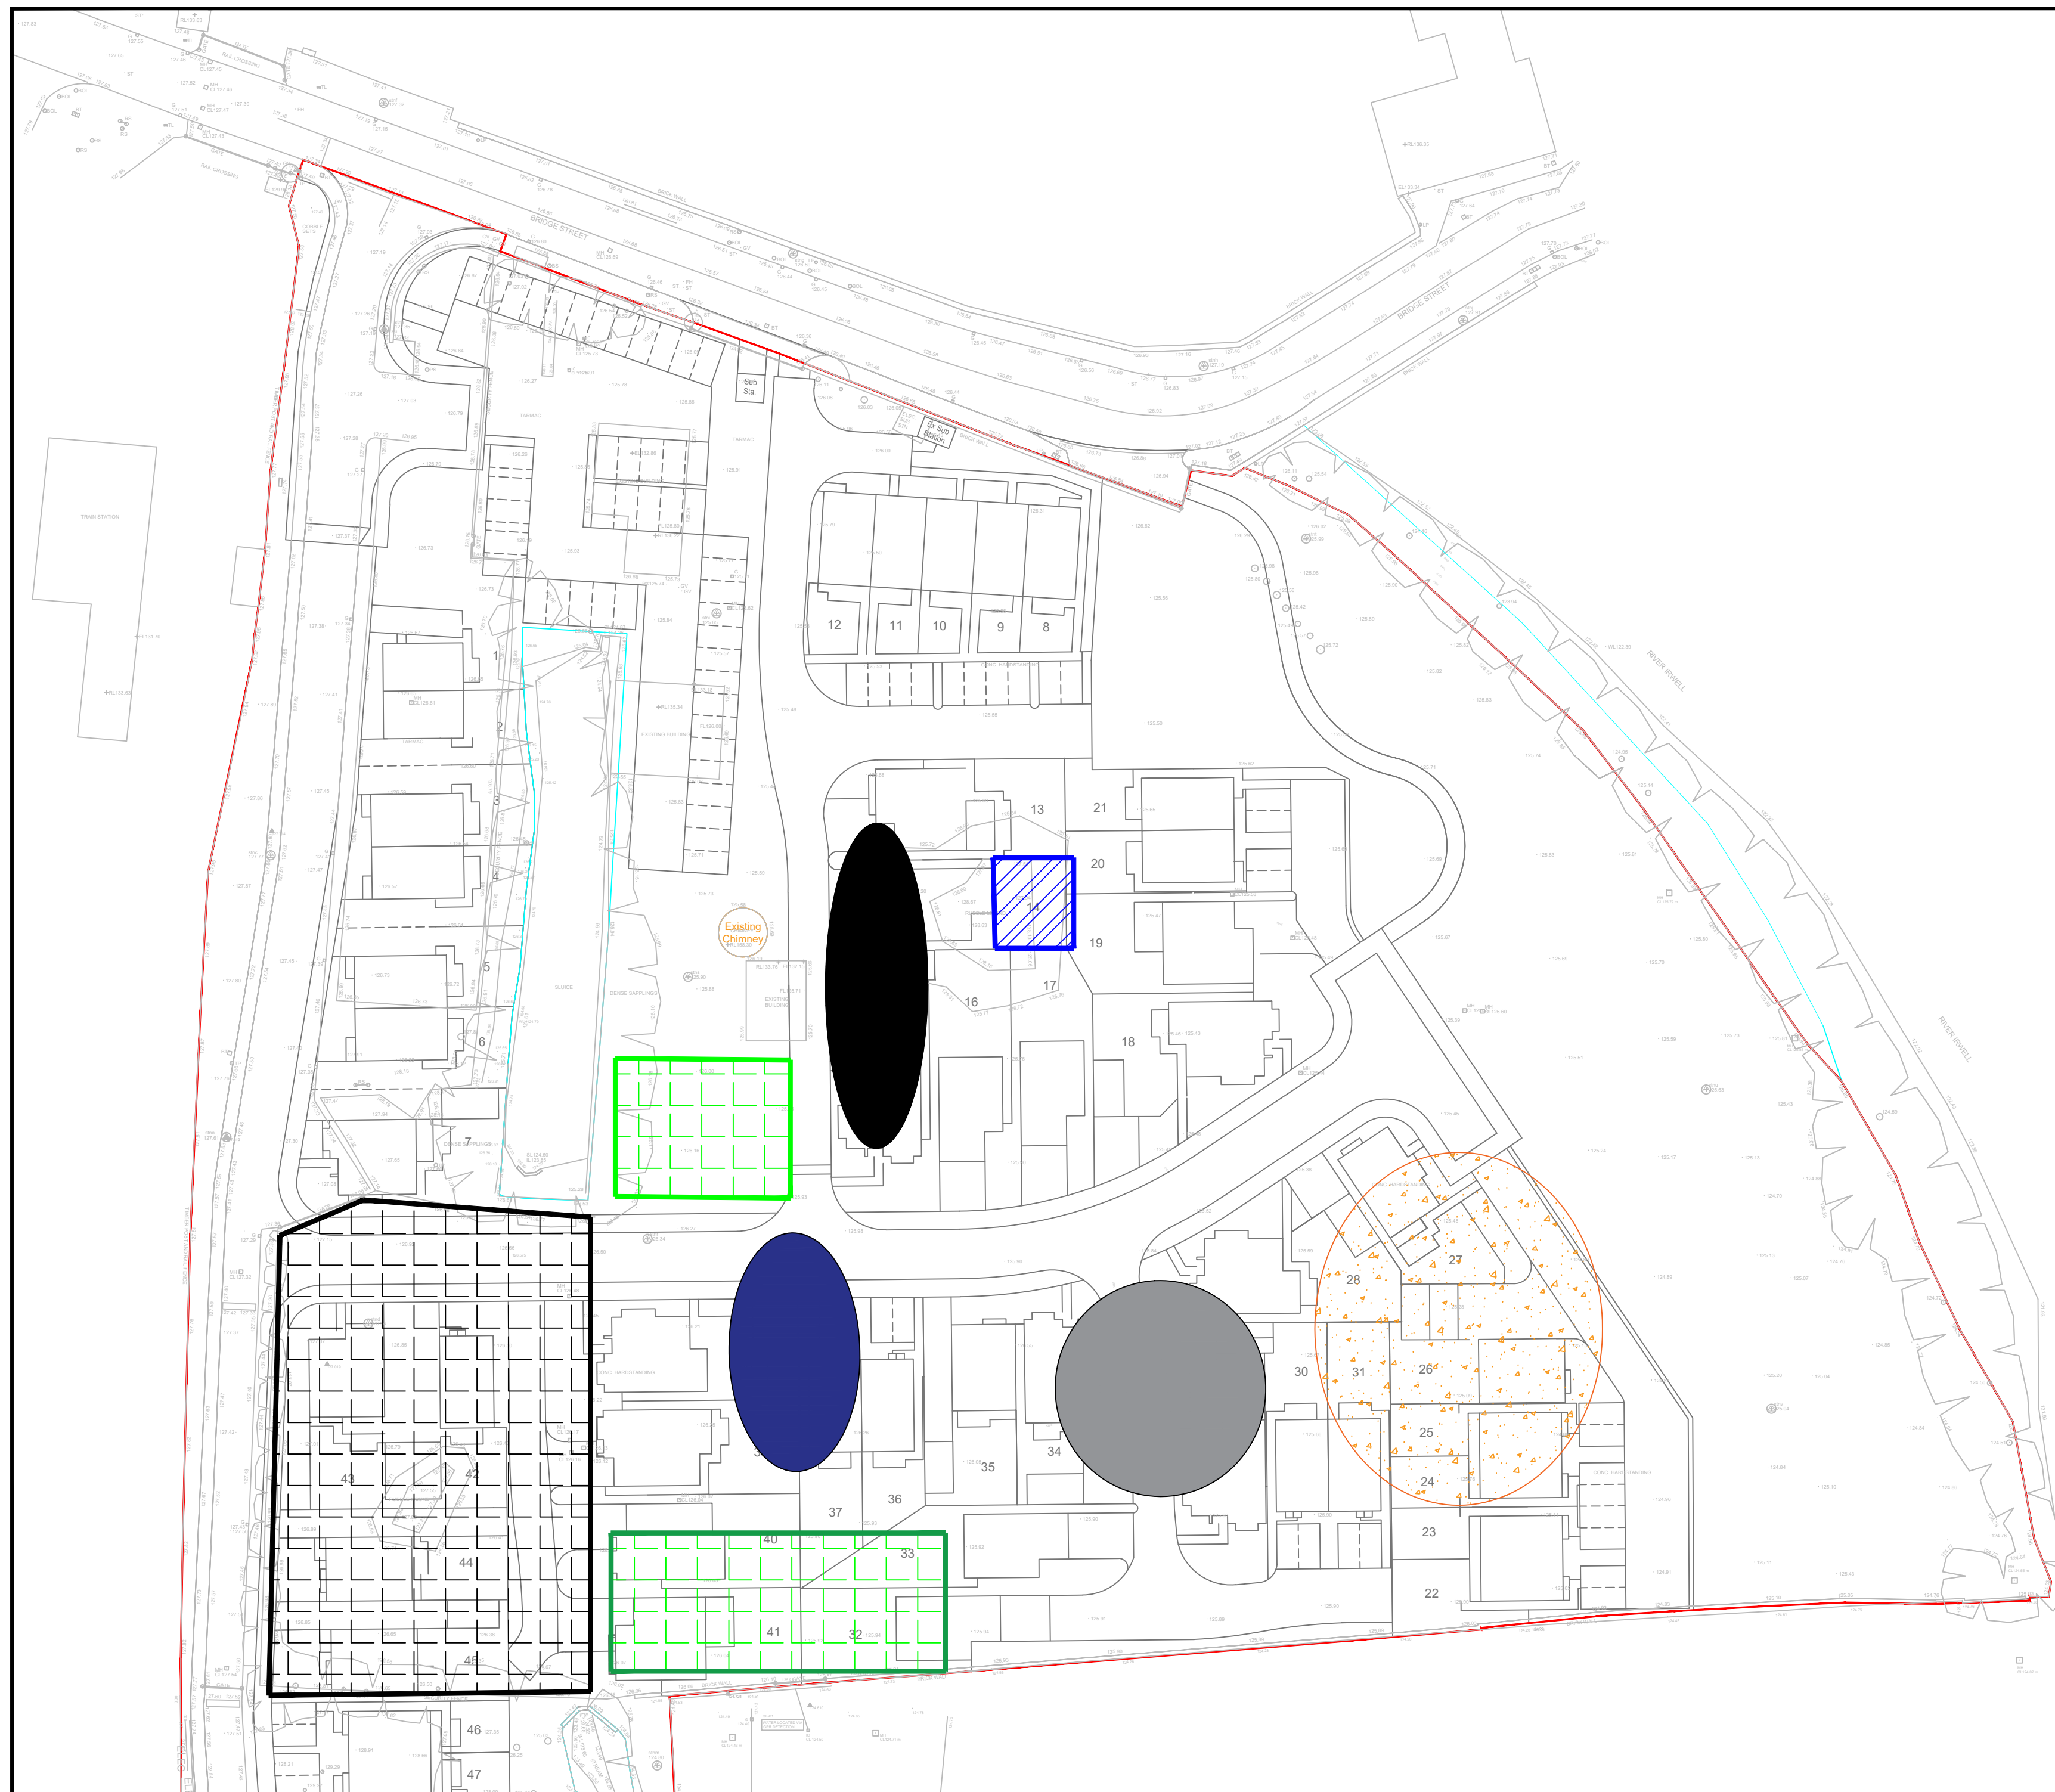

Notes

This drawing and the information contained therein is issued in confidence and is the copyright of Urban Regen Ltd. Disclosure of this information to Third Parties and unauthorised copying or replication of this data without approval is forbidden.

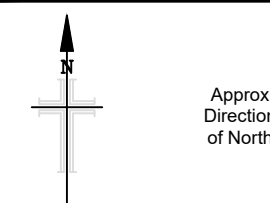

Key:

-  Site boundary
-  Current compound location.
-  Off-site segregated stockpile locations.
-  Clean Concrete processing/stockpile.
-  Base layer Concrete processing/stockpile.
-  Tarmac Stockpile.
-  Site Won Clean 6F2 Stockpile

Works Undertaken:

- 07:00 - 13:00 : 30t excav. (Rich) continuing with breakout of below ground foundations/structures in area 2 with breakout being stockpiled locally in preparation of being hauled to clean concrete stock when ADT available on 24/03/25
- 07:00 - 13:00 : 35t excav. (Lewis) tidying former off-site processing area on southern boundary, removing existing surface slabs adjacent southern boundary exposing remaining concrete bases associated with southern boundary wall as structural engineer due on site 24-25/03/25, exposed suspected w/d UT/11. Additional investigation to be undertaken 24-25/03/25.

-	--/--/----	--	Description	--
-	--/--/----	--	Description	--
Rev	Date	Drawn	Description	Ch'k'



Urban Regen Ltd.,
Langley Road,
Pendlebury,
Salford.
M6 6FG
TEL :
email :

Client

Eccleston Homes


Site

Mondi - Mill,
Ramsbottom , BL0 0BS.


1	Title
---	-------

MMP Daily Tracking Record
21/03/25

Surveyed	IHB	Drawn	IHB
Chk.	IHB	Date	21/03/25
Scale	[A2 Sheet]	CAD file	
1:500	Supplied planning layout.dxf		
Dwg No.	MONDI-UR-V1-01-MMP-047		Rev A

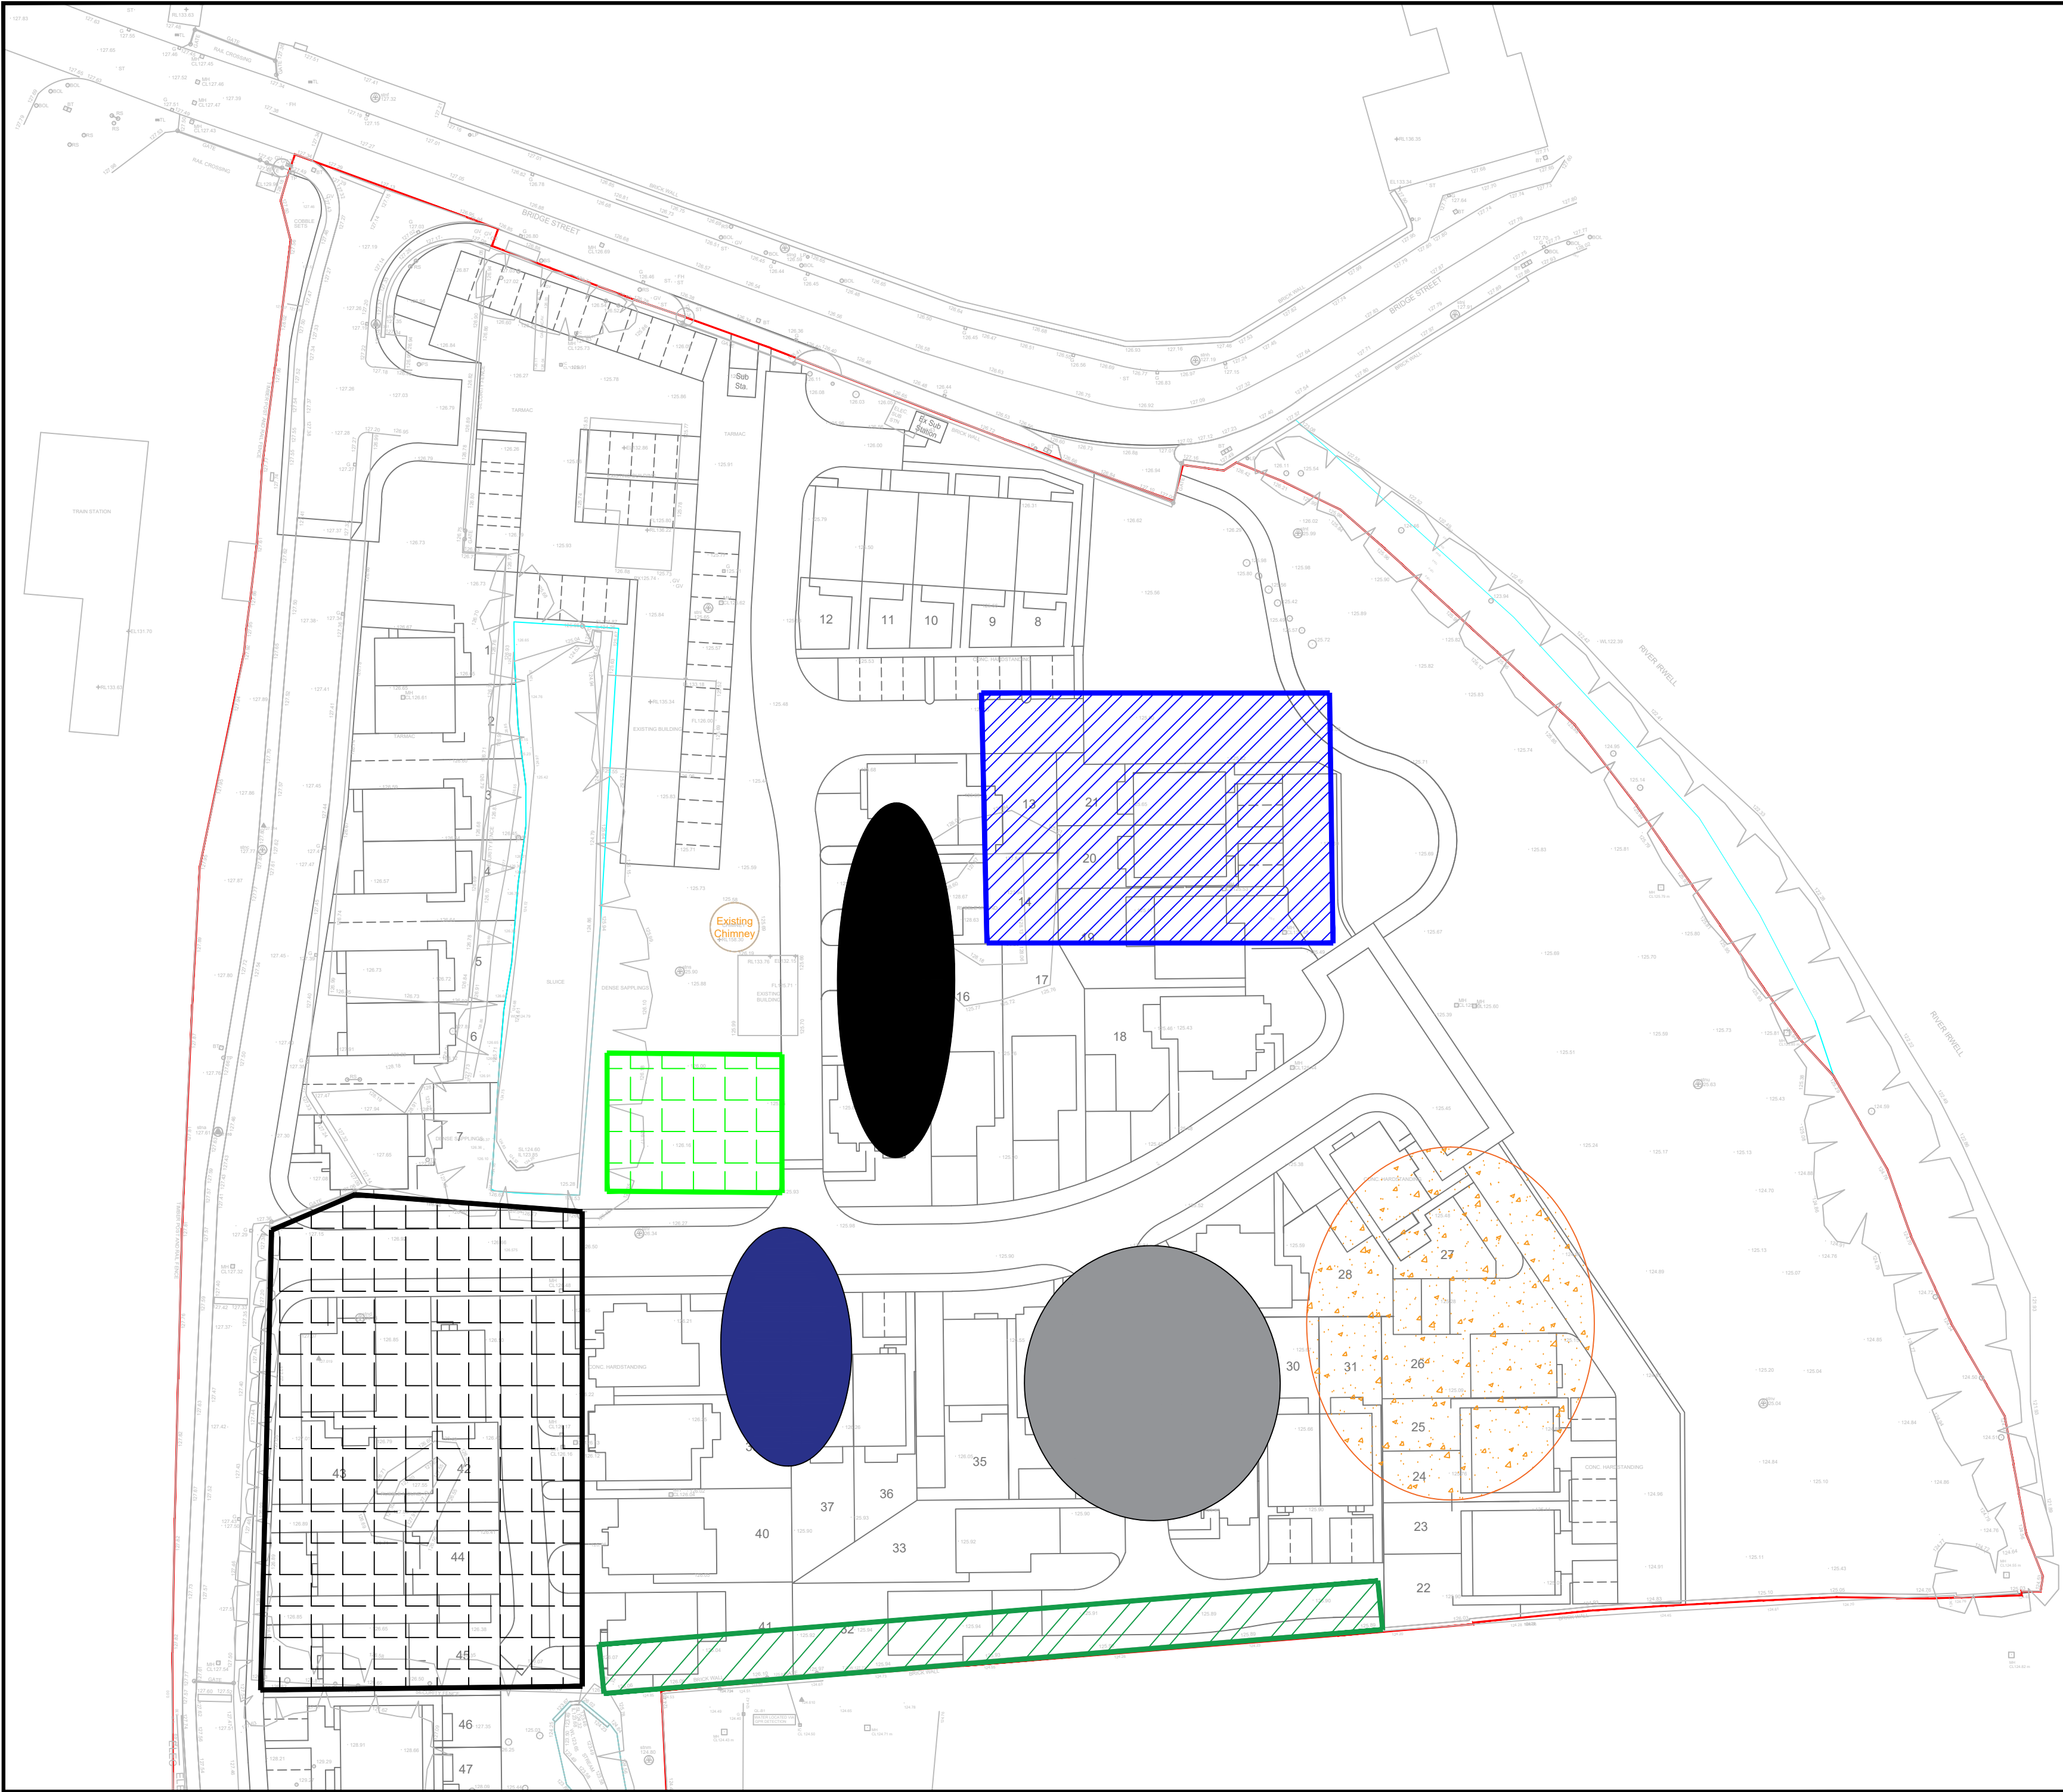

Notes
This drawing and the information contained therein is issued in confidence and is the copyright of Urban Regen Ltd. Disclosure of this information to Third Parties and unauthorised copying or replication of this data without approval is forbidden.

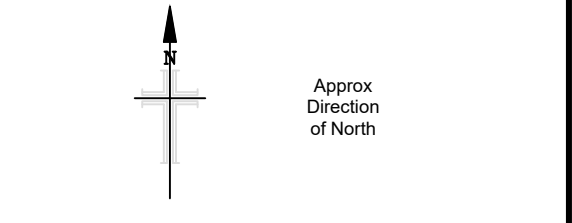

- Key:**
- Site boundary
 - Current compound location.
 - Off-site segregated stockpile locations.
 - Clean Concrete processing/stockpile.
 - Base layer Concrete processing/stockpile.
 - Tarmac Stockpile.
 - Site Won Clean 6F2 Stockpile

- Works Undertaken:**
- 07:00 - 18:00 : 35t excav. (Key) utilising hydraulic grab to remove 90m, approx. 2.0m high double skin brickwork from R.C base on Southern boundary wall, also removing steel stanchions previously cut/burnt down of former reit house at 6 m intervals at brickwork removed loaded into 30t ADT and added to clean concrete stock ready for crushing. Heras fence installed on R.C.C side of wall (previously agreed with P. Croft, R.C.C contact) with fence posts used to protect water main at toe of wall. R.C.C land cleaned as works progress. 30t ADT driver used to bank excav, assist in cleaning & erecting fencing with 1 Bentley, 4 no. ADT loads (52 m3) brickwork added to clean concrete stock.
 - 07:00 - 18:00 : 30t excav. (Rick) utilising hydraulic breaker continuing with existing slab and below ground foundations/structures encountered in area 2, joined by 22 excav. (Chris) from 14:30 loading localised stockpiles, hard materials encountered taken to segregated stocks on turned works in area 1 by 30t ADT, 19 no. ADT loads (247 m3) O/S hard added to clean concrete stock.


Rev	Date	Drawn	Description	Chk'd
-	-	-	Description	-
-	-	-	Description	-




Urban Regen
ESTABLISHED 2001

Urban Regen Ltd.,
Langley Road,
Pendlebury,
Salford,
M6 6FG
TEL :
email :

Client				Eccleston Homes	
Site					
Mondi - Mill, Ramsbottom , BL0 OBS.					
Title					
MMP Daily Tracking Record 24/03/25					
Surveyed	IHB		Drawn	IHB	
Chk.	IHB		Date	24/03/25	
Scale	(A2 Sheet)	CAD file			
1:500		Supplied planning layout.dxf			
Dwg No.				Rev	
MONDI-UR-V1-01-MMP-048				A	

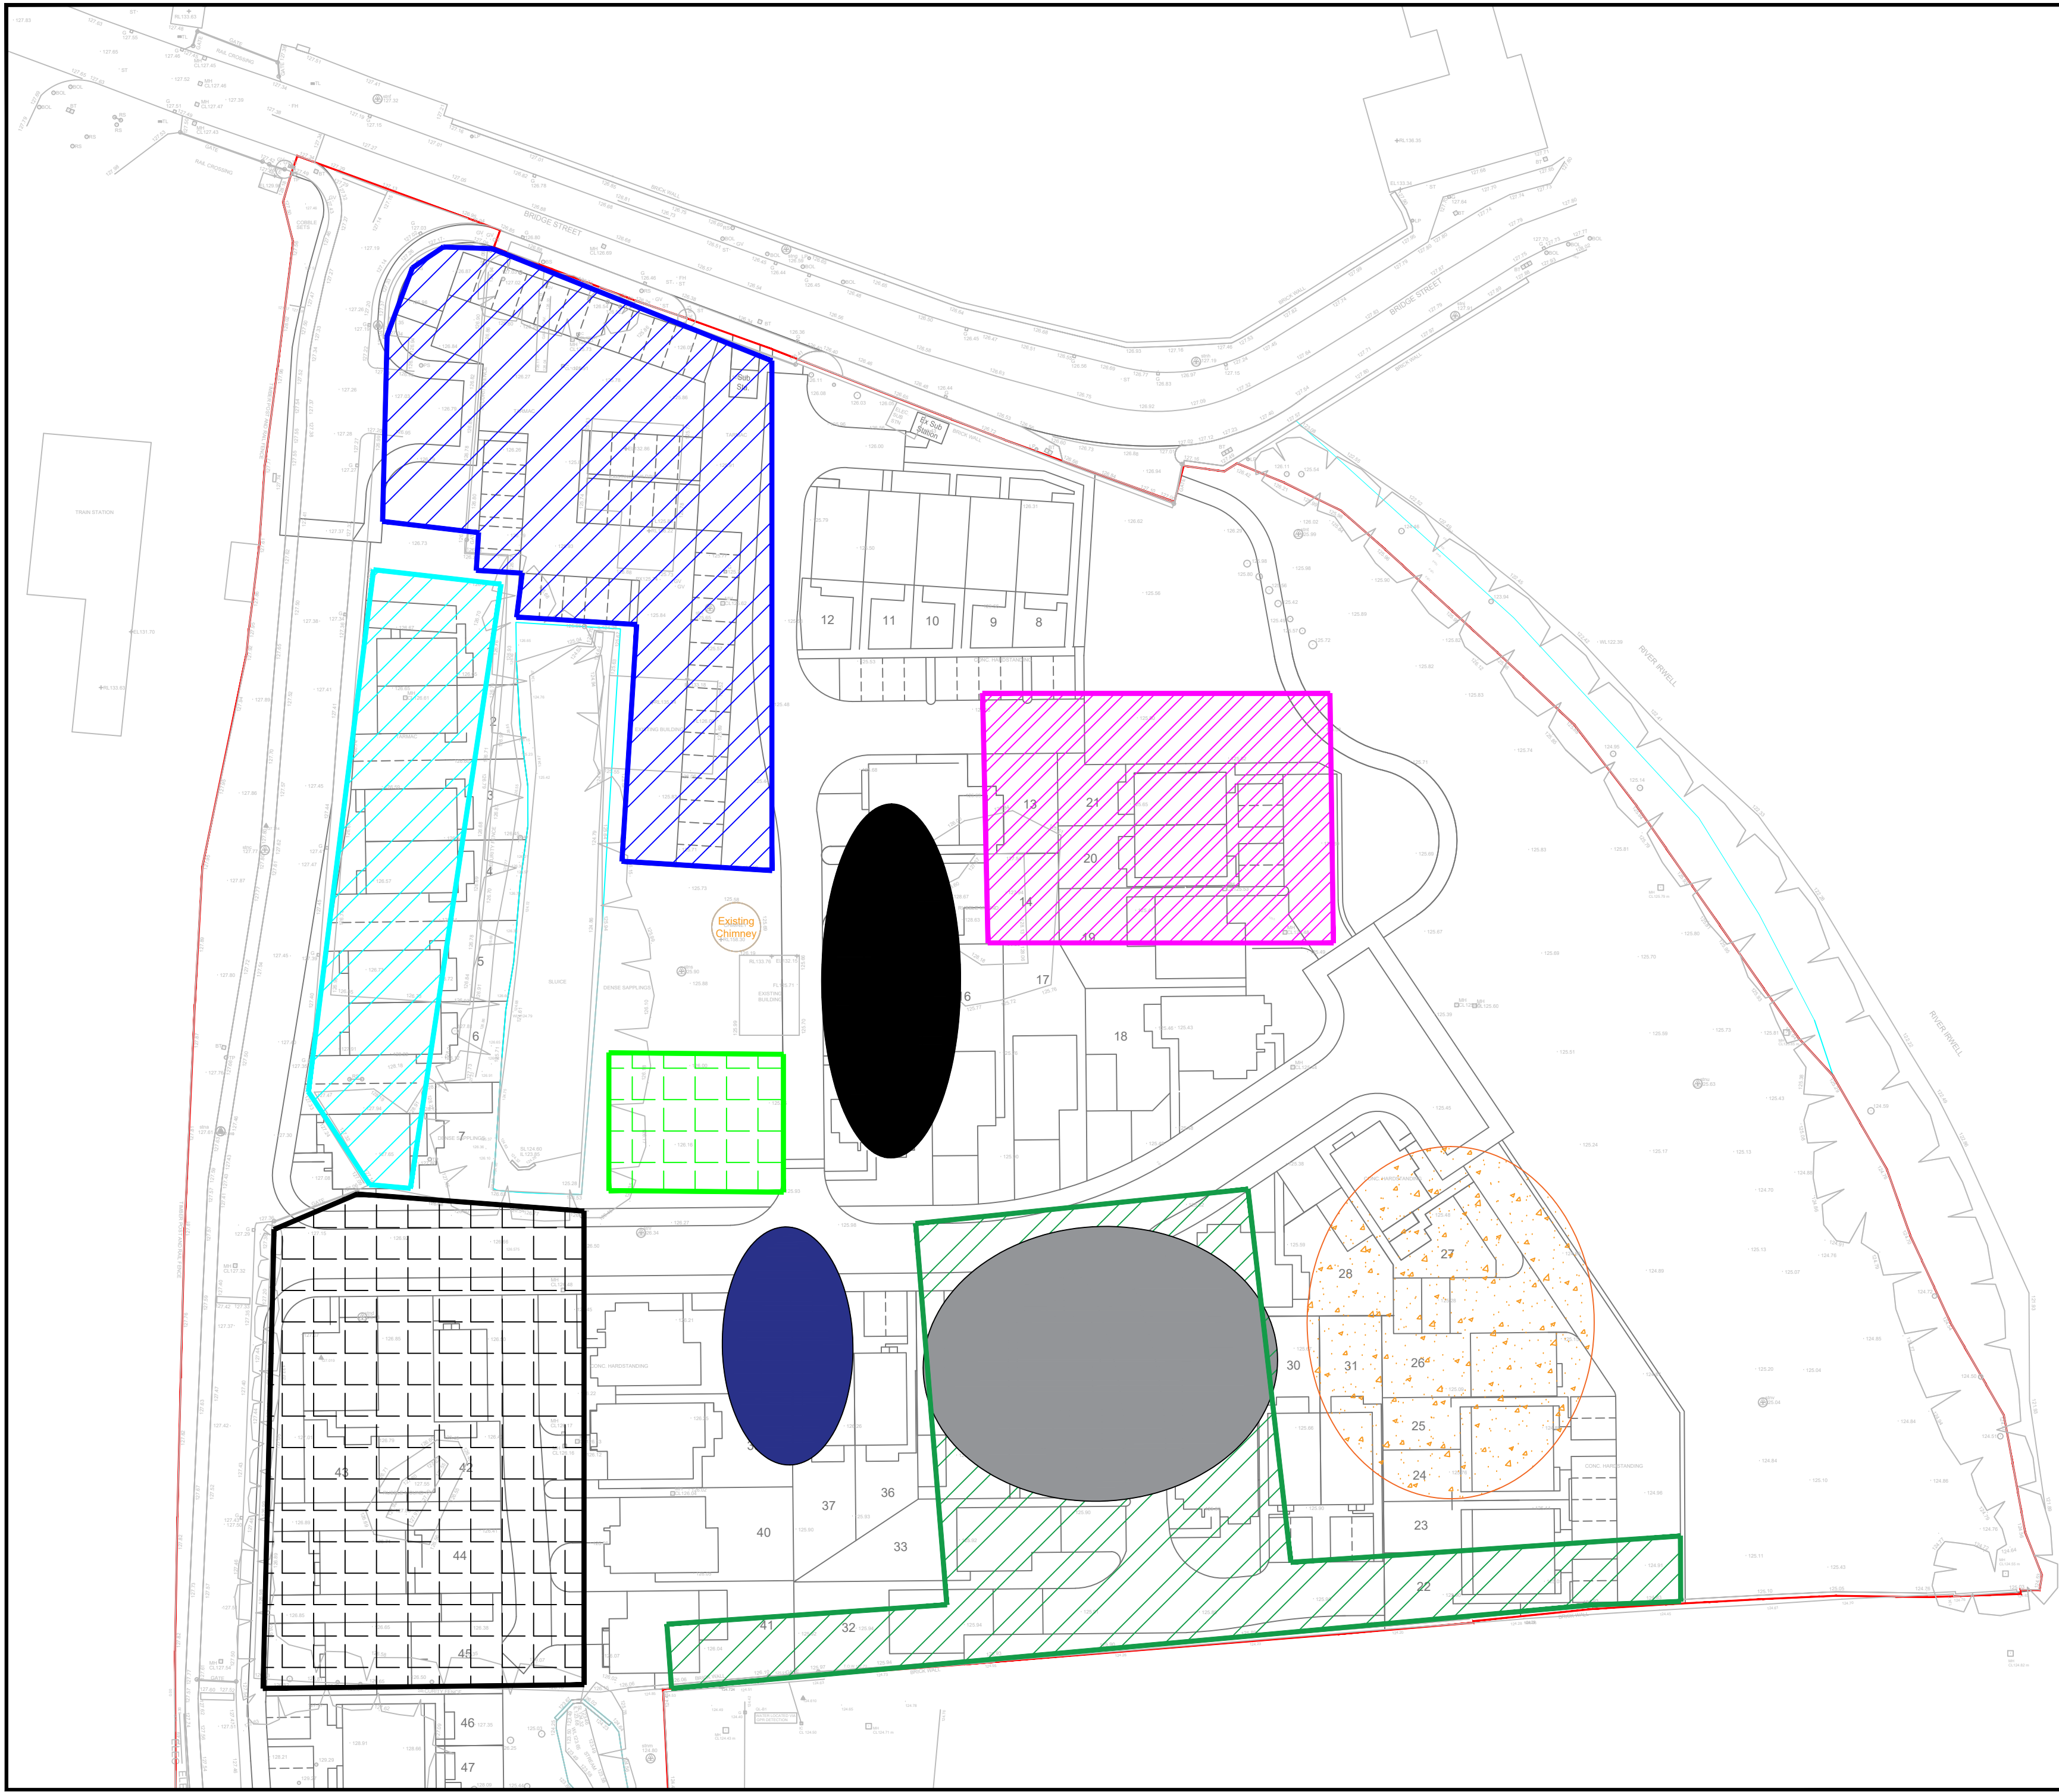

Notes
This drawing and the information contained therein is issued in confidence and is the copyright of Urban Regen Ltd. Disclosure of this information to Third Parties and unauthorised copying or replication of this data without approval is forbidden.

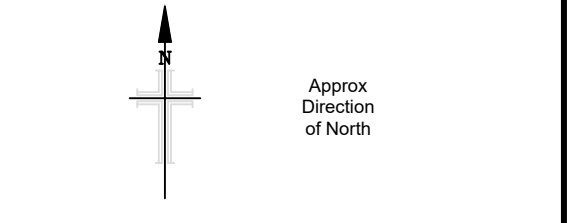

- Key:**
- Site boundary
 - Current compound location.
 - Off-site segregated stockpile locations.
 - Clean Concrete processing/stockpile.
 - Base layer Concrete processing/stockpile.
 - Tarmac Stockpile.
 - Site Won Clean 6F2 Stockpile

- Works Undertaken:**
- 07:00 - 18:00 : 35t excav. (Kev) tidying processing O/S hard from slab breakout undertaken 22/03 and loading 30t ADT with remaining arisings from southern boundary wall removal, assisted moving fencing materials to southern end of site then commencing with removal of former foul pump on houses on the southern boundary.
 - 07:00 - 18:00 : 30t excav. (Rick) utilising hydraulic breaker to remove existing below ground structures & foundations until 10:00 then using GPS to trim carpark/new compound area in N/W corner with surplus fill material being stockpiled on eastern boundary of proposed car park (Area 3) ready to be used as gen fill in area 2. 13:00 - 15:30 Working with Murray Rix operative (Dean) excavating through fill/turned backfilled material to undertake NDG testing. 15:30 - 18:00 back to trimming proposed carpark.
 - 07:00 - 18:00 : 22t excav (Chris) loading 30t ADT with slab and below ground structure/foundations broken by 30t excav 24-25/03, then haymaking back approx 500 m3 of 6F2 stockpile to expose existing below ground ring beam of former machine house in preparation of removal of below ground structures on northern work face of area due to commence 26/03/25 24 no. (312 m3) loads of Hard O/S material added to clean concrete stock ready for crushing
 - 13:00 - 16:00 : Murray Rix on site to undertake NDG testing in area 3, 17 no. NDG's undertaken achieving 100%+ on compaction, please note a max. dry density has been assumed at 1.84, samples of the material being tested collected by Murray Rix and is to be updated accordingly once true M.D.D is known.

Rev	Date	Drawn	Description	Chk'd
-	-	-	Description	-
-	-	-	Description	-



Urban Regen
ESTABLISHED 2001


Urban Regen Ltd.,
Langley Road,
Pendlebury,
Salford,
M6 6FG
TEL :
email :

Client
Eccleston Homes


Site
Mondi - Mill,
Ramsbottom , BL0 OBS.

Title
MMP Daily Tracking Record
25/03/25

Surveyed	IHB	Drawn	IHB
Chk.	IHB	Date	25/03/25
Scale	[A2 Sheet]	CAD file	
1:500	Supplied planning layout.dxf		
Dwg No.	MONDI-UR-V1-01-MMP-049		Rev A

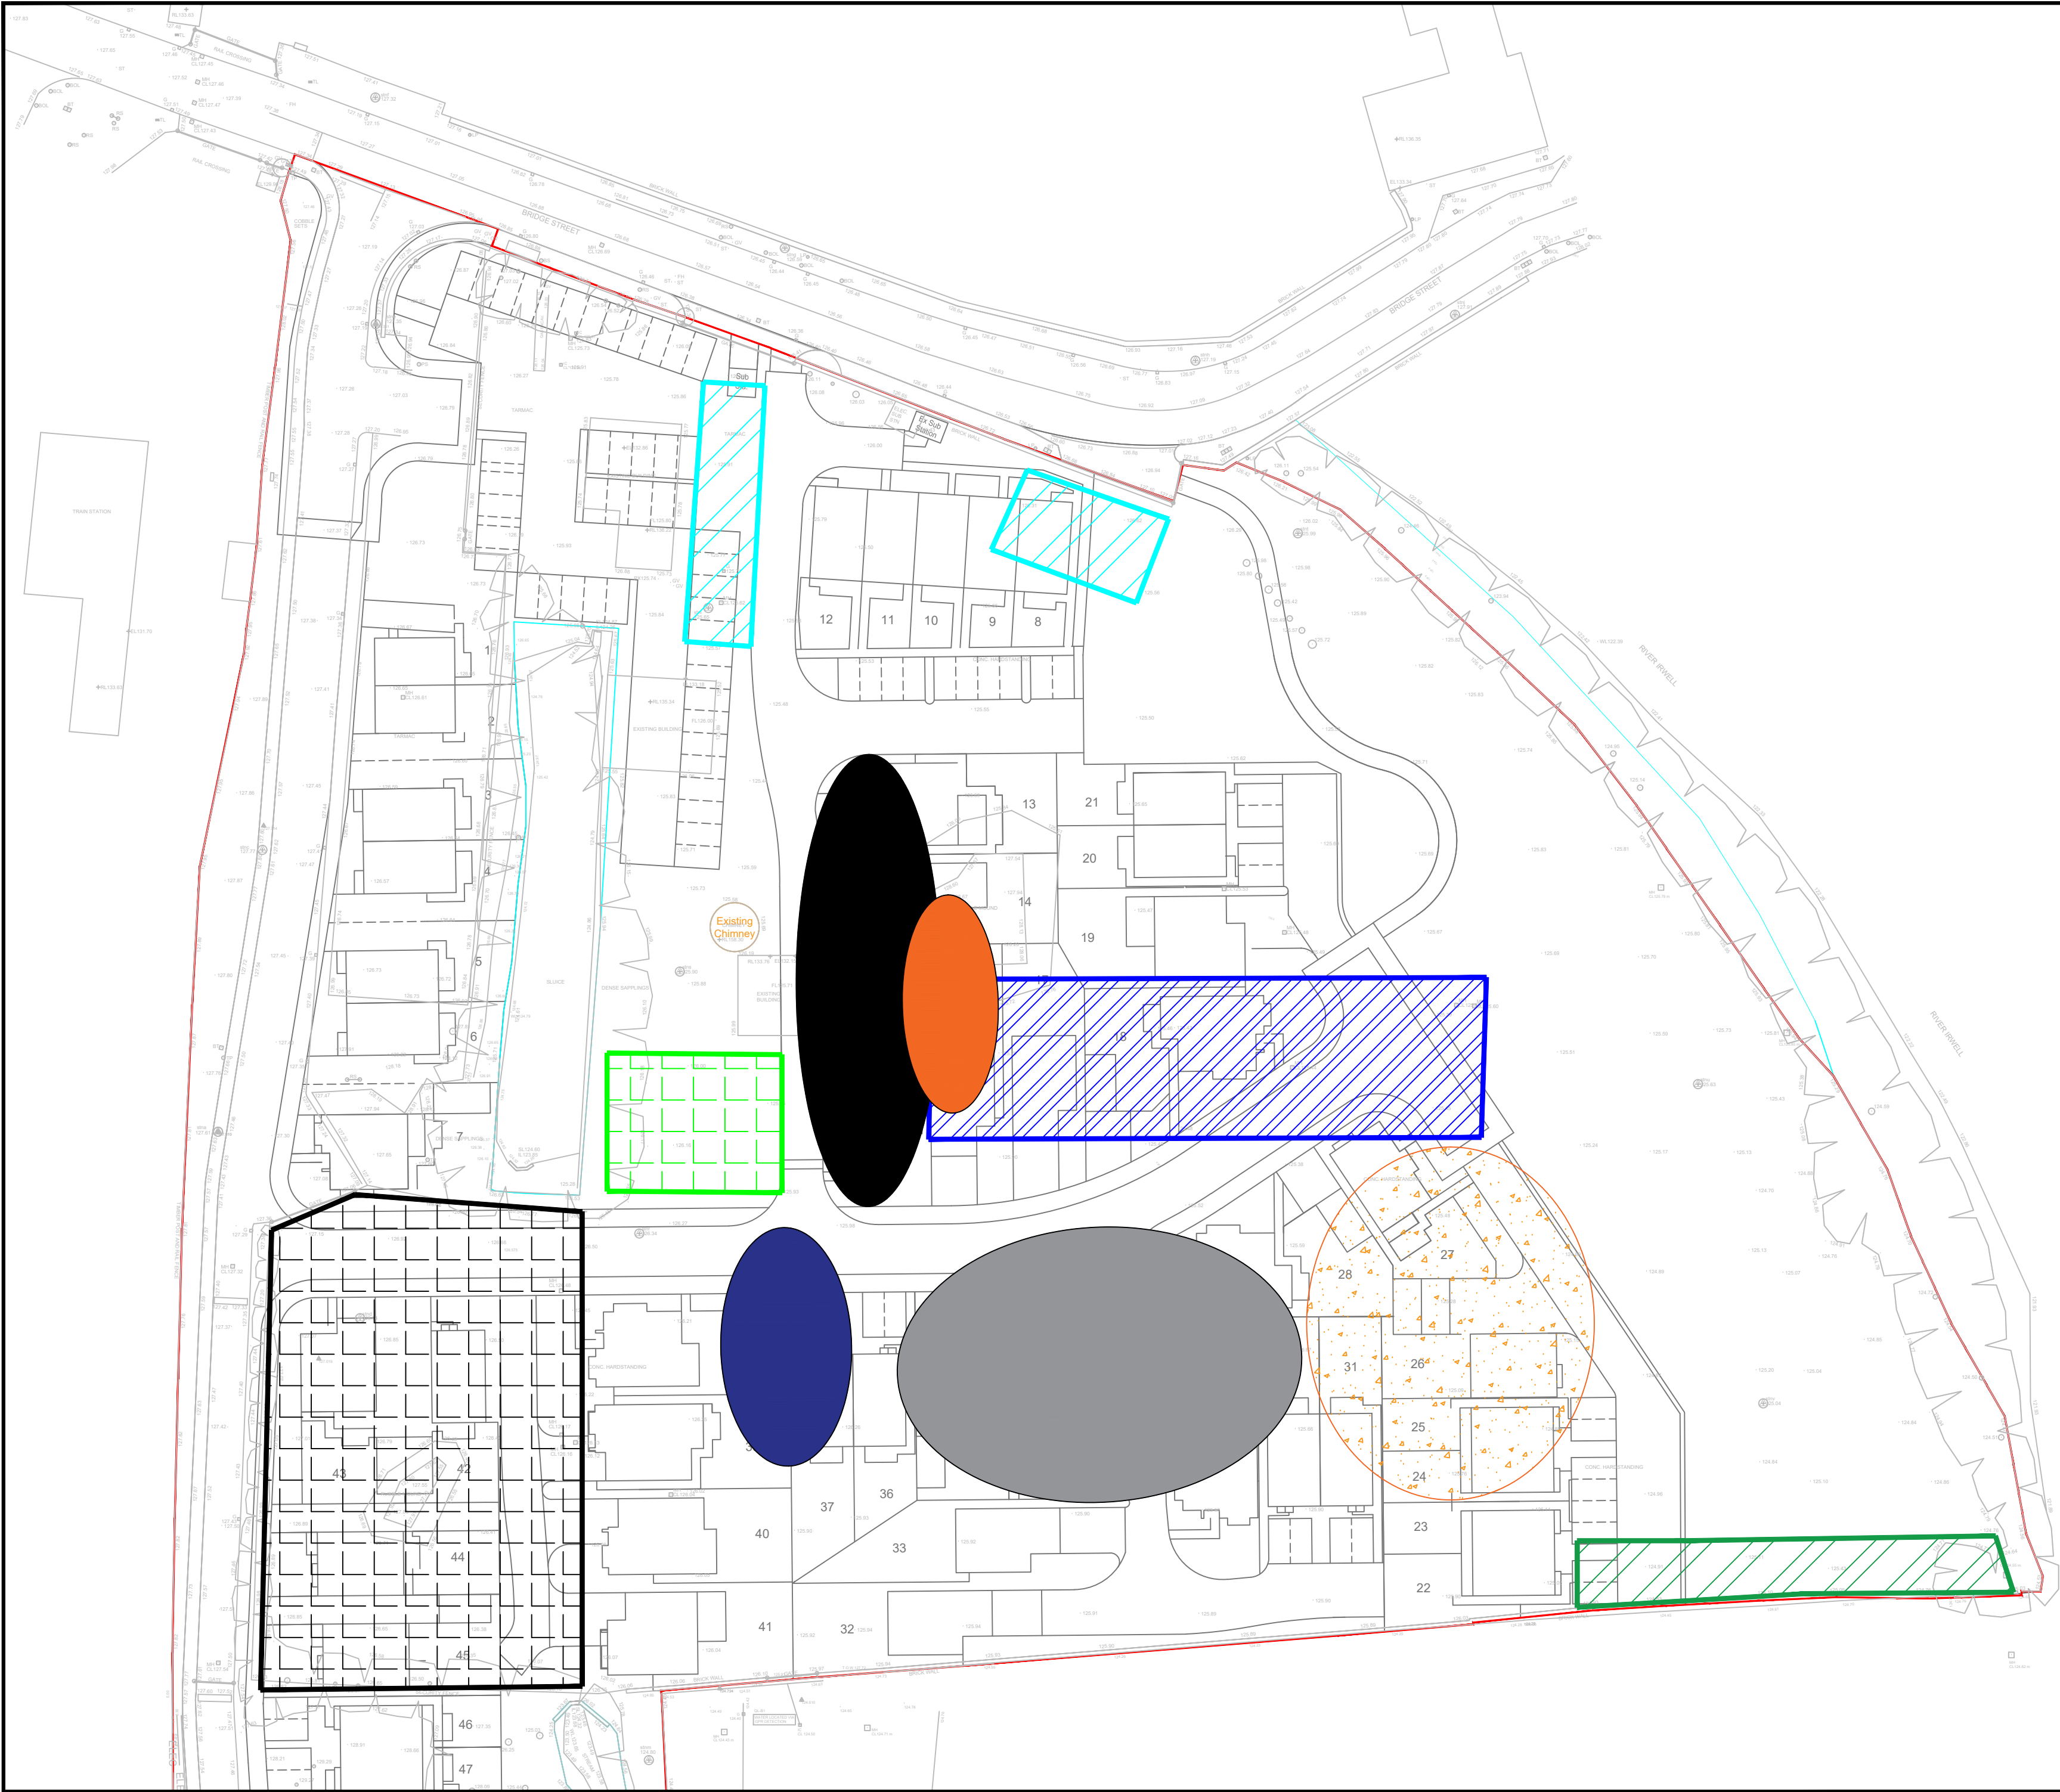

Notes
This drawing and the information contained therein is issued in confidence and is the copyright of Urban Regen Ltd. Disclosure of this information to Third Parties and unauthorised copying or replication of this data without approval is forbidden.

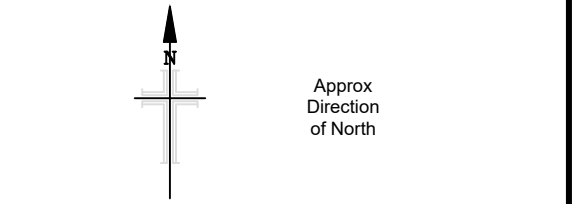

- Key:**
- Site boundary
 - Current compound location.
 - Off-site segregated stockpile locations.
 - Clean Concrete processing/stockpile.
 - Base layer Concrete processing/stockpile.
 - Made Ground Brick/Rubble stock.
 - Tarmac Stockpile.
 - Site Won Clean 6F2 Stockpile

- Works Undertaken:**
- 07:00 - 18:00 : 35t excav. (Kev) continuing with southern boundary wall treatment, instructed operatives to leave remainder of wall and concentrate on removing existing filter beds & removal of brick rubble made ground & existing slabs etc. in Eastern P.O.S. all materials excavated sent to segregated stocks slow working until 13:30 as material being riddled to reduce on fines in stockpiles 13:30 - 18:00 any materials requiring riddling sent to screening operation being undertaken in area 2 with turnover works. 7 no. (91 m3) O/S hard sent to base layer crush pile & 6 no. (778 m3) loads sent to screening operation.
 - 07:00 - 18:00 : 30t excav. (Rick) & 22t excav. (Chris) continuing turnover works in area 2, "hymaking" brick rubble made ground from eastern P.O.S to eastern extent of area 1, removing all remaining structures/foundations/hard materials encountered in excess of 150mm, removing piles encountered below former structures, ensuring that any piles that break are taken to a minimum 3.0m below E.W.O. 13:00 - 18:00 22t excav. loading sandvik screen to process brick rubble made ground. 30t excav. stockpiling material from area 1, utilising hydraulic breaker to reduce O/S hard in size as required and breaking up structures removed 26-27/03/25. 13 no. (160 m3) loads of O/S hard sent to base layer crush pile
 - 13:30 - 18:00 : 30t excav. (Carl) creating pad for new cabin set up in proposed carpark in N.W corner of site until 15:00 then moved over to undertake turnover works in the vicinity of the proposed sign base adjacent northern boundary, removing all remaining structures/foundations/hard materials encountered in excess of 150mm, removing piles encountered below former structures, ensuring that any piles that break are taken to a minimum 3.0m below E.W.O., re-engineering existing natural made ground materials in 300mm layers compacted with 15t roller in preparation of laying approx. 120 m3 to achieve a 5 x 5m pad within 1.6 m off the top of the northern boundary wall.

-	--/--/----	--	Description	--
-	--/--/----	--	Description	--
Rev	Date	Drawn	Description	Chk'd



Urban Regen
ESTABLISHED 2001


Urban Regen Ltd.,
Langley Road,
Pendlebury,
Salford,
M6 6FG
TEL :
email :

Client
Eccleston Homes


Site
Mondi - Mill,
Ramsbottom , BL0 0BS.

Title
MMP Daily Tracking Record
27/03/25

Surveyed	IHB	Drawn	IHB
Chk.	IHB	Date	27/03/25
Scale	[A2 Sheet]	CAD file	
1:500	Supplied planning layout.dxf		
Dwg No.	MONDI-UR-V1-01-MMP-051		Rev
			A

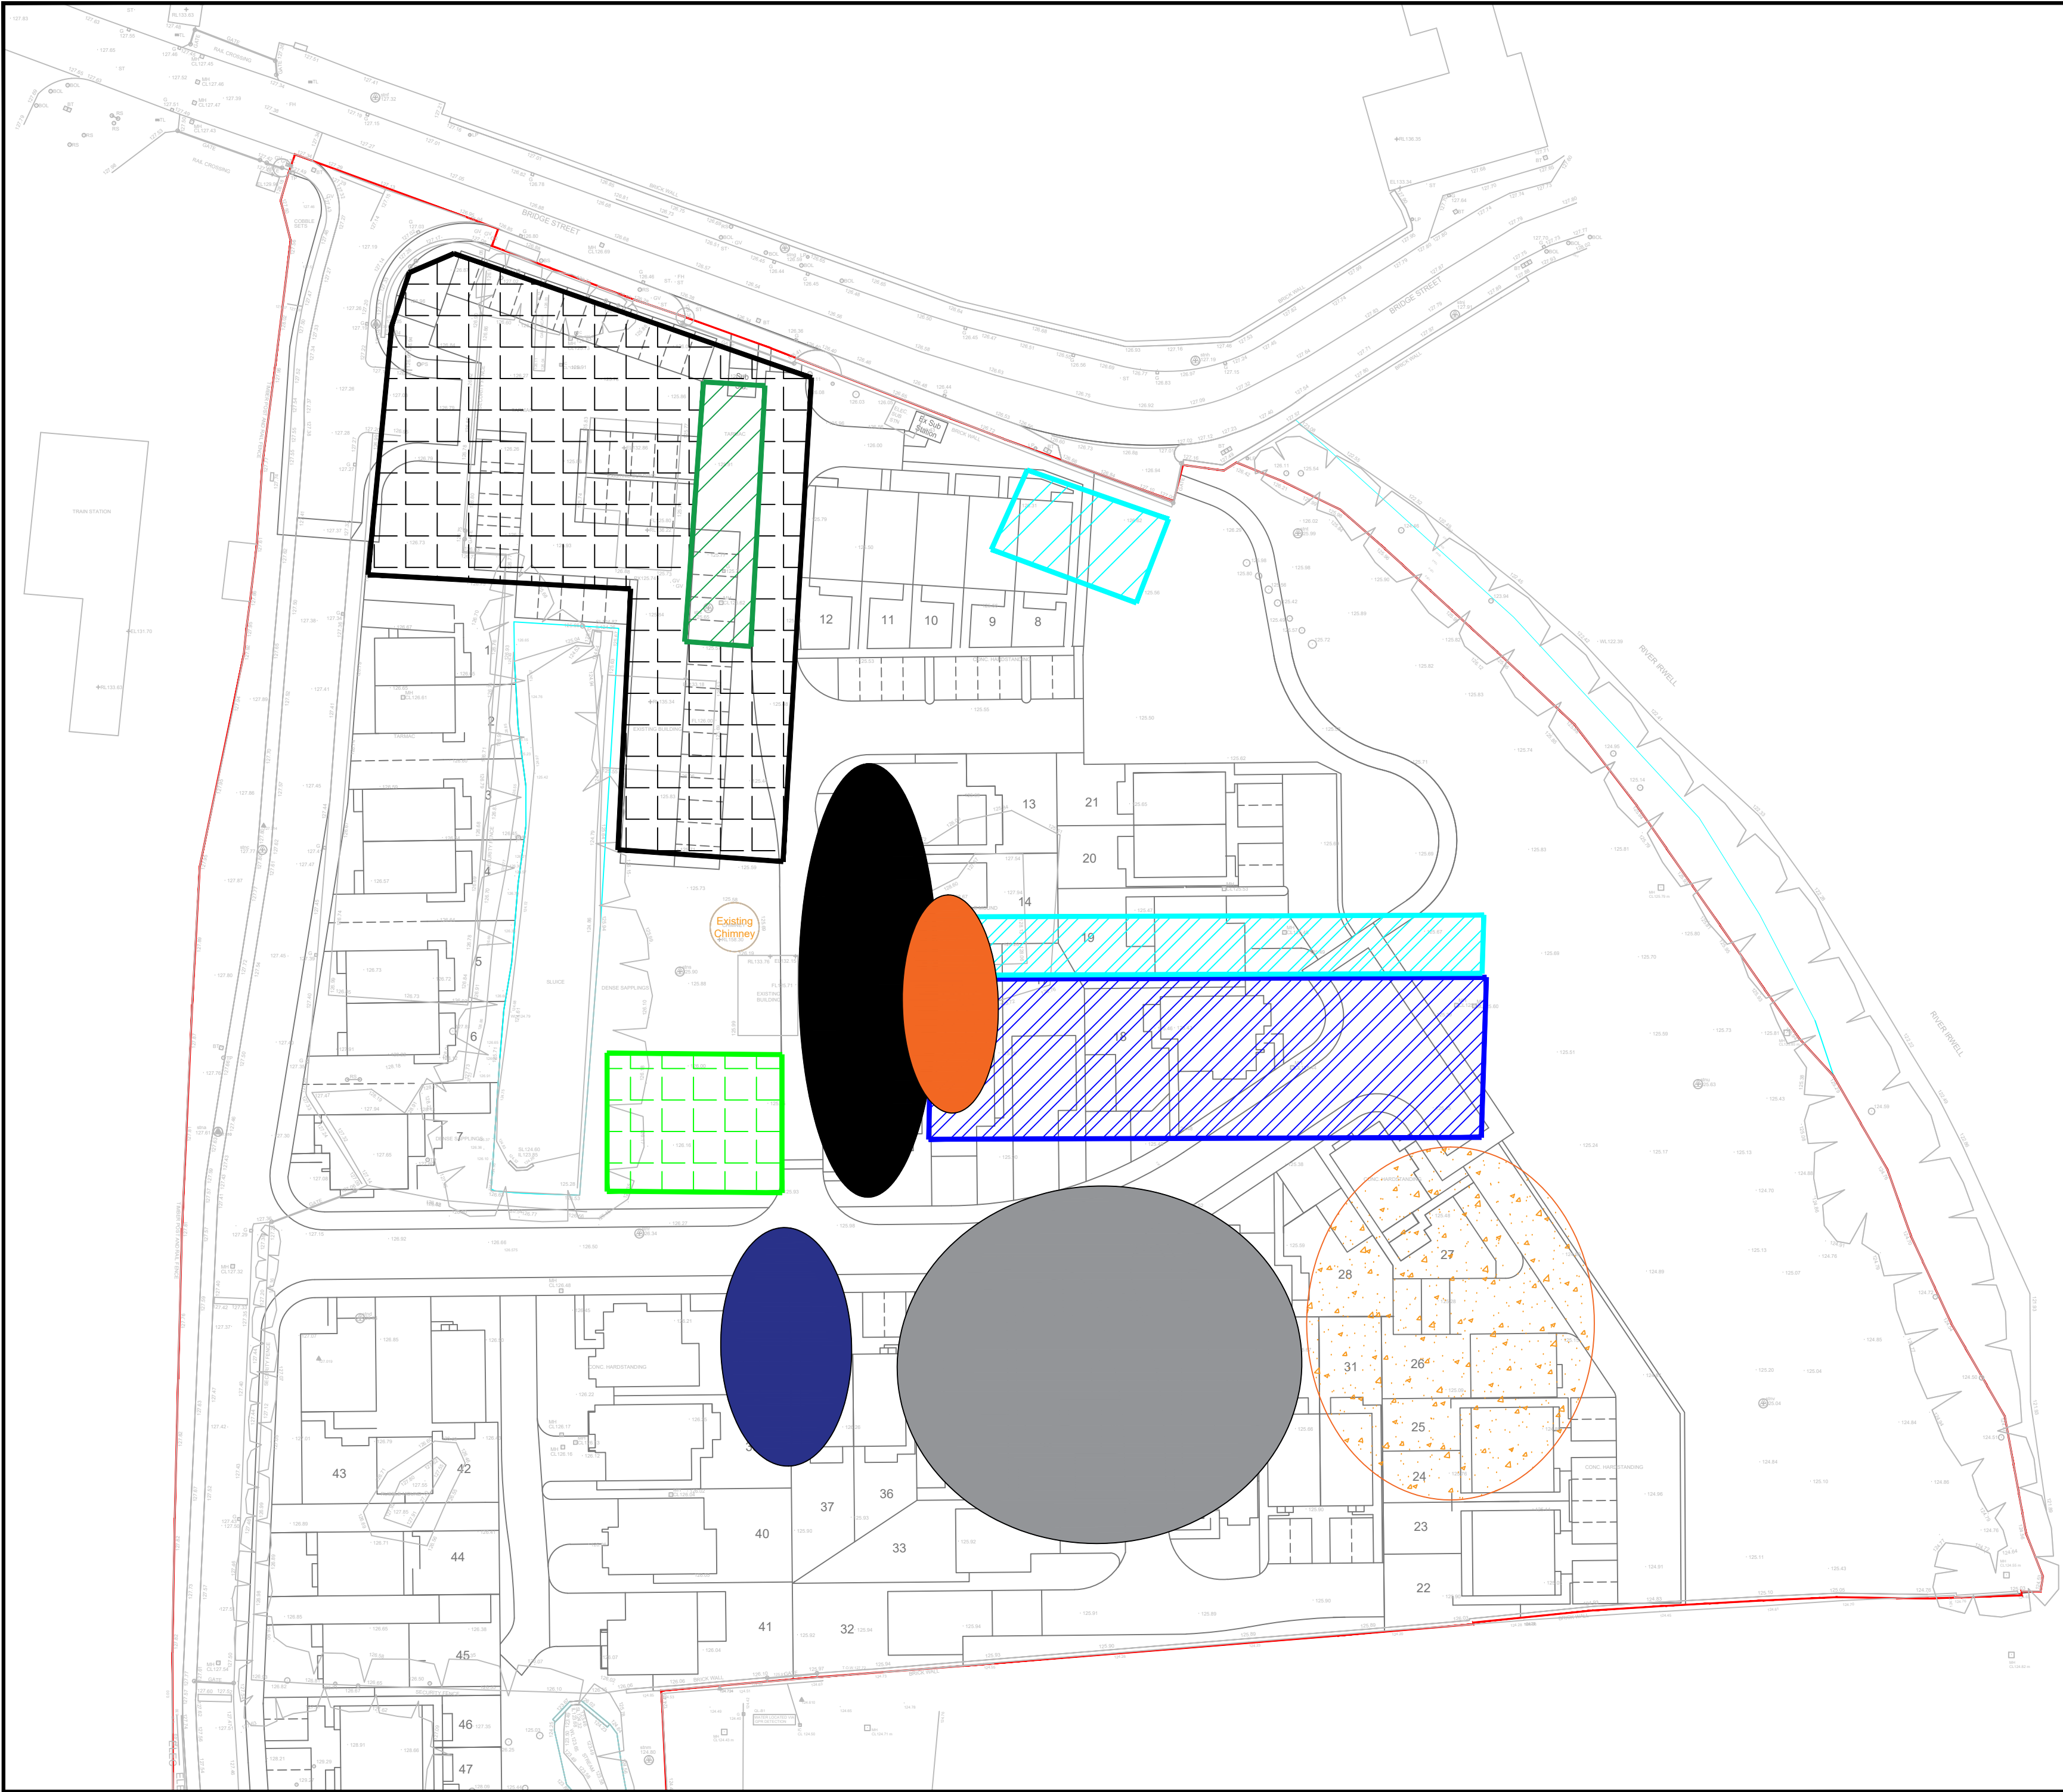

Notes
This drawing and the information contained therein is issued in confidence and is the copyright of Urban Regen Ltd. Disclosure of this information to Third Parties and unauthorised copying or replication of this data without approval is forbidden.

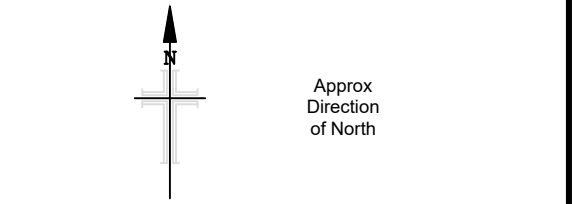

- Key:**
- Site boundary
 - Current compound location.
 - Off-site segregated stockpile locations.
 - Clean Concrete processing/stockpile.
 - Base layer Concrete processing/stockpile.
 - Made Ground Brick/Rubble stock.
 - Tarmac Stockpile.
 - Site Won Clean 6F2 Stockpile

- Works Undertaken:**
- 07:00 - 17:00 : 35t excav. (Kev) undertaking compound re-site from S.W corner to N.W corner of site, moving all cabins/containers and re-setting up with site manager, then tidying proposed car park until 16:00 then cleaning tracks in preparation of excav. leaving site 31/03/25.
 - 07:00 - 17:30 : 30t excav. (Rick) & 22t excav. (Chris) continuing turnover works in area 2, "thymaking" brick rubble made ground from eastern P.O.S to eastern extent of area 1, removing all remaining structures/foundations/hard materials encountered in excess of 150mm, removing piles encountered below former structures, ensuring that any piles that break are taken to a minimum 3.0m below E.W.O. : 13:00 - 18:00 22t excav. loading sandvik screen to process brick rubble made ground. 30t excav. stockpiling material from fines belt in turned works of Area 2, utilising hydraulic breaker to reduce O/S hard in size as required and breaking up structures removed 26-27/03/25.
 - 07:00 - 17:30 : 30t excav. (Carl) loading broken oversize generated from turnover works into 30t ADT, laying 10 no. ADT loads onto turned ground of proposed sign base in N.E corner of site, with screened fines from turnover works, compacted in 300mm layers with 13t roller. 8 no. (104m3) screened fines sent to sign base & 26 no. (340 m3) hard O/S sent to processing stock.

-	--/--/----	--	Description	--
-	--/--/----	--	Description	--
Rev	Date	Drawn	Description	Chk'd



Urban Regen
ESTABLISHED 2001


Urban Regen Ltd.,
Langley Road,
Pendlebury,
Salford,
M6 6FG
TEL :
email :

Client
Eccleston Homes


Site
Mondi - Mill,
Ramsbottom , BL0 OBS.

Title
MMP Daily Tracking Record
28/03/25

Surveyed	IHB	Drawn	IHB
Chk.	IHB	Date	28/03/25
Scale	[A2 Sheet]	CAD file	
1:500	Supplied planning layout.dxf		
Dwg No.	MONDI-UR-V1-01-MMP-052		Rev A

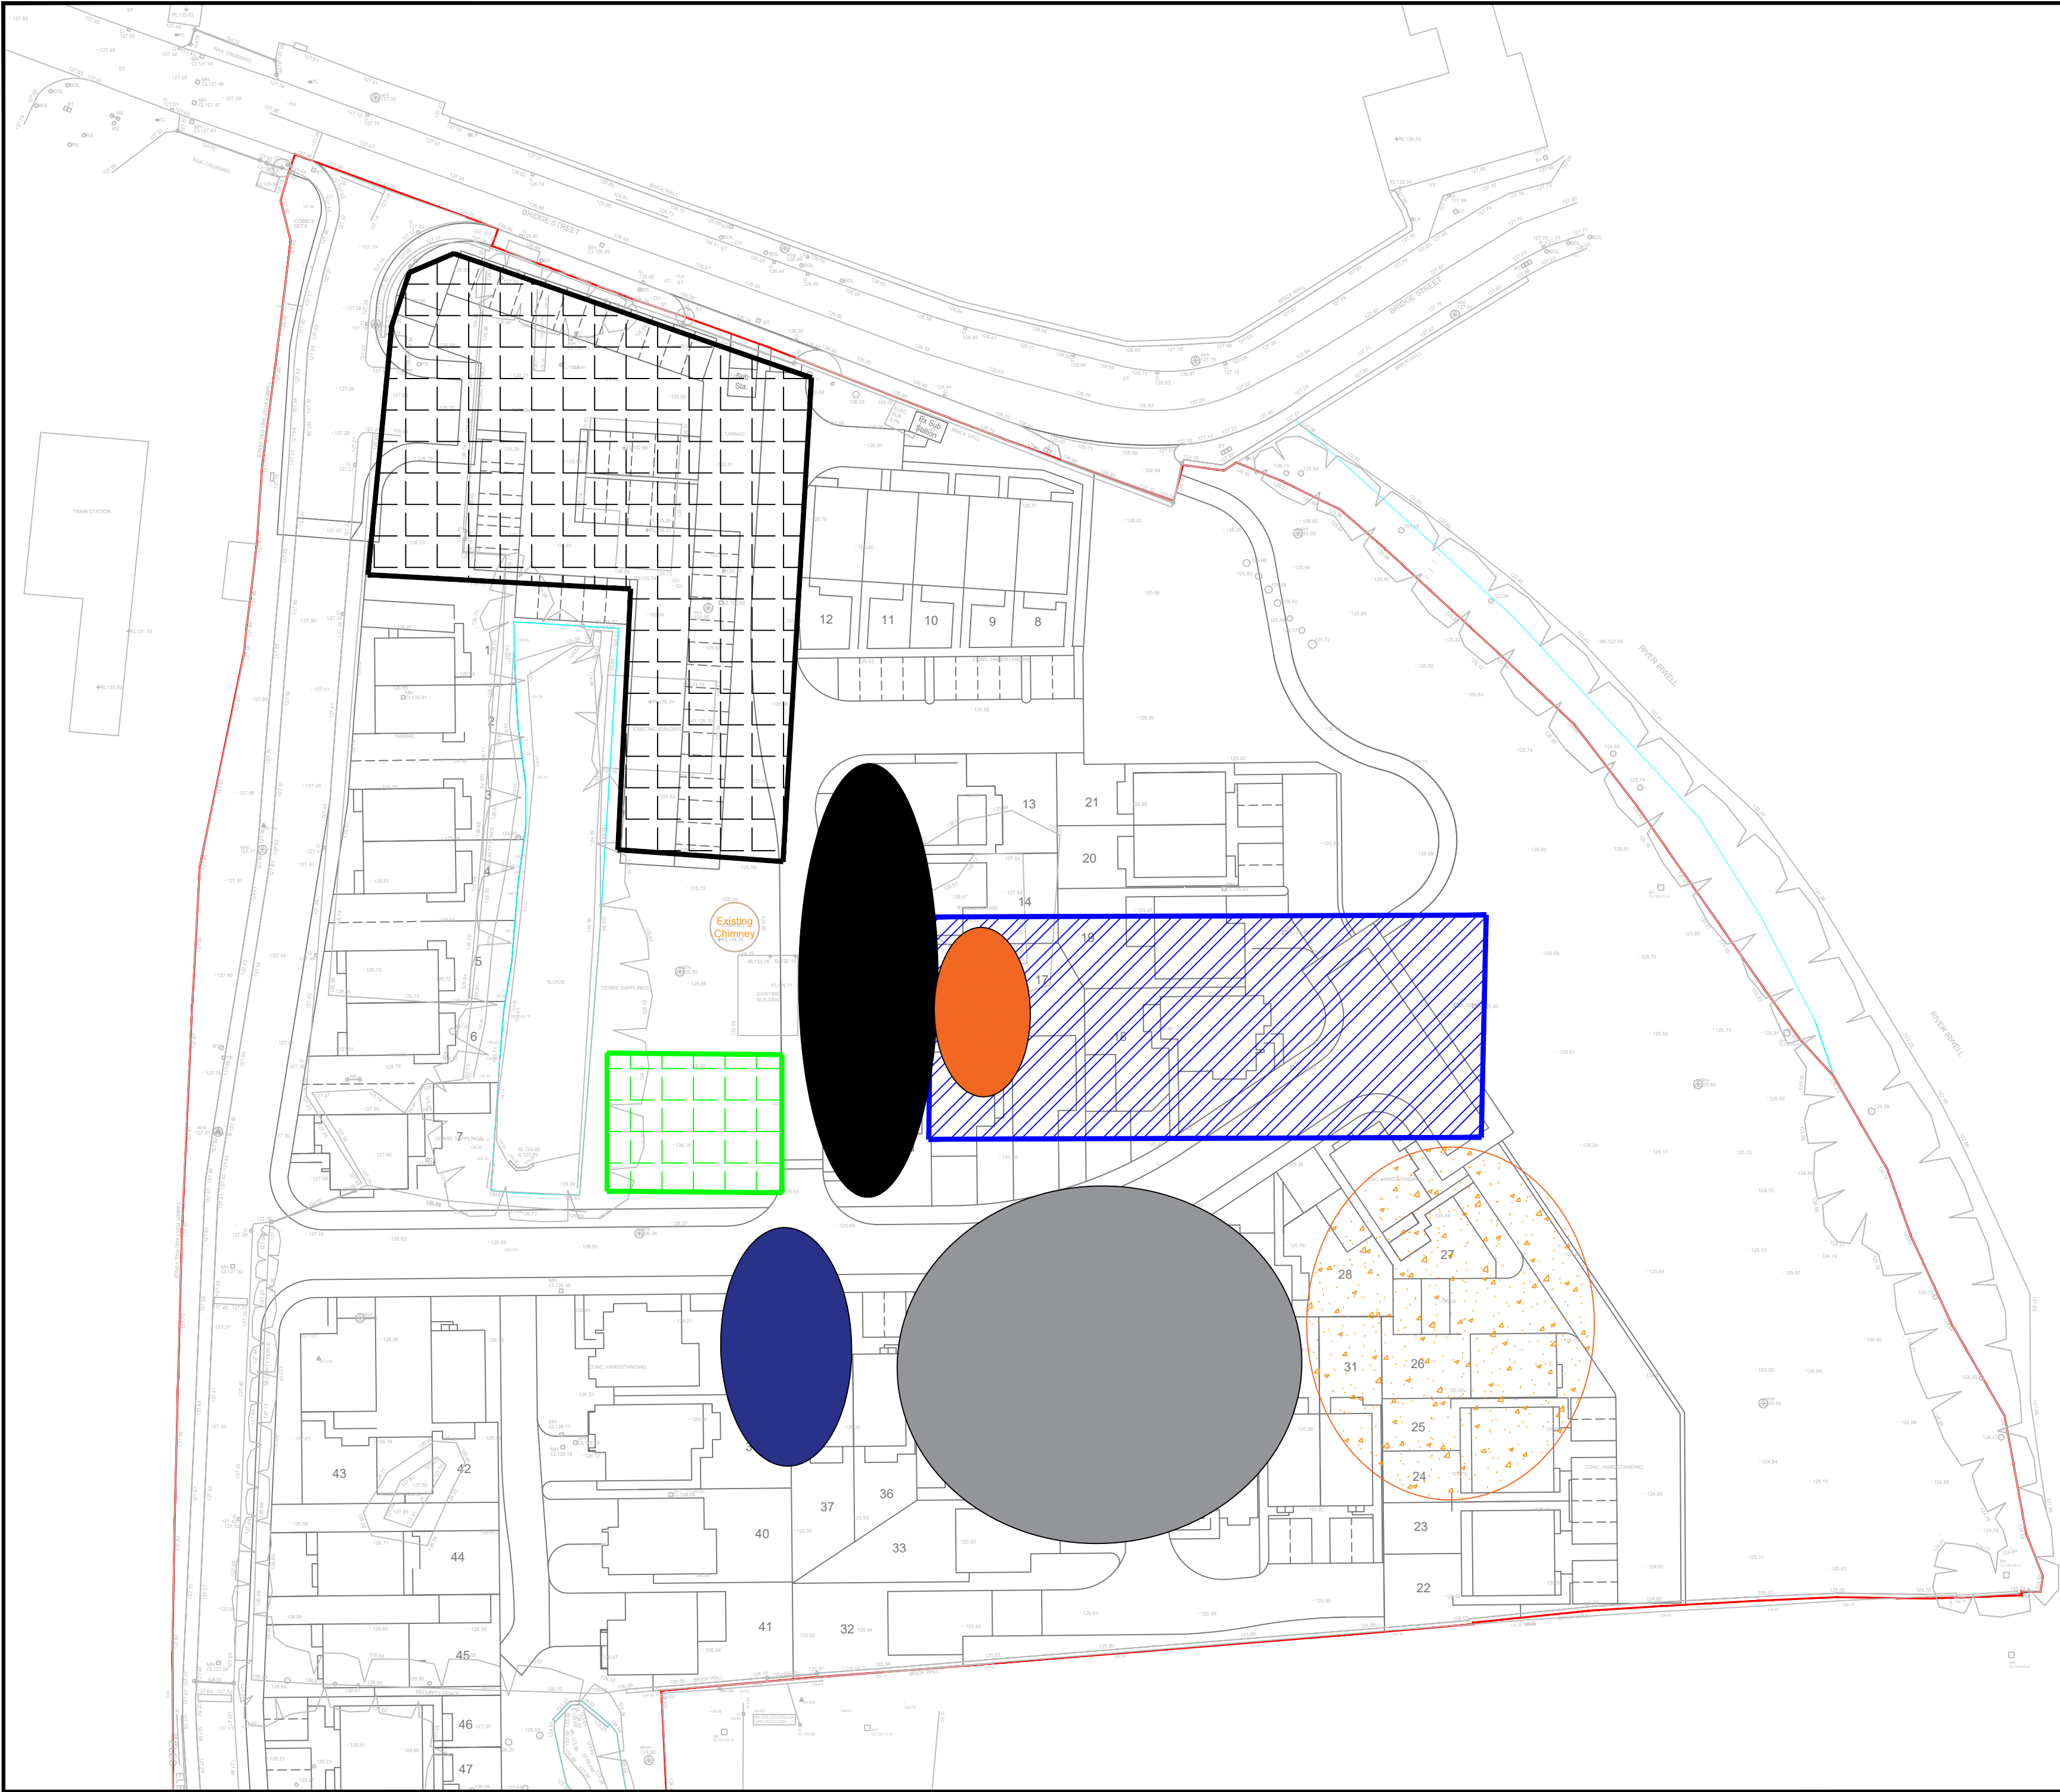

Notes
This drawing and the information contained therein is issued in confidence and is the copyright of Urban Regen Ltd. Disclosure of this information to Third Parties and unauthorised copying or replication of this data without approval is forbidden.

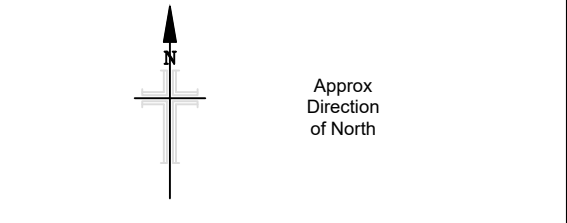

- Key:**
- Site boundary
 - Current compound location.
 - Off-site segregated stockpile locations.
 - Clean Concrete processing/stockpile.
 - Base layer Concrete processing/stockpile.
 - Made Ground Brick/Rubble stock.
 - Tarmac Stockpile.
 - Site Won Clean 6F2 Stockpile

Works Undertaken:

- 07:00 - 13:00 i excav. (Rick) & 30t excav. (Carl), loading sandvik screen to process brick rubble made ground. 30t excav., utilising hydraulic breaker to reduce O/S hard in size as required and breaking up structures removed 28/03/25.

-	---/---/---	--	Description	--
-	---/---/---	--	Description	--
Rev	Date	Drawn	Description	Chk'd



Urban Regen
ESTABLISHED 2001


Urban Regen Ltd.,
Langley Road,
Pendlebury,
Salford,
M6 6FG
TEL :
email :

Client
Eccleston Homes


Site
Mondi - Mill,
Ramsbottom , BL0 OBS.

Title
MMP Daily Tracking Record
29/03/25

Surveyed	IHB	Drawn	IHB
Chk.	IHB	Date	29/03/25
Scale	[A2 Sheet]	CAD file	
1:500	Supplied planning layout.dxf		
Dwg No.	MONDI-UR-V1-01-MMP-053		Rev A

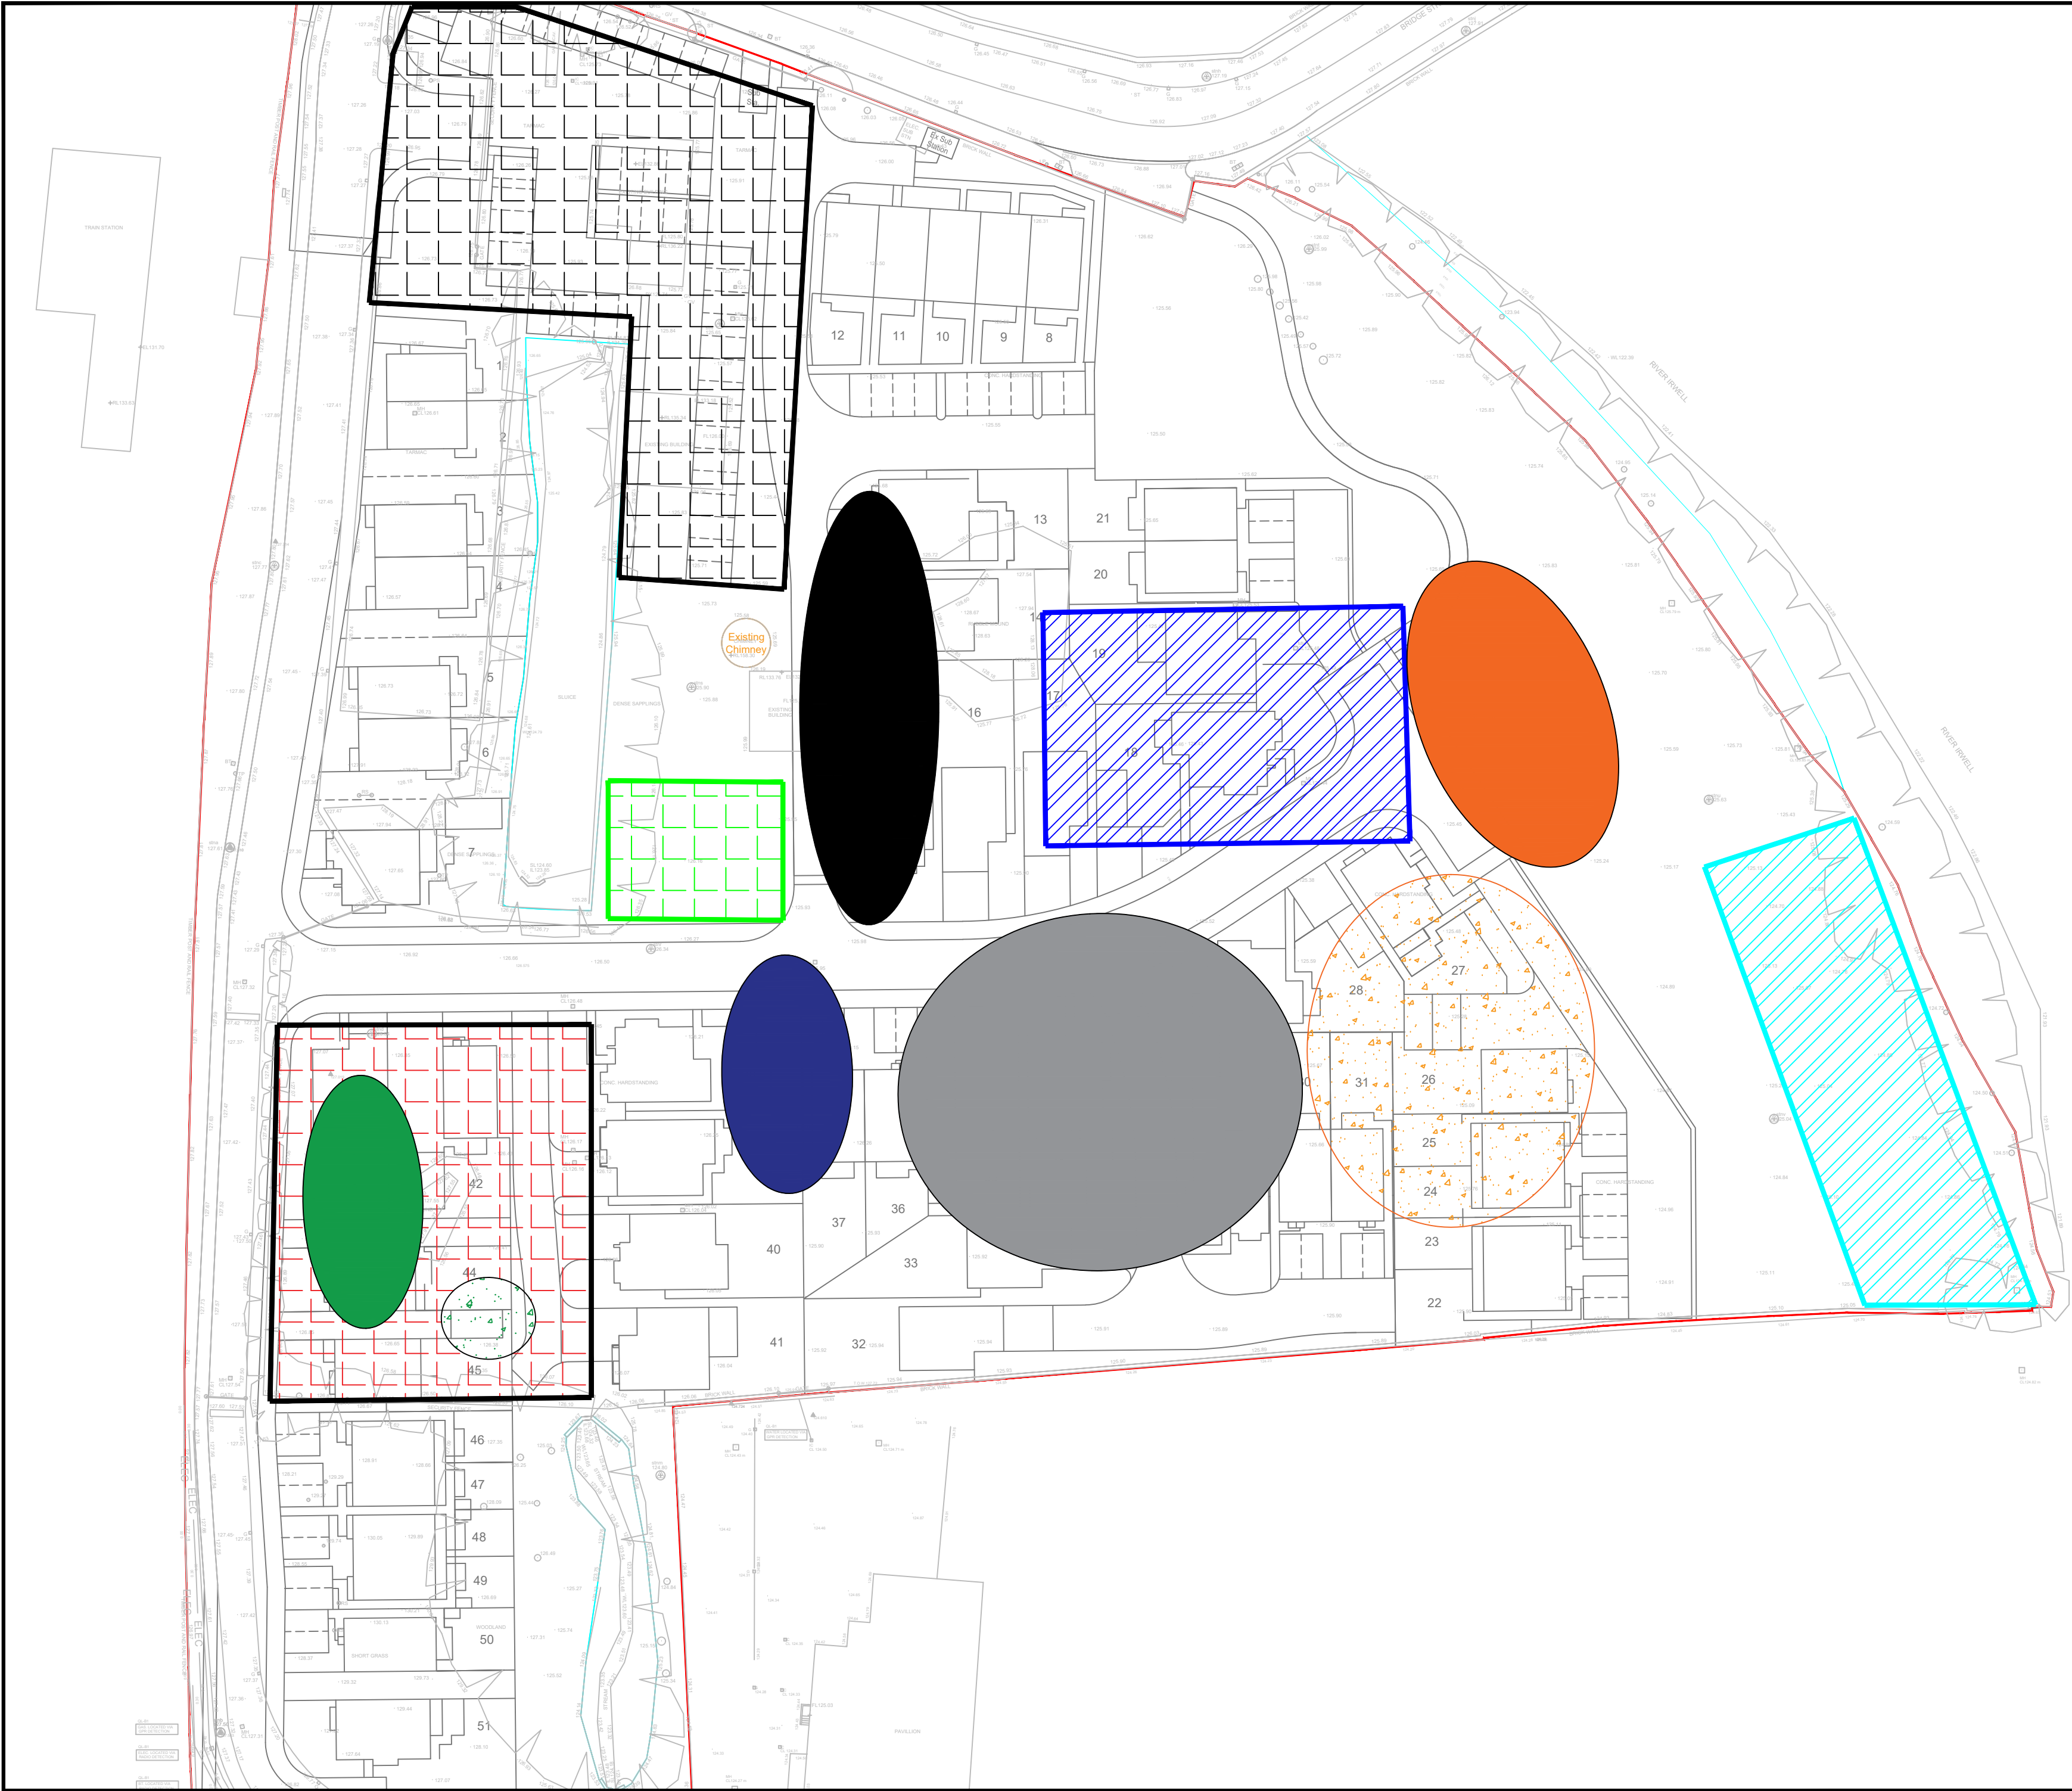

Notes
This drawing and the information contained therein is issued in confidence and is the copyright of Urban Regen Ltd. Disclosure of this information to Third Parties and unauthorised copying or replication of this data without approval is forbidden.

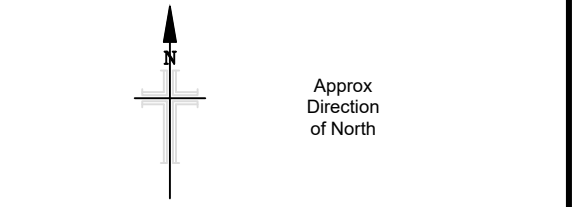

- Key:**
- Site boundary
 - Current compound location.
 - Off-site segregated stockpile locations.
 - Japanese Knotweed Processing Area.
 - Clean Concrete processing/stockpile.
 - Base layer Concrete processing/stockpile.
 - Made Ground Brick/Rubble stock.
 - Tarmac Stockpile.
 - Site Won Clean 6F2 Stockpile
 - JK Impacted soil stock off-site disposal.
 - O/S Hard removed from JK impacted soils.

- Works Undertaken:**
- 07:00 - 18:00 : 2 x 30t excav s (Carl & Rick) continuing with breakout of R.C tank encountered during turnover works in area 2 until 09:00 then setting up Sandvik screen with 30t excav. (Rick) processing stockpiled made ground from eastern P.O.S. 30t excav (Carl) maintaining belt stockpiling fines into area 2 turnover works & O/S hard materials hauled to made ground crush stockpile. Approx. 900 m3 processed and stockpiled in area 2 turnover works. 10 no. ADT (150 m3) loads of Hard O/S taken to clean concrete stock from screening op.
 - 07:00 - 17:00 : 22t excav. (Chris) continuing with made ground excavation from Eastern P.O.S. as-dug made ground materials sent to screening stockpile in task 1, 30 no. (390 m3) ADT loads sent to stock and approx. 200 m3 added to stock by excavator.

Rev	Date	Drawn	Description	Chk'd
-	--/--/----	--	Description	--
-	--/--/----	--	Description	--




Urban Regen Ltd.,
Langley Road,
Pendlebury,
Salford,
M6 6FG
TEL :
email :

Client
Eccleston Homes


Site
Mondi - Mill,
Ramsbottom , BL0 0BS.

Title
MMP Daily Tracking Record
02/04/25

Surveyed	IHB	Drawn	IHB
Chk.	IHB	Date	02/04/25
Scale	[A2 Sheet]	CAD file	
1:500	Supplied planning layout.dxf		
Dwg No.	MONDI-UR-V1-01-MMP-056		Rev A

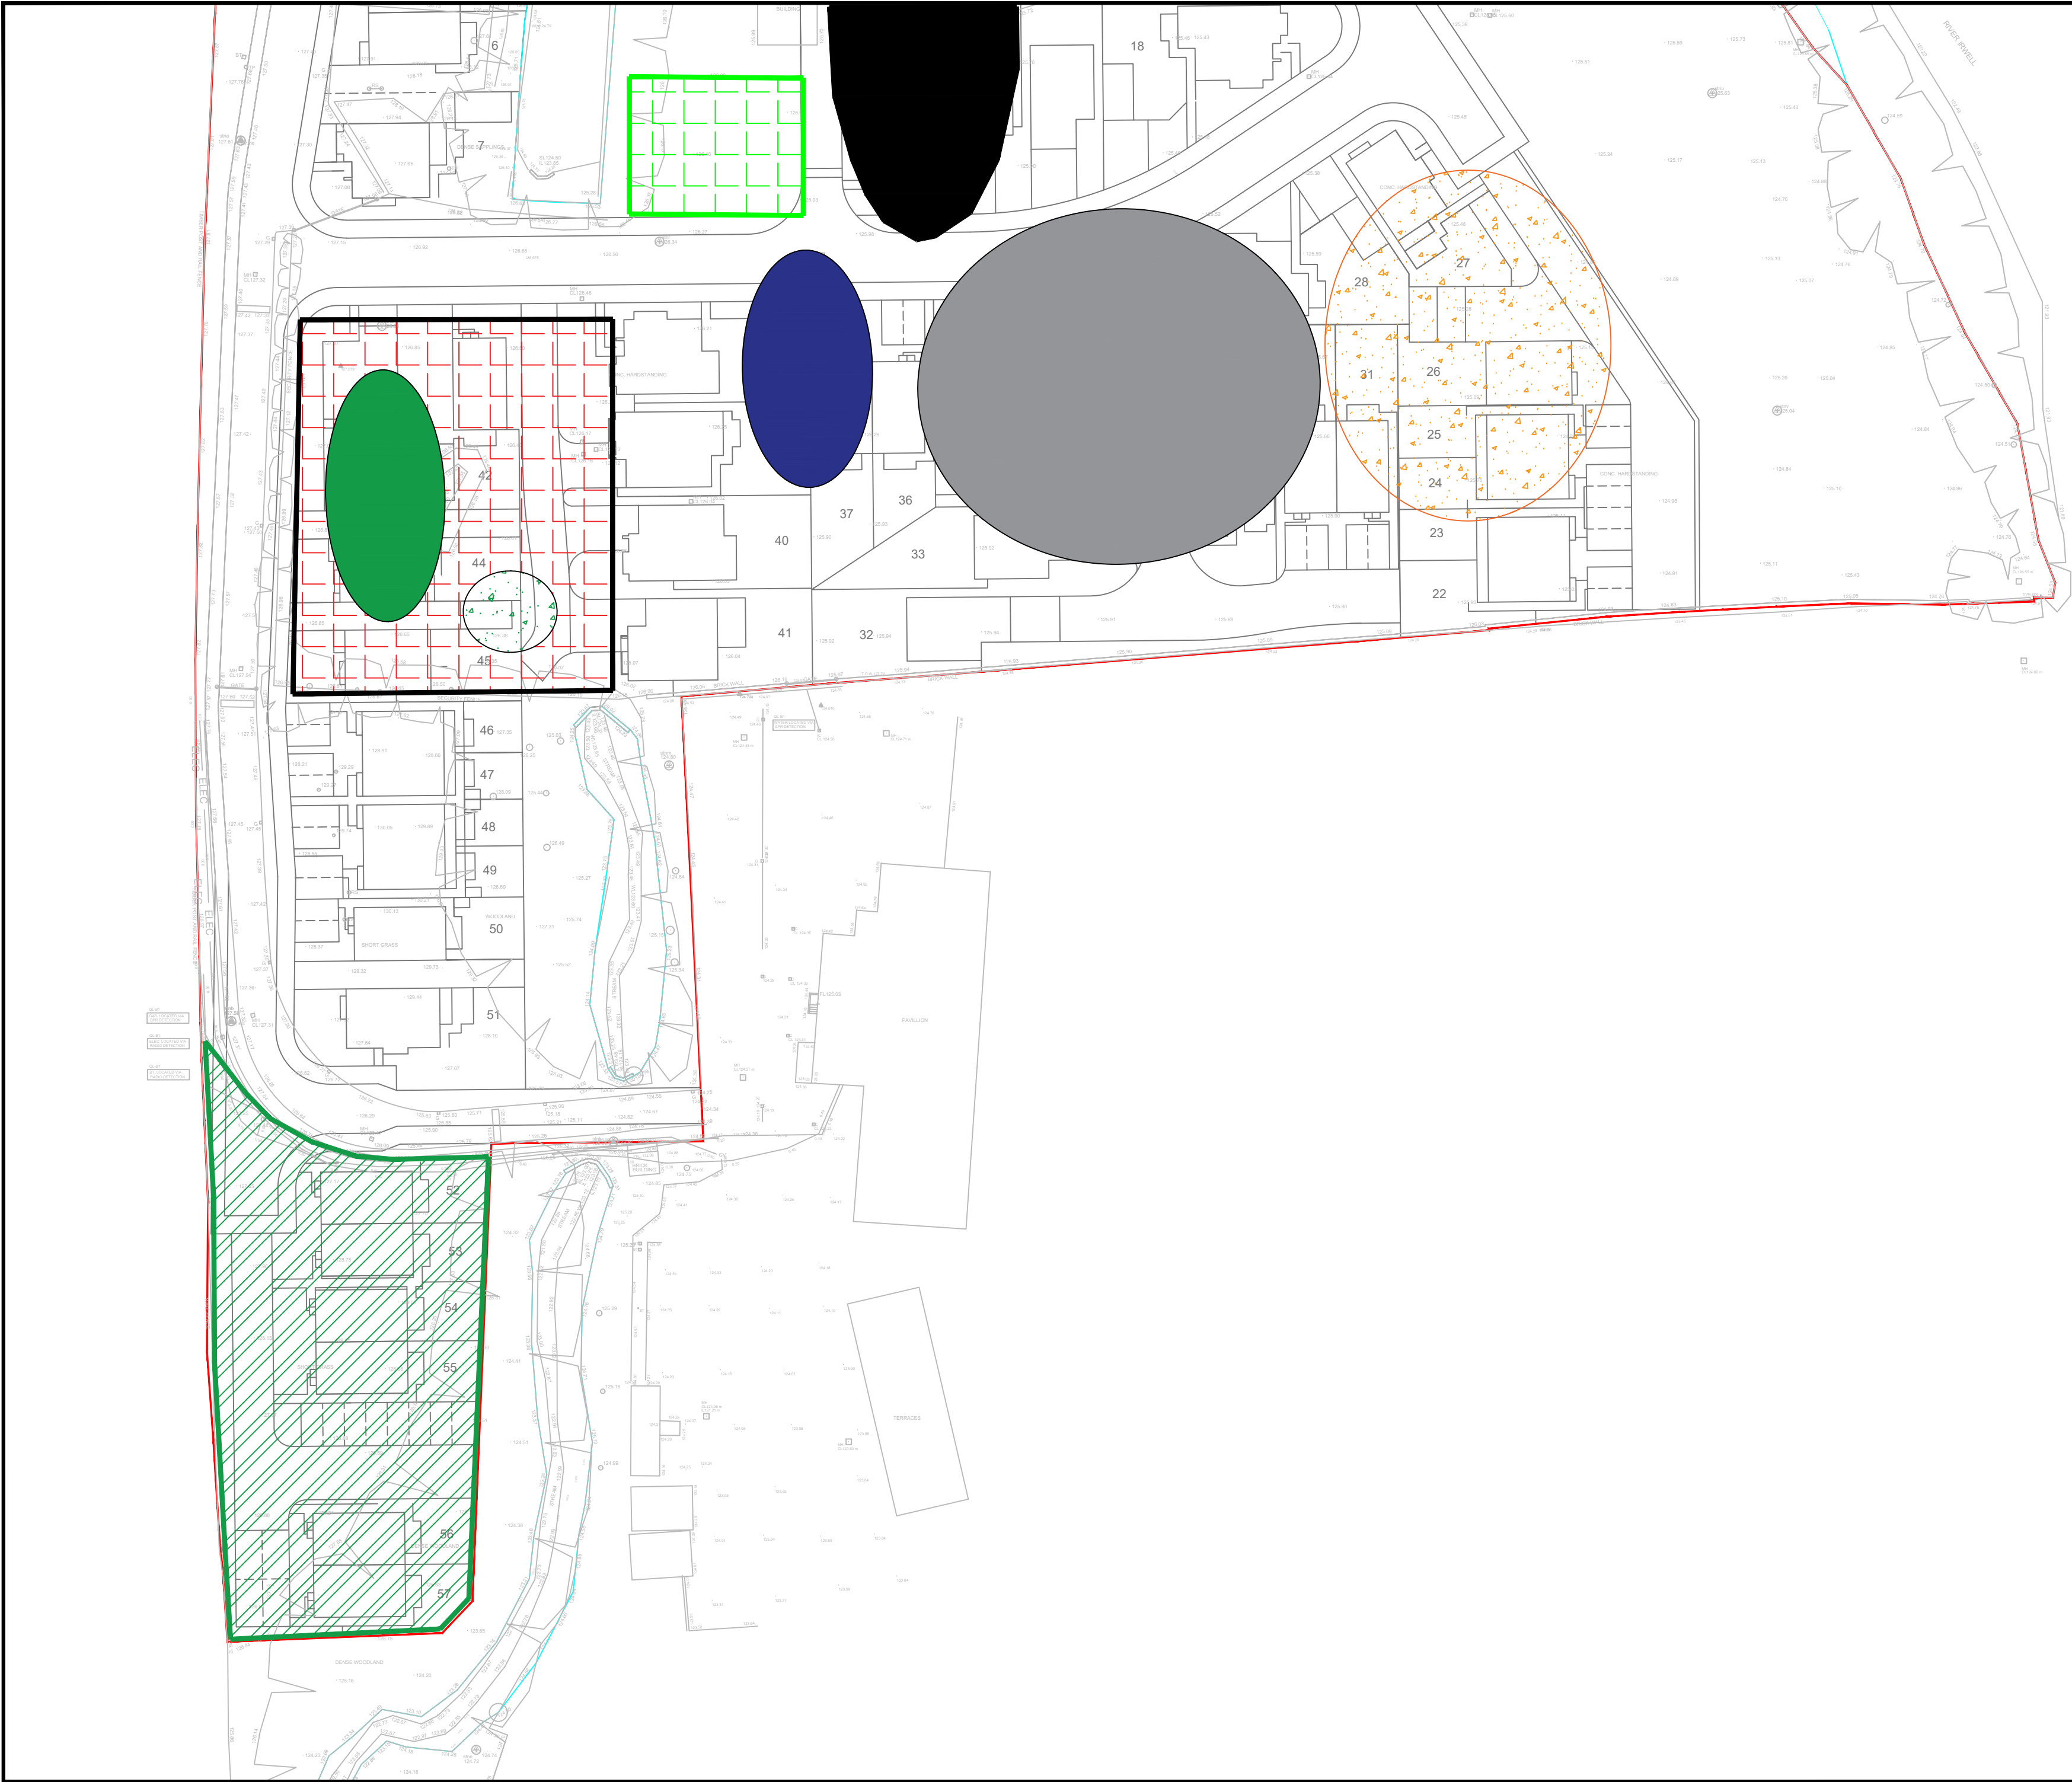

Notes
This drawing and the information contained therein is issued in confidence and is the copyright of Urban Regen Ltd. Disclosure of this information to Third Parties and unauthorised copying or replication of this data without approval is forbidden.

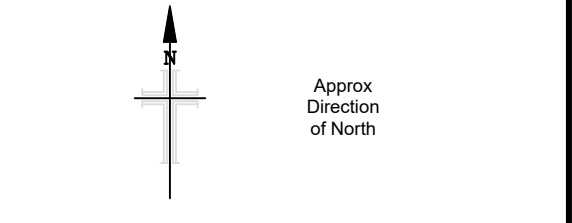

- Key:**
- Site boundary
 - Current compound location.
 - Off-site segregated stockpile locations.
 - Japanese Knotweed Processing Area.
 - Clean Concrete processing/stockpile.
 - Base layer Concrete processing/stockpile.
 - Made Ground Brick/Rubble stock.
 - Tarmac Stockpile.
 - Site Won Clean 6F2 Stockpile
 - JK Impacted soil stock off-site disposal.
 - O/S Hard removed from JK impacted soils.

- Works Undertaken:**
- 07:00 - 17:30 : 30t excav. (Carl) continuing with turnover works below plots 8-12 (previous reservoir & filter beds) removing all hard materials encountered up to 3m from EGL's in excess of 150mm dia. slow working as previous reservoir & filter beds in area with water encountered in granular materials approx. 2.0m from EGL's tractor & bowser used to de-water area. 5 no. (100m3) O/S hard material from turnover works area 2, taken to stockpile to be used as base layer & 7 no. (80 m3) of brick rubble encountered sent to stock on East POS/area 2 boundary in preparation of screening.
 - 07:00 - 17:30 : 30t excav. (Rick) completing turnover below plots 13 & 21 until 09:00, then utilising hydraulic breaker of former transformer house, boiler house & joiners store until 12:30 when pipe blew on oil quick attachment. Using DGN to level screened material into fill area until hose repaired on excav. at 14:30 then back to breaking structures compacted with 15t roller in 300mm layers.
 - 07:00 - 17:00 : 22t excav. (Chris) undertaking stockpile maintenance until 09:00 then undertaking reduced level excavation on western boundary (ELR railway) of area 6, loading 30t ADT with JK impacted materials under supervision of Knotweed Eradication , G Parry. Material tracked over area 6 to ensure no damage caused to existing kerblines/footpath. 6 no. ADT loads (75 m3) of JK impacted materials to processing area from area 6. 14:30 - 17:00 utilising ride bucket to remove handstanding from material and hand picked for rhizomes by G Parry remaining material added to off site stock generated 04-05/04/25 Access rd. to R.C.C closed to traffic as agreed with R.C.C during removal operation, access re-installed at 14:30.

-	--/--/----	--	Description	--
-	--/--/----	--	Description	--
Rev	Date	Drawn	Description	Chk'd



Urban Regen
ESTABLISHED 2001


Urban Regen Ltd.,
Langley Road,
Pendlebury,
Salford,
M6 6FG
TEL :
email :

Client
Eccleston Homes


Site
Mondi - Mill,
Ramsbottom , BL0 OBS.

Title
MMP Daily Tracking Record
04/04/25 (2)

Surveyed	IHB	Drawn	IHB
Chk.	IHB	Date	04/04/25
Scale	[A2 Sheet]	CAD file	
1:500	Supplied planning layout.dxf		
Dwg No.	MONDI-UR-V1-01-MMP-059		Rev A

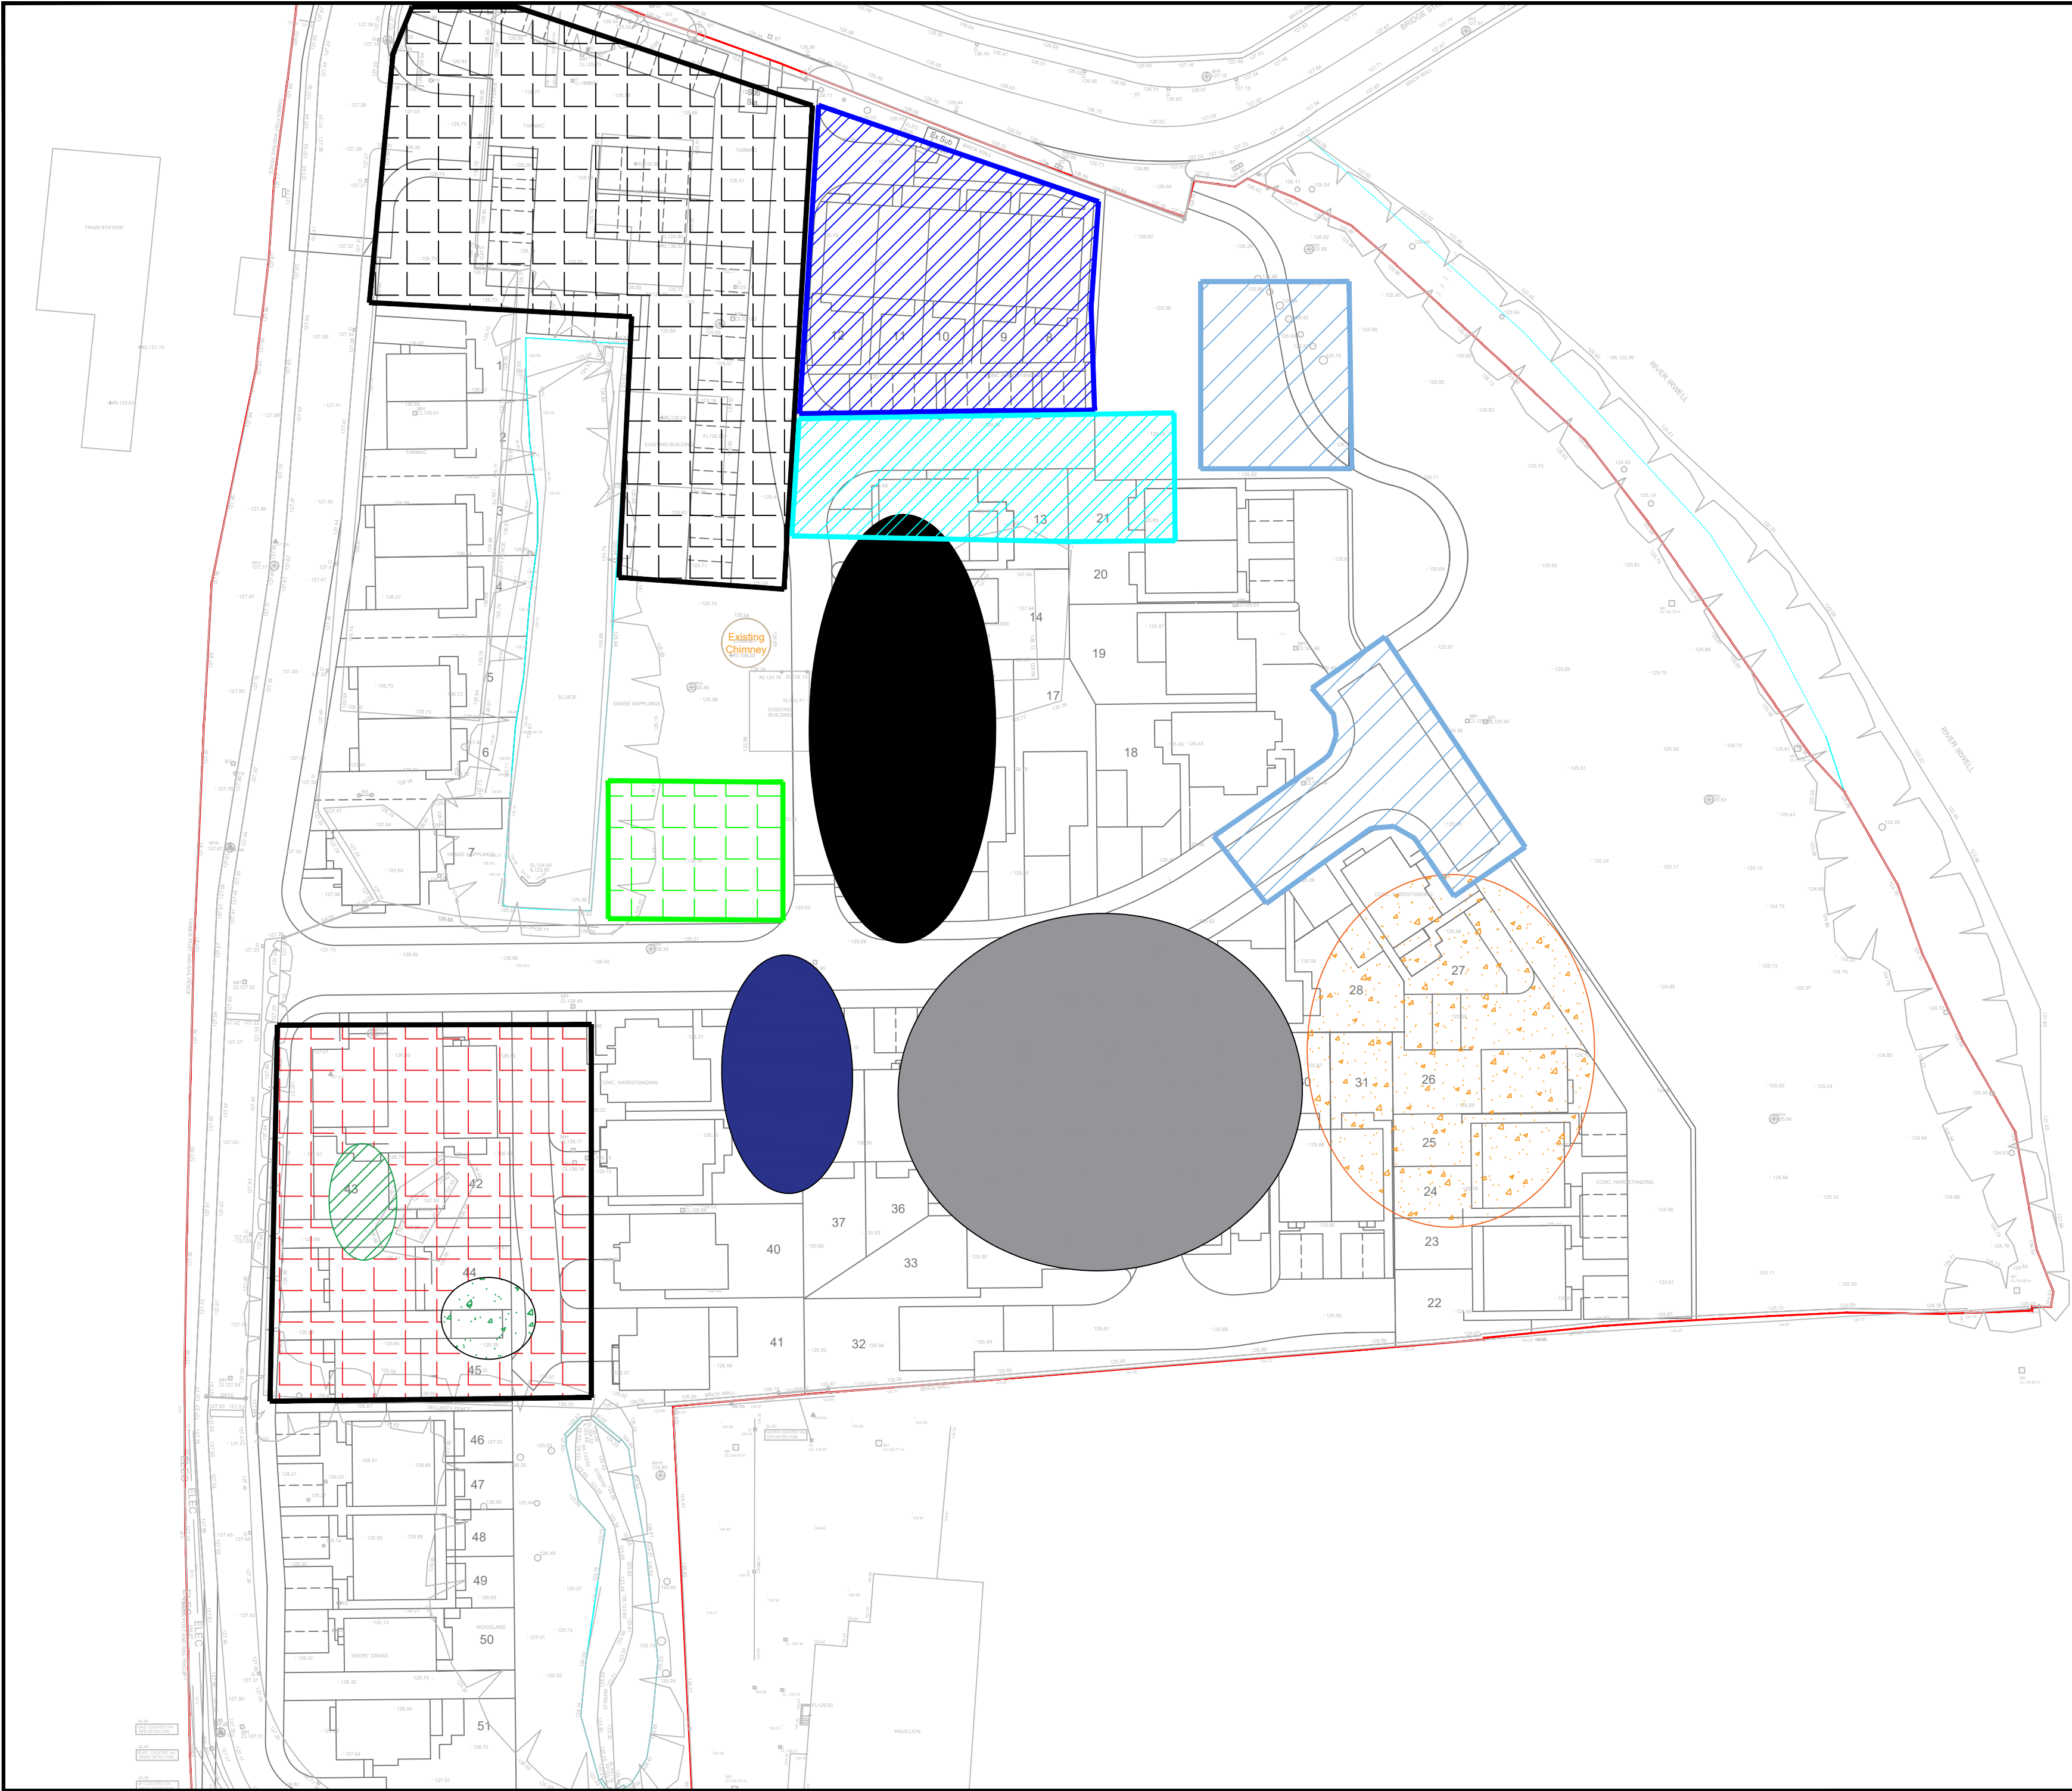

Notes
This drawing and the information contained therein is issued in confidence and is the copyright of Urban Regen Ltd. Disclosure of this information to Third Parties and unauthorised copying or replication of this data without approval is forbidden.

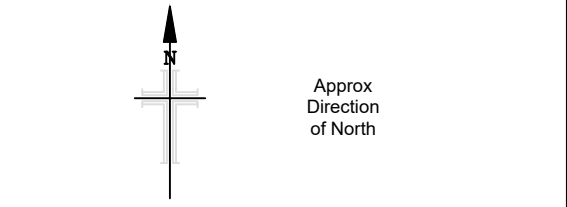

- Key:**
- Site boundary
 - Current compound location.
 - Off-site segregated stockpile locations.
 - Japanese Knotweed Processing Area.
 - Clean Concrete processing/stockpile.
 - Base layer Concrete processing/stockpile.
 - Tarmac Stockpile.
 - Site Won Clean 6F2 Stockpile
 - JK Impacted soil stock off-site disposal.
 - O/S Hard removed from JK impacted soils.


- Works Undertaken:**
- 07:00 - 18:00 : 30t excav. (Carl) continuing with turnover works below plots 8-12 (previous reservoir & filter beds) removing all hard materials encountered up to 3m from EGL's in excess of 150mm dia. slow working as previous reservoir & filter beds in area with water encountered in granular materials approx. 2.0m from EGL's tractor & bowser used to de-water area. 12:00 during excavation below plots 11/12 operator encountered assumed reservoir wall at EGL-2.0m, when chasing out found that wall running below area turned 05/04 (Wall appears to have been previously reduced in height at 1000mm wide below turnover undertaken), wall continued to EGL -4.500m at EGL -3.0m encountered heavy groundwater flow from wall. Tractor & Bowser used to de-water excav. Excav. undertaking slip trenches on works undertaken 03-07/04 through Plots 8-12 to EGL-3.0m to ensure that no other walls have been missed. Slip trenches backfilled and re-compacted. 4" Pump to be set up 08/04/25 to undertake removal.
 - 07:00 - 18:00 : Continuing with Breakout of heavy structures, utilising hydraulic breaker of former transformer house, heater house & joiners store until 12:30, then assisting with tractor & Bowser to de-water suspected reservoir wall (Used on site as dust suppression) until 14:00 then back to breaking above structures. Materials generated sent to segregated stocks
 - 07:00 - 17:00 : 22t excav. (Chris) loading 8 wheel 20t tipper with JK impacted materials from stockpile in former compound for off site disposal by B.J Crowther. 2 no. 8 wheel tipper on turnaround removing 14 no. loads (Approx. 154 m3). Material dry & light, having to fill above body before weight exceeded, approx 76 no. loads remaining, scheduled 3 no. wagons on turnaround with BJ Crowther to allow cleaning of area & inspection by Knotweed Eradication
 - 07:00 - 17:00 : 25t excav. (Andy) clearing hexagonal tank in N.E corner of eastern P.O.S below proposed Ecoclean compound in preparation of breaking & screening in-filled material along with made ground from eastern P.O.S. Undertaking stockpile maintenance in preparation of crushing 08/04. 16:00 - 17:00 undertaking reduced level dig through proposed road box of Area back down to natural at FGL-2.4m (approx.) to allow segregated tarmac & O/S hard generated from JK processing undertaken 31/03 & 04/04 to be buried at depth, proposed 300mm layer to be installed ensuring levels below proposed drainage excavation levels.
 - 07:00 - 17:00 : 13t Roller & 30t ADT servicing above work operations as required. 10 no. ADT (135 m3) loads of O/S hard materials taken to base layer concrete stock from turnover works and 7 no. (91 m3) loads of made ground from screening to fill area below plots 11/12.

Rev	Date	Drawn	Description	Chk'd
-	-	-	Description	-
-	-	-	Description	-


 **Urban Regen**
ESTABLISHED 2001

Urban Regen Ltd.,
Langley Road,
Pendlebury,
Salford,
M6 6FG
TEL :
email :

Client			
Eccleston Homes			
Site			
Mondi - Mill, Ramsbottom , BL0 OBS.			
Title			
MMP Daily Tracking Record 07/04/25			
Surveyed	IHB	Drawn	IHB
Chk.	IHB	Date	07/04/25
Scale	[A2 Sheet] CAD file		
1:500	Supplied planning layout.dxf		
Dwg No.	MONDI-UR-V1-01-MMP-060		Rev
		A	

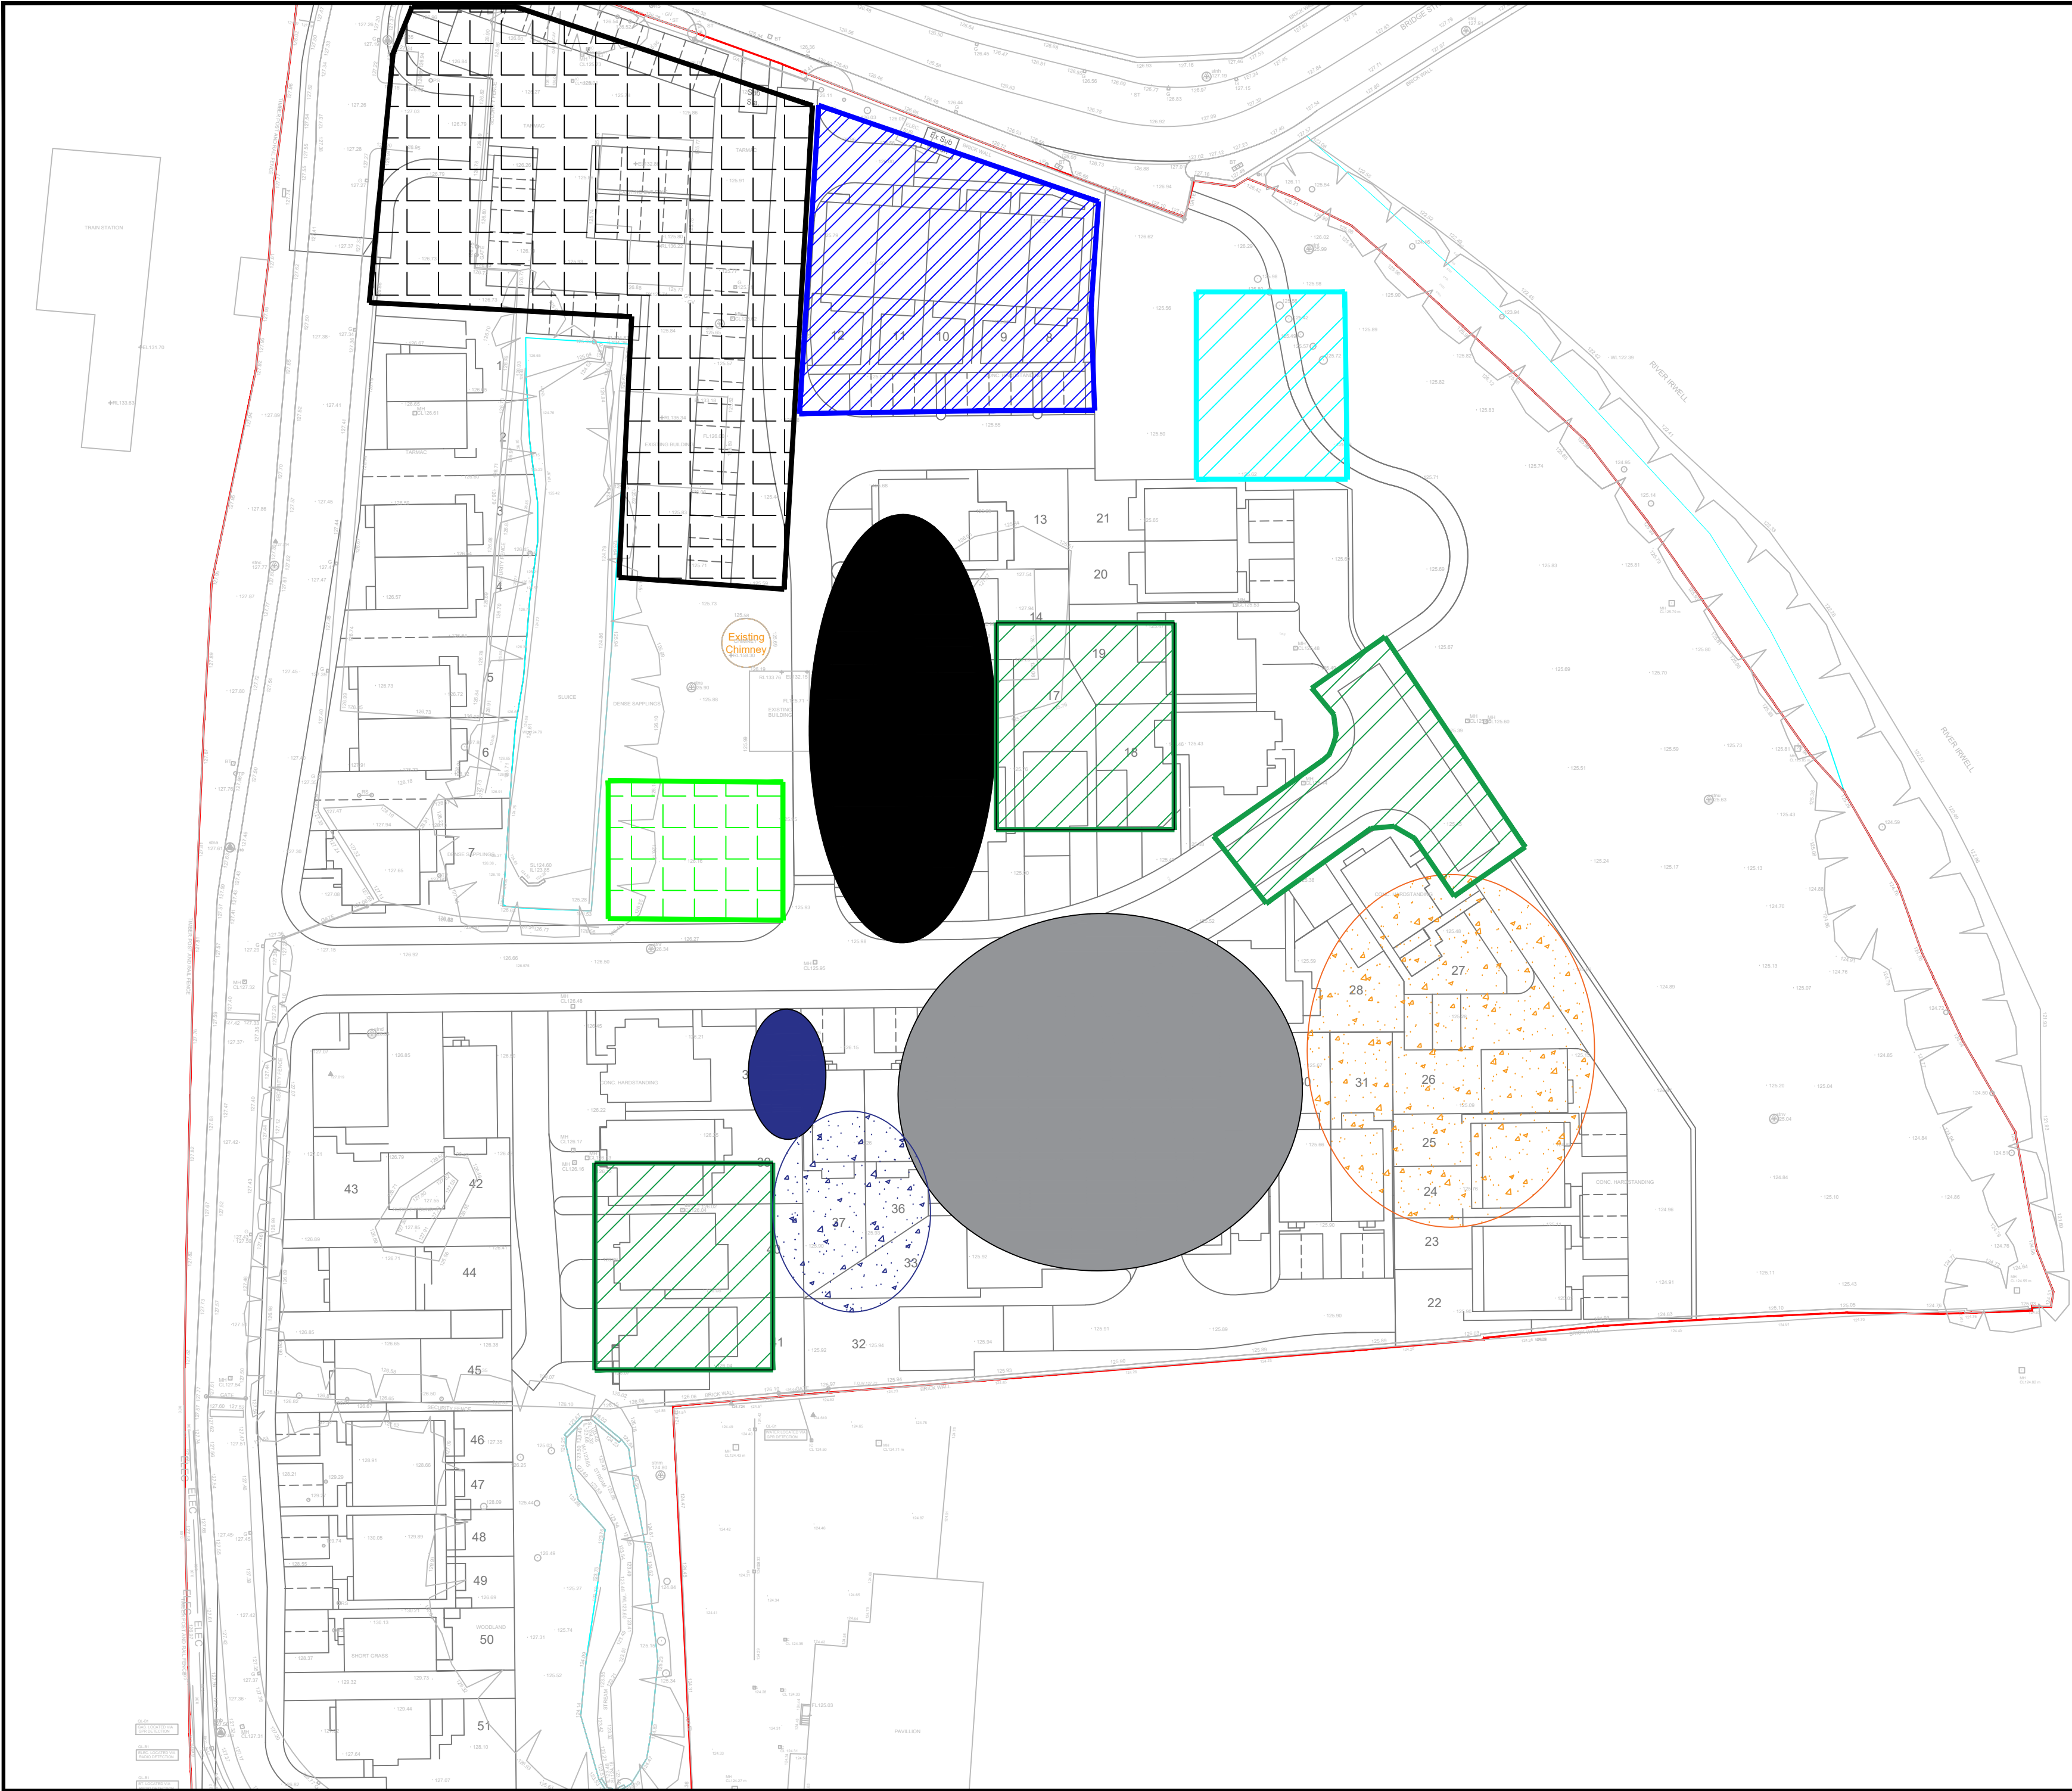

Notes
This drawing and the information contained therein is issued in confidence and is the copyright of Urban Regen Ltd. Disclosure of this information to Third Parties and unauthorised copying or replication of this data without approval is forbidden.

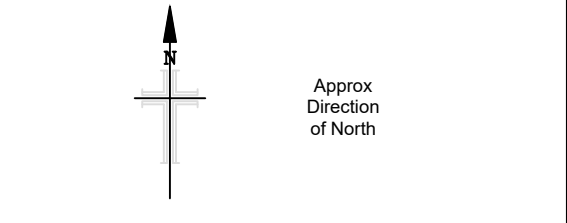

- Key:**
- Site boundary
 - Current compound location.
 - Off-site segregated stockpile locations.
 - Clean Concrete processing/stockpile.
 - Base layer Concrete processing/stockpile.
 - Tarmac Stockpile.
 - Processed site won O/S hard from JK works & tarmac.
 - Site Won Clean 6F2 Stockpile

- Works Undertaken:**
- 07:00 - 18:00 : 30t excav. (Carl) continuing with removal of former reservoir wall below plots 11/12 10:00 during last 1m of wall removal on north side of plots 11/12 wall widened & changed construction to BWork & sandstone and encountered mass ingress of water at depth, left for 1 hr to allow pump to get control of water and exposed brickwork arch (min 6m wide) connected to wall all structures encountered removed with plots 11/12 to 5.6m from proposed E.W.O. are backfilled with suitable materials encountered with initial layer at 1m thick to assist in sealing area as water ingress reduced but not stopped, then backfilled in 300mm layers compacted with 13t roller. Natural materials used from area, then backfilling with screened made ground fines recovered from road box excav undertaken 08-09/04/25 & continued backfilling with 6F2 from clean concrete stock up to 0.5m from proposed E.W.O.
 - 07:00 - 18:00 : 30t excav. (Rick) utilising hydraulic breaker to segregate remaining walls then clearing broken O/S hard from excavation of Hex. Tank, then commencing backfilling utilising screened fines from Hex. Tank infill material screened 08/04/25 compacted in 300mm layers with 13t roller. 13:30 - 17:00 loading 30t ADT with 6F2 from crush pile supplying Task 1. Also assisting Task 3 as required, maintaining, moving and clearing crusher.
 - 07:00 - 18:00 : 25t excav. (Andy) & 22t excav. (Chris) completing crushing of segregated tarmac stock, laying 400mm thick layer into road box excav. compacted with 13t roller in 200mm layers and trimming ensuring that material laid below proposed drainage excavation levels. 10:30 - 18:00 setting up crusher and commencing with crushing concrete base layer stock, processing and stockpiling on made ground screened fines laid 04-07/04/25. 22t excav loading with 25t excav. maintaining belt. 22t excav. finished at 17:00 allowing 25t excav. to undertake stockpile maintenance in preparation of continuing with crushing operation. Approx 300m3 processed in day.
 - 07:00 - 17:00 : 30t ADT & 13t roller (Rob) servicing above work operations as required. 8 no. (104 m3) O/S hard from turnover works plots 8-12 taken to base layer crush pile, 19 no. (247 m3) screened fines from Road 2 reduced level dig & 27 no. (350 m3) of 6F2 crush from processed stock used as gen fill below plots 8-12.
 - 07:00 - 17:00 : Tractor & Bowser being used as dust suppression due to prolonged dry period, on stockpiles, haul routes & work areas

Rev	Date	Drawn	Description	Chk'd
-	-	-	Description	-
-	-	-	Description	-




Urban Regen
ESTABLISHED 2001

Urban Regen Ltd.,
Langley Road,
Pendlebury,
Salford,
M6 6FG
TEL :
email :

Client			
Eccleston Homes			
Site			
Mondi - Mill, Ramsbottom , BL0 OBS.			
Title			
MMP Daily Tracking Record 09/04/25			
Surveyed	IHB	Drawn	IHB
Chk.	IHB	Date	09/04/25
Scale	[A2 Sheet] CAD file		
1:500	Supplied planning layout.dxf		
Dwg No.	MONDI-UR-V1-01-MMP-062		Rev
		A	



Notes
This drawing and the information contained therein is issued in confidence and is the copyright of Urban Regen Ltd. Disclosure of this information to Third Parties and unauthorised copying or replication of this data without approval is forbidden.

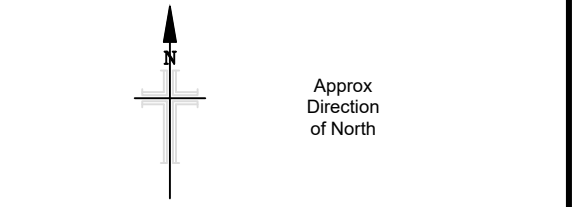

- Key:**
- Site boundary
 - Current compound location.
 - Off-site segregated stockpile locations.
 - Clean Concrete processing/stockpile.
 - As-dug non-tip waste stockpile.
 - As-dug non-tip waste temp stockpile.
 - Processed site won O/S hard from JK works & tarmac.
 - Site Won Clean 6F2 Stockpile
 - Base layer Concrete 6f2 stockpile

- Works Undertaken:**
- 07:00 - 18:00 : 2 no. 30t excav.'s (Rick & Carl) utilising hydraulic breaker,pulveriser continuing with breaking remaining slabs below ground structures & foundations below former concrete base layer stock Piles 13-15, O/S hard loaded into 30t ADT & added to Clean concrete stock and undertaking processing at clean concrete stock to assist crushing operation as required.
 - 07:00 - 18:00 : 22t excav. continuing to load Powertrack 400 crusher (Casey's) with O/S hard from clean concrete 2 stock, 25t excav. continuing with maintaining belt & added to 6f2 stock, and building wind breaks on either side of belt to reduce down on dust in area 1 area, 22t excav. segregating and stockpiling O/S sandstone blocks/boulders within stock as due to be utilised with Golt western batter retaining detail, 22t excav. & crusher operating until 17:00, 25t excav. undertaking stock maintenance until 18:00, Approx. 400 m3 produced in shift.
 - 07:30 - 16:30 : 22t excav. (Craig) undertaking reduced level excavation of existing stockpiled material on top of former reservoir/landfill in area 6, haymaking material to access ready to be loaded and to allow additional testing of tip material by Betts-Geo, Top of Tip exposed with as-dug material being stockpiled adjacent to access rd. ready to be loaded, 07:30 - 13:30 30t ADT (Ohy) stood awaiting material being moved by excav, 13:30 - 16:30 13t excav (Graham) sat in former compound stockpiling hauled material to keep ADT tyres clean, & gen ops. (Sean, Callum & mason) marshalling traffic to R.C.C whilst ADT on road
 - 07:00 - 17:00 : 30t ADT servicing above work operations as required

Rev	Date	Drawn	Description	Chk'd
-	--/--/----	--	Description	--
-	--/--/----	--	Description	--




Urban Regen Ltd.,
Langley Road,
Pendlebury,
Salford,
M6 6FG
TEL :
email :

Client			
Eccleston Homes			
Site			
Mondi - Mill, Ramsbottom , BL0 0BS.			
Title			
MMP Daily Tracking Record 16/04/25			
Surveyed	IHB	Drawn	IHB
Chk.	IHB	Date	16/04/25
Scale	[A2 Sheet] CAD file		
1:500	Supplied planning layout.dxf		
Dwg No.	MONDI-UR-V1-01-MMP-068		Rev
		A	



Notes
This drawing and the information contained therein is issued in confidence and is the copyright of Urban Regen Ltd. Disclosure of this information to Third Parties and unauthorised copying or replication of this data without approval is forbidden.

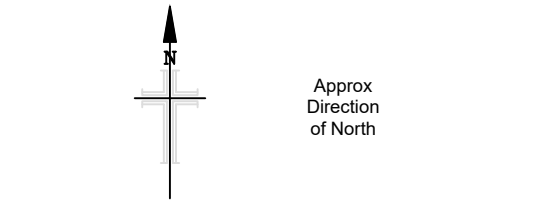

- Key:**
- Site boundary
 - Current compound location.
 - Off-site segregated stockpile locations.
 - Clean Concrete processing/stockpile.
 - As-dug non-tip waste stockpile.
 - As-dug non-tip waste temp stockpile.
 - Processed site won O/S hard from JK works & tarmac.
 - Site Won Clean 6F2 Stockpile
 - Base layer Concrete 6F2 stockpile

- Works Undertaken:**
- 07:00 - 18:00 : 2 no. 30t excav.'s (Rick & Carl) utilising hydraulic breaker/pulveriser continuing with breaking remaining slabs/below ground structures & foundations below former concrete base layer stock Piles 13-15, O/S hard loaded into 30t ADT & added to Clean concrete stock and undertaking processing at clean concrete stock to assist crushing operation as required.
 - 07:00 - 18:00 : 22t excav. continuing to load Powertrack 400 crusher (Casey's) with O/S hard from clean concrete 2 stock, 25t excav. continuing with maintaining belt & added to 6F2 stock, and building wind breaks on either side of belt to reduce down on dust in area 1 area, 22t excav. segregating and stockpiling O/S sandstone blocks/boulders within stock as due to be utilised with Golt western batter retaining detail, 22t excav. & crusher operating until 17:00, 25t excav. undertaking stock maintenance until 18:00, Approx. 400 m3 produced in shift.
 - 07:30 - 16:30 : 22t excav. (Craig) undertaking reduced level excavation of existing stockpiled material on top of former reservoir/landfill in area 6, haymaking material to access ready to be loaded and to allow additional testing of tip material by Betts-Geo, Top of Tip exposed with as-dug material being stockpiled adjacent to access rd. ready to be loaded, 07:30 - 13:30 30t ADT (Oly) stood awaiting material being moved by excav, 13:30 - 16:30 13t excav (Graham) sat in former compound stockpiling hauled material to keep ADT tyres clean, & gen ops. (Sean, Callum & mason) marshalling traffic to R.C.C whilst ADT on road.
 - 07:00 - 17:00 : 30t ADT servicing above work operations as required

-	--/--/----	--	Description	--
-	--/--/----	--	Description	--
Rev	Date	Drawn	Description	Chk'd

 **Urban Regen**
ESTABLISHED 2001

Urban Regen Ltd.,
Langley Road,
Pendlebury,
Salford,
M6 6FG
TEL :
email :

Client
Eccleston Homes


Site
Mondi - Mill,
Ramsbottom , BL0 0BS.

Title
MMP Daily Tracking Record
16/04/25 (2)

Surveyed	IHB	Drawn	IHB
Chk.	IHB	Date	16/04/25
Scale	[A2 Sheet]	CAD file	
1:500	Supplied planning layout.dxf		
Dwg No.	MONDI-UR-V1-01-MMP-069		Rev A



Notes
This drawing and the information contained therein is issued in confidence and is the copyright of Urban Regen Ltd. Disclosure of this information to Third Parties and unauthorised copying or replication of this data without approval is forbidden.

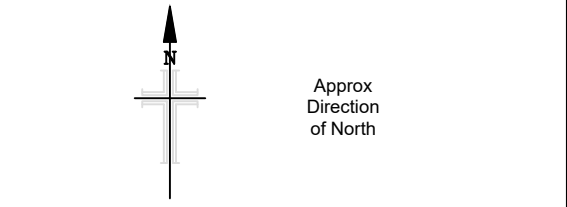

- Key:**
- Site boundary
 - Current compound location.
 - Off-site segregated stockpile locations.
 - Clean Concrete processing/stockpile.
 - As-dug non-tip waste stockpile.
 - As-dug non-tip waste temp stockpile.
 - Processed site won O/S hard from JK works & tarmac.
 - Site Won Clean 6F2 Stockpile
 - Base layer Concrete 6f2 stockpile

Works Undertaken:

- 07:00 - 18:00 : 2 no. 30t excav.'s (Rick & Carl) utilising hydraulic breaker/pulveriser continuing with breaking remaining slabs/below ground structures & foundations below former concrete base layer stock Piles 13-15. O/S hard loaded into 30t ADT & added to Clean concrete stock and undertaking processing at clean concrete stock to assist crushing operation as required.

- 07:00 - 18:00 : 22t excav. continuing to load Powertrack 400 crusher (Casey's) with O/S hard from clean concrete 2 stock. 25t excav. continuing with maintaining belt & added to 6f2 stock, and building wind breaks on either side of belt to reduce down on dust in area 1 area. 22t excav. segregating and stockpiling O/S sandstone blocks/boulders within stock as due to be utilised with Got western batter retaining detail. 22t excav. & crusher operating until 16:00. 25t excav. undertaking stock maintenance until 17:00. Approx. 350 m3 produced.

- 07:30 - 16:30 : 22t excav. (Craig) undertaking reduced level excavation of existing stockpiled material on top of former reservoir/landfill in area 6, haymaking material to access ready to be loaded and to allow additional testing of tip material by Betts-Geo. Top of Tip exposed with as-dug material being stockpiled adjacent to access rd. ready to be loaded. 07:30 - 09:00 30t ADT (Oily) stood awaiting material being moved by excav., 13t excav (Graham) sat in former compound stockpiling hauled material to keep ADT tyres clean, & gen ops. (Sean, Callum & mason) marshalling traffic to R.C.C whilst ADT on road 11 no. as dug loads taken to temp stock in former compound from area 6. 12:00 - 16:30 22t excav stockpiling remainder of above tip material adjacent access rd. ready to haul, once arranged with R.C.C. 13t excav. loading ADT from temp stock & hauling to eastern P.O.S 6 no loads (78 m3). 30t ADT also servicing Task 1 removing 3 no. loads re-bar & 3 no. (38 m3) no. loads of clean concrete O/S hauled to clean concrete 2 stock.


-	--/--/----	--	Description	--
-	--/--/----	--	Description	--
Rev	Date	Drawn	Description	Chk'd




Urban Regen
ESTABLISHED 2001

Urban Regen Ltd.,
Langley Road,
Pendlebury,
Salford,
M6 6FG
TEL :
email :

Client			
Eccleston Homes			
Site			
Mondi - Mill, Ramsbottom , BL0 0BS.			
Title			
MMP Daily Tracking Record 17/04/25			
Surveyed	IHB	Drawn	IHB
Chk.	IHB	Date	17/04/25
Scale	[A2 Sheet] CAD file		
1:500	Supplied planning layout.dxf		
Dwg No.			Rev
MONDI-UR-V1-01-MMP-070			A

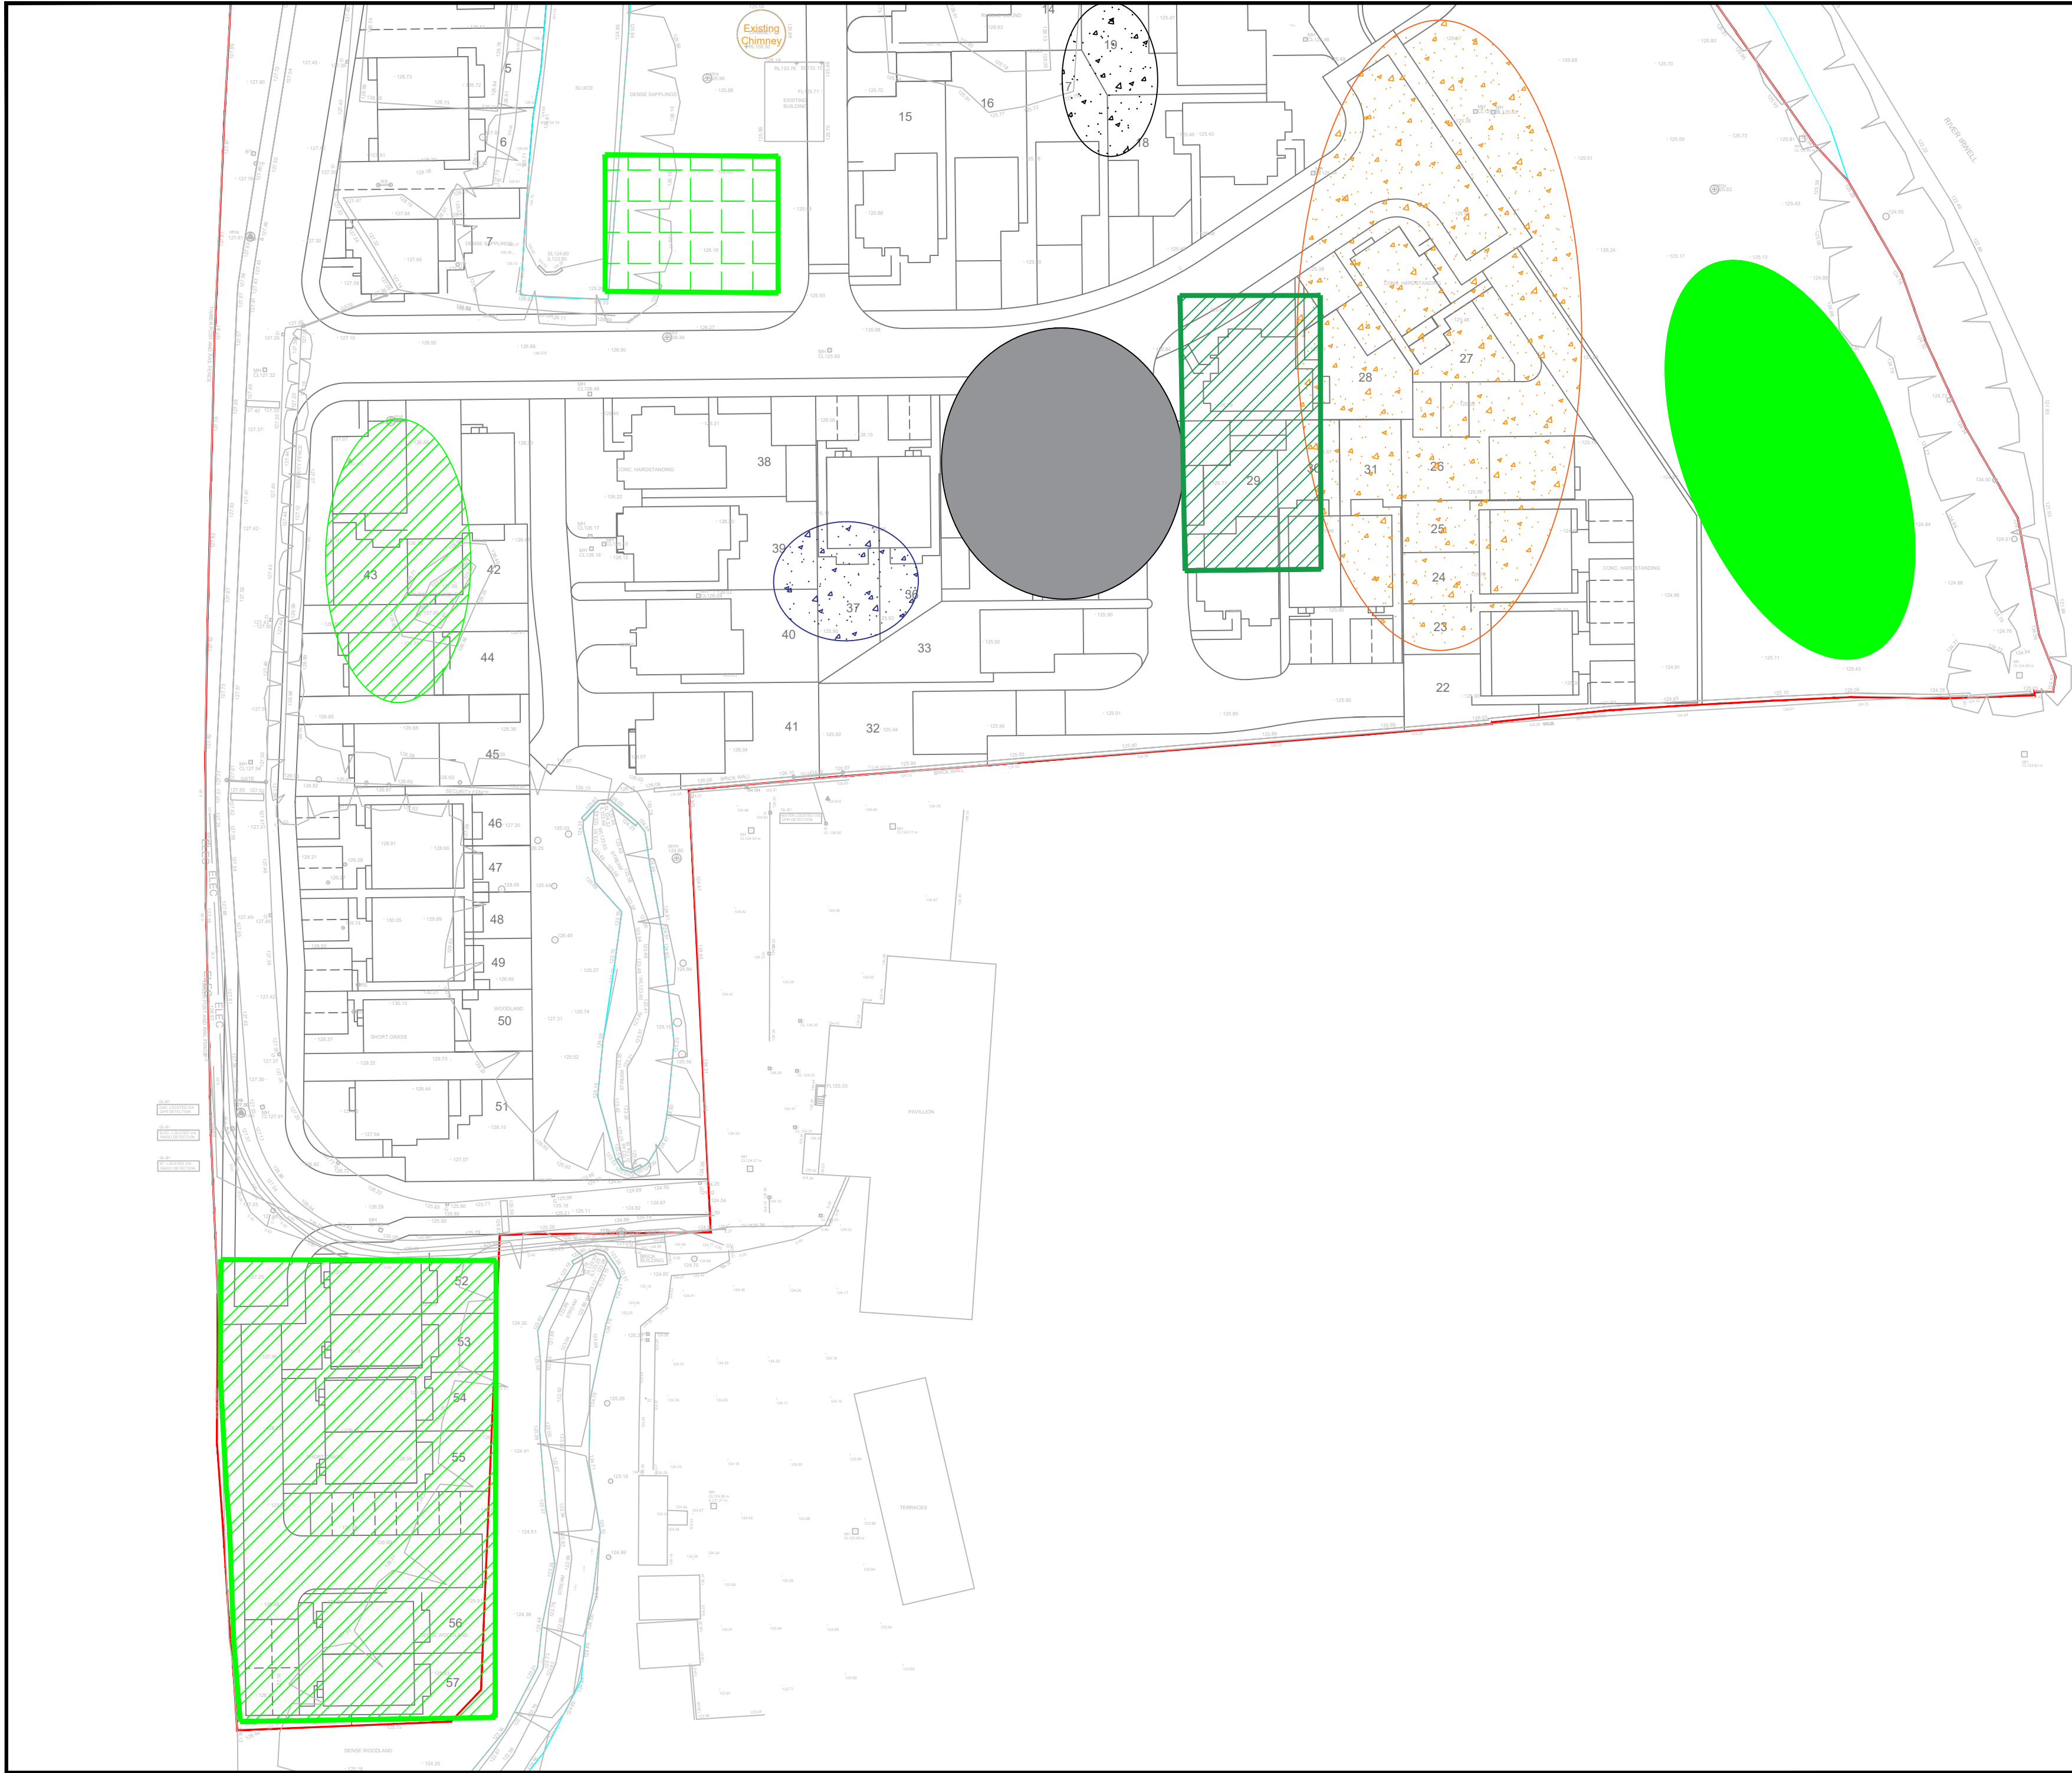

Notes
This drawing and the information contained therein is issued in confidence and is the copyright of Urban Regen Ltd. Disclosure of this information to Third Parties and unauthorised copying or replication of this data without approval is forbidden.

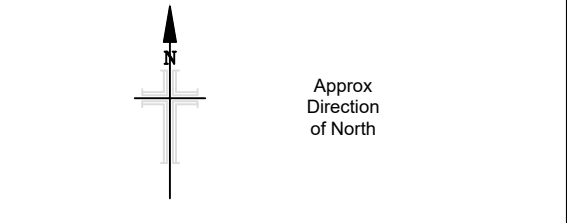

- Key:**
- Site boundary
 - Current compound location.
 - Off-site segregated stockpile locations.
 - Clean Concrete processing/stockpile.
 - As-dug non-tip waste stockpile.
 - As-dug non-tip waste temp stockpile.
 - Processed site won O/S hard from JK works & tarmac.
 - Site Won Clean 6F2 Stockpile
 - Base layer Concrete 6F2 stockpile

- Works Undertaken:**
- 07:00 - 18:00 : 2 no. 30t excav. 's (Rick & Carl) utilising hydraulic breaker/pulveriser continuing with breaking remaining slabs below ground structures & foundations below former concrete base layer stock Piles 13-15. O/S hard loaded into 30t ADT & added to Clean concrete 2 stock and undertaking processing at clean concrete stock 2 to assist crushing operation as required.
 - 07:00 - 18:00 : 22t excav. continuing to load Powertrack 400 crusher (Casey's) with O/S hard from clean concrete 2 stock. 25t excav. continuing with maintaining belt & added to 6F2 stock, and building wind breaks on either side of belt to reduce down on dust in area 1 area. 22t excav. segregating and stockpiling O/S sandstone blocks/boulders within stock as due to be utilised with Golt western batter retaining detail. 22t excav. & crusher operating until 16:00. 25t excav. undertaking stock maintenance until 17:00. Approx. 350 m3 produced.
 - 07:30 - 16:30 : 22t excav. (Craig) undertaking reduced level excavation of existing stockpiled material on top of former reservoir/landfill in area 6, haymaking material to access ready to be loaded and to allow additional testing of tip material by Betts-Geo. Top of Tip exposed with as-dug material being stockpiled adjacent to access rd. ready to be loaded. 07:30 - 09:00 30t ADT (Oily) stood awaiting material being moved by excav. 13t excav (Graham) sat in former compound stockpiling hauled material to keep ADT tyres clean. & gen ops. (Sean, Callum & mason) marshalling traffic to R.C.C. whilst ADT on road 11 no. as dug loads taken to temp stock in former compound from area 6. 12:00 - 16:30 22t excav stockpiling remainder of above tip material adjacent access rd. ready to haul, once arranged with R.C.C. 13t excav. loading ADT from temp stock & hauling to eastern P.O.S 6 no loads (78 m3). 30t ADT also servicing Task 1 removing 3 no. loads re-bar & 3 no. (38 m3) no. loads of clean concrete O/S hauled to clean concrete 2 stock.

-	--/--/----	--	Description	--
-	--/--/----	--	Description	--
Rev	Date	Drawn	Description	Chk'd




Urban Regen
ESTABLISHED 2001

Urban Regen Ltd.,
Langley Road,
Pendlebury,
Salford.
M6 6FG
TEL :
email :

Client			
Eccleston Homes			
Site			
Mondi - Mill, Ramsbottom , BL0 OBS.			
Title			
MMP Daily Tracking Record 17/04/25 (2)			
Surveyed	IHB	Drawn	IHB
Chk.	IHB	Date	17/04/25
Scale	[A2 Sheet] CAD file		
1:500	Supplied planning layout.dxf		
Dwg No.	MONDI-UR-V1-01-MMP-071		Rev
		A	



Notes
This drawing and the information contained therein is issued in confidence and is the copyright of Urban Regen Ltd. Disclosure of this information to Third Parties and unauthorised copying or replication of this data without approval is forbidden.

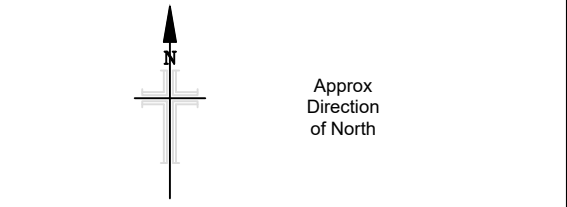

- Key:**
- Site boundary
 - Current compound location.
 - Off-site segregated stockpile locations.
 - As-dug non-tip waste stockpile.
 - As-dug non-tip waste temp stockpile.
 - Oversize hard stock from surface/structure breakout.
 - Processed site won O/S hard from JK works & tarmac.
 - Site Won Clean 6F2 Stockpile
 - Base layer Concrete 6F2 stockpile

- Works Undertaken:**
- 07:00 - 18:00 : 2 no. 30t excav. 's (Rick & Carl) utilising hydraulic breaker/pulveriser continuing with breaking remaining slabs/below ground structures & foundations below former concrete base layer stock Piles 13-15, ground turned to 3.0 m from E.W.O removing approx 80 no. R.C piles from below former transformer house. O/S hard loaded into 30t ADT & added to Clean concrete 2 stock.
 - 07:00 - 17:00 : 22t excav. (Chris) working in eastern P.O.S., stockpiling remaining useable made ground encountered below R.C slabs, in preparation of screening due to be undertaken 24/04 until 13:00 then assisting task 3 at O/S processing, segregating into piles ready for crushing and one that requires pulveriser due to volume of steel.
 - 07:00 - 18:00 : 28t excav. (Ien) regulating 6F2 stockpile in preparation of surveying until 10:30 when hydraulic breaker delivered from Bullen then processing O/S hard materials in preparation of crushing approx 200m3 processed in shift.
 - 07:30 - 16:30 : 22t excav. (Craig) loading stockpiled non tip material from top of former reservoir/difill in area 6, 30t ADT (Oli) hauling (23 no. loads = 300 m3) into former compound with 13t excav (Graham) sat. stockpiling hauled material to keep ADT tyres clean, gen op. (Sean) marshalling traffic to R.C C whilst ADT on road. Bulk excavation of non tip material to a level between 127.3 & 127.8m A.O.D.I. Target 127.3m completed area awaiting testing/classification & permit to become live before processing works can commence. 30t ADT (Rob) assisting with haul when not required hauling O/S concrete in task 1.
 - 07:00 - 17:00 : 30t ADT servicing above work operations as required, hauling 14 no. loads (162 m3) O/S hard from task 1 to O/S process stock, 14 no. loads (162 m3) of as-dug hauled with task 4.

Rev	Date	Drawn	Description	Chk'd
-	-	-	Description	-
-	-	-	Description	-


 **Urban Regen**
ESTABLISHED 2001

Urban Regen Ltd.,
Langley Road,
Pendlebury,
Salford,
M6 6FG
TEL :
email :

Client			
Eccleston Homes			
Site			
Mondi - Mill, Ramsbottom , BL0 OBS.			
Title			
MMP Daily Tracking Record 23/04/25			
Surveyed	IHB	Drawn	IHB
Chk.	IHB	Date	23/04/25
Scale	[A2 Sheet] CAD file		
1:500	Supplied planning layout.dxf		
Dwg No.			Rev
MONDI-UR-V1-01-MMP-073			A



Notes
This drawing and the information contained therein is issued in confidence and is the copyright of Urban Regen Ltd. Disclosure of this information to Third Parties and unauthorised copying or replication of this data without approval is forbidden.

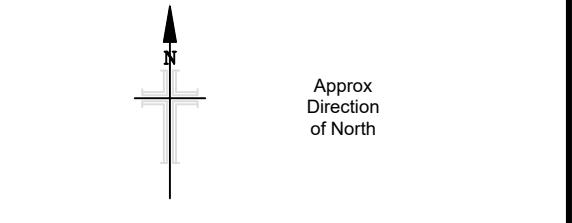

- Key:**
- Site boundary
 - Current compound location.
 - Off-site segregated stockpile locations.
 - As-dug non-tip waste stockpile.
 - As-dug non-tip waste temp stockpile.
 - Oversize hard stock from surface/structure breakout.
 - Processed site won O/S hard from JK works & tarmac.
 - Site Won Clean 6F2 Stockpile
 - Base layer Concrete 6F2 stockpile

- Works Undertaken:**
- 07:00 - 18:00 : 2 no. 30t excav. 's (Rick & Carl) utilising hydraulic breaker/pulveriser continuing with breaking remaining slabs below ground structures & foundations below former concrete base layer stock Piles 13-15, ground turned to 3.0 m from E.W.O removing approx 80 no. R.C piles from below former transformer house. O/S hard loaded into 30t ADT & added to Clean concrete 2 stock.
 - 07:00 - 17:00 : 22t excav. (Chris) working in eastern P.O.S., stockpiling remaining useable made ground encountered below R.C slabs, in preparation of screening due to be undertaken 24/04 until 13:00 then assisting task 3 at O/S processing, segregating into piles ready for crushing and one that requires pulveriser due to volume of steel.
 - 07:00 - 18:00 : 28t excav. (Ien) regulating 6F2 stockpile in preparation of surveying until 10:30 when hydraulic breaker delivered from Bullen then processing O/S hard materials in preparation of crushing approx 200m3 processed in shift.
 - 07:30 - 16:30 : 22t excav. (Craig) loading stockpiled non tip material from top of former reservoir/diaphragm in area 6, 30t ADT (Oli) hauling (23 no. loads = 300 m3) into former compound with 13t excav (Graham) sat. stockpiling hauled material to keep ADT tyres clean, gen op. (Sean) marshalling traffic to R.C.C whilst ADT on road. Bulk excavation of non tip material to a level between 127.3 & 127.8m A.O.D. (Target 127.3m) completed area awaiting testing/classification & permit to become live before processing works can commence. 30t ADT (Rob) assisting with haul when not required hauling O/S concrete in task 1.
 - 07:00 - 17:00 : 30t ADT servicing above work operations as required, hauling 14 no. loads (182 m3) O/S hard from task 1 to O/S process stock, 14 no. loads (182 m3) of as-dug hauled with task 4.

-	--/--/----	--	Description	--
-	--/--/----	--	Description	--
Rev	Date	Drawn	Description	Chk'd




Urban Regen
ESTABLISHED 2001

Urban Regen Ltd.,
Langley Road,
Pendlebury,
Salford,
M6 6FG
TEL :
email :

Client		Eccleston Homes	
Site			
Mondi - Mill, Ramsbottom , BL0 OBS.			
Title			
MMP Daily Tracking Record 22/04/25 (2)			
Surveyed	IHB	Drawn	IHB
Chk.	IHB	Date	22/04/25
Scale	[A2 Sheet]	CAD file	
1:500	Supplied planning layout.dxf		
Dwg No.	MONDI-UR-V1-01-MMP-074		Rev A



Notes
This drawing and the information contained therein is issued in confidence and is the copyright of Urban Regen Ltd. Disclosure of this information to Third Parties and unauthorised copying or replication of this data without approval is forbidden.

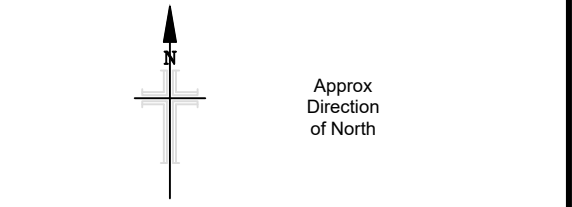

- Key:**
- Site boundary
 - Current compound location.
 - Off-site segregated stockpile locations.
 - As-dug non-tip waste stockpile.
 - As-dug non-tip waste temp stockpile.
 - Oversize hard stock from surface/structure breakout.
 - Processed site won O/S hard from JK works & tarmac.
 - Site Won Clean 6F2 Stockpile
 - Base layer Concrete 6F2 stockpile

- Works Undertaken:**
- 07:00 - 18:00 : 2 no. 30t excav.'s (Rick & Carl) utilising hydraulic breaker/pulveriser continuing with breaking remaining slabs below ground structures & foundations below former concrete base layer stock Piles 14 to road 2 working North to south, made ground removed and stockpiled at northern end in preparation of screening due to commence 28/04/25 & allow turnover to be undertaken 25/04/25 to EGL -3.0m. O/S hard breakout hauled to concrete processing in task 3.
 - 07:00 - 17:00 : 22t excav. (Chris) & 13t excav. (Graham) undertaking screening of made ground stockpiled 23/04/25. 22t excav. working alone until 12:00. 22t excav. loading Sandvik screen with 13t excav. maintaining fines belt & O/S off grates, screening completed for 16:00. 13t op. left site due to illness. 22t excav. loading O/S hard from works into 30t ADT & hauled to concrete processing to be undertaken in task 3.
 - 07:00 - 18:00 : 25t excav. (Ian) utilising hydraulic breaker processing O/S hard materials in preparation of crushing approx 200m3 processed in shift.
 - 07:00 - 17:00 : 30t ADT servicing above work operations as required, hauling 18 no. loads (234 m3) oversize with tasks 1 & 2. 4 no. (52 m3) O/S sandstone recovered from crushing operation taken to proposed Gof works & 2 no. 6F2 crush to O/S recorded well as backfill after investigation works undertaken at request of M.Fawcett.

Rev	Date	Drawn	Description	Chk'd
-	-	-	Description	-
-	-	-	Description	-




Urban Regen Ltd.,
Langley Road,
Pendlebury,
Salford,
M6 6FG
TEL :
email :

Client			
Eccleston Homes			
Site			
Mondi - Mill, Ramsbottom , BL0 0BS.			
Title			
MMP Daily Tracking Record 24/04/25			
Surveyed	IHB	Drawn	IHB
Chk.	IHB	Date	24/04/25
Scale	(A2 Sheet)	CAD file	
1:500	Supplied planning layout.dxf		
Dwg No.	MONDI-UR-V1-01-MMP-075		Rev
			A



Notes
This drawing and the information contained therein is issued in confidence and is the copyright of Urban Regen Ltd. Disclosure of this information to Third Parties and unauthorised copying or replication of this data without approval is forbidden.

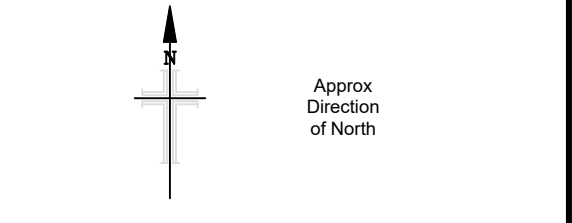

- Key:**
- Site boundary
 - Current compound location.
 - Off-site segregated stockpile locations.
 - As-dug non-tip waste stockpile.
 - Oversize hard stock from surface/structure breakout.
 - Processed site won O/S hard from JK works & tarmac.
 - Site Won Clean 6F2 Stockpile
 - Base layer Concrete 6F2 stockpile

- Works Undertaken:**
- 07:00 - 17:00 : 2 no. 30t excav.'s continuing with existing slab breakout & associated below ground structures. "Haymaking" made ground exposed in preparation of screening due to commence 28/04, and undertaking turnover to ECL - 3.0m removing all hard encountered in excess of 150mm including R.C piles, with any retained surveyed for records. Clean O/S hard hauled to processing works in task 3.
 - 07:00 - 17:00 : 22t excav. loading 30t ADT with as-dug non-tip material from former re-landfill below stockpiled in former compound 22 & 23/04/25 (approx. 500 m³) and hauling to Eastern P.O.S in preparation of processing/burial. 15:00 22t excav moved to eastern P.O.S to civilise hauled material and seal to protect from weathering until 15:00 then sealing natural ground turned over in task 1 as too soft for 30t excav.'s.
 - 07:00 - 17:00 : 25t excav. (lan) utilising hydraulic breaker continuing to process O/S hard being sent from task 1 and forming new crush pile - approx 150 m³ processed in day until 14:00, segregating processing undertaken since 23/04/25 into hard ready for crushing & O/S hard that requires pulverising to remove majority of re-inforcement.
 - 07:00 - 17:00 : 30t ADT (Rob) servicing above works as required. 30 no. (300m³) loads of as-dug non tip material from temporary stock in former compound to eastern P.O.S & 4 no. (52 m³) O/S hard from turnover works in task 1 to clean concrete stock

-	--/--/----	--	Description	--
-	--/--/----	--	Description	--
Rev	Date	Drawn	Description	Chk'd

 **Urban Regen**
ESTABLISHED 2001

Urban Regen Ltd.,
Langley Road,
Pendlebury,
Salford,
M6 6FG
TEL :
email :

Client
Eccleston Homes


Site
Mondi - Mill,
Ramsbottom , BL0 OBS.

Title
MMP Daily Tracking Record
25/04/25

Surveyed	IHB	Drawn	IHB
Chk.	IHB	Date	25/04/25
Scale	[A2 Sheet]	CAD file	
1:500	Supplied planning layout.dxf		
Dwg No.	MONDI-UR-V1-01-MMP-076		Rev
			A



Notes
This drawing and the information contained therein is issued in confidence and is the copyright of Urban Regen Ltd. Disclosure of this information to Third Parties and unauthorised copying or replication of this data without approval is forbidden.

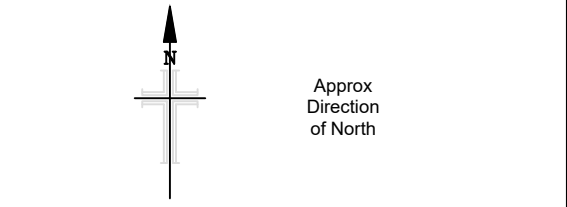

- Key:**
- Site boundary
 - Current compound location.
 - Off-site segregated stockpile locations.
 - As-dug non-tip waste stockpile.
 - Oversize hard stock from surface/structure breakout.
 - Processed site won O/S hard from JK works & tarmac.
 - Site Won Clean 6F2 Stockpile
 - Base layer Concrete 6F2 stockpile

- Works Undertaken:**
- 07:00 - 13:00 : 30t excav. (Can) & 20t excav. (lan) utilising hydraulic breakers, continuing with breakout of existing slabs and associated below ground structures in area 21 below plots 15-Road 2 & 36/34.
 - 07:00 - 13:00 : 30t excav. (Rick) utilising hydraulic pulveriser to process O/S hard, processed 22-25/04/25 to remove majority of steel to improve productivity of crusher on next visit.

-	--/--/----	--	Description	--
-	--/--/----	--	Description	--
Rev	Date	Drawn	Description	Chk'd



Urban Regen Ltd.,
Langley Road,
Pendlebury,
Salford,
M6 6FG
TEL :
email :

Client
Eccleston Homes


Site
Mondi - Mill,
Ramsbottom , BL0 0BS.

Title
MMP Daily Tracking Record
26/04/25

Surveyed	IHB	Drawn	IHB
Chk.	IHB	Date	26/04/25
Scale	[A2 Sheet]	CAD file	
1:500	Supplied planning layout.dxf		
Dwg No.	MONDI-UR-V1-01-MMP-077		Rev A



Notes
This drawing and the information contained therein is issued in confidence and is the copyright of Urban Regen Ltd. Disclosure of this information to Third Parties and unauthorised copying or replication of this data without approval is forbidden.

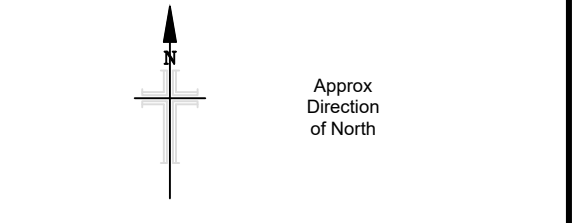

- Key:**
- Site boundary
 - Current compound location.
 - Off-site segregated stockpile locations.
 - Landfill material processing area
 - As-dug non-tip waste stockpile.
 - Oversize hard stock from surface/structure breakout.
 - Processed site won O/S hard from JK works & tarmac.
 - Site Won Clean 6F2 Stockpile

- Works Undertaken:**
- 07:00 - 17:30 : 2 no. 30t excav.'s (Rick & Chris) laying 6f2 over fill area below plots 13-21. Rick loading 6f2 crush from stock in area 1. 30t ADT hauling to fill area and 30t excav. (Chris) laying. Approx 500mm depth placed in 2 no. layers compacted with 13t roller with a minimum 8 no. passes. 50 no. loads of 6f2 taken to fill area.
 - 07:00 - 17:30 : 30t excav. (Luke), 25t excav. (Ian) & gen op. (Joe) utilising Sandvik screener, commencing with processing works to infill material of former tip/reservoir in area 5, 22t excav. loading sandvik screener of non-tip material encountered to North end of working area, segregating fines & O/S. Fines stockpiled adjacent & sealed to protect from weathering. O/S stockpiled adjacent. Gen. op. clearing O/S of waste continuously throughout day. O/S will require re-screening as heavy on fines due to waste & 60mm grits fitted to screener. 12:00 hose blow on 30t excav. OT notified and operative using 13t excav (UR Civils) 22t excav. finished work at 17:00 with 13t excav. undertaking stock maintenance. Approx. 200 m3 processed in day on a 60 (fines) -40 (O/S) split
 - 07:00 - 17:30 : 30t ADT & 13t roller servicing above work operations as required. 6 no. (78 m3) O/S from Task 2 to eastern POS segregated stock. 8 no. (104 m3) Tarmac/JK impacted O/S moved from plot 37 to eastern P.O.S (awaiting more road to be laid at depth). 10 no. (130 m) base layer crush laid in fill area ensuring minimum cover from FGL. = 1.600m & 44 no. (572 m3) 6f2 from stock to fill area in task 1.

-	--/--/----	--	Description	--
-	--/--/----	--	Description	--
Rev	Date	Drawn	Description	Chk'd



Urban Regen
ESTABLISHED 2001

Urban Regen Ltd.,
Langley Road,
Pendlebury,
Salford,
M6 6FG
TEL :
email :

Client
Eccleston Homes


Site
Mondi - Mill,
Ramsbottom , BL0 OBS.

Title
MMP Daily Tracking Record
02/05/25

Surveyed	IHB	Drawn	IHB
Chk.	IHB	Date	02/05/25
Scale	[A2 Sheet]	CAD file	
1:500	Supplied planning layout.dxf		
Dwg No.	MONDI-UR-V1-01-MMP-082		Rev A



Notes
This drawing and the information contained therein is issued in confidence and is the copyright of Urban Regen Ltd. Disclosure of this information to Third Parties and unauthorised copying or replication of this data without approval is forbidden.

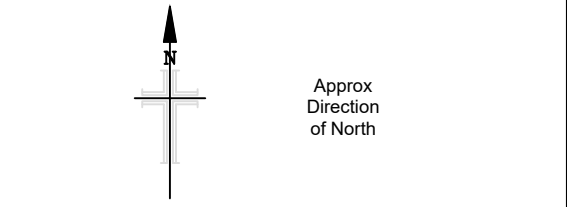

- Key:**
- Site boundary
 - Current compound location.
 - Off-site segregated stockpile locations.
 - Landfill material processing area
 - As-dug non-tip waste stockpile.
 - Oversize hard stock from surface/structure breakout.
 - Oversize hard stock from Landfill Processing area
 - Processed site won O/S hard from JK works & tarmac.
 - Site Won Clean 6F2 Stockpile

Works Undertaken:

- 07:00 - 11:00 : 2 no. 30t excav.'s (Rick & Chris) laying 6f2 over fill area below plots 13-21. (Rick) loading 6f2 crush from stock in area 1. 30t ADT hauling to fill area and (Chris) laying. Approx 500mm depth placed in 2 no. layers compacted with 13t roller with a minimum 8 no. passes. 41 no. loads of 6f2 taken to fill area.,

- 11:00 -18:00 : 30t excav. (Rick) continuing with breakout & turnover in area 2 below plot 15 & R2, removing all O/S hard in excess of 150mm up to 3.0m from proposed E.W.O including concrete R.C. steel encased piles any piles remaining abutted surveyed by excav. all O/S hard "haymaked" to clean concrete pile adjacent in area .

- 11:00 - 13:00 : 30t excav. (Chris) utilising hydraulic grab to move stockpiled re-inforcement, to allow trail screening area to be increased, moving tree stumps removed 30/04/25 from trial area including shaking off fines and re-locating to plot 21 unable to dispose of off-site with CTO as still tree roots to be removed from area 5. 13:00 - 15:00 utilising hydraulic breaker to break down mass filled structures encountered below plot 33 approx. 15:00 - 17:00 : Backfilling well SD7/114C now that bentonite pellets have reacted - set & creating ramp into Eccleston Homes compound in preparation of cabin delivery, scheduled for 07/05/25

- 07:00 - 18:00 : 25t excav. (Ian), 22t excav. (Luke) & Sandvik screener, continuing with processing works to infill material of former tip/reservoir in area 5, 22t excav. loading sandvik screener with tip material hauled from southern end of area 5 adjacent R.C.C access rd., segregating fines & O/S. fines stockpiled adjacent & sealed to protect from weathering. O/S stockpiled adjacent, Gen. op. clearing O/S of waste continuously throughout day. O/S will require re-screening as heavy on fines due to waste & 60mm grills fitted to screener. 14:00 O/S that been screened & piled twice hauled to segregated stock in Eastern P.O.S to allow more processing to be undertaken.

- 07:00 - 18:00 : 30t ADT & 13t roller servicing above work operations as required, 41 no. loads (533 m3) 6f2 from stock to fill area plots 8-21 as detailed in task 1, 3 no. (39 m3) O/S hard from task 2 to O/S hard clean concrete stock in area 1 & 4 no. loads (52 m3) root balls from area 5 to eastern P.O.S.

- 07:00 - 18:00 : tractor & Bowser used as required as dust suppression 10:00, 13:00 & 16:00.

Rev	Date	Drawn	Description	Chk'd
-	--/--/----	--	Description	--
-	--/--/----	--	Description	--



Urban Regen
ESTABLISHED 2001


Urban Regen Ltd.,
Langley Road,
Pendlebury,
Salford,
M6 6FG
TEL :
email :

Client
Eccleston Homes


Site
Mondi - Mill,
Ramsbottom , BL0 0BS.

Title
MMP Daily Tracking Record
06/05/25

Surveyed	IHB	Drawn	IHB
Chk.	IHB	Date	06/05/25
Scale	[A2 Sheet] CAD file		
1:500			Supplied planning layout.dxf
Dwg No.	MONDI-UR-V1-01-MMP-083	Rev	A

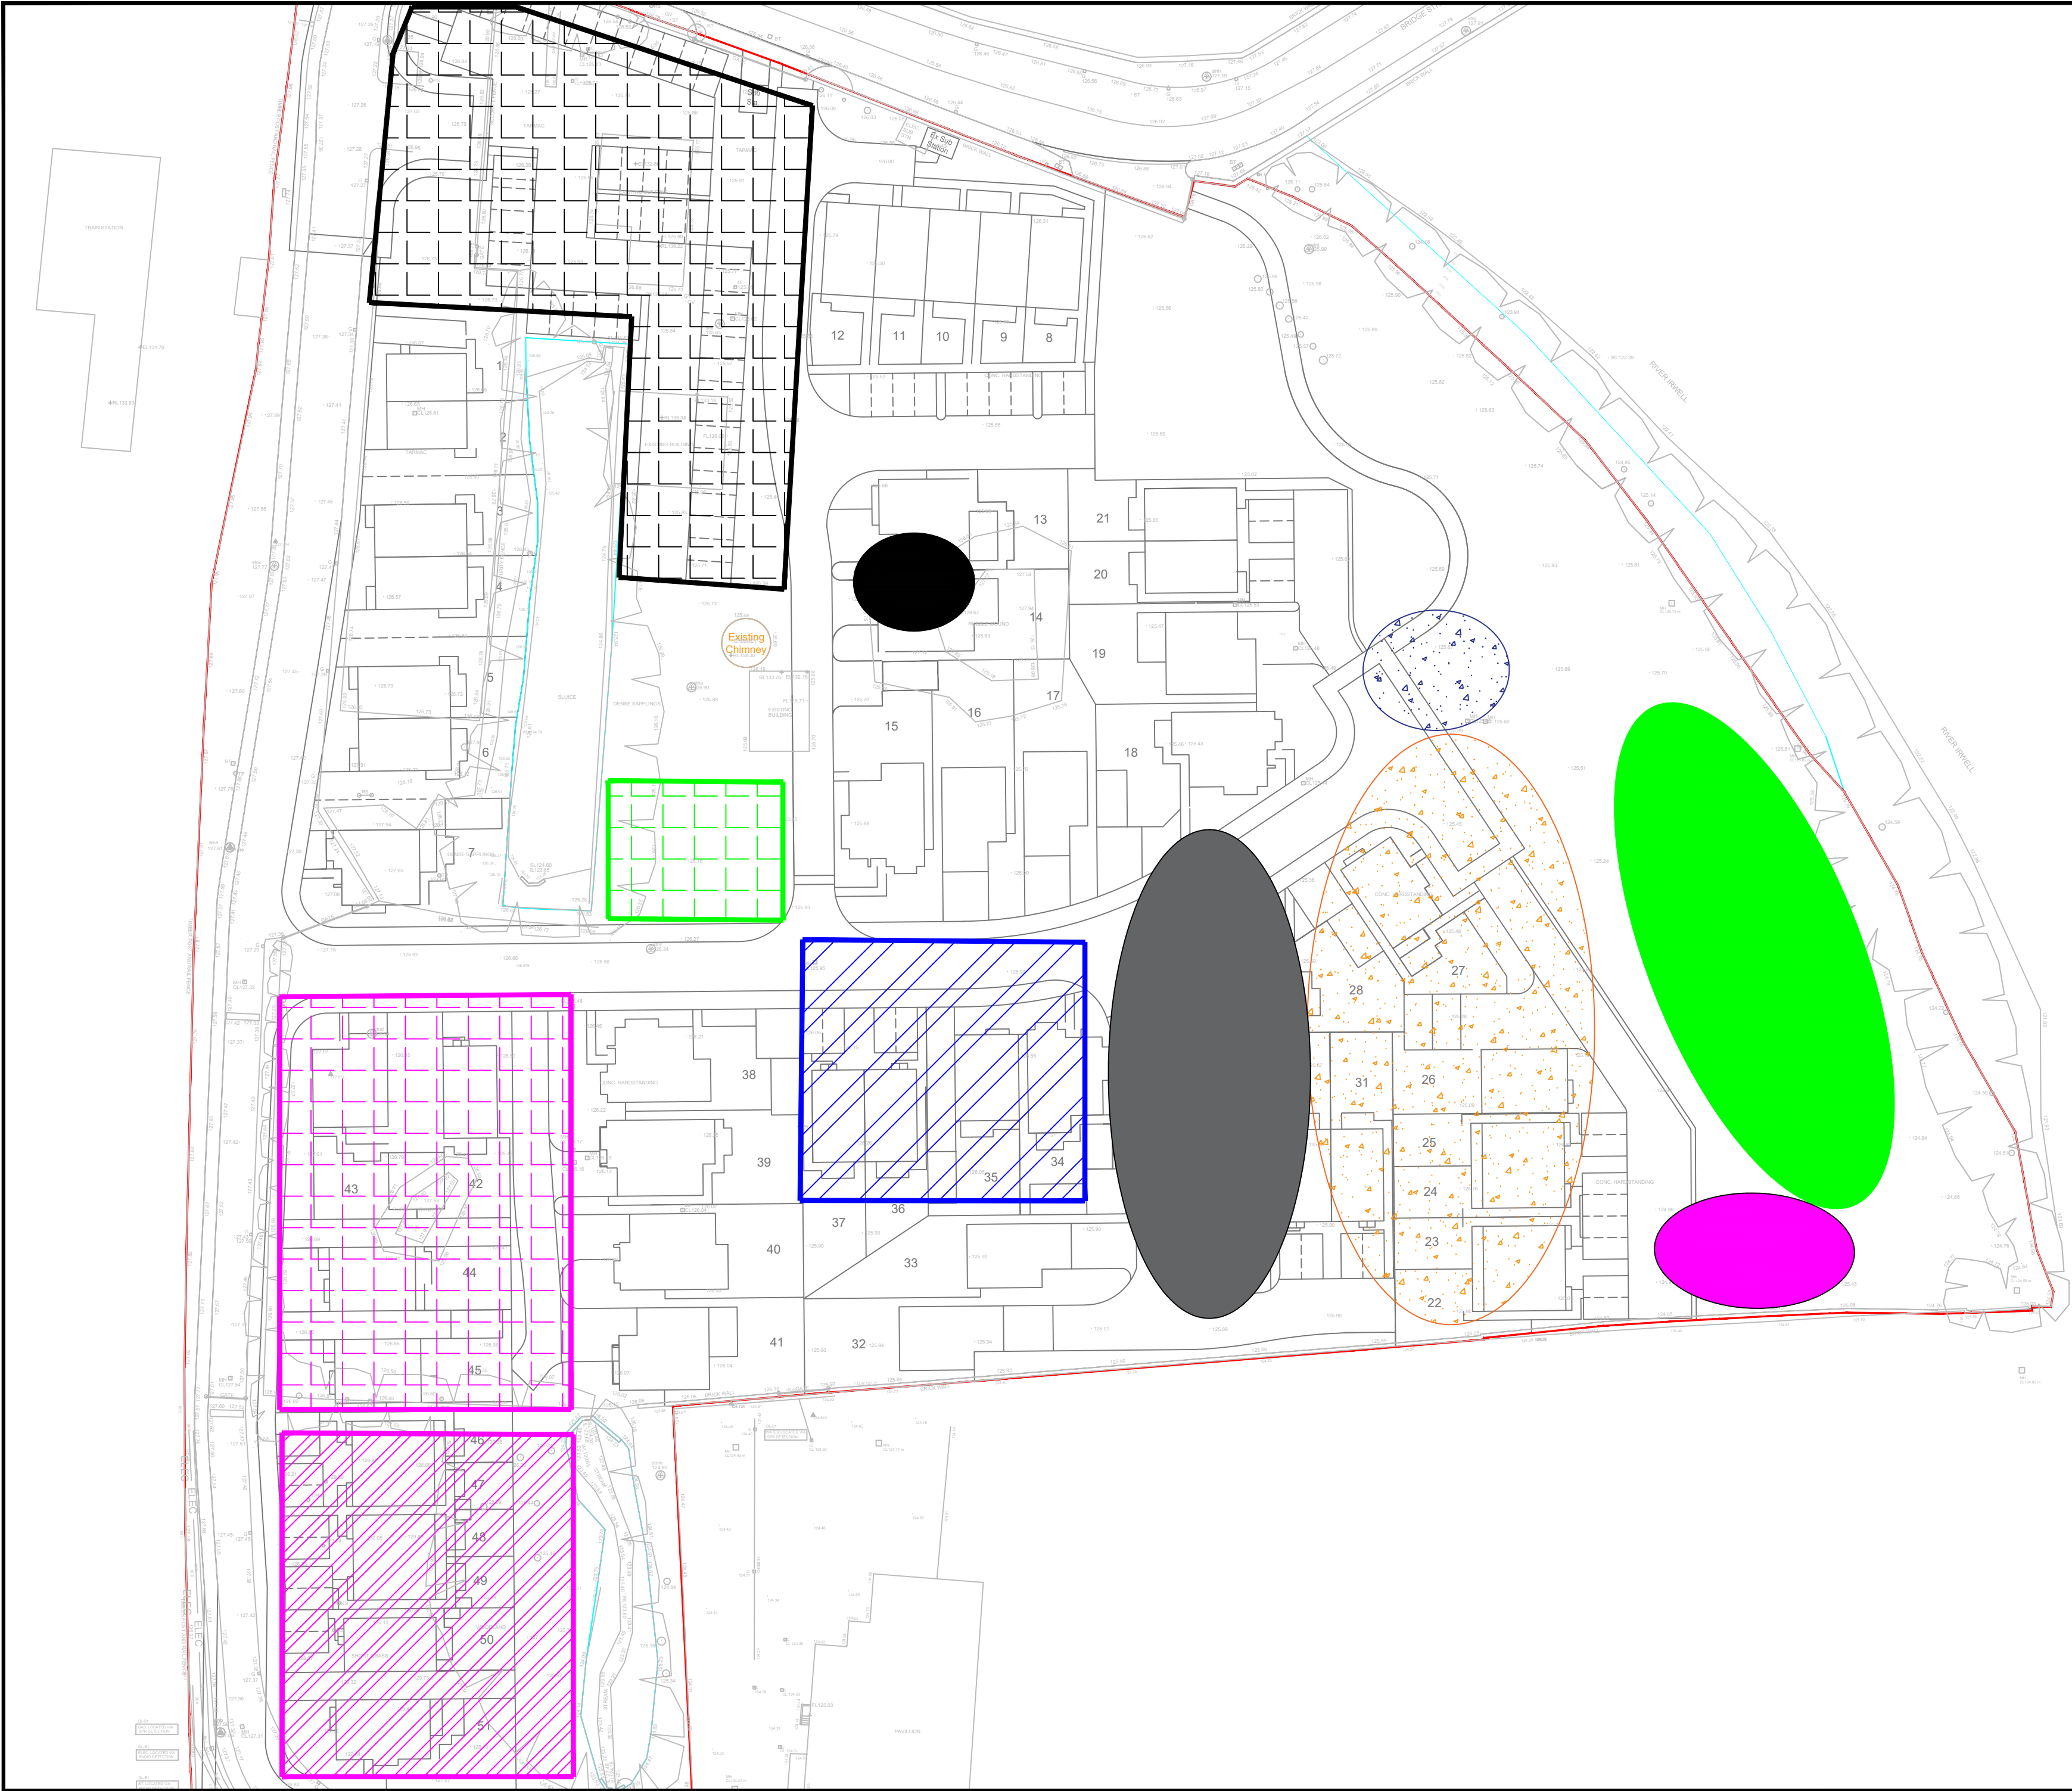

Notes
This drawing and the information contained therein is issued in confidence and is the copyright of Urban Regen Ltd. Disclosure of this information to Third Parties and unauthorised copying or replication of this data without approval is forbidden.

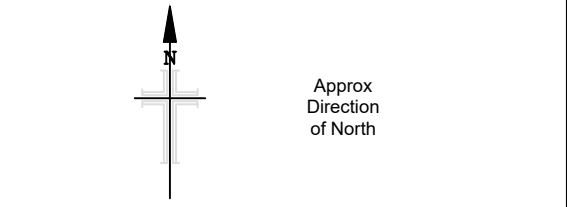

- Key:**
- Site boundary
 - Current compound location.
 - Off-site segregated stockpile locations.
 - Landfill material processing area
 - As-dug non-tip waste stockpile.
 - Oversize hard stock from surface/structure breakout.
 - Oversize hard stock from Landfill Processing area
 - Oversize hard stock generated from M.G Screening
 - Site Won Clean 6F2 Stockpile


- Works Undertaken:**
- 07:00 - 18:00 : 2 x 30 t excav.'s (Rick & Chris) continuing with surface hard & below ground associated concrete breakout, including turning of made ground encountered upto 3.0m from EGL's removing all hard materials in excess of 150mm. Existing piles encountered removed/ taken to a minimum 3.0m from EGL with retained piles surveyed by excav.'s. Utilising Sandvik screener until 11:00 whilst 25t excav. clearing waste and 'thymasking' landfill material to screener location on area 4/5 boundary. 11:00 - 18:00 continuing to stockpile made ground brick rubble exposing below ground structures. Brick rubble made ground encountered segregated from structural concrete breakout due to elevated asbestos fines found in previous samples taken.
 - 07:00 - 18:00 : 25t excav. (Ian), 22t excav. (Luke) & gen op. (Joe) tidying work area in preparation of continuing with trial processing of landfill material, removing gen. waste, scrap metal, wood & hard O/S to segregated stocks outside of processing area 22t excav. loading hard O/S from screening works undertaken 10 & 12/05/24 09:30-11:00. 11:00 - 18:00 25t excav. loading Sandvik screener with as-dug materials. 22t excav. maintaining segregated stocks (Gen. waste, wood, scrap metal & fines with mixed waste) with gen op. continually hand picking waste during work operations. Screened fines retained in processing area all other waste for off-site disposal/processing sent to site stocks
 - 07:00 - 17:00 : 30t ADT & 13t roller servicing above work operations as required. 25 no.(325 m3) ADT loads taken from screening undertaken in Task to base O/S hard stock in area 2, 5 no. (65 m3) O/S loads removed from screening works in Task 2 to Eastern P.O.S..
 - 07:00 - 17:00 : tractor & Bowser used as required as dust suppression continuously operated by J.Woitenholme (UR Civils)

Rev	Date	Drawn	Description	Chk'd
-	--/--/----	--	Description	--
-	--/--/----	--	Description	--




Urban Regen Ltd.,
Langley Road,
Pendlebury,
Salford,
M6 6FG
TEL :
email :

Client			
Eccleston Homes			
Site			
Mondi - Mill, Ramsbottom , BL0 OBS.			
Title			
MMP Daily Tracking Record 12/05/25			
Surveyed	IHB	Drawn	IHB
Chk.	IHB	Date	12/05/25
Scale	[A2 Sheet] CAD file		
1:500	Supplied planning layout.dxf		
Dwg No. MONDI-UR-V1-01-MMP-088			Rev A

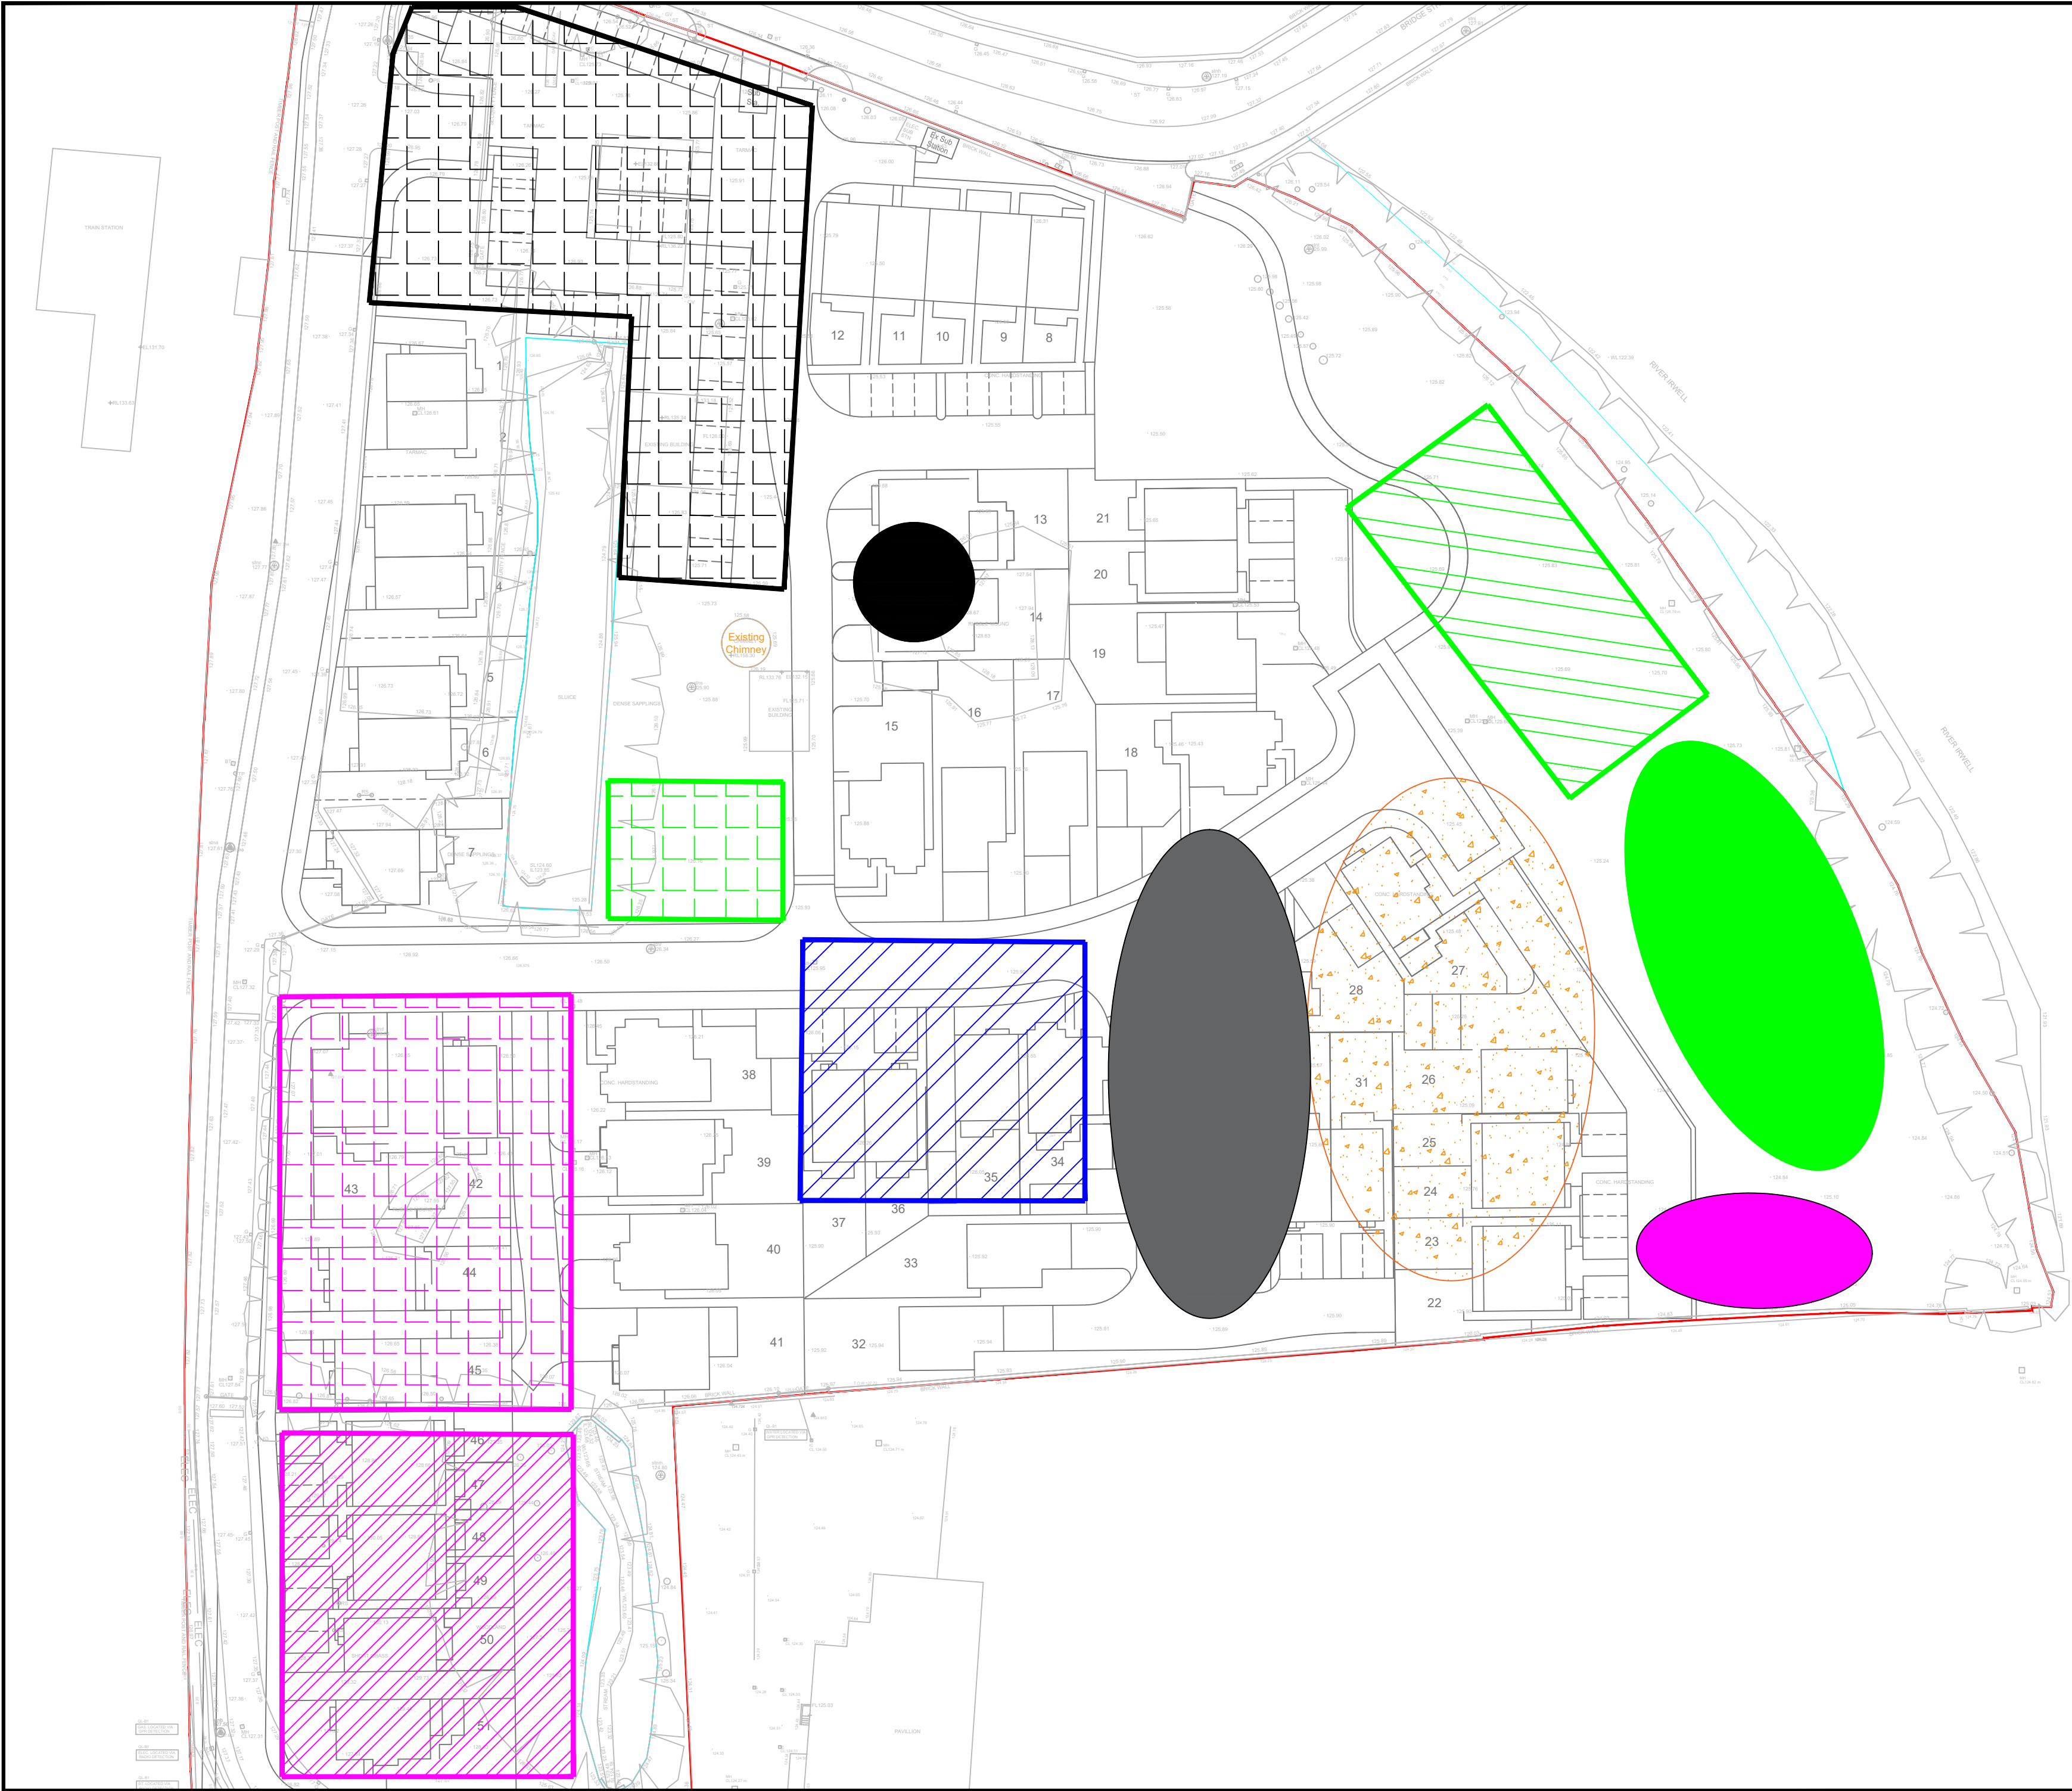

Notes
This drawing and the information contained therein is issued in confidence and is the copyright of Urban Regen Ltd. Disclosure of this information to Third Parties and unauthorised copying or replication of this data without approval is forbidden.

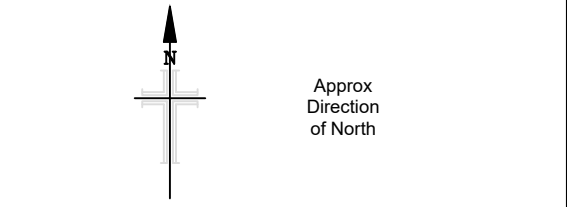

- Key:**
- Site boundary
 - Current compound location.
 - Off-site segregated stockpile locations.
 - Landfill material processing area
 - As-dug non-tip waste stockpile.
 - Oversize hard stock from surface/structure breakout.
 - Oversize hard stock from Landfill Processing area
 - Oversize hard stock generated from M.G Screening
 - Site Won Clean 6F2 Stockpile

- Works Undertaken:**
- 07:00 - 18:00 : 30t excav. (Rick) laying remainder of 6f2 from tarmac crushing & O/S recovered from JK impacted in soils processed 09 & 10/04/25 into R2 road box between 3.0 & 3.5m below FRL then using sandvik screener to remove O/S hard from brick rubble made ground encountered during turn-over works below plots 36/37 with screened fines 125mm and down laid into fill area below plots 35/36. O/S hard sent to base concrete layer stock on plots 13/14 as historically material contains elevated asbestos fines so designated as being placed with a minimum 1.0m cover from E.W.O. once processed. 13/30 encountered high concentration of broken cement bound asbestos sheets in base layer material segregated to allow works to continue then moved out of area onto concrete allowing UR asbestos operative (Scott) to undertake hand pick of material. Picked asbestos placed into asbestos bags ready for offsite disposal. Picked material sent to fill area below plots 36/37.
 - 07:00 - 17:00 : 30t excav. (Chris) working with Task 1 breaking concrete structures encountered, reducing O/S hard size in preparation of crushing, stockpile maintenance of O/S hard stocks. Pulverising R.C. concrete removing steel, shaking tree roots to remove soils, and clearing fines belt of task 1 as required.
 - 07:00 - 17:00 : Cat 20 excav. (Dan) inducted to site then undertaking stock maintenance in Eastern P.O.S. Assisting task 1 loading ADT with stockpiled O/S hard generated & clearing O/S hard from trial processing area until 14.00 then moved to eastern P.O.S to excavate natural sand/dry encountered & stockpiling ready to be used as gen. fill in rear gardens of plots 1-7, 13-21 & chimney P.O.S.
 - 07:00 - 18:00 : 25t excav. (Ian), 22t excav. (Luke) & gen op. (Joe) tidying work area in preparation of continuing with trial processing of landfill material, removing gen. waste, scrap metal, wood & hard O/S to segregated stocks outside of processing area 22t excav. loading hard O/S from screening works undertaken 12/05/25. 09:00 - 18:00 25t excav. loading Sandvik screener with as-dug materials, 22t excav. maintaining segregated stocks (Gen. waste, wood, scrap metal & fines with mixed waste) with gen ops. continually hand picking waste during work operations. Screened fines retained in processing area all other waste for off-site disposal/processing sent to site stocks. Additional gen op. (Scott) organised for hand picking operation. Approx. 200m3 processed in day.
 - 07:00 - 17:00 : 30t ADT & 13t roller servicing above work operations as required. 12 no. (156 m3) of Tarmac/JK impacted crush from Eastern P.O.S to Road 2 plots 15-17, 10 no. (130 m3) O/S hard sent from screening op. in task 1 to base O/S stock in area 2, 7 no. (81 m3) O/S hard from Task 4 to Eastern P.O.S.
 - 07:00 - 17:00 : tractor & Bowser used for dust suppression continuously operated by J.Wolstenholme (UR Civils)


Rev	Date	Drawn	Description	Chk'd
-	--/--/----	--	Description	--
-	--/--/----	--	Description	--




Urban Regen
ESTABLISHED 2001

Urban Regen Ltd.,
Langley Road,
Pendlebury,
Salford,
M6 6FG
TEL :
email :

Client			
Eccleston Homes			
Site			
Mondi - Mill, Ramsbottom , BL0 OBS.			
Title			
MMP Daily Tracking Record 13/05/25			
Surveyed	IHB	Drawn	IHB
Chk.	IHB	Date	13/05/25
Scale	[A2 Sheet] CAD file		
1:500	Supplied planning layout.dxf		
Dwg No.	MONDI-UR-V1-01-MMP-089		Rev
		A	

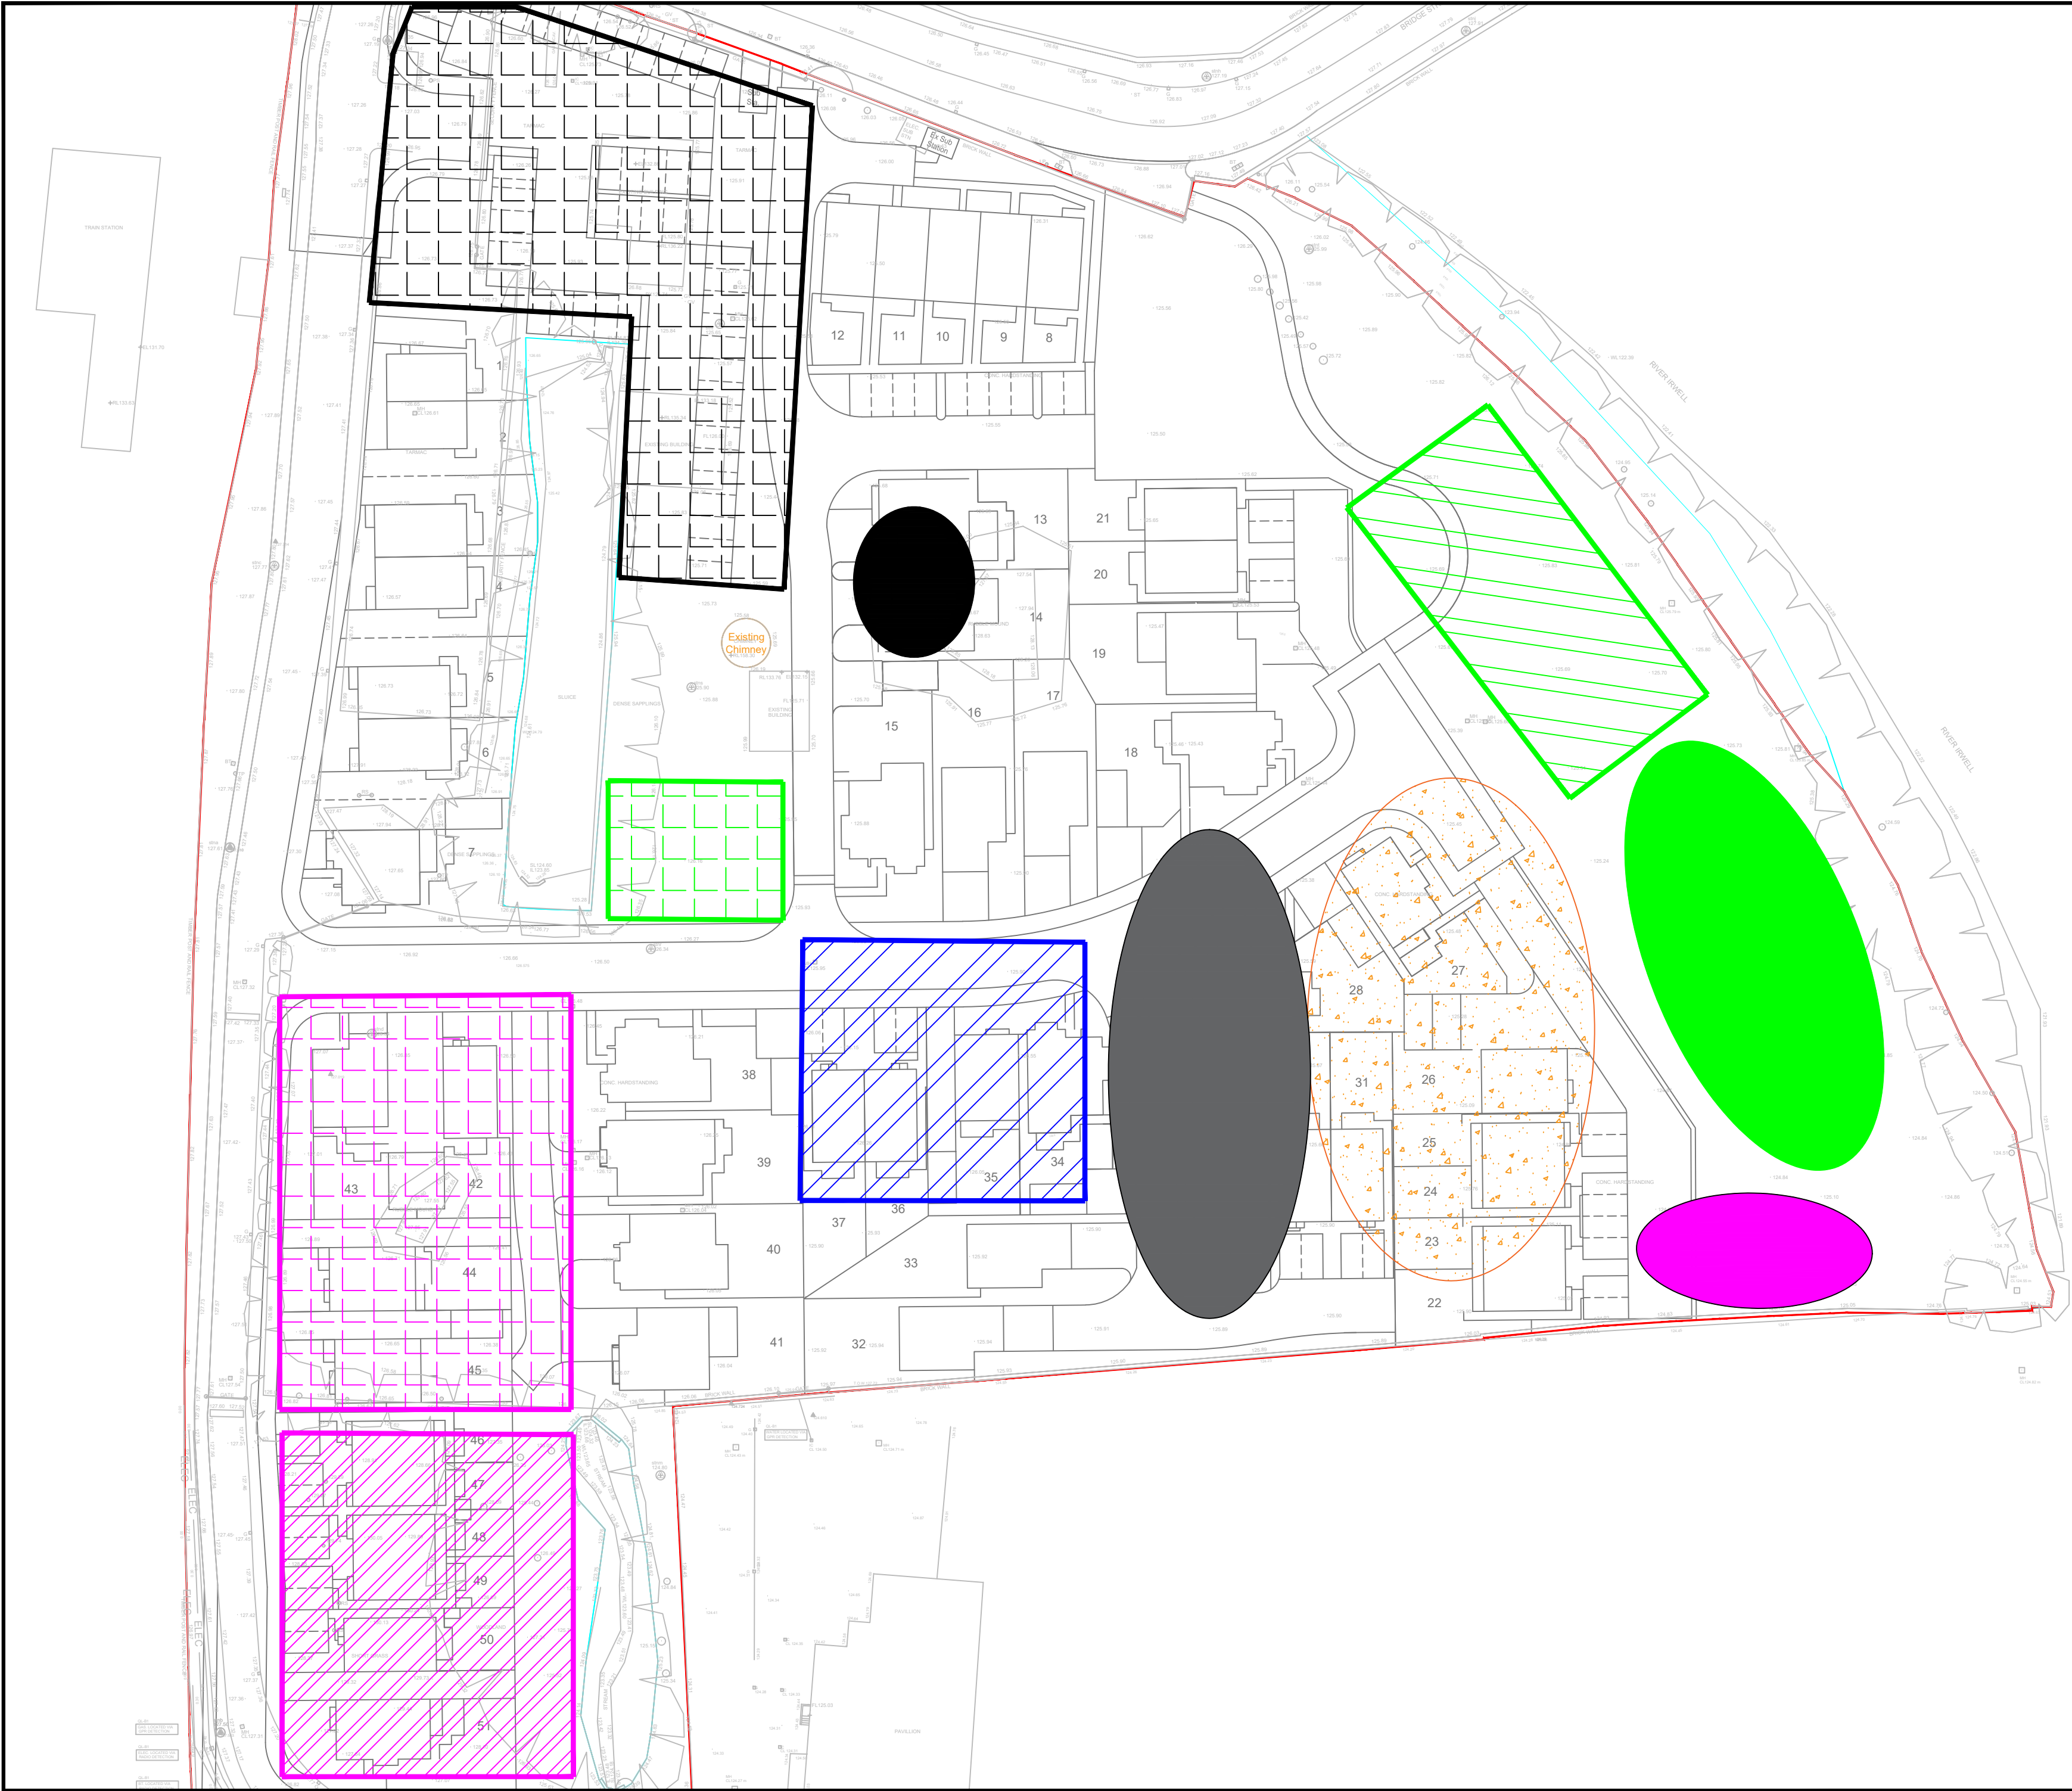

Notes
This drawing and the information contained therein is issued in confidence and is the copyright of Urban Regen Ltd. Disclosure of this information to Third Parties and unauthorised copying or replication of this data without approval is forbidden.

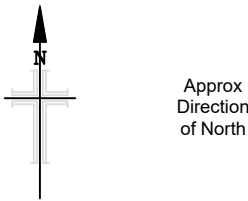

- Key:**
- Site boundary
 - Current compound location.
 - Off-site segregated stockpile locations.
 - Landfill material processing area
 - As-dug non-tip waste stockpile.
 - Overize hard stock from surface/structure breakout.
 - Overize hard stock from Landfill Processing area
 - Overize hard stock generated from M.G Screening
 - Site Won Clean 6F2 Stockpile


- Works Undertaken:**
- 07:00 - 18:00 : 30t excav. (Rick) Continuing to use sandvik screener to remove O/S hard from brick rubble made ground encountered during turn-over works below plots 36/37 with screened fines 125mm and down laid into fill area below plots 35/36. O/S hard sent to base concrete layer stock on plots 13/14 (as historically material contains elevated asbestos fines so designated at being placed with a minimum 1.0m cover from E.W.O. once processed) / Piles encountered during turnover works removed where possible where piles snapped, excav, ensuring piles removed to a min. 3.0m from E.W.O. & asbuilt surveyed.
 - 07:00 -17:00 : 30t excav. (Chris) assisting above operation clearing O/S hard from screener, utilising hydraulic breaker & pulveriser to process O/S concrete & stockpile maintenance on O/S hard stocks to allow ADT access.
 - 07:00 - 17:00 : Cat 20t excav. (Dan) undertaking selective reduced level excav. in Eastern P.O.S generating fills for plots 13-21 rear gardens & plots 1-7 rear Gardens. Segregating soft silts & O/S hard encountered suitable sands recovered stockpiled in area in preparation of placing 15/05/25. CAT 320 excav. keeps going into limp mode requiring excav. to be shut down for 5 min's each time approx. every hour Casey notified, and Firrings (CAT dealer) on site 14:30 - 16:00, but unable to diagnose.
 - 07:00 - 18:00 : 25t excav. (Ian), 22t excav. (Luke) & gen op. (Joe) tidying work area in preparation of continuing with trial processing of landfill material, removing gen. waste, scrap metal, wood & hard O/S to segregated stocks outside of processing area 22t excav. loading hard O/S from screening works undertaken 13/05/25. 09:00 - 18:00 25t excav. loading Sandvik screener with as-dug materials, 22t excav. maintaining segregated stocks (Gen. waste, wood, scrap metal & fines with mixed waste) with gen ops. continually hand picking waste during work operations. Screened fines retained in processing area all other waste for off-site disposal/processing sent to site stocks. Additional gen op. (Scott) organised for hand picking operation. Approx. 200m3 processed in day.
 - 07:00 - 17:00 : 30t ADT & 13t roller servicing above work operations as required, 14 no. (182 m3) sand from Task 3 to rear plots 1-7, 18 no. (234 m3) O/S Hard sent from screening op. in task 1 to base O/S stock in area 2, 4 no. (52 m3 m3) O/S hard from Task 4 to Eastern P.O.S. & 3 no. (38 m3) O/S sandstone from Gull western embankment works task 7 to base O/S hard stock
 - 07:00 - 17:00 : tractor & Bowser used for dust suppression continuously operated by J.Woolstenholme (JR Civils)

Rev	Date	Drawn	Description	Chk'd
-	-	-	Description	-
-	-	-	Description	-




Urban Regen Ltd.,
Langley Road,
Pendlebury,
Salford,
M6 6FG
TEL :
email :

Client			
Eccleston Homes			
Site			
Mondi - Mill, Ramsbottom , BL0 OBS.			
Title			
MMP Daily Tracking Record 14/05/25			
Surveyed	IHB	Drawn	IHB
Chk.	IHB	Date	14/05/25
Scale	[A2 Sheet] CAD file		
1:500	Supplied planning layout.dxf		
Dwg No.	MONDI-UR-V1-01-MMP-090		Rev
		A	

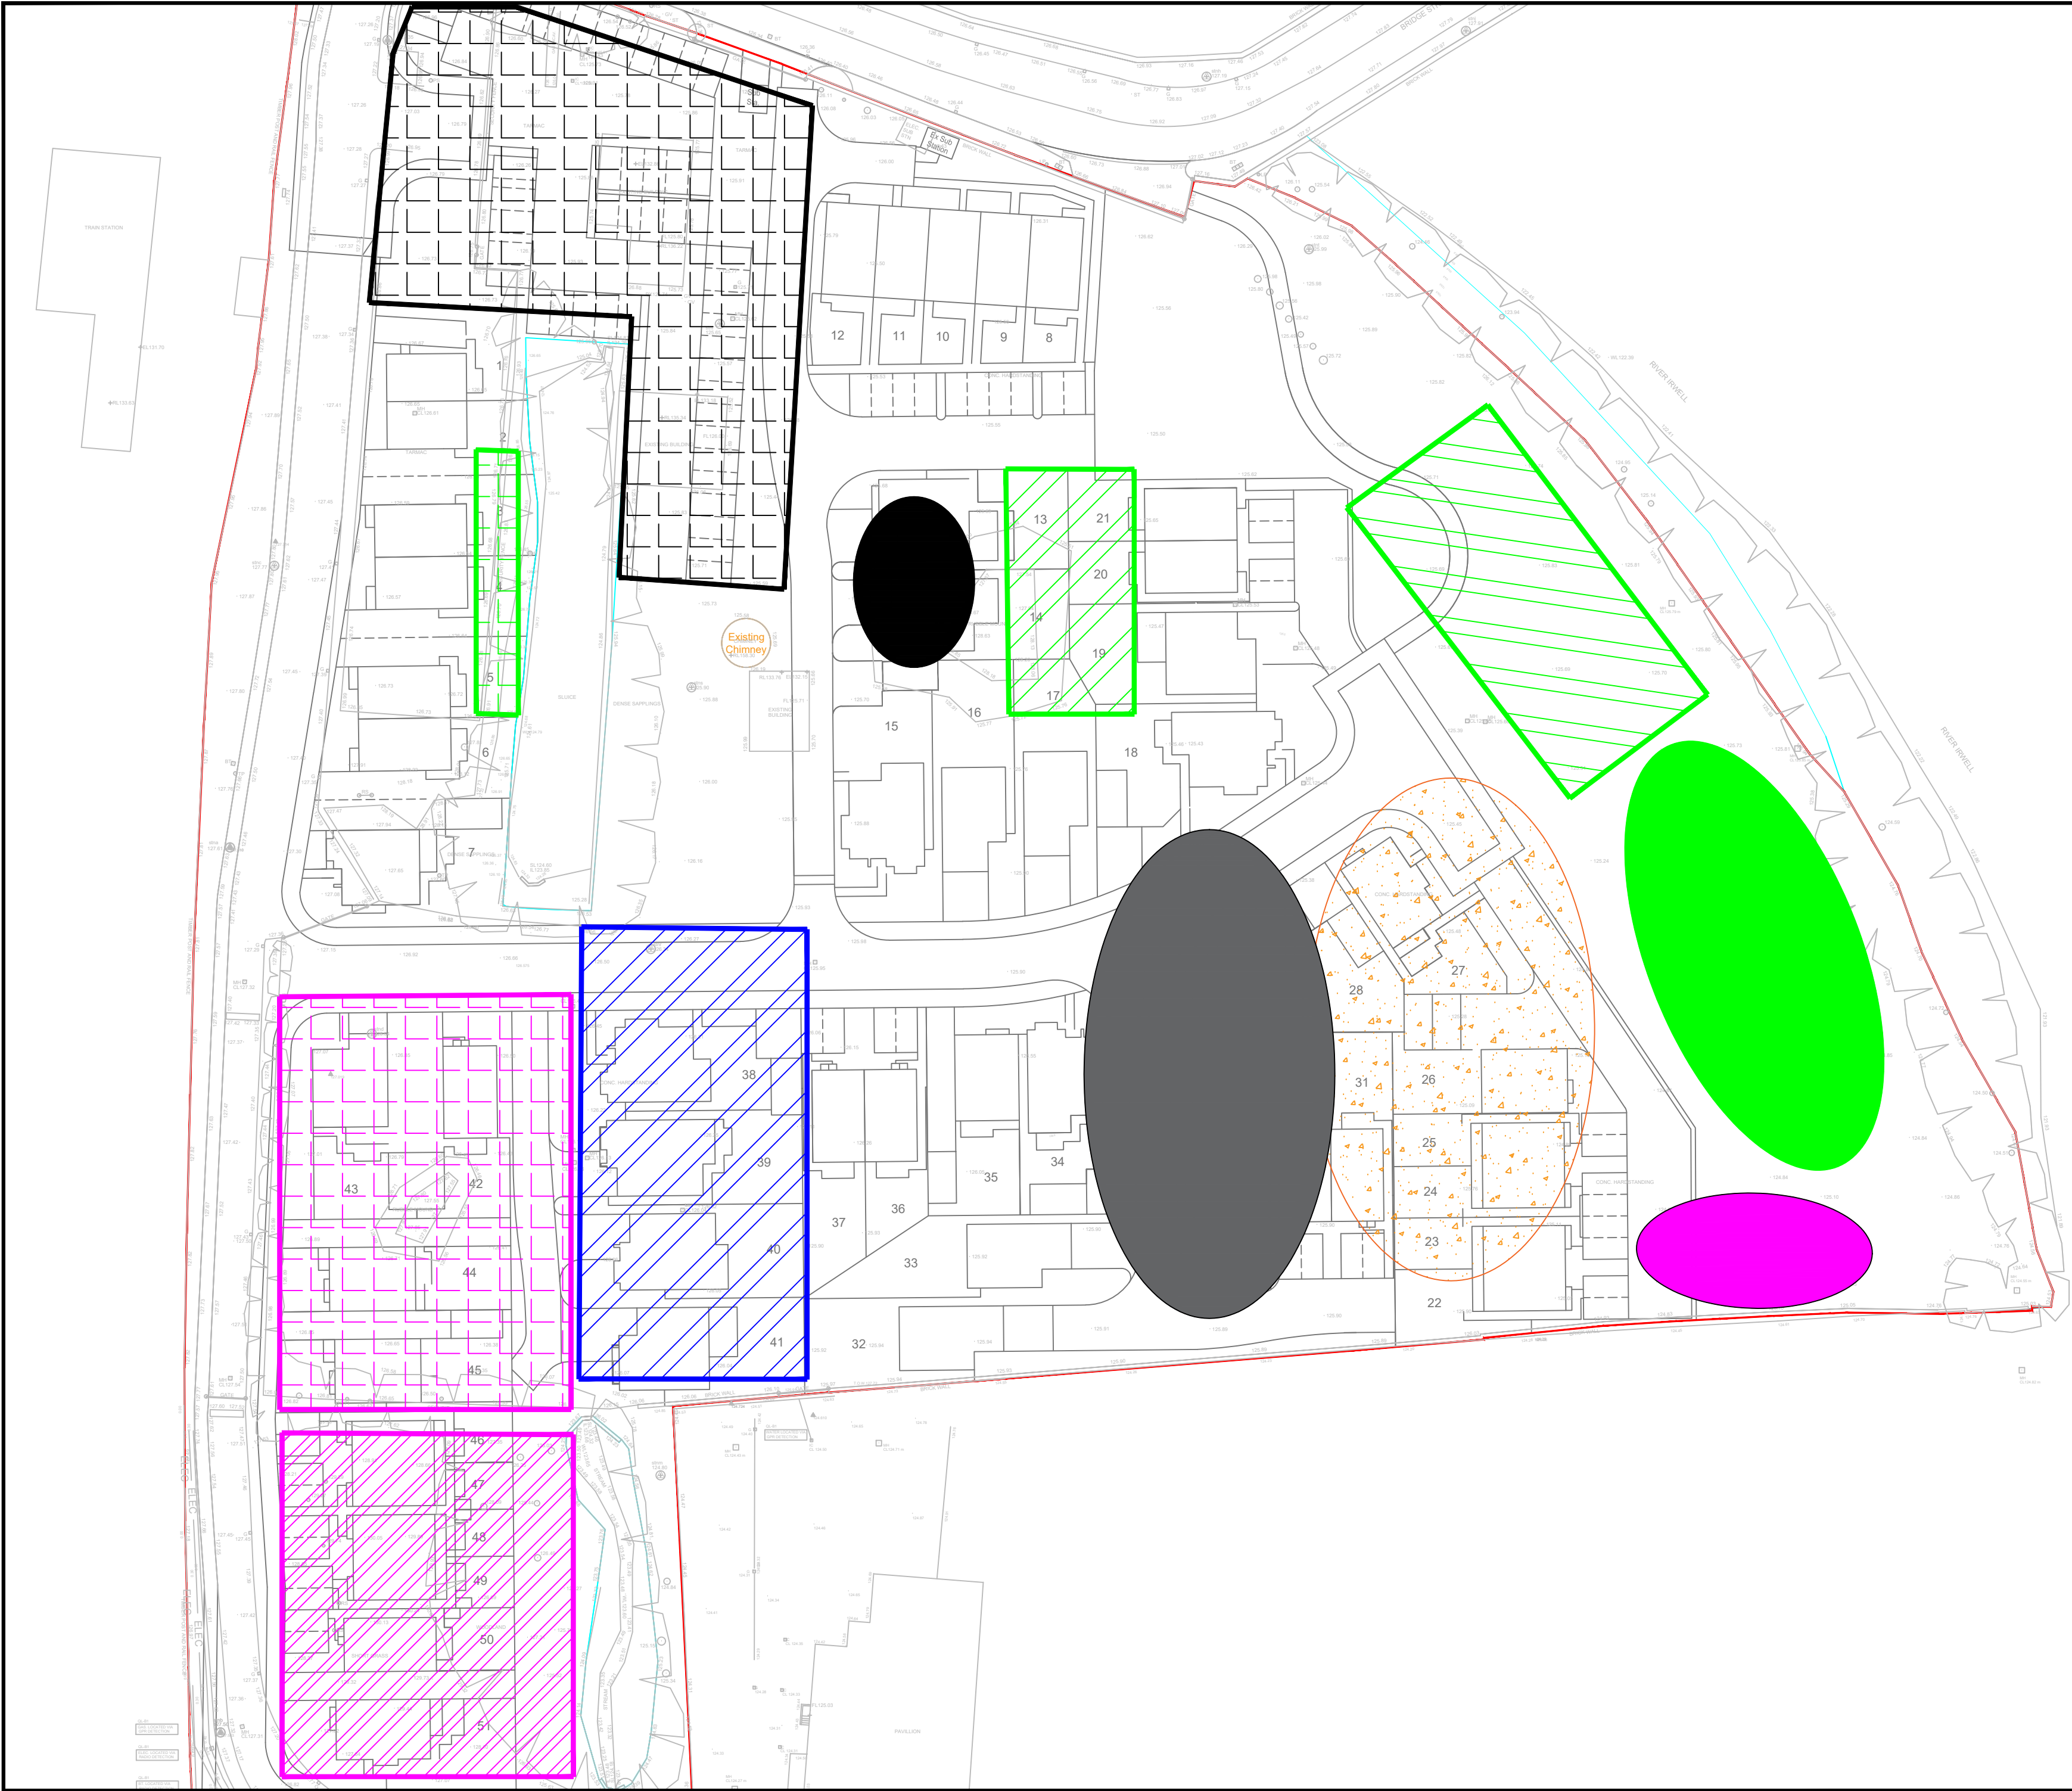

Notes
This drawing and the information contained therein is issued in confidence and is the copyright of Urban Regen Ltd. Disclosure of this information to Third Parties and unauthorised copying or replication of this data without approval is forbidden.

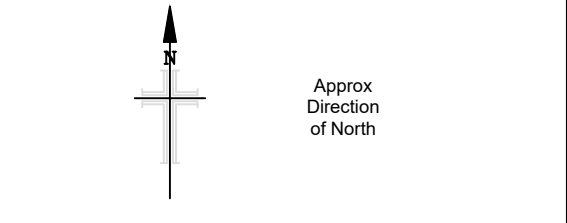

- Key:**
- Site boundary
 - Current compound location.
 - Off-site segregated stockpile locations.
 - Landfill material processing area
 - As-dug non-tip waste stockpile.
 - Oversize hard stock from surface/structure breakout.
 - Oversize hard stock from Landfill Processing area
 - Oversize hard stock generated from M.G. Screening
 - Site Won Clean 6F2 Stockpile

- Works Undertaken:**
- 07:00 - 18:00 : 30t excav. (Rick) laying remainder of fines (125mm & down) processed with screener 13 & 14/05/25 below plots 36 & 37 and tidying area above plots 39-41 as previous stocking area for off-site disposal/processing and commencing with surface hard & associated below structure breakout with hydraulic breaker.
 - 07:00 - 18:00 : 30t excav. (Chris) tidying/moving segregated stocks from area 4 to adjacent. Golt to allow remaining breakout & turn of area 4 - upto trial processing area to be undertaken, maintaining O/S hard stocks to maintain ADT access, loading hookloader with gen. waste (1 no.) and mixed scrap metal (1 no.) for off-site disposal/processing then working with 30t excav in task 1 processing O/S hard breakout with hydraulic pulveriser.
 - 07:00 - 18:00 : 20t excav. (Dan) continuing with bulk excav. in eastern P.O.S until 10:00, joined by 30t ADT excavating 6F2 train from rear gardens of plots 13-21 and placed adjacent on plots 13-21 until 13:00, then loading stockpiled sands from Eastern P.O.S and hauling to gardens of plots 13-21. Sands tracked in by excav. in 300mm layers upto 300mm of E.W.O approx. 325 m3 of 6F2 excavated and 325 m3 of sands placed.
 - 07:00 - 18:00 : 25t excav. (Ian), 22t excav. (Luke) & gen op.'s (Joe, Ryan & Stefan) tidying work area in preparation of continuing with trial processing of landfill material, removing gen. waste, scrap metal, wood & hard O/S to segregated stocks outside of processing area 22t excav. loading hard O/S from screening works undertaken 14/05/25. 09:00 - 18:00 25t excav. loading Sandvik screener with as-dug materials. 22t excav maintaining segregated stocks (Gen. waste, wood, scrap metal & fines with mixed waste) with gen op.'s. continually hand picking waste during work operations. Screened fines retained in processing area all other waste for off-site disposal/processing sent to site stocks. 15:30 Informed by R.Parry to stop trial processing. O/S hard requiring re-screening undertaken and plant commenced tidying area hand picking ops. sent home at 16:00 as no works available. Approx. 150m3 processed in day.
 - 07:00 - 17:00 : 30t ADT & 13t roller servicing above work operations as required. 4 no. (52 m3) from task 1 to base O/S stock in area 2, 1 no. (13 m3 m3) O/S hard from Task 4 to Eastern P.O.S. & 25 no. (325 m3) sand from task 3 to rear plots 13-21, 25 no. (325 m3) 6F2 from task 3 to plots 19-21 & relocating off site stocks 3 no. loads of concrete infilled steel cased piles, 2 no. loads of Tyres + 3 no. loads of timber from task to western side of Golt plots 1-7
 - 07:00 - 17:00 : tractor & Bowser used for dust suppression continuously operated by J.Wolstenholme (UR Civils)


-	--/--/----	--	Description	--
-	--/--/----	--	Description	--
Rev	Date	Drawn	Description	Chk'd




Urban Regen
ESTABLISHED 2001

Urban Regen Ltd.,
Langley Road,
Pendlebury,
Salford,
M6 6FG
TEL :
email :

Client			
Eccleston Homes			
Site			
Mondi - Mill, Ramsbottom , BL0 OBS.			
Title			
MMP Daily Tracking Record 15/05/25			
Surveyed	IHB	Drawn	IHB
Chk.	IHB	Date	15/05/25
Scale	[A2 Sheet] CAD file		
1:500	Supplied planning layout.dxf		
Dwg No.			Rev
MONDI-UR-V1-01-MMP-091			A

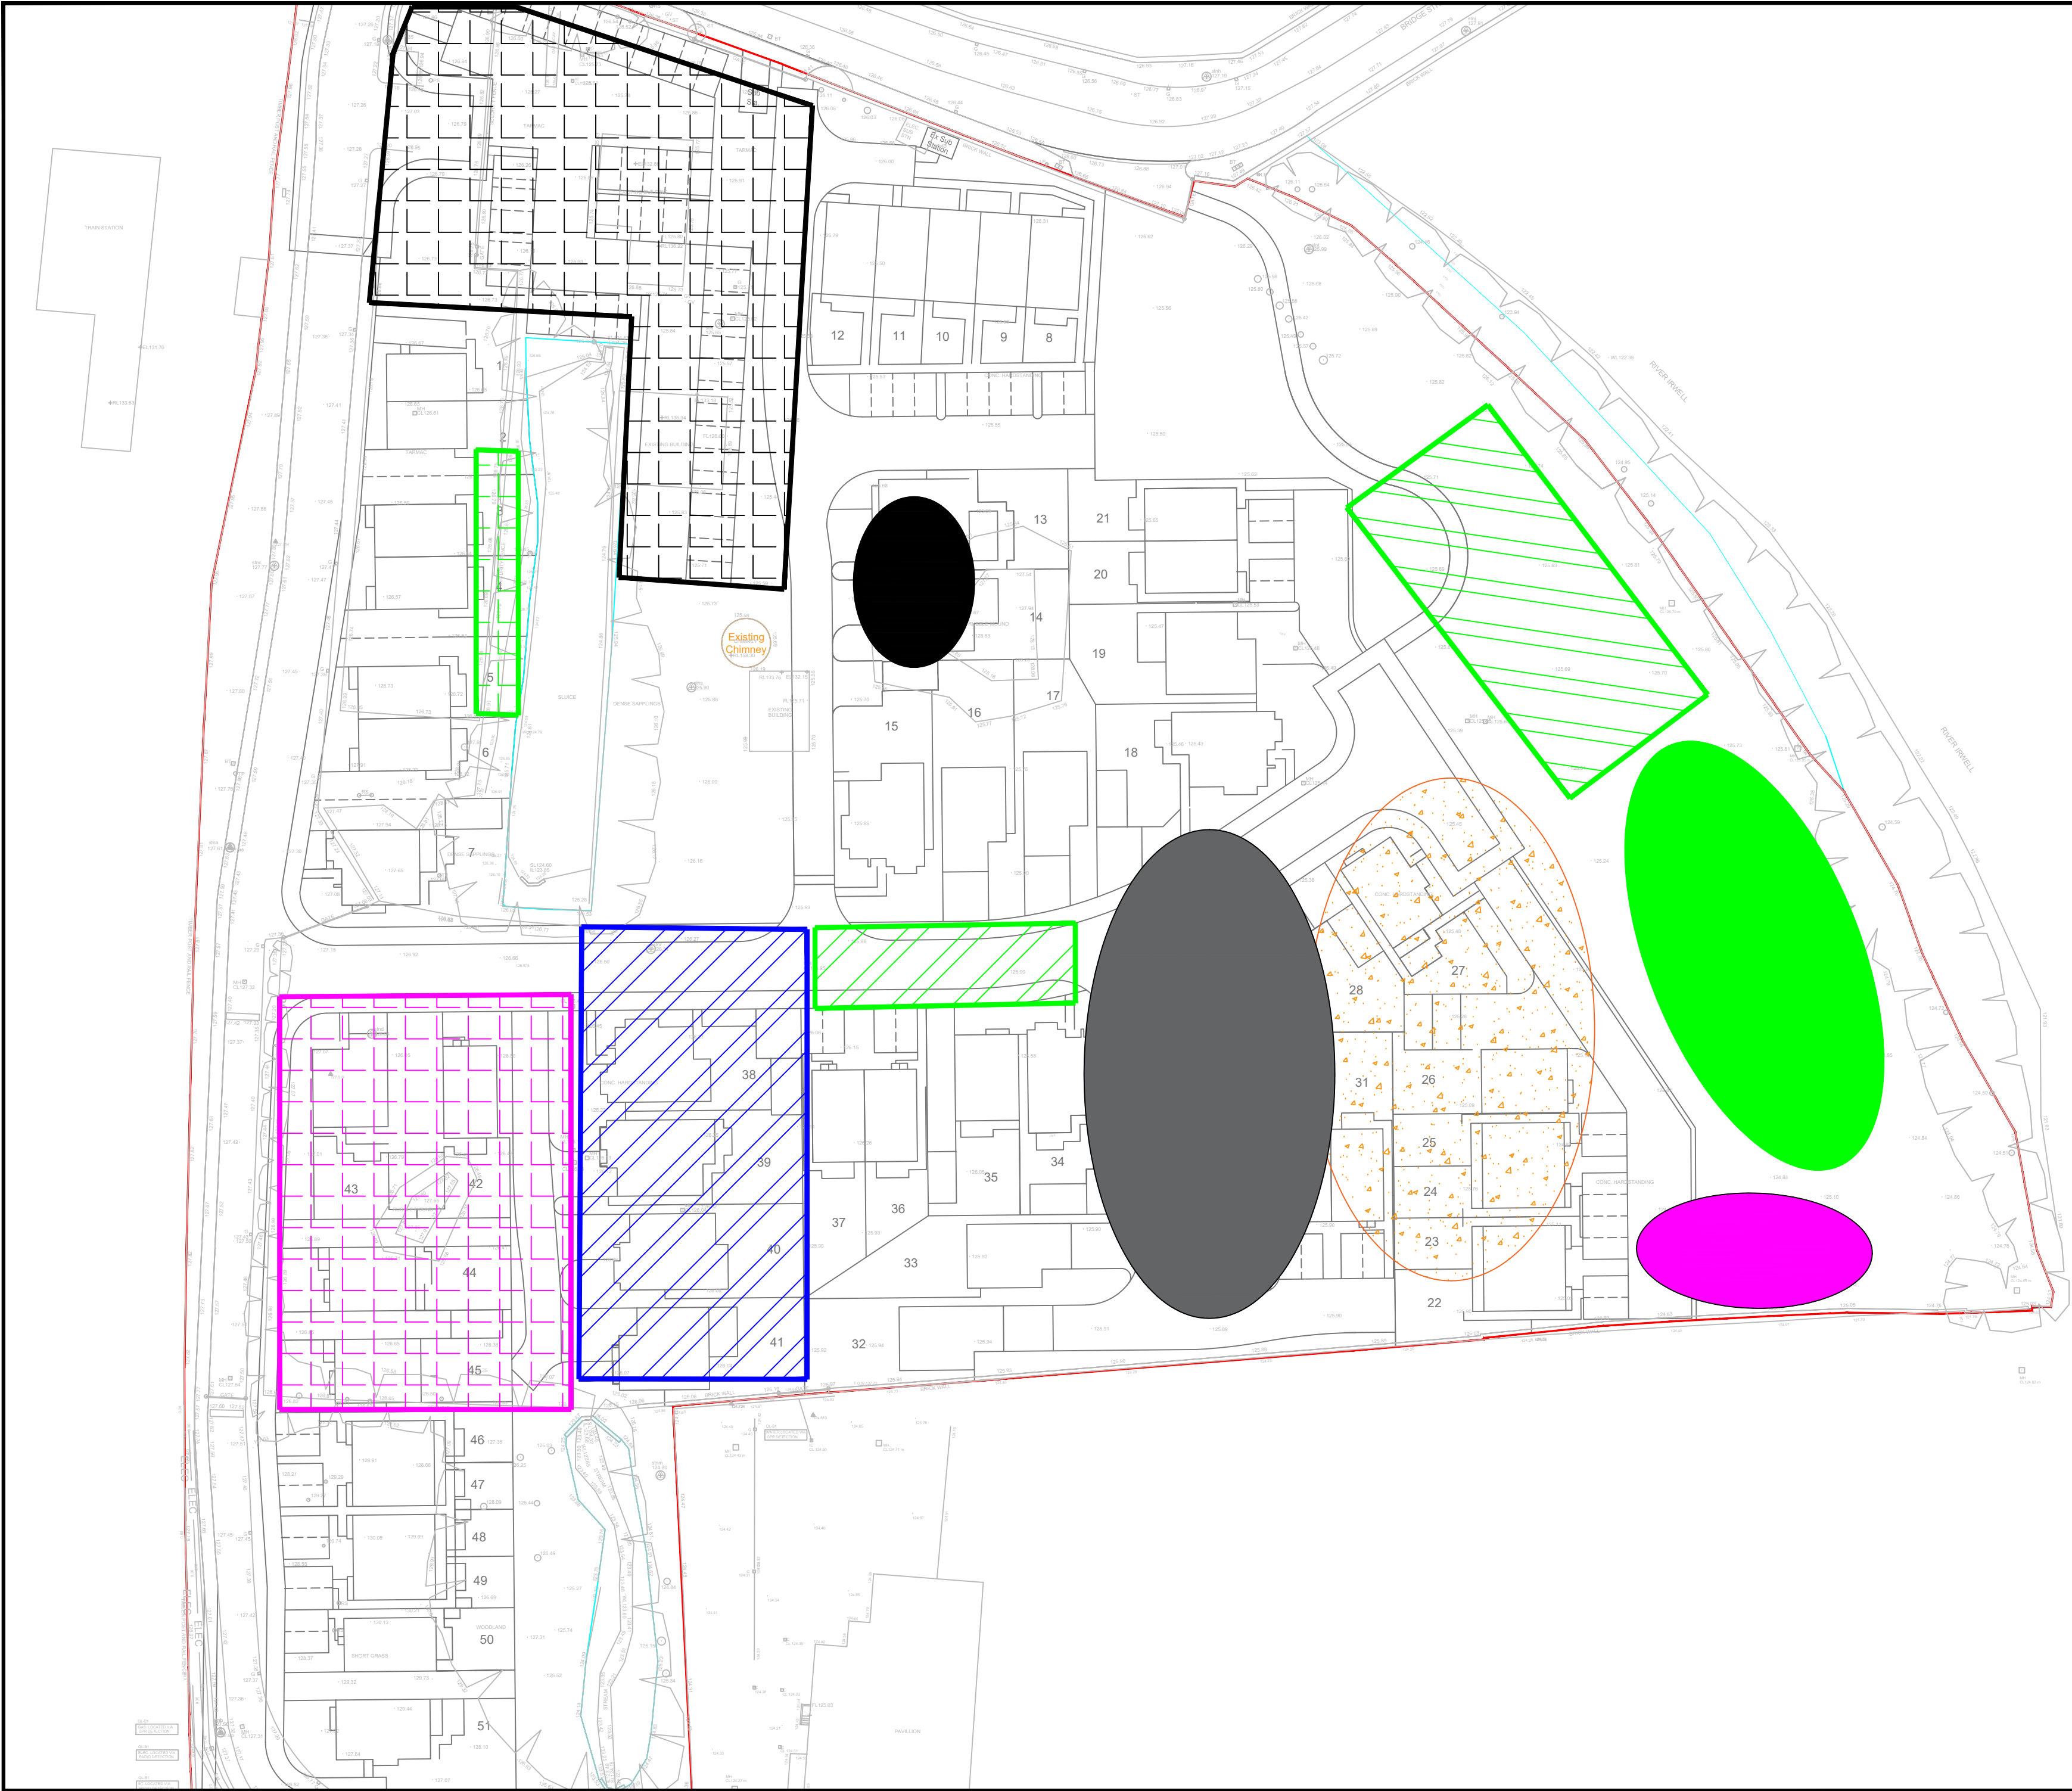

Notes
This drawing and the information contained therein is issued in confidence and is the copyright of Urban Regen Ltd. Disclosure of this information to Third Parties and unauthorised copying or replication of this data without approval is forbidden.

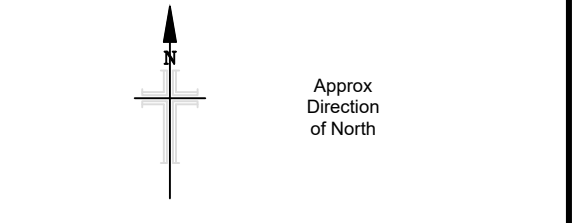

- Key:**
- Site boundary
 - Current compound location.
 - Off-site segregated stockpile locations.
 - Landfill material processing area
 - As-dug non-tip waste stockpile.
 - Override hard stock from surface/structure breakout.
 - Override hard stock from Landfill Processing area
 - Override hard stock generated from M.G Screening
 - Site Won Clean 6F2 Stockpile

- Works Undertaken:**
- 07:00 - 17:00 : 2 no. 30t excav.s (Rick & Chris) continuing with surface hard/associated below ground structure breakout & turnover works to 3.0 m below E.G L's below plots 38-41, ensuring all hard materials in excess of 150mm removed. Piles encountered removed where possible if piles snapped then excav.'s chased to 3.0m below as a min. Materials segregated and processed as required with hydraulic breaker's and pulveriser and hauled to O/S clean concrete stock in preparation of crushing. due to commence 20/05/25
 - 07:00 - 17:00 : 20t excav. (Dan) backfilling road box adjacent plots 34-37 with 6F2 recovered from rear gardens of plots 13-21 on the 15/05, 08:00 - 11:30 then Finings CAT back on site to attempt & resolve fuel filter warning light causing excav. to go into limp mode, 10:00 setting up screener in eastern P.O.S and commenced screening at 11:00 removing O/S hard from stockpiled non tip material removed from the top of areas 5 & 6 approx 500m3 processed and laid in shift. O/S hard recovered to be re-screened to remove as much of remaining fines as possible.
 - 07:00 - 17:00 : 25t excav. (Ian) and gen.op. (Lee) sealing, bulk excav. area, clearing screener and tidying up gen waste in area as trial processing works suspended as trial volume reached at 15:00 on the 15/05, 13t excav. (Graham) assisting in civilising and sealing finished waste stock and cleaning concrete slabs in area. 25t excav. went assisting screening operation detailed in Task 2 & 13t excav. undertaking tidying works around site.
 - 07:00 - 16:00 : 20t excav. (Dan-UR Civils) leveling out fill in road box adjacent plots 34-36, undertaking stock maintenance then stockpiling fines with screening operation detailed in Task 2.

- 07:00 - 17:00 : 30t ADT & 13t roller servicing above work operations as required. 4 no. (52 m3) from task 1 to base O/S stock in area 2, 1 no. (13 m3 m3) O/S hard from Task 4 to Eastern P.O.S. & 8 no. loads (104 m3) of 6F2 retrieved from plots 13-21 rear gardens to R2 road box outside of plots 34-37.
- 07:00 - 17:00 : tractor & Bowser used as required as dust suppression continuously operated by J.Woitenholme (UR Civils)


-	--/--/----	--	Description	--
-	--/--/----	--	Description	--
Rev	Date	Drawn	Description	Chk'd




Urban Regen
ESTABLISHED 2001

Urban Regen Ltd.,
Langley Road,
Pendlebury,
Salford,
M6 6FG
TEL :
email :

Client Eccleston Homes			
Site Mondi - Mill, Ramsbottom , BL0 OBS.			
Title MMP Daily Tracking Record 16/05/25			
Surveyed	IHB	Drawn	IHB
Chk.	IHB	Date	16/05/25
Scale	[A2 Sheet] CAD file		
1:500	Supplied planning layout.dxf		
Dwg No. MONDI-UR-V1-01-MMP-092			Rev A

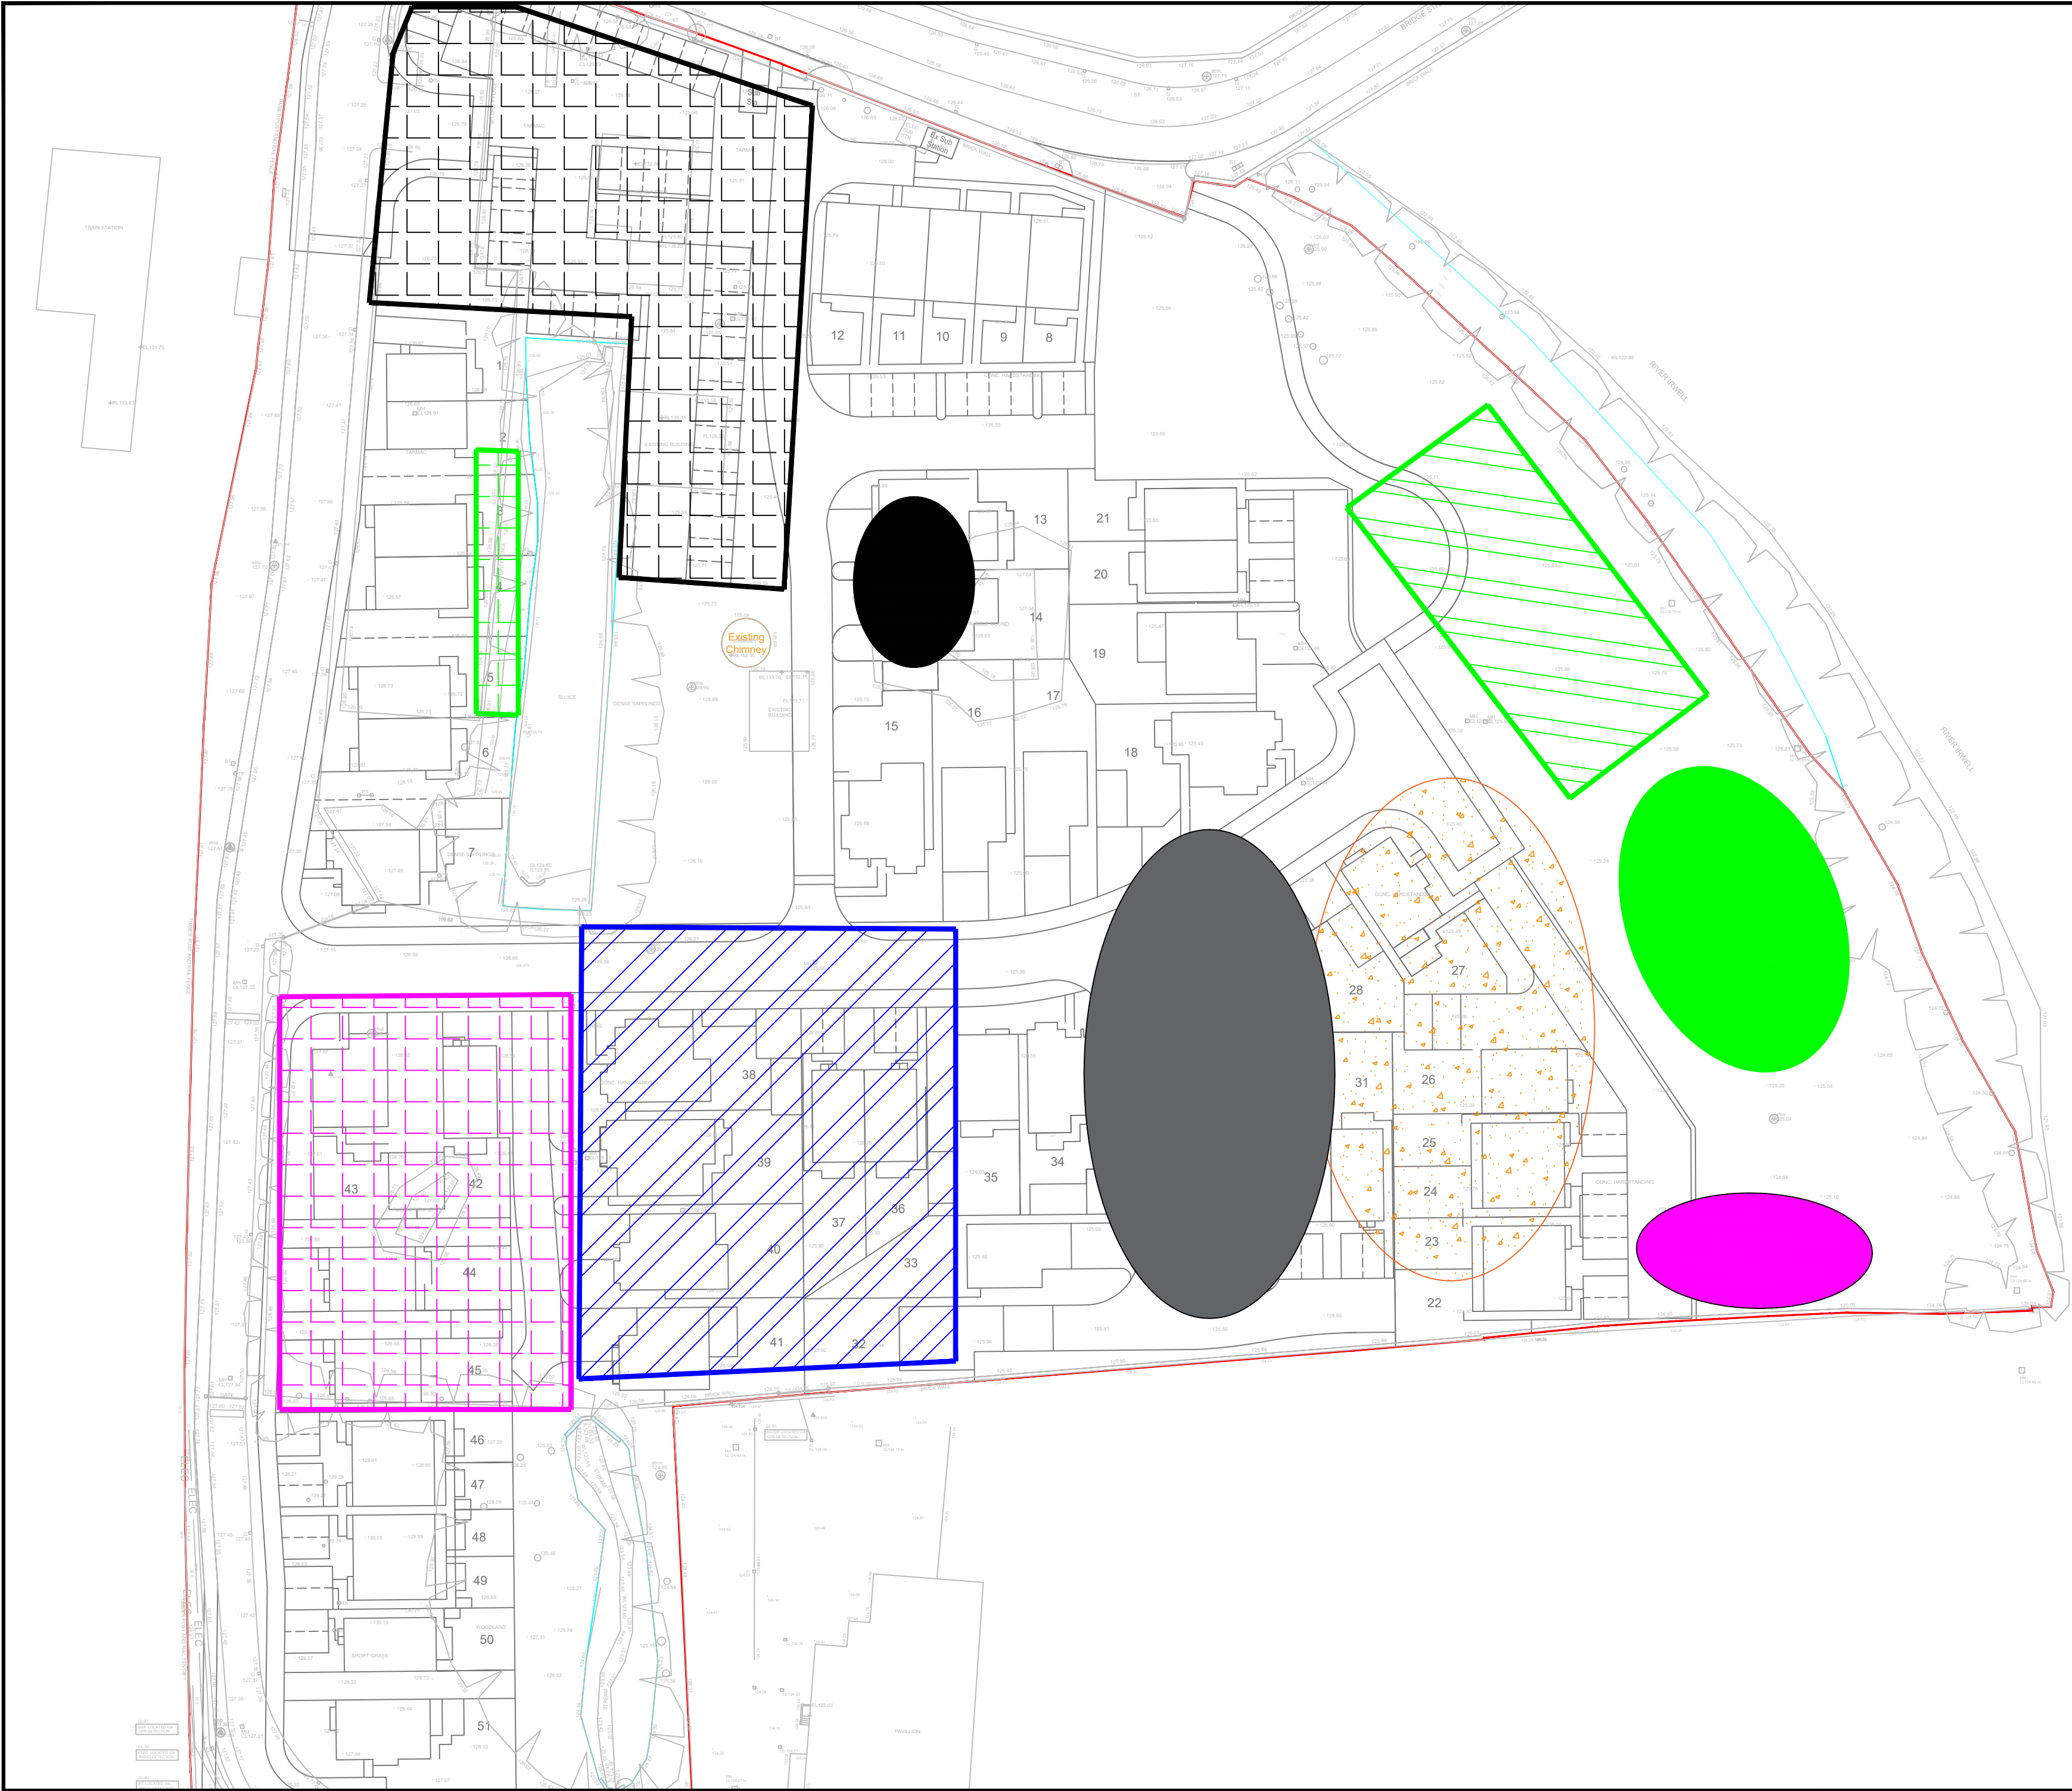

Notes
This drawing and the information contained therein is issued in confidence and is the copyright of Urban Regen Ltd. Disclosure of this information to Third Parties and unauthorised copying or replication of this data without approval is forbidden.

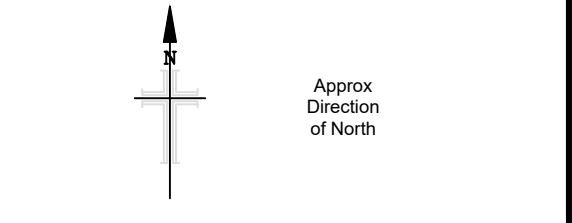

- Key:**
- Site boundary
 - Current compound location.
 - Off-site segregated stockpile locations.
 - Landfill material processing area
 - As-dug non-tip waste stockpile.
 - Oversize hard stock from surface/structure breakout.
 - Oversize hard stock from Landfill Processing area
 - Oversize hard stock generated from M.G Screening
 - Site Won Clean 6F2 Stockpile

- Works Undertaken:**
- 07:00 - 13:00 : 30t excav. (Rick) using sandvik screener (UR - PN 144) to process made ground up to 3 m deep encountered below plots 33-41 (approx.). fines belt used as gen. fill below plots 34-35. O/S hard segregated as suspected elevated asbestos fines (Previously encountered) and not wanting to condemn 6F2 crush pile.
 - 07:00 - 13:00 : 30t excav (Rob) utilising magnet attachment to remove scrap metal from O/S hard generated since processing of hard materials commenced feb 2025, loading 30t ADT (Rob) and creating segregated stockpile within area 5 processing area allowing breakout & turn over to proceed upto processing area.
 - 07:00 - 13:00 : 25t excav. (Ian), 20t excav. (Dan) and sandvik screener (Casey's) continuing with screening non tip material to recover O/S Hard within the eastern P.O.S approx. 500 m processed in shift.


-	---/---/---	--	Description	--
-	---/---/---	--	Description	--
Rev	Date	Drawn	Description	Chk'd




Urban Regen
ESTABLISHED 2001

Urban Regen Ltd.,
Langley Road,
Pendlebury,
Salford,
M6 6FG
TEL :
email :

Client			
Eccleston Homes			
Site			
Mondi - Mill, Ramsbottom , BL0 0BS.			
Title			
MMP Daily Tracking Record 17/05/25			
Surveyed	IHB	Drawn	IHB
Chk.	IHB	Date	17/05/25
Scale	[A2 Sheet] CAD file		
1:500	Supplied planning layout.dxf		
Dwg No.	MONDI-UR-V1-01-MMP-093		Rev
		A	

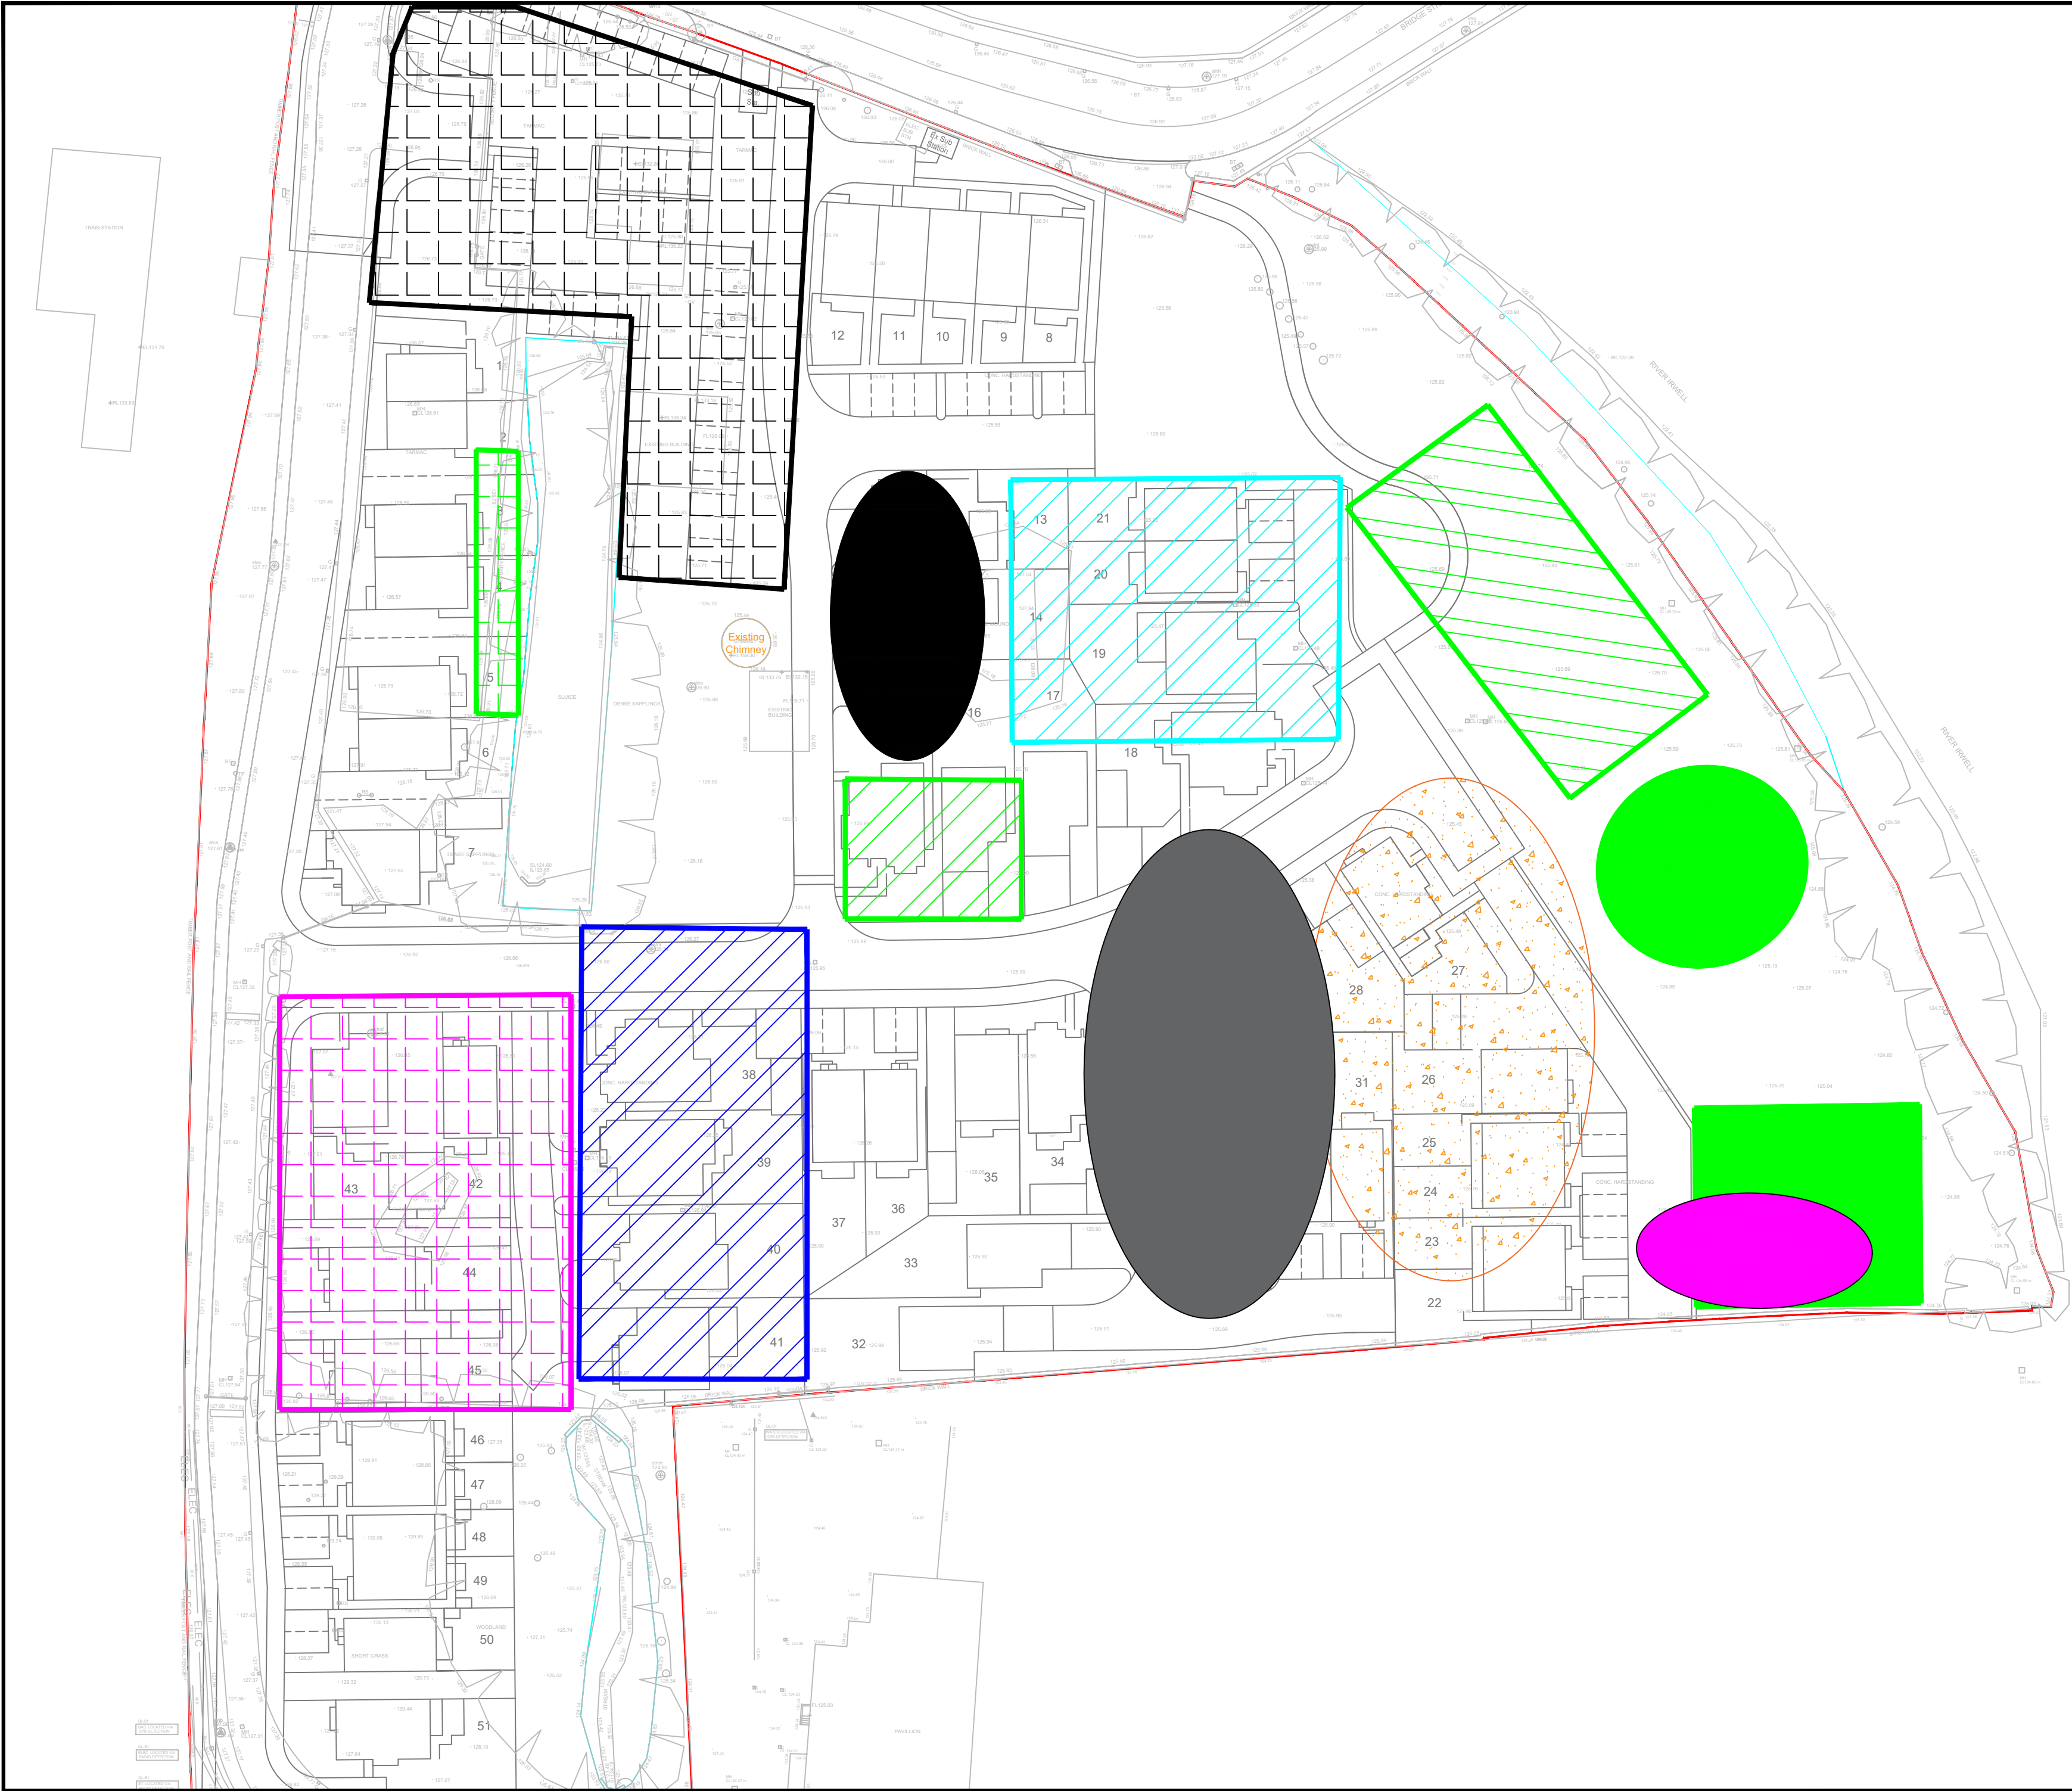

Notes
This drawing and the information contained therein is issued in confidence and is the copyright of Urban Regen Ltd. Disclosure of this information to Third Parties and unauthorised copying or replication of this data without approval is forbidden.

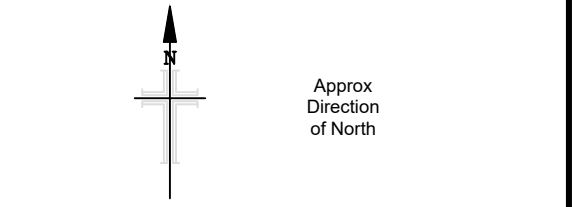

- Key:**
- Site boundary
 - Current compound location.
 - Off-site segregated stockpile locations.
 - Landfill material processing area
 - As-dug non-tip waste stockpile.
 - Oversize hard stock from surface/structure breakout.
 - Oversize hard stock from Landfill Processing area
 - Oversize hard stock generated from M.G Screening
 - Site Won Clean 6F2 Stockpile


- Works Undertaken:**
- 07:00 - 18:00 : 2 x 30t excav 's (Rick & Chris) continuing with breakout & turnover works below plots 38-41, removing all O/S hard encountered in excess of 150mm upto 3.0m from proposed E.W.O. Piles encountered removed, if piles broke during removal then piles chased to the 3.0m cut off level and surveyed by excav. Excavators utilising hydraulic breakers, rotating grab, magnet & pulveriser to process concrete (including all stocks) and hauled to segregated stocks O/S hard & Base O/S hard, scrap metal, wood and gen waste sent to off-site stocks in preparation of disposal/processing.
 - 07:00 - 18 :00 : 25t excav. (Ian) and 20t excav. (Dan) continuing with crushing of base O/S hard stock with 20t excav. loading & 25t excav. maintaining belt ensuring belt pile left as close to belt to reduce on dust generated approx 500 m3 processed in day and laid below road 2 & plots 32-37 approx.
 - 07:30-16:30 : 13t excav. (Graham), 20t excav. (Dan) and gen. op. (Joe) continuing in Eastern P.O.S, utilising sandvik screener (Casey's), re-screening O/S hard stock to reduce on fines & waste content, O/S hard once re-screened sent to O/S base layer stock for crushing.
 - 07:00 - 17:00 : 30t ADT & 13t roller servicing above work operations as required. 12 no. (156 m3) ADT loads taken from Breakout in Task 1 to O/S hard stock in area 1 & 7 no. (91 m3) O/S from Task 3 in Eastern P.O.S to base O/S hard stock.
 - 07:00 - 17:00 : tractor & Bowser used as dust suppression continuously operated by J.Wolstenholme (UR Civils)

Rev	Date	Drawn	Description	Chk'd
-	-	-	Description	-
-	-	-	Description	-




Urban Regen Ltd.,
Langley Road,
Pendlebury,
Salford,
M6 6FG
TEL :
email :

Client				Eccleston Homes			
Site				Mondi - Mill, Ramsbottom , BL0 OBS.			
Title				MMP Daily Tracking Record 20/05/25			
Surveyed		IHB		Drawn		IHB	
Chk.		IHB		Date		20/05/25	
Scale		[A2 Sheet] CAD file		Supplied planning layout.dxf			
1:500							
Dwg No.				MONDI-UR-V1-01-MMP-095		Rev A	

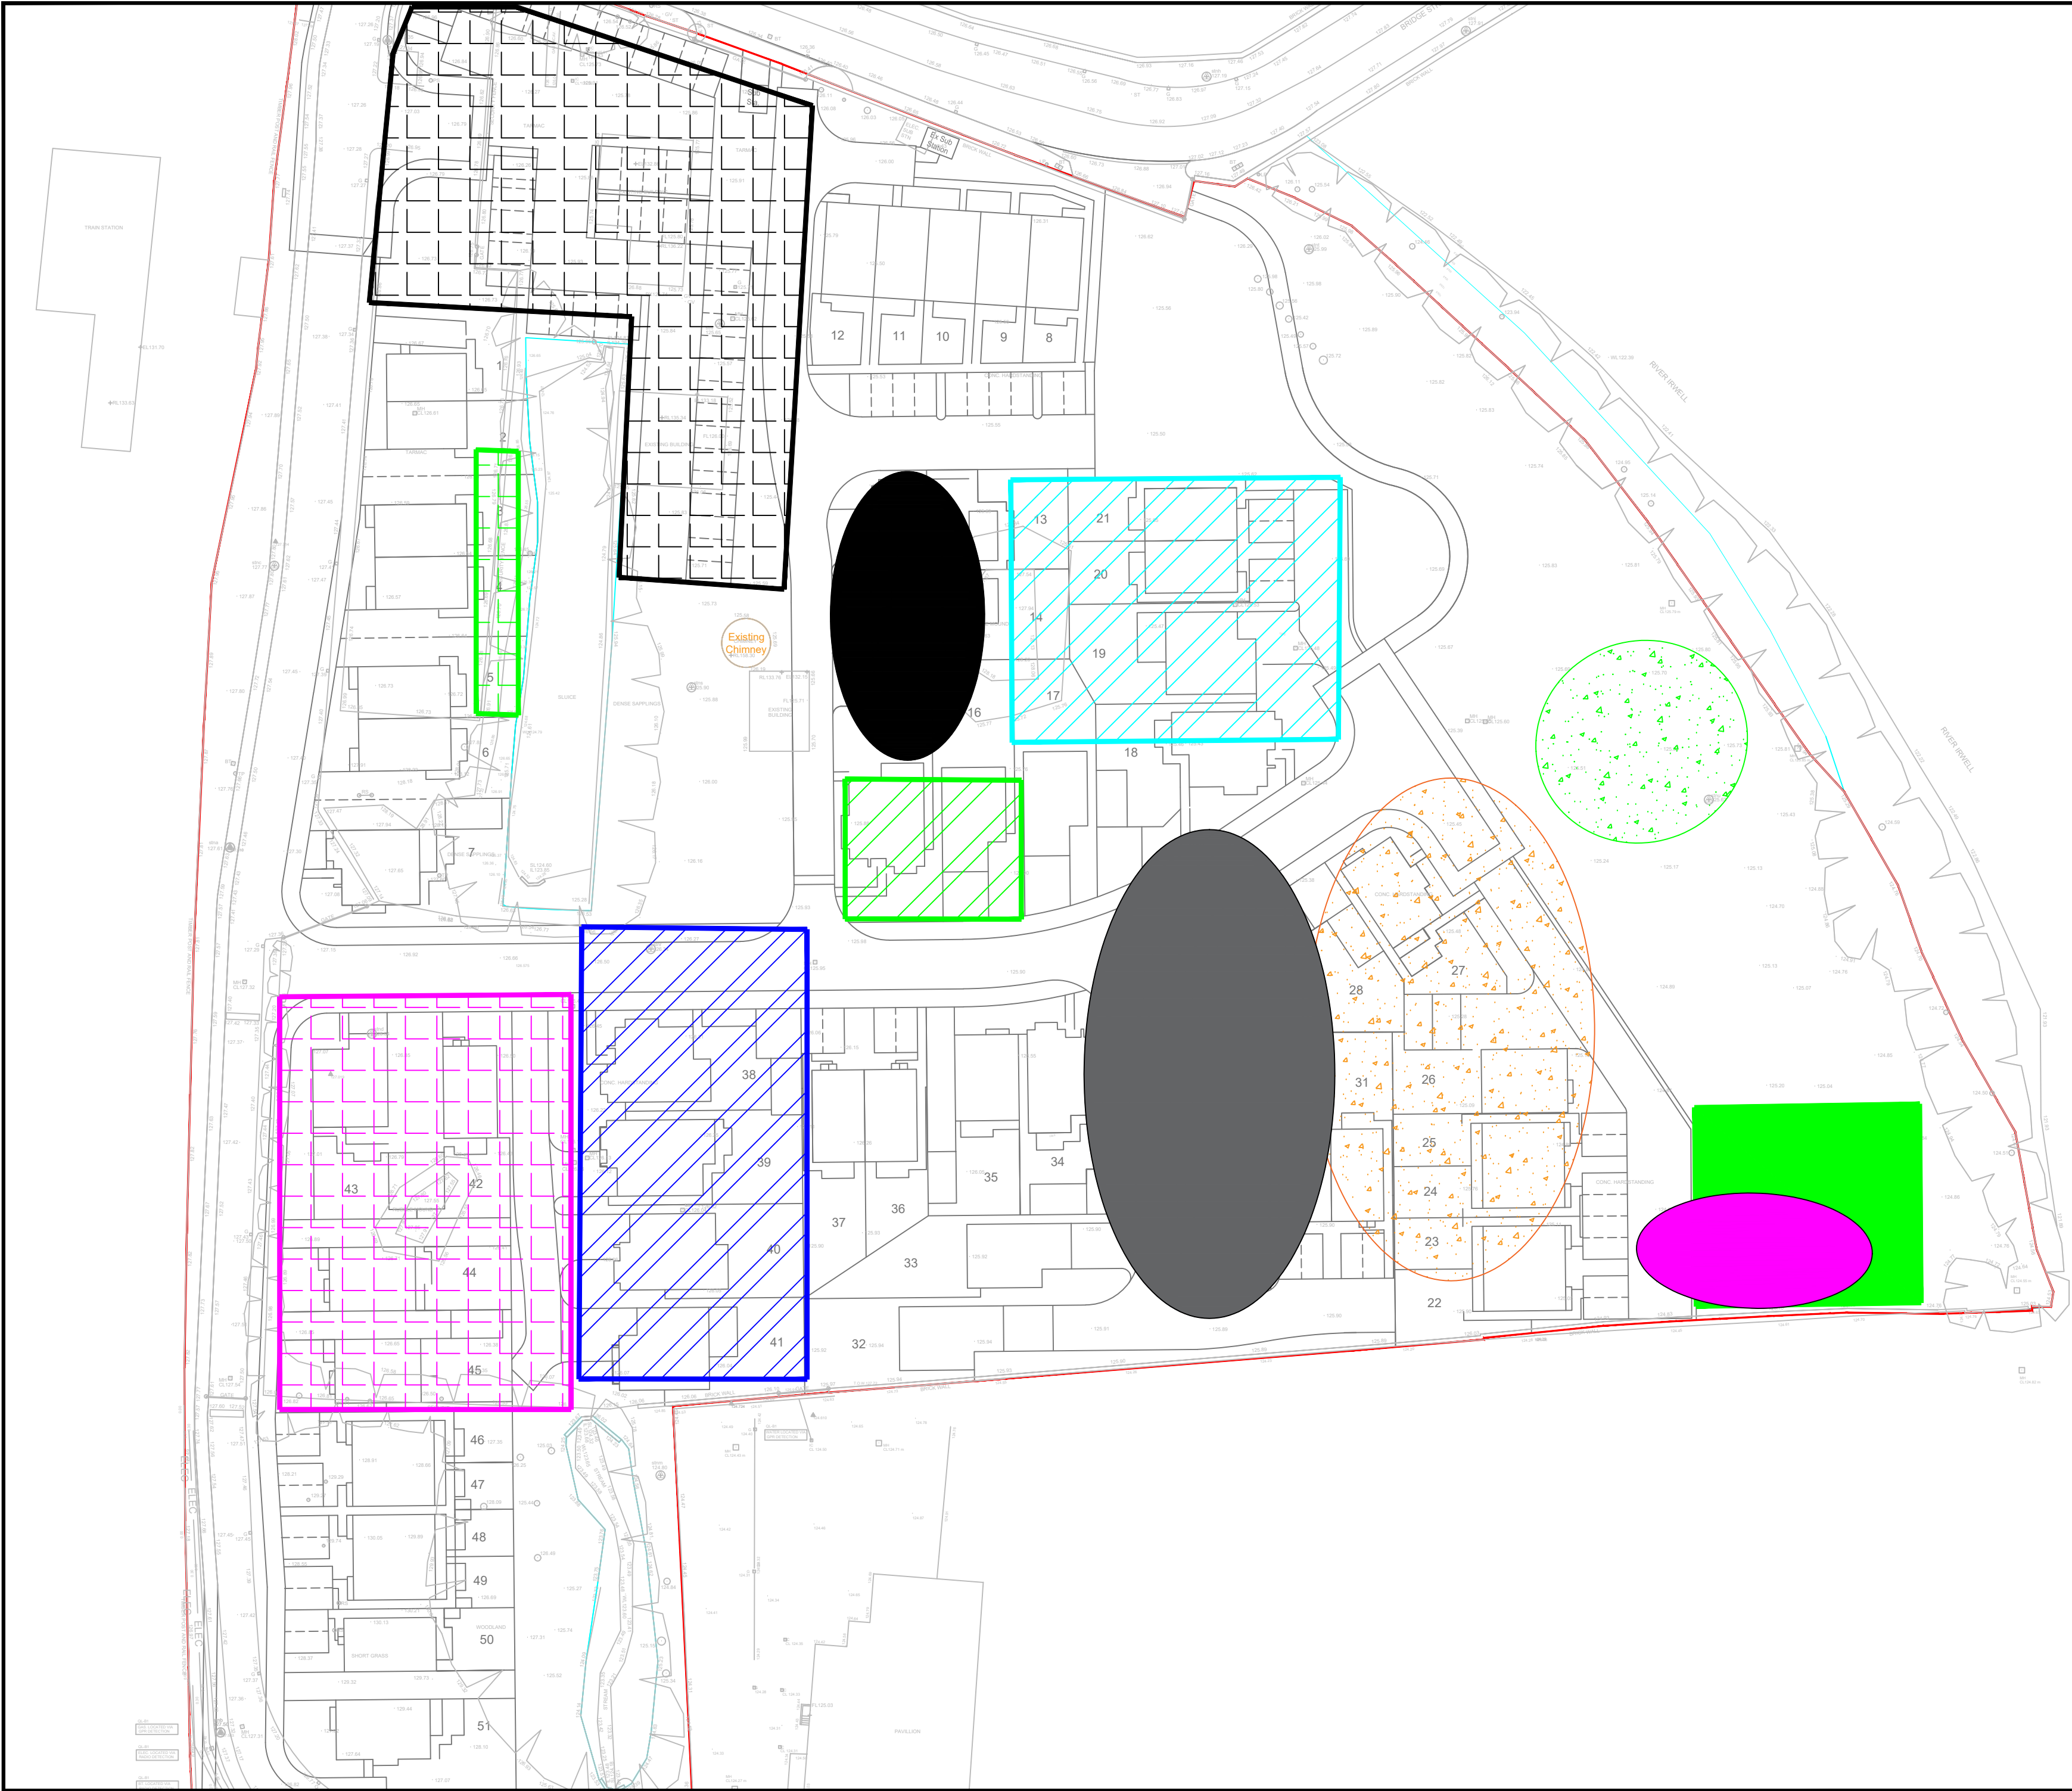

Notes
This drawing and the information contained therein is issued in confidence and is the copyright of Urban Regen Ltd. Disclosure of this information to Third Parties and unauthorised copying or replication of this data without approval is forbidden.

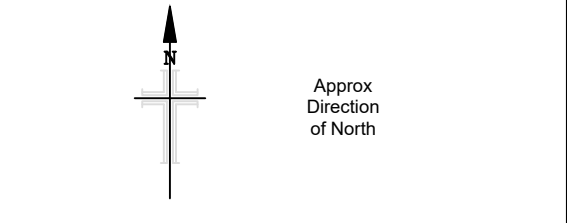

- Key:**
- Site boundary
 - Current compound location.
 - Off-site segregated stockpile locations.
 - Landfill material processing area
 - As-dug non-tip waste stockpile.
 - Oversize hard stock from surface/structure breakout.
 - Oversize hard stock from Landfill Processing area
 - Oversize hard stock generated from M.G Screening
 - Site Won Clean 6F2 Stockpile
 - Screened fines from Area 5 & 6 capping material.

- Works Undertaken:**
- 07:00 - 18:00 : 2 x 30t excav 's (Rick & Chris) continuing with breakout & turnover works below plots 38-41, removing all O/S hard encountered in excess of 150mm upto 3.0m from proposed E.W.O. Piles encountered removed, if piles broke during removal then piles chased to the 3.0m cut off level and surveyed by excav. Excavators utilising hydraulic breakers, rotating grab, magnet & pulveriser to process concrete (including all stocks) and hauled to segregated stocks O/S hard & Base O/S hard, scrap metal, wood and gen waste sent to off-site stocks in preparation of disposal/processing.
 - 07:00 - 18:00 : 29t excav. (tan), 20t excav. (Dan) and gen. op. (Jae) continuing in Eastern P.O.S. utilising sandvick screener (Casey's), screening non tip material from areas 5 & 6 removing O/S hard fines & O/S hard stockpiled locally approx (600 m3 processed), 14.00 then setting up screener to re-screen O/S hard stock to reduce on fines & waste content, screening op. detailed in Task 3 15:00 - 18:00 commencing crushing of base O/S hard stock with 20t excav, loading & 25t excav, maintaining belt ensuring belt pile left as close to belt to reduce on dust generated approx 200 m3 processed in day and laid below plots 14-15.
 - 07:30 - 16:30 : 13t excav. (UR Civils - Graham) leveling out and tracking in 6/2 block tipped on plots 18-21 on the 18/05 & 20t excav. (UR Civils - Dan) "hamming" non tip material to screening operation in task 2 until 10:30, Then placing , leveling & compacting additional sand in rear gardens of plots 13-21 and capping off gardens with 300mm of 6/2 as due to be used as a carpark by Eccleston homes W0 28/05/25. Surcharged over plots 18-21 & rear gardens of plots 13-21 in preparation of trimming due to be undertaken 22/05/25, until 15:00 then undertaking re-screening of O/S hard stock to reduce on fines & waste content,
 - 07:00 - 17:00 : 30t ADT & 13t roller servicing above work operations as required, 16 no. (208 m3) ADT loads taken from Breakout in Task to O/S hard stock in area 1 & 14 no. (182 m3) 6/2 from stock in area 1 to plots 18-21 taken to capping level in Task 5.
 - 07:00 - 17:00 : tractor & Bowser used as dust suppression continuously operated by J.Wolstenholme (UR Civils)

-	---/---/---	--	Description	--
-	---/---/---	--	Description	--
Rev	Date	Drawn	Description	Chk'd




Urban Regen
ESTABLISHED 2001

Urban Regen Ltd.,
Langley Road,
Pendlebury,
Salford,
M6 6FG
TEL :
email :

Client			
Eccleston Homes			
Site			
Mondi - Mill, Ramsbottom , BL0 OBS.			
Title			
MMP Daily Tracking Record 21/05/25			
Surveyed	IHB	Drawn	IHB
Chk.	IHB	Date	21/05/25
Scale	[A2 Sheet] CAD file		
1:500	Supplied planning layout.dxf		
Dwg No.	MONDI-UR-V1-01-MMP-096		Rev
		A	



Notes
This drawing and the information contained therein is issued in confidence and is the copyright of Urban Regen Ltd. Disclosure of this information to Third Parties and unauthorised copying or replication of this data without approval is forbidden.

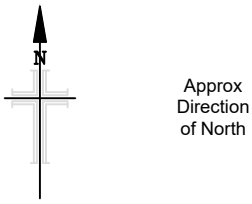

- Key:**
- Site boundary
 - Current compound location. Supplied by Eccleston Homes.
 - Off-site segregated stockpile locations.
 - Landfill material processing area
 - As-dug non-tip waste stockpile.
 - Oversize hard stock from surface/structure breakout.
 - Oversize hard stock from Landfill Processing area
 - Site Won Clean 6F2 Stockpile
 - Screened fines from Area 5 & 6 capping material.


- Works Undertaken:**
- 07:00 - 17:00 30t excav. (Rick) leveling 6f2 placed over plots 15-17, R2 & 34-38 on the 20 & 21/05/25 allowing area to be compacted with 13t roller and laying/compacting 6f2 from stock into R2 to return access off existing slabs of processing area and negate existing haul route along southern boundary and completing 300mm crush cover & protect to all exposed natural made ground as rain due over bank holiday weekend.
 - 07:00 - 17:00 30t excav. (Chris) continuing with trimming plots 18-21 then filling below plots 13 - 17 with 6f2 in preparation of handing area back to Eccleston Homes for material storage & carpark as requested in progress meeting on the 21/05/25. Gen op. (Lee) undertaking litter pick of 6f2 laid at E.W.O/formation with all litter added to gen.waste stock in preparation of Off-site disposal/processing.
 - 07:00 - 17:00 20t excav. (Dan), 25t excav. (Ian) & Powertrack 400 crusher (Casey's) continuing with processing 6f2 from O/S hard stock in area 1, 20t excav. loading crusher with 25t excav. maintaining beltstock and loading 30t ADT with 6f2 as required. Crusher requiring to be stopped every couple of hours as steel getting behind belt and stopping magnet belt, new belt due to be installed 27/05 after Casey filter on site 22/05.
 - 07:00 - 17:00 UR civls 13t (Graham) & 20t excav. (Dan) continuing with tidying/organising works in Eastern P.O.S. slow working as ADT in use & stockpiles already on material requiring screening, moving stockpiles in preparation of screening remaining non-tip material from areas 5 & 6 to retrieve O/S hard
 - 07:00 - 17:00 30t ADT & 13t roller (Rob) servicing above work operations as required. 1 no. O/S from task 1 to O/S hard stock in area 1, 65 no. 6f2 from stock to fill areas below plots 13-21 & 33-37 including re-installing access in R2 adjacent plot 38.
 - 07:00 - 17:00 tractor & Bowser used as dust suppression as required.
 - 09:00 - 15:30 Murray Rix site technician on site to Undertake CBR tests on final layers of plots 8-19 (Excluding 15-17) in preparation of handing area to Eccleston Homes for materials storage and car park. 8 no. CBR's undertaken achieving over 15 % (Target 5%). Unable to commence testing until 10:30 as area being compacted/worked.

Rev	Date	Drawn	Description	Chk'd
-	--/--/----	--	Description	--
-	--/--/----	--	Description	--




Urban Regen Ltd.,
Langley Road,
Pendlebury,
Salford,
M6 6FG
TEL :
email :

Client				Eccleston Homes			
Site				Mondi - Mill, Ramsbottom , BL0 OBS.			
Title				MMP Daily Tracking Record 23/05/25			
Surveyed	IHB		Drawn	IHB			
Chk.	IHB		Date	23/05/25			
Scale	[A2 Sheet]		CAD file				
1:500		Supplied planning layout.dxf					
Dwg No.			MONDI-UR-V1-01-MMP-098			Rev	A

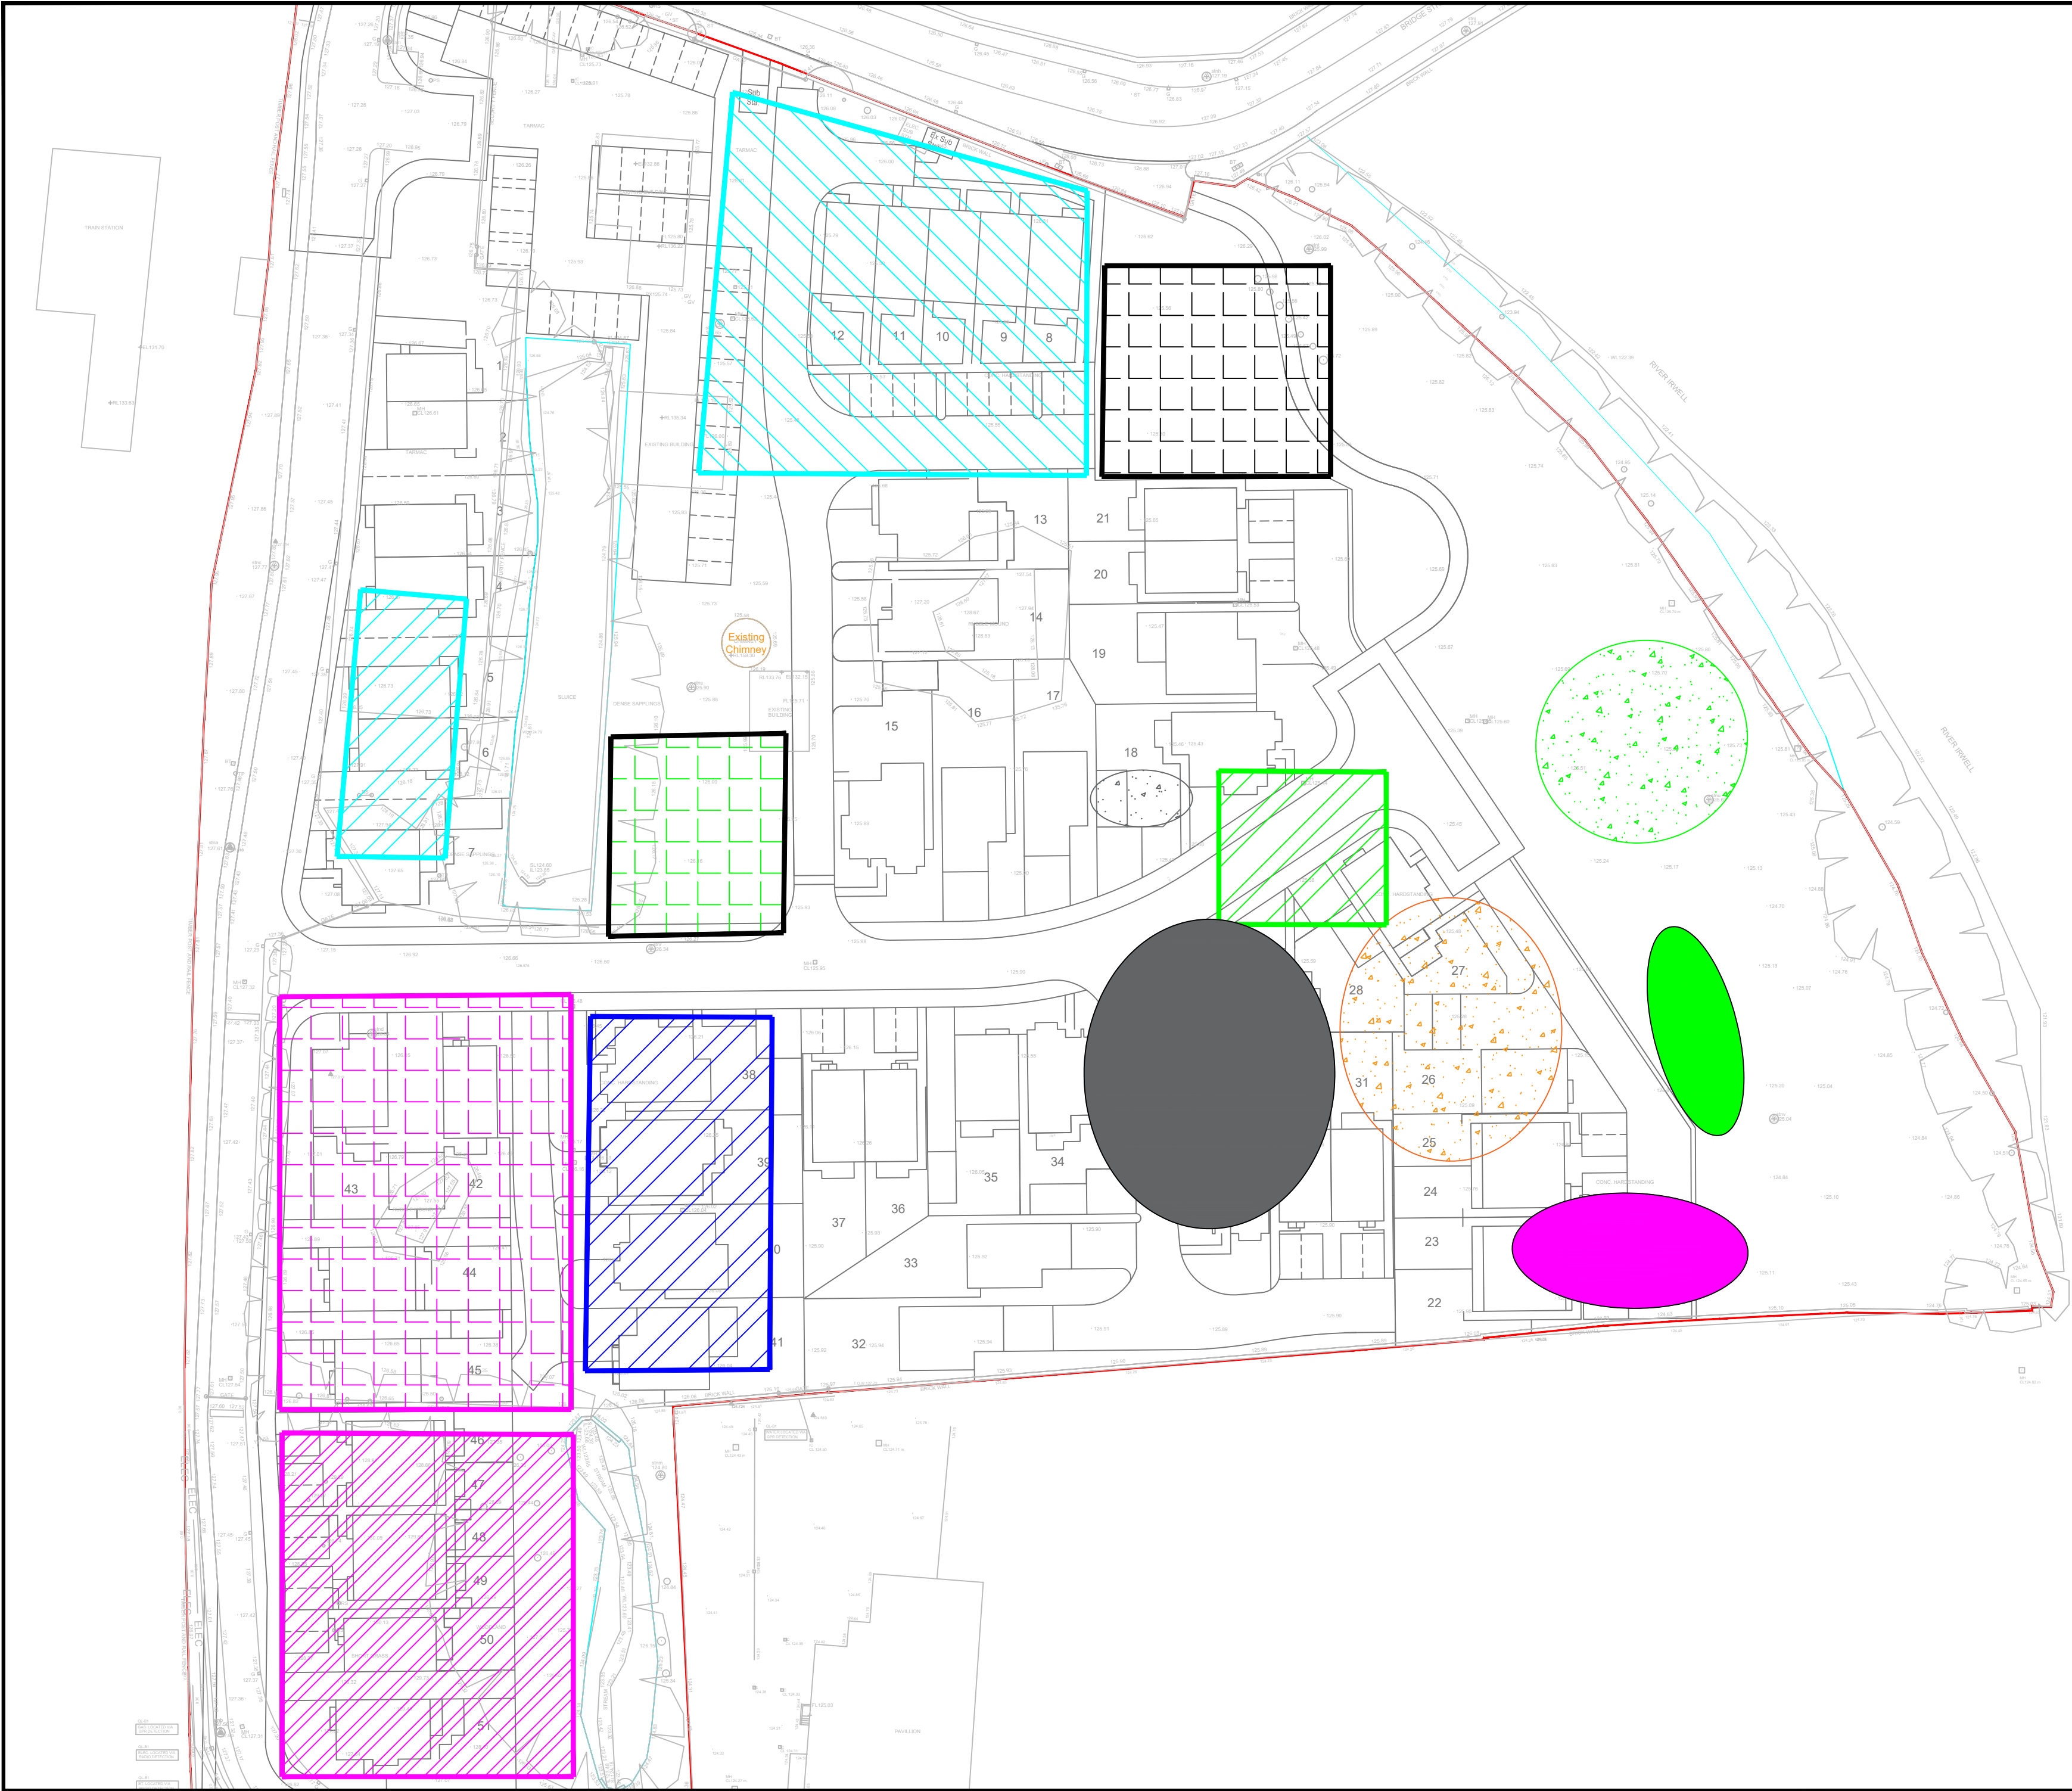

Notes
This drawing and the information contained therein is issued in confidence and is the copyright of Urban Regen Ltd. Disclosure of this information to Third Parties and unauthorised copying or replication of this data without approval is forbidden.

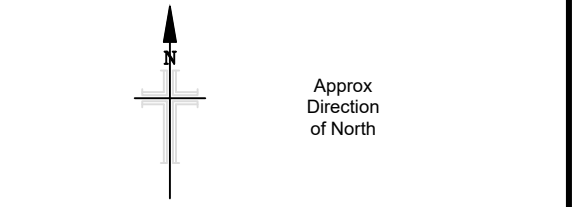

- Key:**
- Site boundary
 - Current compound location. Supplied by Eccleston Homes.
 - Off-site segregated stockpile locations.
 - Landfill material processing area
 - As-dug non-tip waste stockpile.
 - Oversize hard stock from surface/structure breakout.
 - Site Won Clean 6F2 Stockpile
 - Screened fines from Area 5 & 6 capping material.
 - Site Won Clean MOT Trial Stockpile

- Works Undertaken:**
- 07:00 - 18:00 : 30t excav. (Rick) Loading UR bulker (Scrap) & 35 yard skip wagon supplied by CTC (Blumen soaked timbers) for off-site disposal/processing, undertaking processing on O/S hard stock with hydraulic breaker & pulveriser and continuing with breakout/turnover works below plots 38-41, hard breakout stockpiled locally in preparation of removal once ADT available.
 - 07:00 - 18:00 : 30t excav. (Carl) continuing with uplifting levels, laying pile mats, trimming to design levels and utilising magnet attachment to plots 1-14 & western side of proposed carpark, slow working around plots 8-12 as UR civils laying Tarmac to E.H compound. Tarmac works due to be completed for 13:00 but works not complete until 16:00 causing operations to be undertaken at same time.
 - 07:00 - 18:00 : 20t excav. (Dan) loading premiertrak 400 crusher (Casey's) with O/S hard from stock processing 6/2, 2/2 excav. (Dan-UR Civils) maintaining stock & loading 30t ADT as required. Shims changed in crusher back to 6/2 as causing slow production. Crusher stood 08:00 - 13:00 having bearings replaced on main belt. 20t excav. operated undertaking stock maintenance and exposing larger O/S hard that requires processing (undertaken in task 1).
 - 07:00 - 18:00 : 25t excav. (Ian), 21t excav. (Chris), Sandvik Screener (UR) & 2 no gen. ops. (Joe & Mark), continuing with trial processing of landfill material. 20t excav. loading Sandvik screener with as-dug materials, 21t excav maintaining segregated stocks (Gen. waste, wood, scrap metal & fines with mixed waste) with gen op's. continually hand picking waste during work operations. Screened fines retained in processing area all other waste for off-site disposal/processing sent to site stocks. re-screening O/S hard generated 27/05, 3 no. times to reduce fines content as materials wet. Area cleared of O/S hard and tidied as per MS.
 - 07:00 - 18:00 : 30t ADT & 13t roller servicing above work operations as required. 23 no. (29t m3) loads of 6/2 from stock hauled to uplift/trimming works detailed in task 2, 6 no. (78 m3) loads of O/S hard taken from processing detailed in task 4 to segregated stock in eastern P.O.S.
 - 07:00 - 17:00 : tractor & Bowser used as dust suppression as required.


Rev	Date	Drawn	Description	Chk'd
-	-	-	Description	-
-	-	-	Description	-




Urban Regen
ESTABLISHED 2001

Urban Regen Ltd.,
Langley Road,
Pendlebury,
Salford,
M6 6FG
TEL :
email :

Client Eccleston Homes			
Site Mondi - Mill, Ramsbottom , BL0 OBS.			
Title MMP Daily Tracking Record 28/05/25			
Surveyed	IHB	Drawn	IHB
Chk.	IHB	Date	28/05/25
Scale	[A2 Sheet] CAD file		
1:500	Supplied planning layout.dxf		
Dwg No. MONDI-UR-V1-01-MMP-100			Rev A

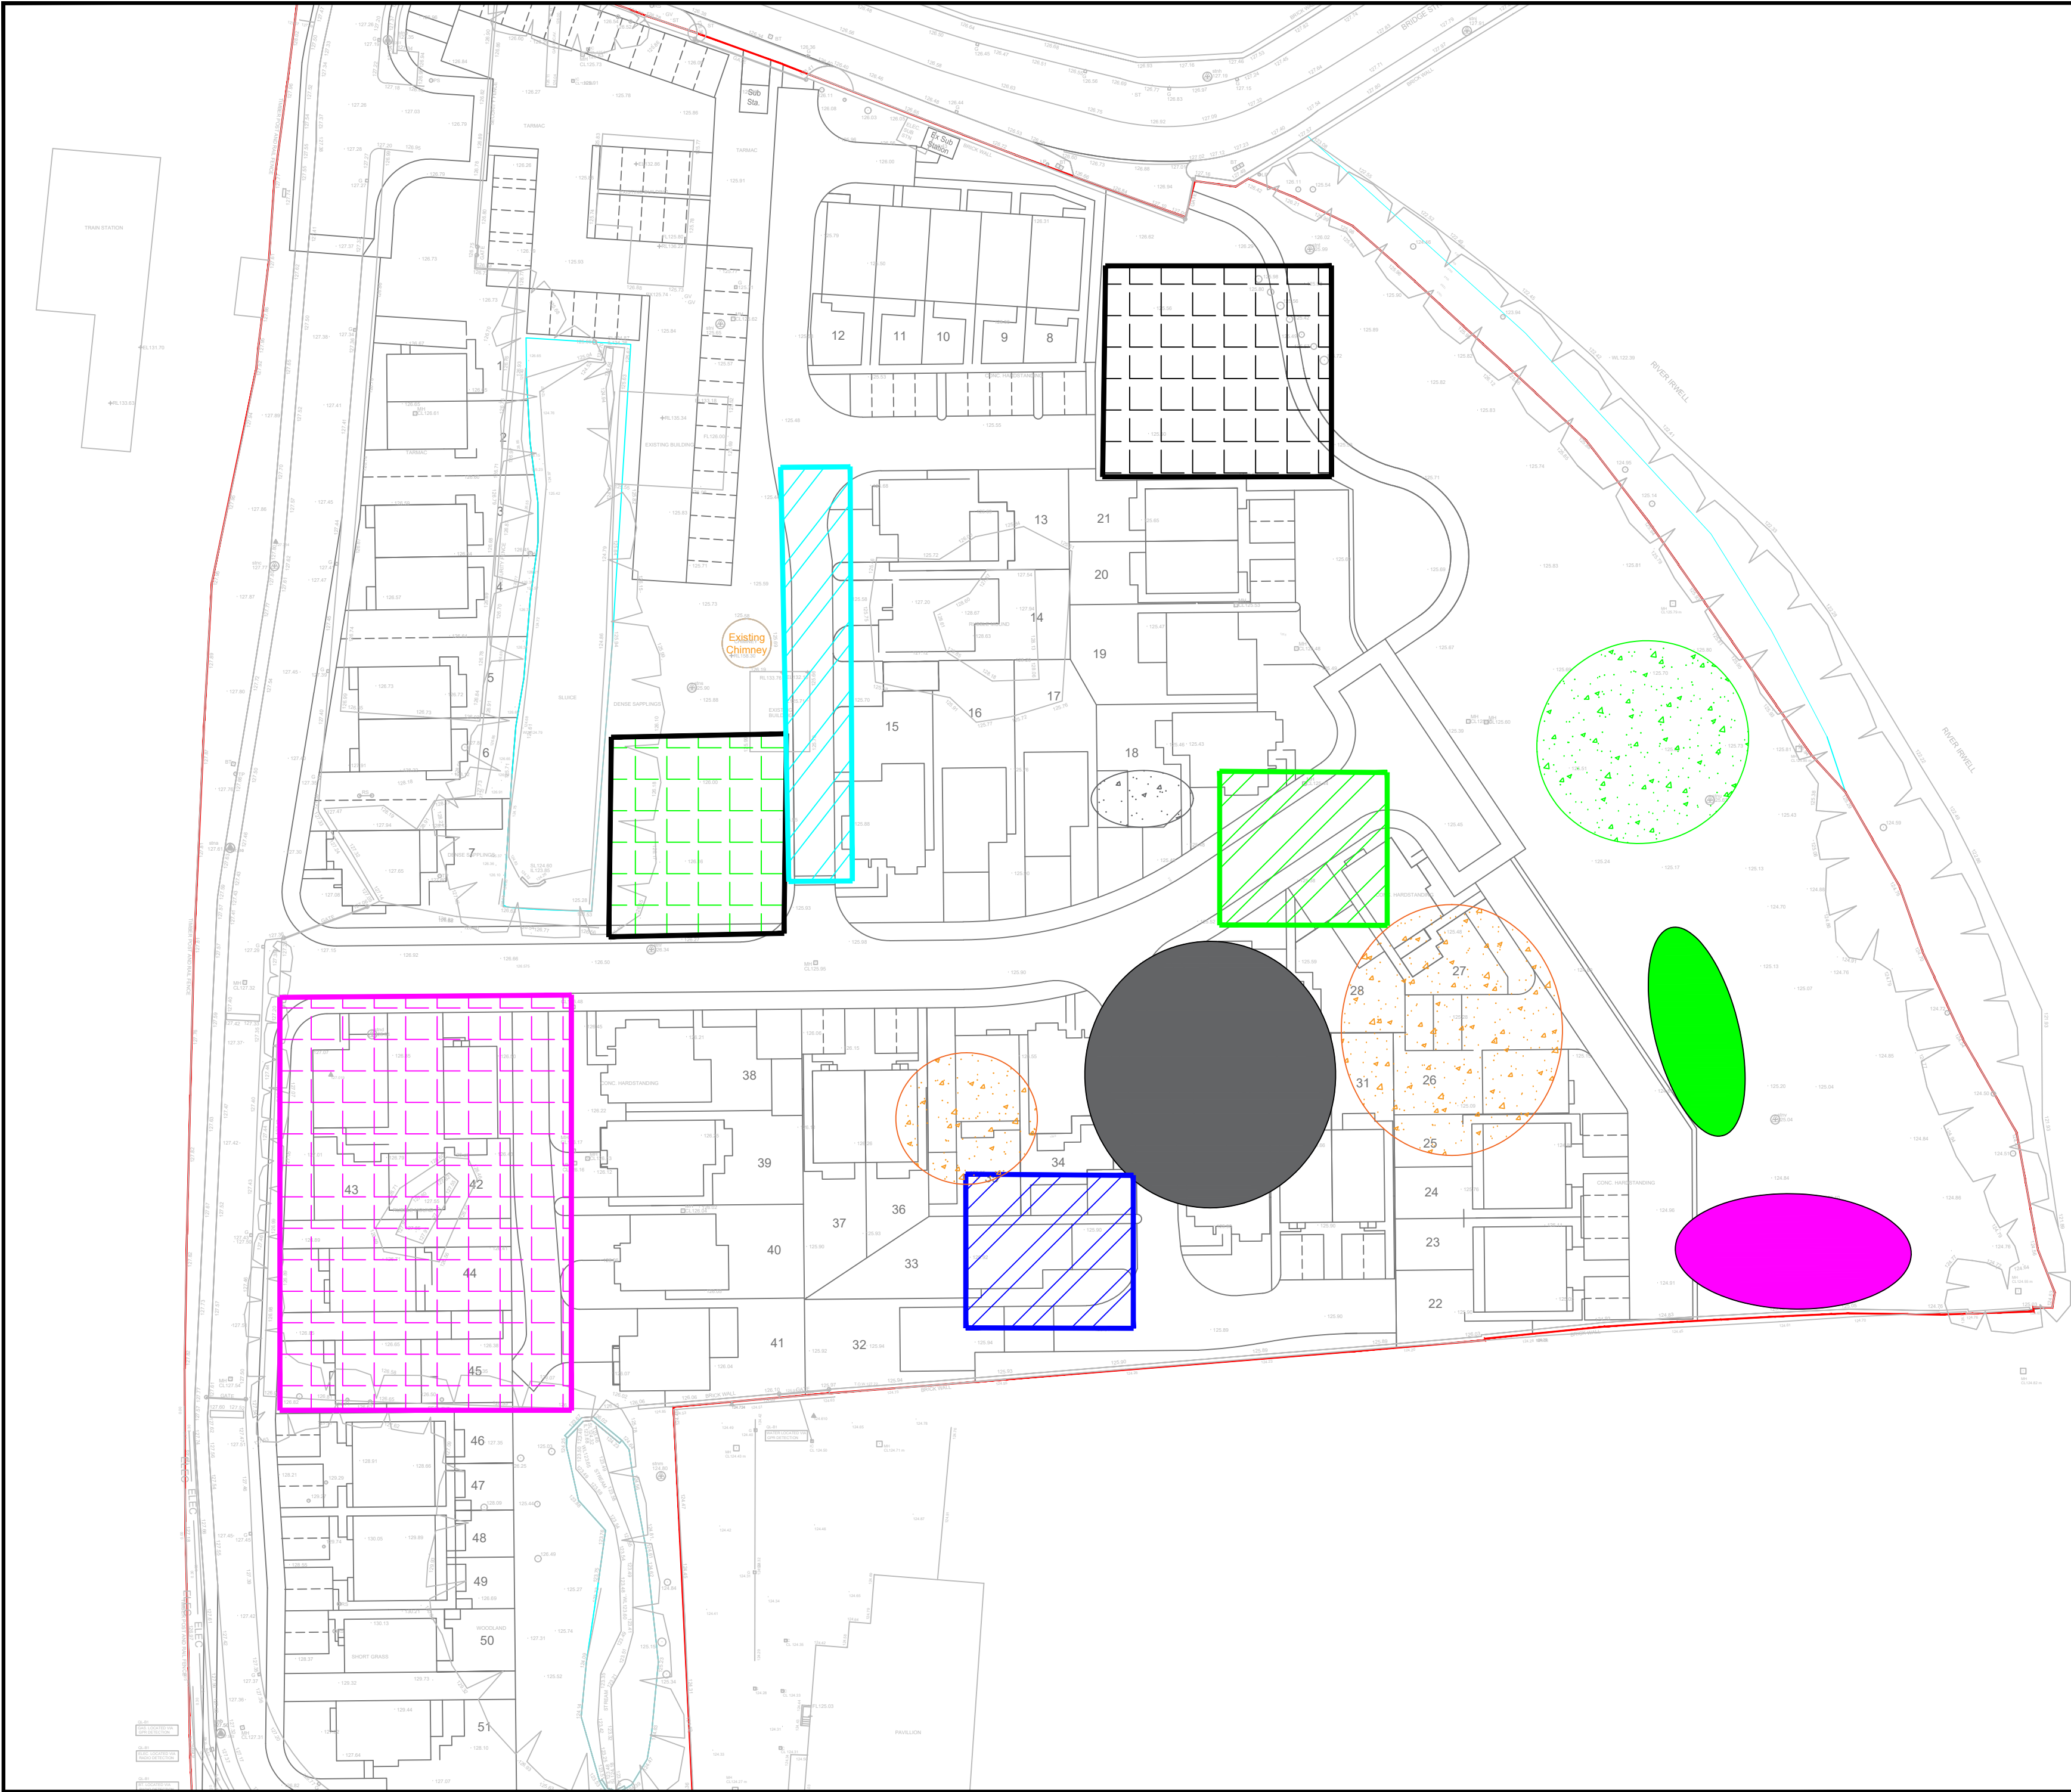

Notes
This drawing and the information contained therein is issued in confidence and is the copyright of Urban Regen Ltd. Disclosure of this information to Third Parties and unauthorised copying or replication of this data without approval is forbidden.

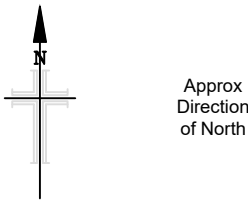

- Key:**
- Site boundary
 - Current compound location, Supplied by Eccleston Homes.
 - Off-site segregated stockpile locations.
 - Landfill material processing area
 - As-dug non-tip waste stockpile.
 - Oversize hard stock from surface/structure breakout.
 - Site Won Clean 6F2 Stockpile's
 - Screened fines from Area 5 & 6 capping material.
 - Site Won Clean MOT Trial Stockpile


- Works Undertaken:**
- 07:00 - 18:00 : 30t excav. (Rick) undertaking stockpile maintenance on O/S hard pile being crushed utilising hydraulic breaker & grab, resolving issues with crusher, moving steel out of processing area, clearing breakout undertaken 27 & 28/05/25 from below plots 38-41. Plant & Op. put on wet weather work as adverse weather scheduled.
 - 07:00 - 18:00 : 30t excav. (Carl) continuing with uplifting shared access in front of plots 12-15, getting ready for Handover to EH-LUR Civils due 28/05/25, 20t excav (Dan UR Civils) loading 30t ADT with 6f2 from stockpile in area 1, 6f2 laid in 150mm layers and compacted with 13t roller ensuring material dead rolled within 20m of existing chimney
 - 07:00 - 18:00 : 20t excav. (Dan) loading premiertrak 400 crusher (Casey's) with O/S hard from stock processing 6f2, 25t excav. (Ien) maintaining stock & loading 30t ADT as required. Approx. 1 hr lost in day as material jammed in jaws of crusher. Approx 400 m3 processed in shift.
 - 07:00 - 17:00 : 21t excav.(Chris) undertaking site tidying works/stockpile maintenance ramping off O/S hard from landfill processing works in eastern P.O.S and haymaking O/S hard to 20t excav. loading crusher in Task 3 including segregating O/S hard for Task 1.
 - 07:00 - 18:00 : 30t ADT & 13t roller servicing above work operations as required. 29 no. (377 m3) loads of 6f2 from stock hauled to uplift/trimming works detailed in task 2.
 - 07:00 - 17:00 : 2 no. gen. ops. undertaking litter pick on surface 6f2 laid 23-28/05/25 all waste collected and added to segregated piles ready for off-site disposal/processing.
 - 08:30 - 12:00 : Murray fix site technician on site to undertake CBR tests on capping laid to plots 1-7 on the 27 & 28, 3 no. undertaken 75,88 & 96 (Validation Grid references), results not looking good as perastant rain since 02:00, testing held off until 11:00 as rain scheduled to stop at 10:00 but continued until 13:00. Technician unable to provide approximate results on site. Provisionally booked testing for weds 04/06 dependant on results once received.
 - 07:00 - 17:00 : tractor & Bowser used as dust suppression as required.

Rev	Date	Drawn	Description	Chk'd
-	--/--/----	--	Description	--
-	--/--/----	--	Description	--




Urban Regen Ltd.,
Langley Road,
Pendlebury,
Salford,
M6 6FG
TEL :
email :

Client			
Eccleston Homes			
Site			
Mondi - Mill, Ramsbottom , BL0 OBS.			
Title			
MMP Daily Tracking Record 29/05/25			
Surveyed	IHB	Drawn	IHB
Chk.	IHB	Date	29/05/25
Scale	[A2 Sheet] CAD file		
1:500	Supplied planning layout.dxf		
Dwg No. MONDI-UR-V1-01-MMP-101			Rev A

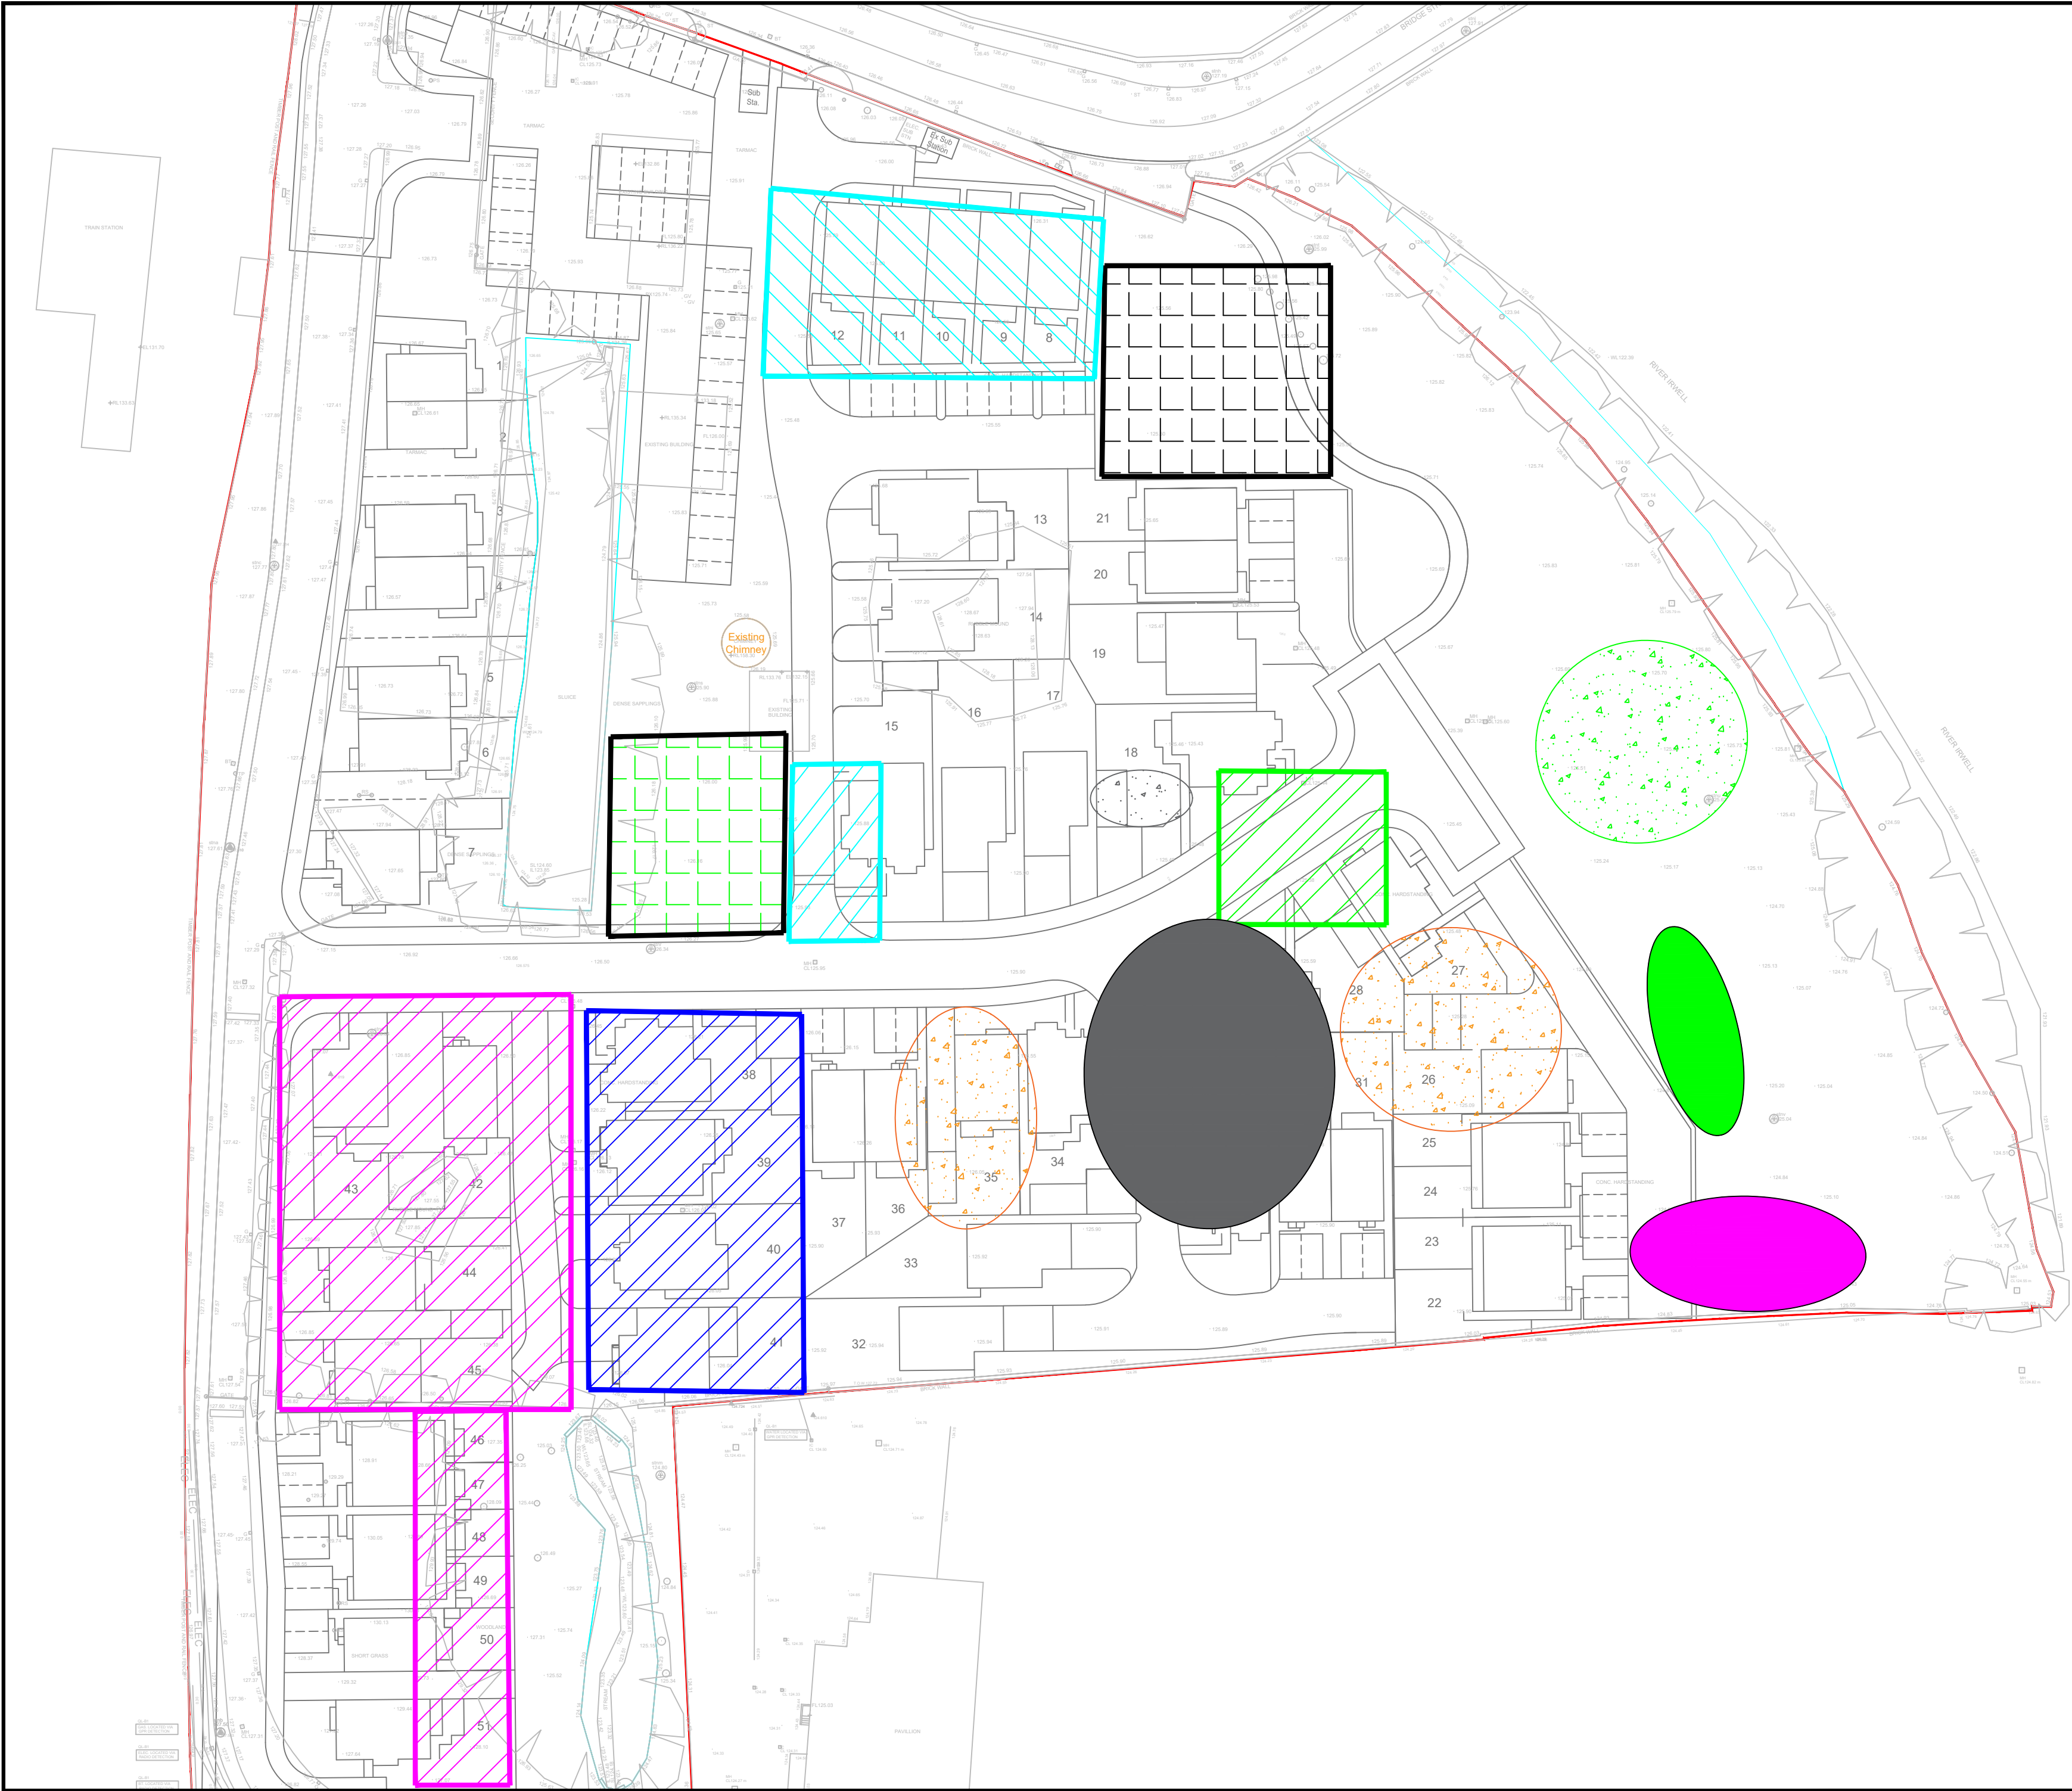

Notes
This drawing and the information contained therein is issued in confidence and is the copyright of Urban Regen Ltd. Disclosure of this information to Third Parties and unauthorised copying or replication of this data without approval is forbidden.

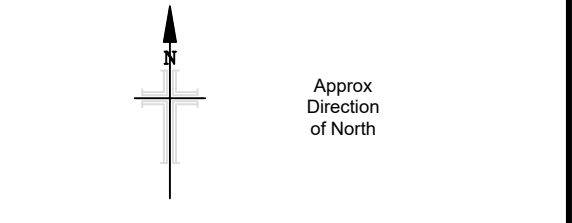

- Key:**
- Site boundary
 - Current compound location. Supplied by Eccleston Homes.
 - Off-site segregated stockpile locations.
 - Landfill material processing area
 - As-dug non-tip waste stockpile.
 - Oversize hard stock from surface/structure breakout.
 - Site Won Clean 6F2 Stockpile
 - Screened fines from Area 5 & 6 capping material.
 - Site Won Clean MOT Trial Stockpile

- Works Undertaken:**
- 07:00 - 17:00 : 30t excav. (Rick) continuing with Breakout & turnover works below plots 38-41. Removing all O/S hard materials encountered in excess of 150mm dia. . Piles encountered removed. where pile snaps, excavator chased down to 3.0 m from E.G.L's and recorded with excavator's GPS with base of dig points. Screening made ground encountered to remove all O/S taken directly to crushing operation in 30t ADT
 - 07:00 - 13:00 : 30t excav. (Carl) creating new site access off Bridge street , extending temp carpark on pile mats of plots 8-12 to allow more than 6 cars to park with 3 no. loads of 6F2 from stockpile, amending fill area, ramping off and creating new laydown area for off-site material & plant park on plots 15-17 approx. Operator left site at 13:00 due to scheduled medical appointment.
 - 07:00 - 17:00 : 20t excav. (Dan) loading premiertrak 400 crusher (Casey's) with O/S hard from stock processing 6F2, 22t excav. (Dan - Ur civils) maintaining stock & loading 30t ADT as required. Slow working as material heavy on fines causing crusher to keep jamming approx. 2 hrs. lost in day. Approx. 300 m3 6F2 processed in shift. 22t excav. left site at 14:30 due to scheduled medical appointment.
 - 07:00 - 17:00 : 25t excav. (Ian) & 21t excav. (Chris) amending processing area. former site access gates permanently closed allowing area to be increased. Haymaking processed fire/ign. waste to increase available processing/stockpiling area and forming temp haul rd. over area 5 to access area 6 on opposite side of R.C.C access rd. Temp haul rd. made from O/S hard retrieved from processing temporarily stockpiled in eastern P.O.S with 30t ADT. 14:30 25t excav. taking over from 22t excav. in Task 3.
 - 07:00 - 17:00 : 30t ADT & 13t roller servicing above work operations as required. 3 no. (30 m3) loads of 6F2 from stock hauled to upthinning works detailed in task 2. 4 no. O/S hard from screening works detailed in Task 1 and 12 no. loads of O/S hard from eastern P.O.S to area 5 as detailed in Task 4.
 - 07:00 - 17:00 : tractor & Bowser used as dust suppression as required.

Rev	Date	Drawn	Description	Chk'd
-	--/--/----	--	Description	--
-	--/--/----	--	Description	--




Urban Regen Ltd.,
Langley Road,
Pendlebury,
Salford,
M6 6FG
TEL :
email :

Client			
Eccleston Homes			
Site			
Mondi - Mill, Ramsbottom , BL0 OBS.			
Title			
MMP Daily Tracking Record 30/05/25			
Surveyed	IHB	Drawn	IHB
Chk.	IHB	Date	30/05/25
Scale	[A2 Sheet] CAD file		
1:500	Supplied planning layout.dxf		
Dwg No. MONDI-UR-V1-01-MMP-102			Rev A



Notes
This drawing and the information contained therein is issued in confidence and is the copyright of Urban Regen Ltd. Disclosure of this information to Third Parties and unauthorised copying or replication of this data without approval is forbidden.

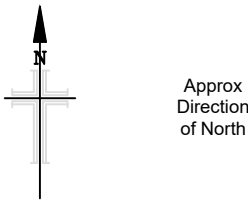

- Key:**
- Site boundary
 - Current compound location, Supplied by Eccleston Homes.
 - Off-site segregated stockpile locations.
 - Landfill material processing area
 - As-dug non-tip waste stockpile.
 - Oversize hard stock from surface/structure breakout.
 - Oversize hard stock from Landfill Processing area
 - Site Won Clean 6F2 Stockpile
 - Screened fines from Area 5 & 6 capping material.
 - Site Won Clean MOT Trial Stockpile

- Works Undertaken:**
- 07:00 - 13:00 : 2 x 30t excav.s (Rick & Lewis) continuing with turnover & screening works below plots 38-41, removing O/S hard and laying and compacting fines into fill area generated, material compacted in 300mm layers with 13t roller.
 - 07:00 - 13:00 : 20t excav. (Dan) loading premietrak 400 crusher (Casey's) with O/S hard from stock processing 3/2, 22t excav. (Iain) maintaining stock & loading 30t ADT as required. Approx. 2 hr lost in day as re-bar started nesting in crusher causing processing to stop and re-bar to be cleared.
 - 07:00 - 13:00 : 30t ADT & 13t roller servicing above work operations as required. 6 no. (78 m3) O/S hard from screening works detailed in Task 1 and compacting fill placed as detailed in Task 1.

Rev	Date	Drawn	Description	Chk'd
-	-	-	Description	-
-	-	-	Description	-




Urban Regen Ltd.,
Langley Road,
Pendlebury,
Salford,
M6 6FG
TEL :
email :

Client				Eccleston Homes
Site				Mondi - Mill, Ramsbottom , BL0 0BS.
Title				MMP Daily Tracking Record 31/05/25
Surveyed	IHB		Drawn	IHB
Chk.	IHB		Date	31/05/25
Scale	[A2 Sheet]	CAD file		
1:500	Supplied planning layout.dxf			
Dwg No.			MONDI-UR-V1-01-MMP-103	Rev A



Notes
This drawing and the information contained therein is issued in confidence and is the copyright of Urban Regen Ltd. Disclosure of this information to Third Parties and unauthorised copying or replication of this data without approval is forbidden.

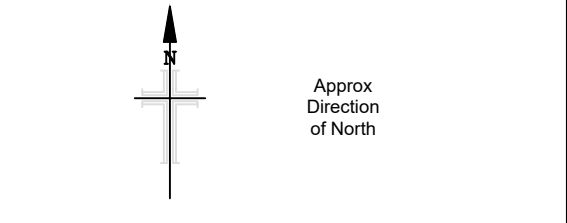

- Key:**
- Site boundary
 - Current compound location, Supplied by Eccleston Homes.
 - Off-site segregated stockpile locations.
 - Landfill material processing area
 - As-dug non-tip waste stockpile.
 - Oversize hard stock from surface/structure breakout.
 - Site Won Clean 6F2 Stockpile
 - Screened fines from Area 5 & 6 capping material.
 - Site Won Clean MOT Trial Stockpile

- Works Undertaken:**
- 07:00 - 18:30 : 2 x 30t excav. (Rick & Chris) continuing with Breakout & turnover works below plots 38-41. Removing all O/S hard materials encountered in excess of 150mm dia. Piles encountered removed, where pile snaps, excavator chased down to 3.0 m from E.G.L's and recorded with excavator's GPS with base of dig points. Screening made ground encountered to remove all O/S taken directly to crushing operation in 30t ADT. C. Table left at 17:00 as arranged with R.Perry.
 - 07:00 - 18:00 : 20t excav. (Dan) loading premiertrak 400 crusher (Casey's) with O/S hard from stock processing 02, 21t excav. (Chris) maintaining stock. Slow working as material heavy on fines.
 - 07:00 - 18:00 : 28t excav. (Ian) heymaking and stockpiling non tip material in area 6 in preparation of hauling to processing area in area 4 until 13:00, 13:30 -16:00 hauling non tip material from area 6 with ADT and stockpiling in area 4 in preparation of continuing with processing former landfill material on the 03/06/25. 16:00-18:00 hauling works stopped due to number of vehicles requiring access to R.C.C. All stockpiles sealed at end of shift to protect from adverse weather scheduled overnight. 2 no. gen. sps. (Joe & Mark) undertaking litter pick of area 5 and banking access rd. during hauling from area 6.
 - 07:00 - 17:00 : 30t ADT & 13t roller servicing above work operations as required. , 15 no. (195 m3) O/S hard from screening works detailed in Task 1 and 12 no. (104 m3) loads of O/S hard taken from task 1 to crushing op. in task 2.

Rev	Date	Drawn	Description	Chk'd
-	--/--/----	--	Description	--
-	--/--/----	--	Description	--



Urban Regen Ltd.,
Langley Road,
Pendlebury,
Salford,
M6 6FG
TEL :
email :

Client			
Eccleston Homes			
Site			
Mondi - Mill, Ramsbottom , BL0 0BS.			
Title			
MMP Daily Tracking Record 02/06/25			
Surveyed	IHB	Drawn	IHB
Chk.	IHB	Date	02/06/25
Scale	[A2 Sheet] CAD file		
1:500	Supplied planning layout.dxf		
Dwg No.	MONDI-UR-V1-01-MMP-104		Rev
		A	