




PROPOSED FRONT ELEVATION

Double frosted
glass window
2100mmx550mm

3way Bi-folding door 2400mm
PROPOSED REAR ELEVATION

Window
550mmx2000mm

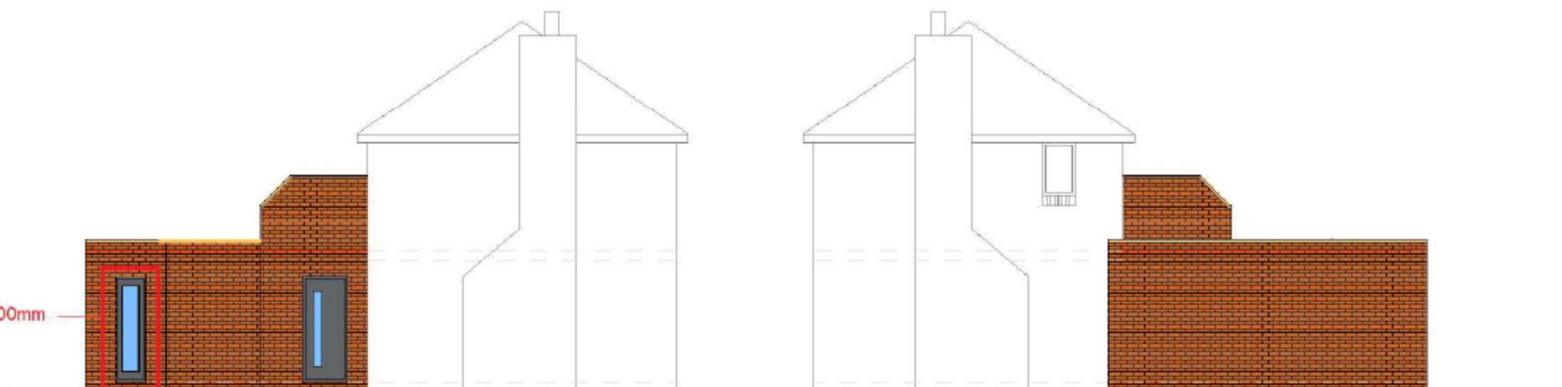

Window
550mmx2000mm

PROPOSED SIDE ELEVATION

PROPOSED SIDE ELEVATION

Notes

THESE DRAWINGS ARE TO BE READ IN CONJUNCTION WITH ALL RELEVANT AND ARCHITECTS, SERVICE ENGINEERS AND SUBCONTRACTOR DRAWINGS.

REVIEW ALL DRAWINGS AND REPORT ANY DISCREPANCIES TO AND DESIGN PRIOR TO COMMENCEMENT.

DO NOT SCALE FROM THIS DRAWING. ALL DIMENSIONS AND LEVELS INCLUDING RISE AND FALL TO EXISTING STRUCTURES TO BE CHECKED ON SITE PRIOR TO COMMENCEMENT.

WORK FROM FINISHED DIMENSIONS ONLY. DO NOT SCALE FROM THIS DRAWING.

ALL DIMENSIONS IN MILLIMETRES AND LEVELS IN METRES, TO BE CHECKED ON SITE.

NO ORIENTATION FROM DETAILS SHOWN ON THESE DRAWINGS IS ALLOWED WITHOUT AND DESIGN PRIOR PERMISSION IN WRITING.

ALL WORK IS TO BE COMPLETED IN ACCORDANCE WITH THE RELEVANT SPECIFICATIONS ISSUED BY AND DESIGN, BRITISH STANDARD CODES OF PRACTICE, STATUTORY REQUIREMENTS AND THE CONTRACT DOCUMENTS.

S1	BOULES FOR PLANNING	AC	25.01.19	
No.	Revised	Date	Rev	Date

Client

5 INGLEWOOD CLOSE

PROPOSED ELEVATIONS

Drawn by	Scale	Checked by	Date
----------	-------	------------	------

AD A/10/10 25.01.19

Technical ☐ Tender ☐ Contract ☐ As Built ☐

Drawing Number Revision

04

51