


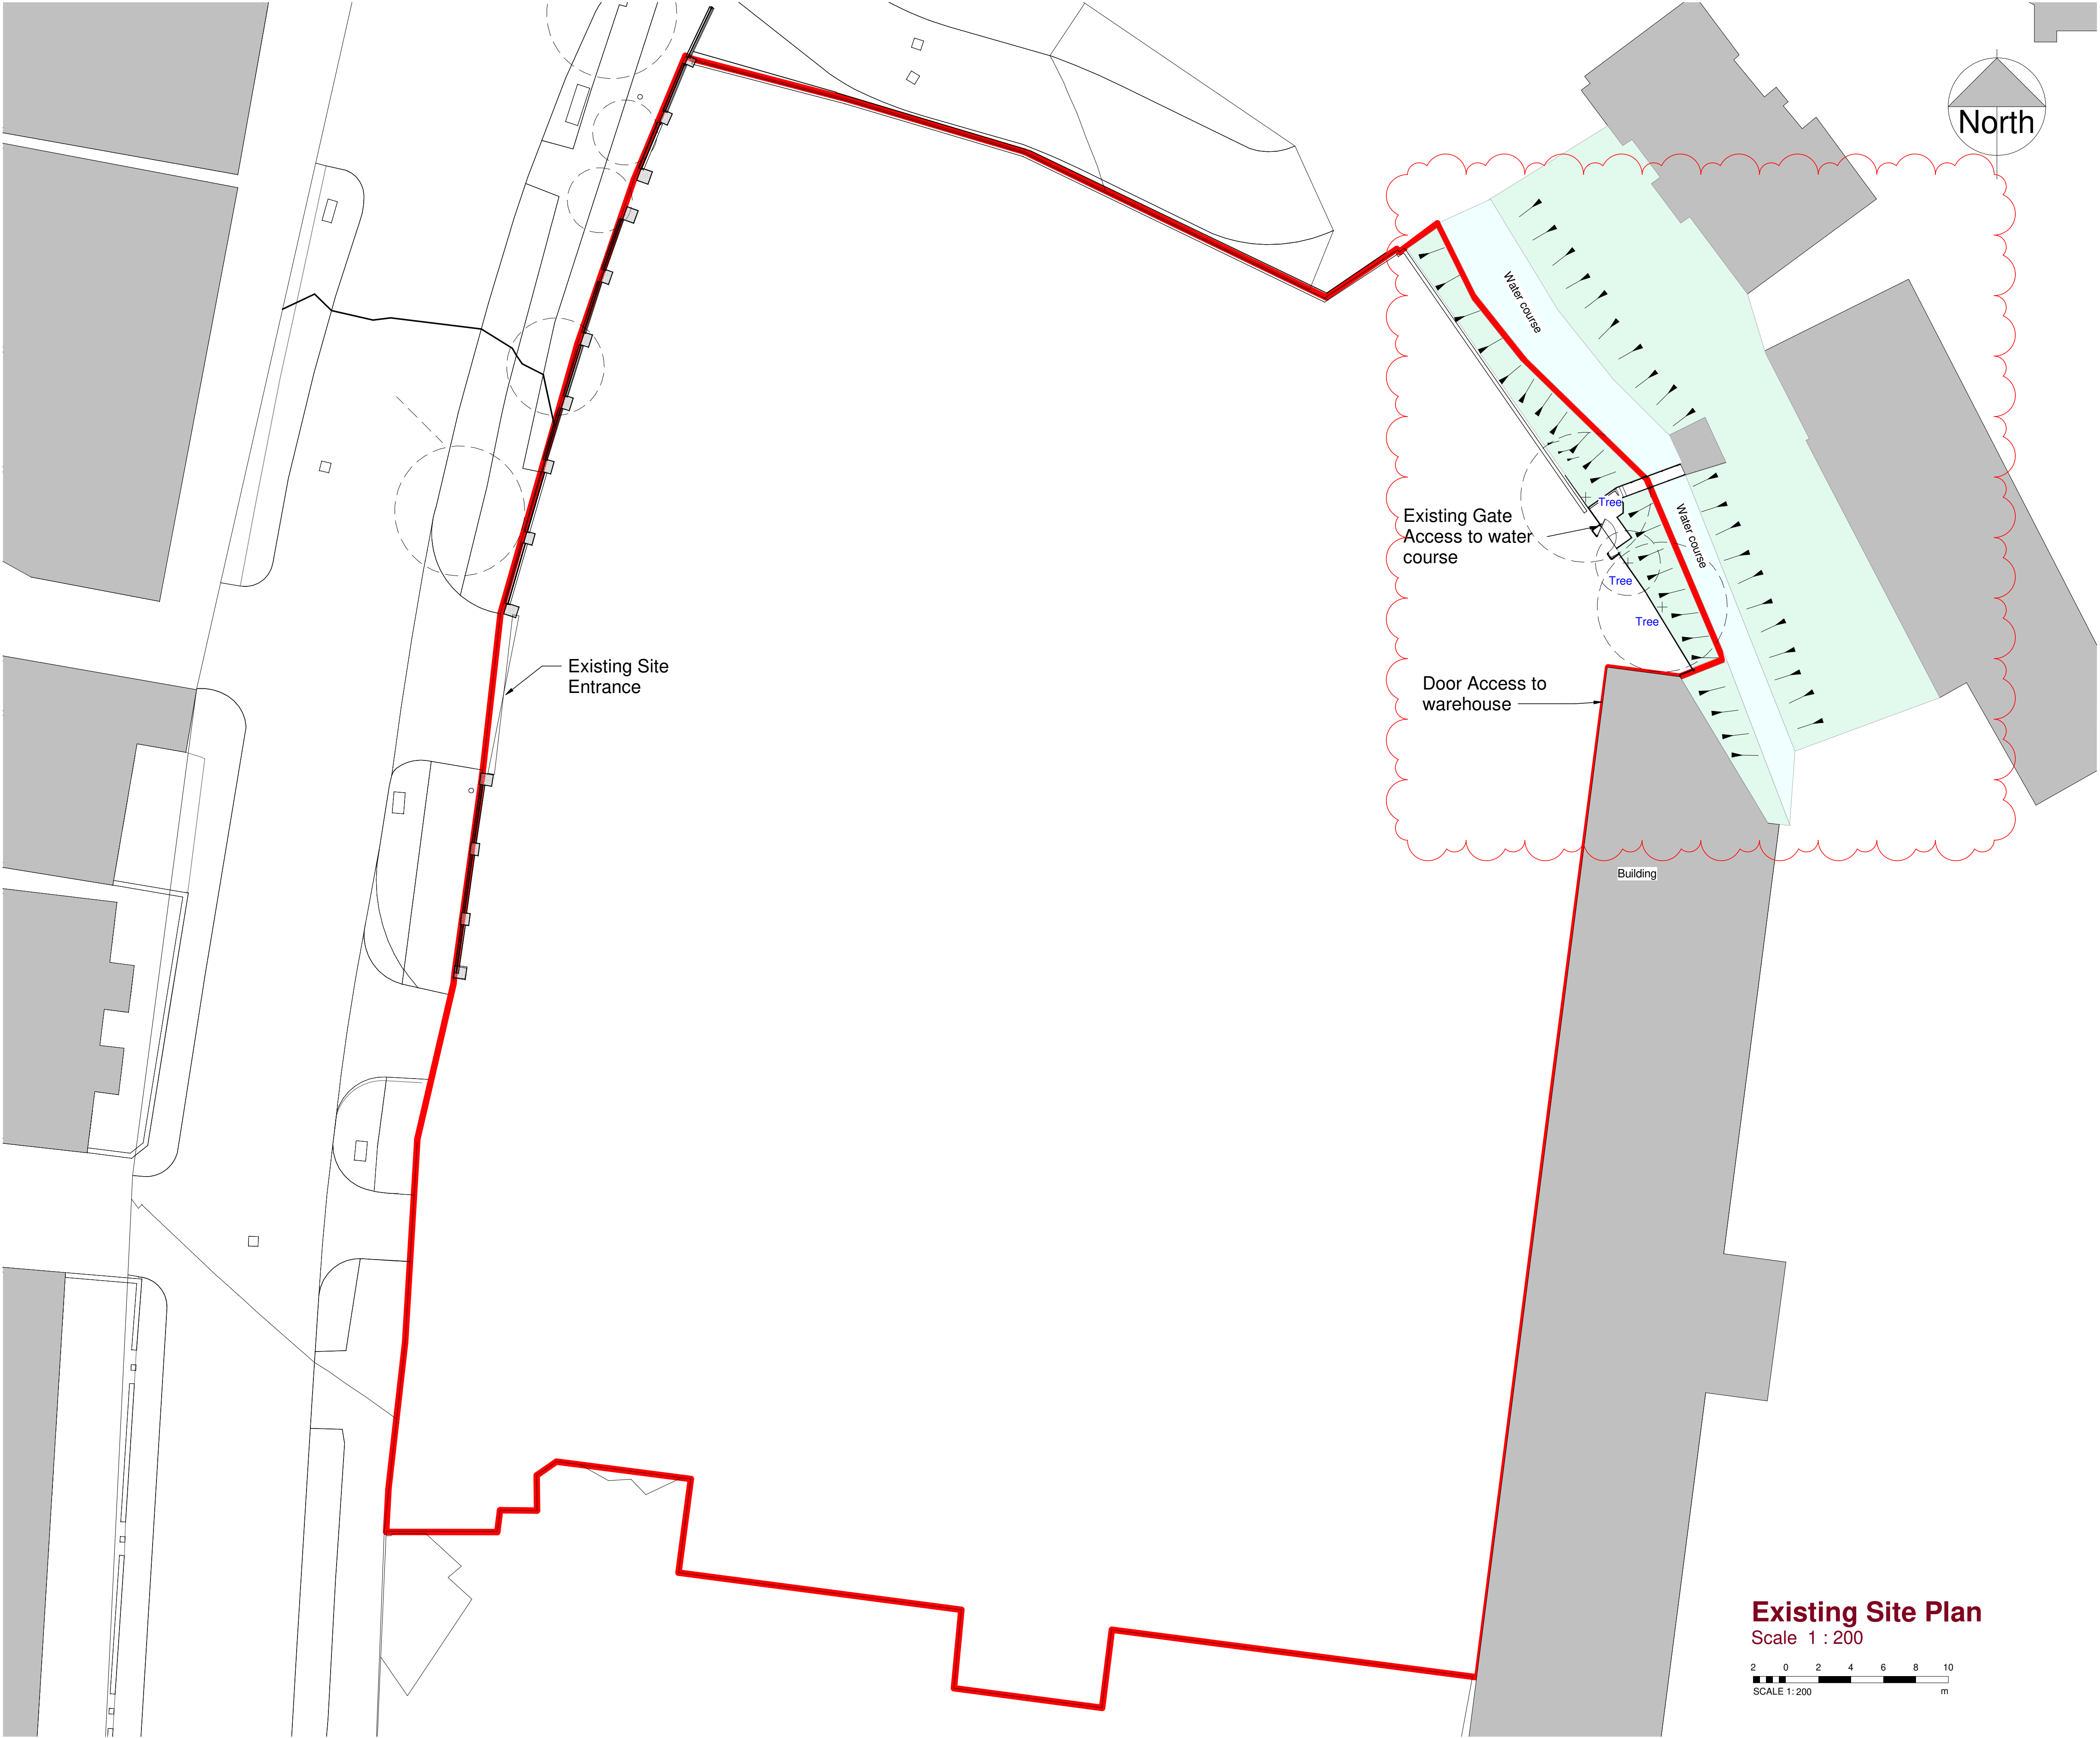

© This Drawing & Design is the copyright of Jenkins Design Services Ltd and should not be reproduced without written consent.

Contractors are to check all levels & dimensions on site prior to site works commencing & report discrepancies to the Designers.

DO NOT SCALE FROM THIS DRAWING

PLANNING

NOTES:-

Site area Demise denoted with red line equates to:-
5,878m² / 63,270 ft² / 0.5878 Hectares / 1.452 Acres

B	Existing brook gate access added to existing site plan.	AL	TR	04.07.23
A	Site boundary adapted in line with Title Plan GM685098	CM	TR	24.02.21
Rev	Description	By	Chk	Date
Project: Station works Bury Road, Radcliffe, M26 2UA				
Title: Existing Site Plan				
Client: Paul Cook Developments/ Jigsaw Homes				
Drawn By:	NM	Checked By:	BJ	on 04.07.23
Original Size:	A1	Project Number:	22049	
Drawing Number:	SI-00-DR-A-0801	REV	B	

