



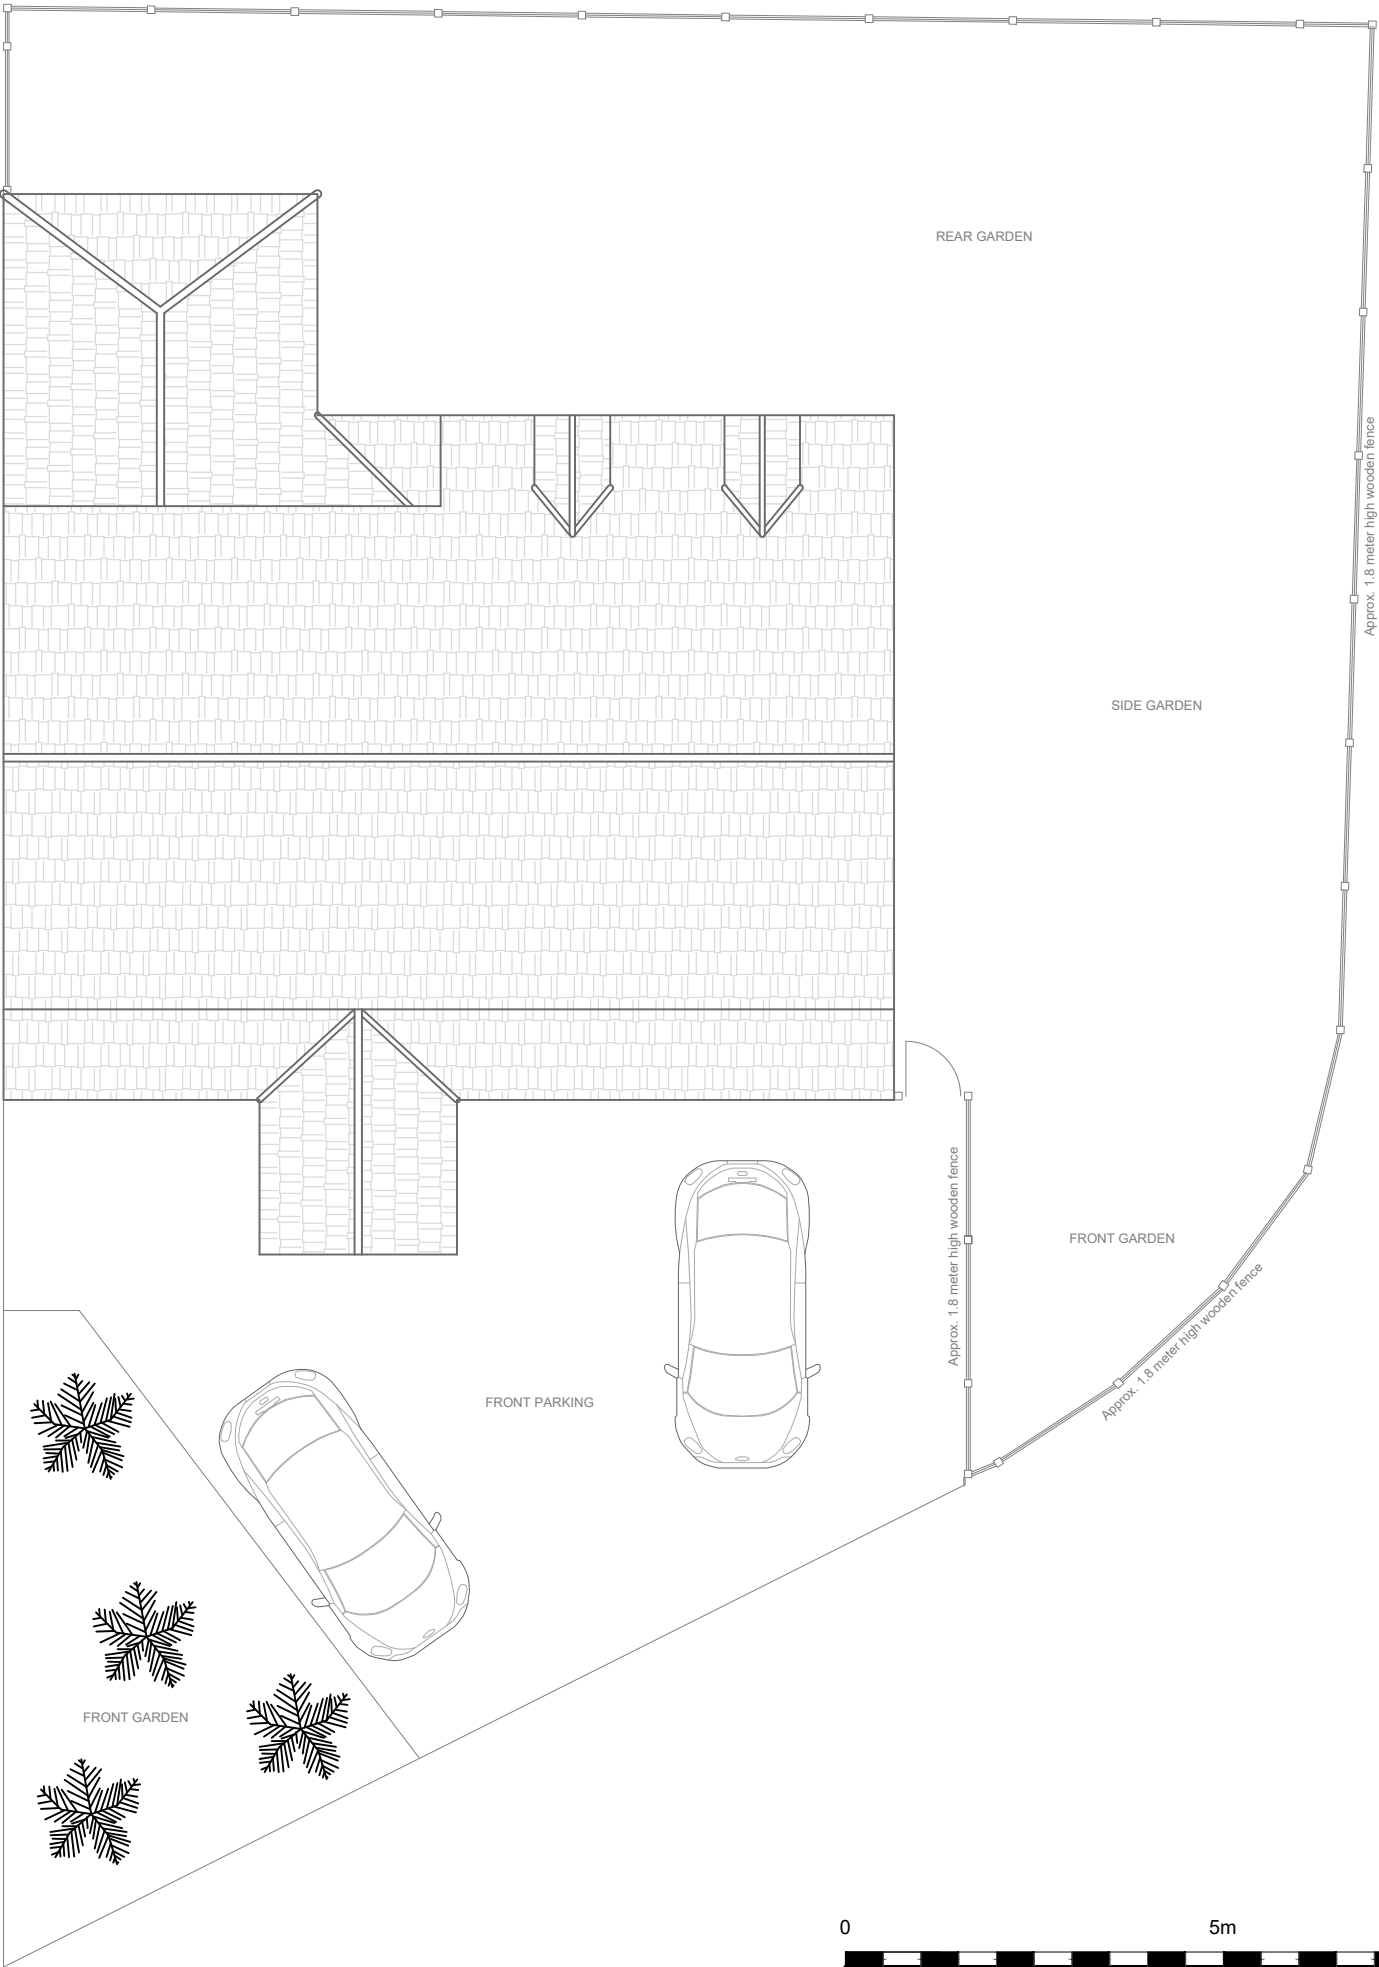

AS-BUILT SITE PLAN

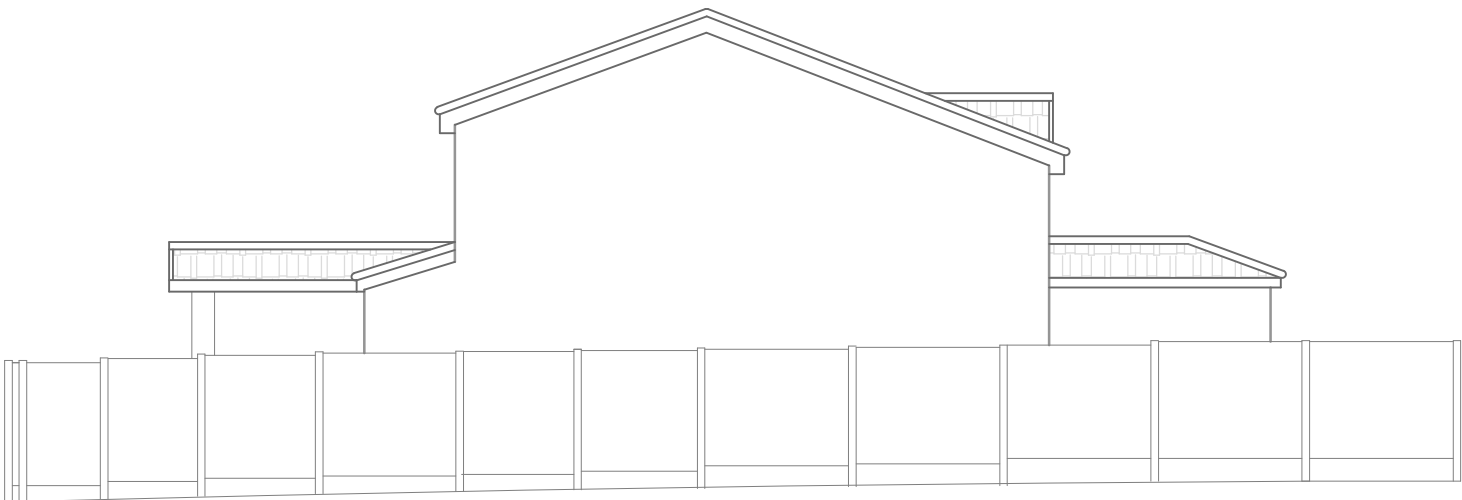

EXISTING SIDE ELEVATION Incl. BOUNDARY (EAST)

This drawing is the property of IPS Architects and copyright is reserved by them.
This drawing is not to be copied or disclosed by or to any unauthorized person without the prior written consent of IPS Architects.


Do not scale from this drawing.

All dimensions are to be checked on site prior to construction, manufacture of any components and ordering of materials and equipment.

Any discrepancies are to be reported to the architects for clarification.

All materials and workmanship to be accordance with the current British Standards and codes of practice.

This drawing is to be read in conjunction with all relevant Architectural Structural Engineers, Mechanical Engineers, Electrical Engineers and Specialists drawings and specifications.

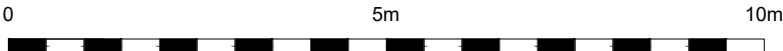

I Planning Services email: ipsuk@live.co.uk	2A Cook Street, Bury, Lancashire, BL9 0RP, 0161 8717405	As-Built Site plan and Elevation of 17 Bloomfeild Drive, Bury, BL9 8JX		Scale :1 : 100 on A3	All Dimensions in Meters	REV: A Date: 22/05/2024
		Ref:: IPS/R/17/BL98JX		Date : 16/04/2024	SHT 2a of 3	As-Built