



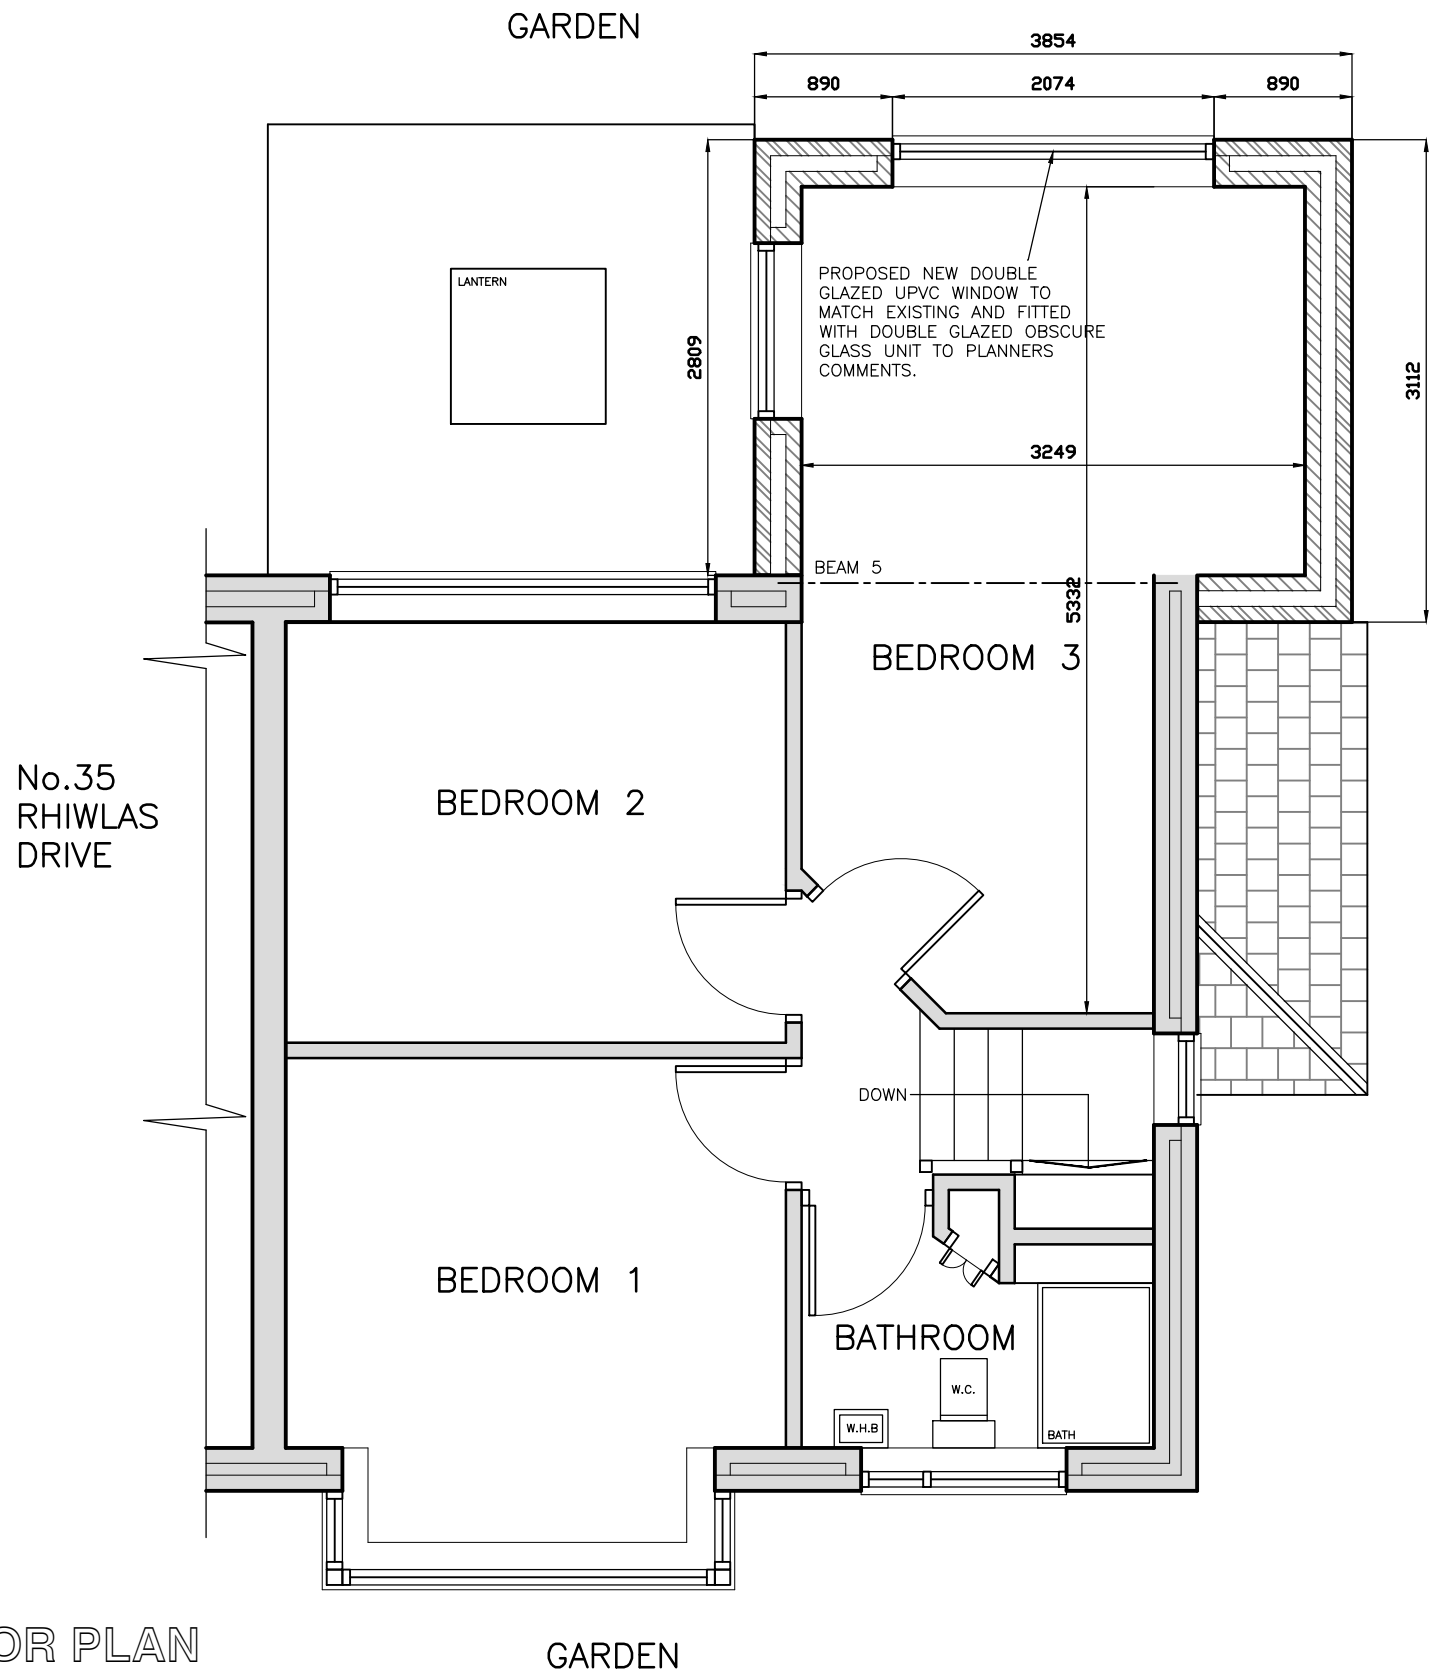

PROPOSED FIRST FLOOR PLAN

PROPOSED:

COPYRIGHT RESERVED
This drawing is the property of Phil Corns Architectural Services Ltd. and must not be copied or used in whole or in part without their consent.
C.D.M.
Client and contractors working on projects lasting more than 30 days or involving more than 500 persons must fulfill their duties under the CDM Regulations 2015.
THIS DRAWING (OR ANY PART THEREOF) MAY NOT BE COPIED, TRANSMITTED OR DISCLOSED TO ANY THIRD PARTY OR UNAUTHORIZED PERSON WITHOUT THE PRIOR WRITTEN PERMISSION OF PHIL CORNS ARCHITECTURAL SERVICES LTD. THIS DRAWING IS TO BE READ IN CONJUNCTION WITH ALL OTHER RELEVANT DRAWINGS PREPARED BY CONSULTANTS AND SUB-CONTRACTORS. DO NOT SCALE FROM THIS DRAWING. WORK ONLY TO PRINTED DIMENSIONS. REPORT ANY DISCREPANCIES TO PHIL CORNS ARCHITECTURAL SERVICES LTD OR REPRESENTATIVES THEREOF.
ONCE PRINTED AND DISTRIBUTED THIS DOCUMENT IS ASSUMED UNCONTROLLED.
ALL DIMENSIONS AND LEVELS ARE TO BE CHECKED ON SITE.

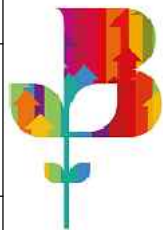

Greater Manchester
Chamber of Commerce
Member of Chamber of the Year
2017/18



A SEPT.22 WINDOW TO BEDROOM 3 AMENDED TO
OBSCURE GLAZING TO PLANNERS COMMENTS

PAC

revision	description			PHIL CORNS ARCHITECTURAL SERVICES Ltd. 142 ELMSFIELD AVENUE NORDEN, ROCHEDALE OL11 5XA TEL:01706 564197 MOB:07594 214758 email:phil@philcornsarchitecturalservices.co.uk	
STATUS	Information ☒	Comment ☐	Approval ☐	CAS	
	Tender ☐	Construction ☐	As-Built ☐		
PROJECT NUMBER	2022_04_05	SCALE	1:50	ORIGINAL DRG. SHEET SIZE	A3
DRAWN BY	PAC	CHECKED BY	-	DATE	APR.22
DRAWING NUMBER				REV.	DRAWING
2022_04_05 - 06				A	PROPOSED: FIRST FLOOR PLAN