


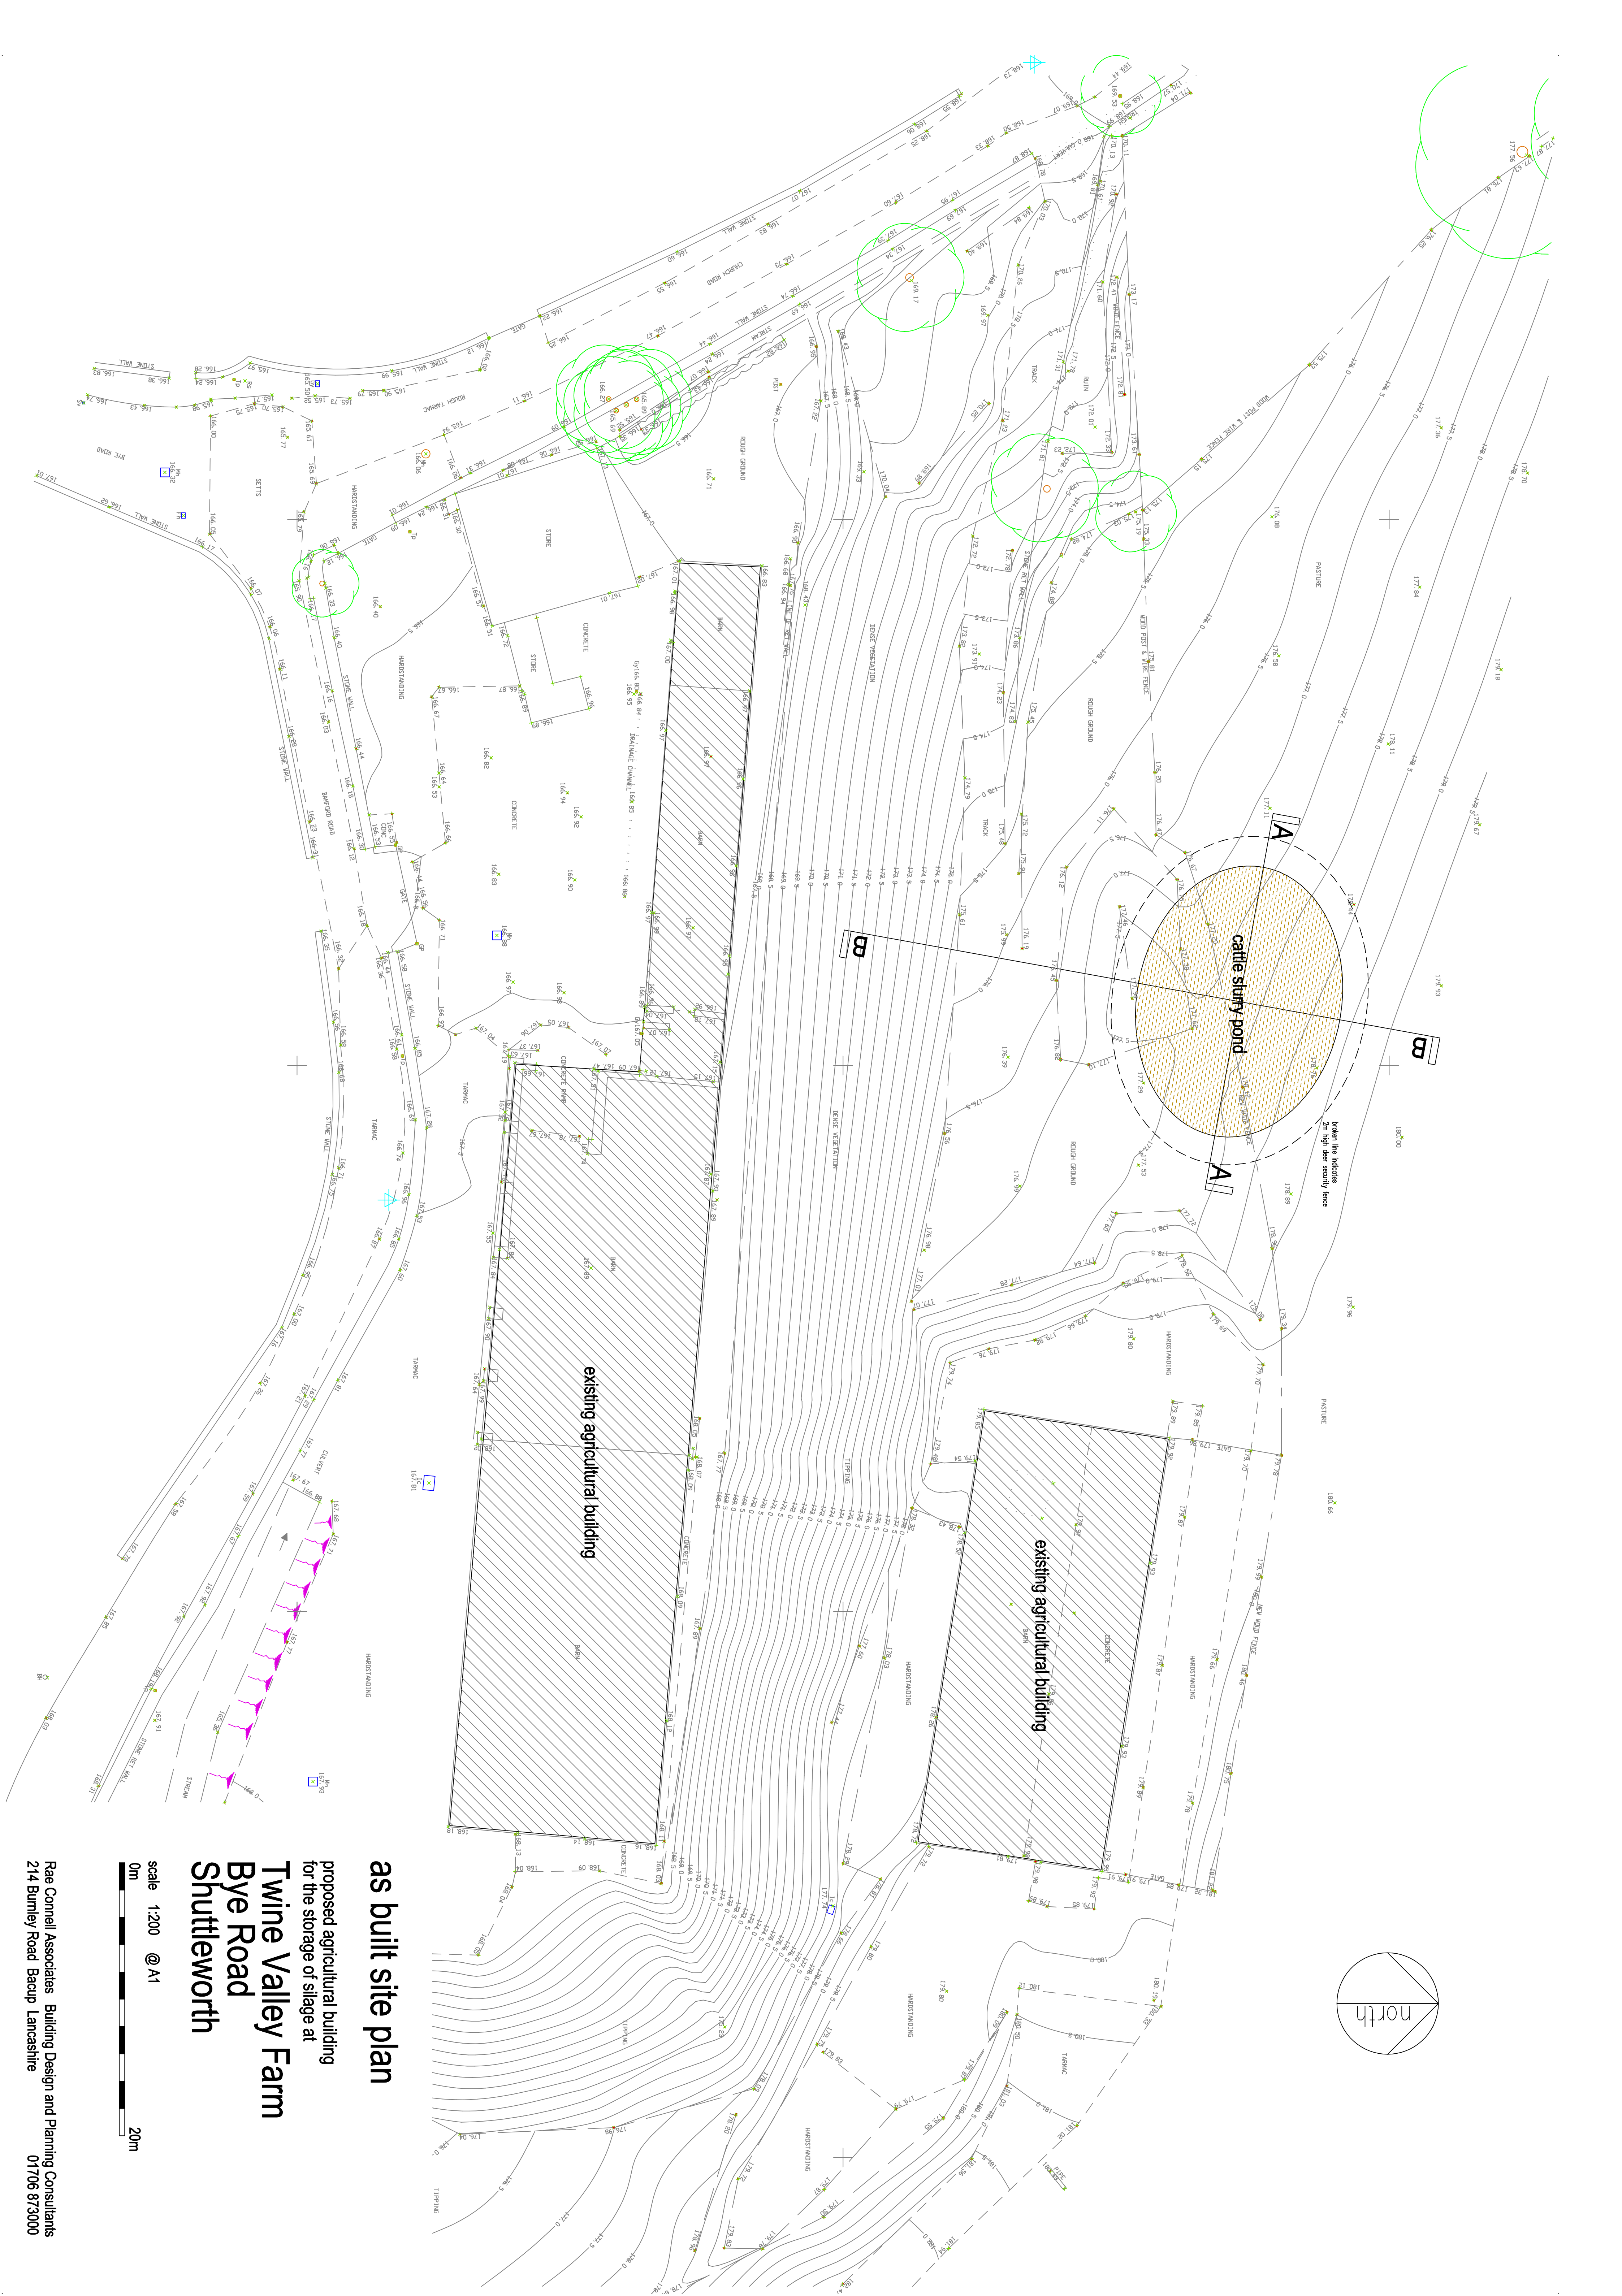

as built site plan

proposed agricultural building
for the storage of silage at

Twine Valley Farm

Bye Road

Shuttleworth

scale 1:200 @ A1

0m 20m