




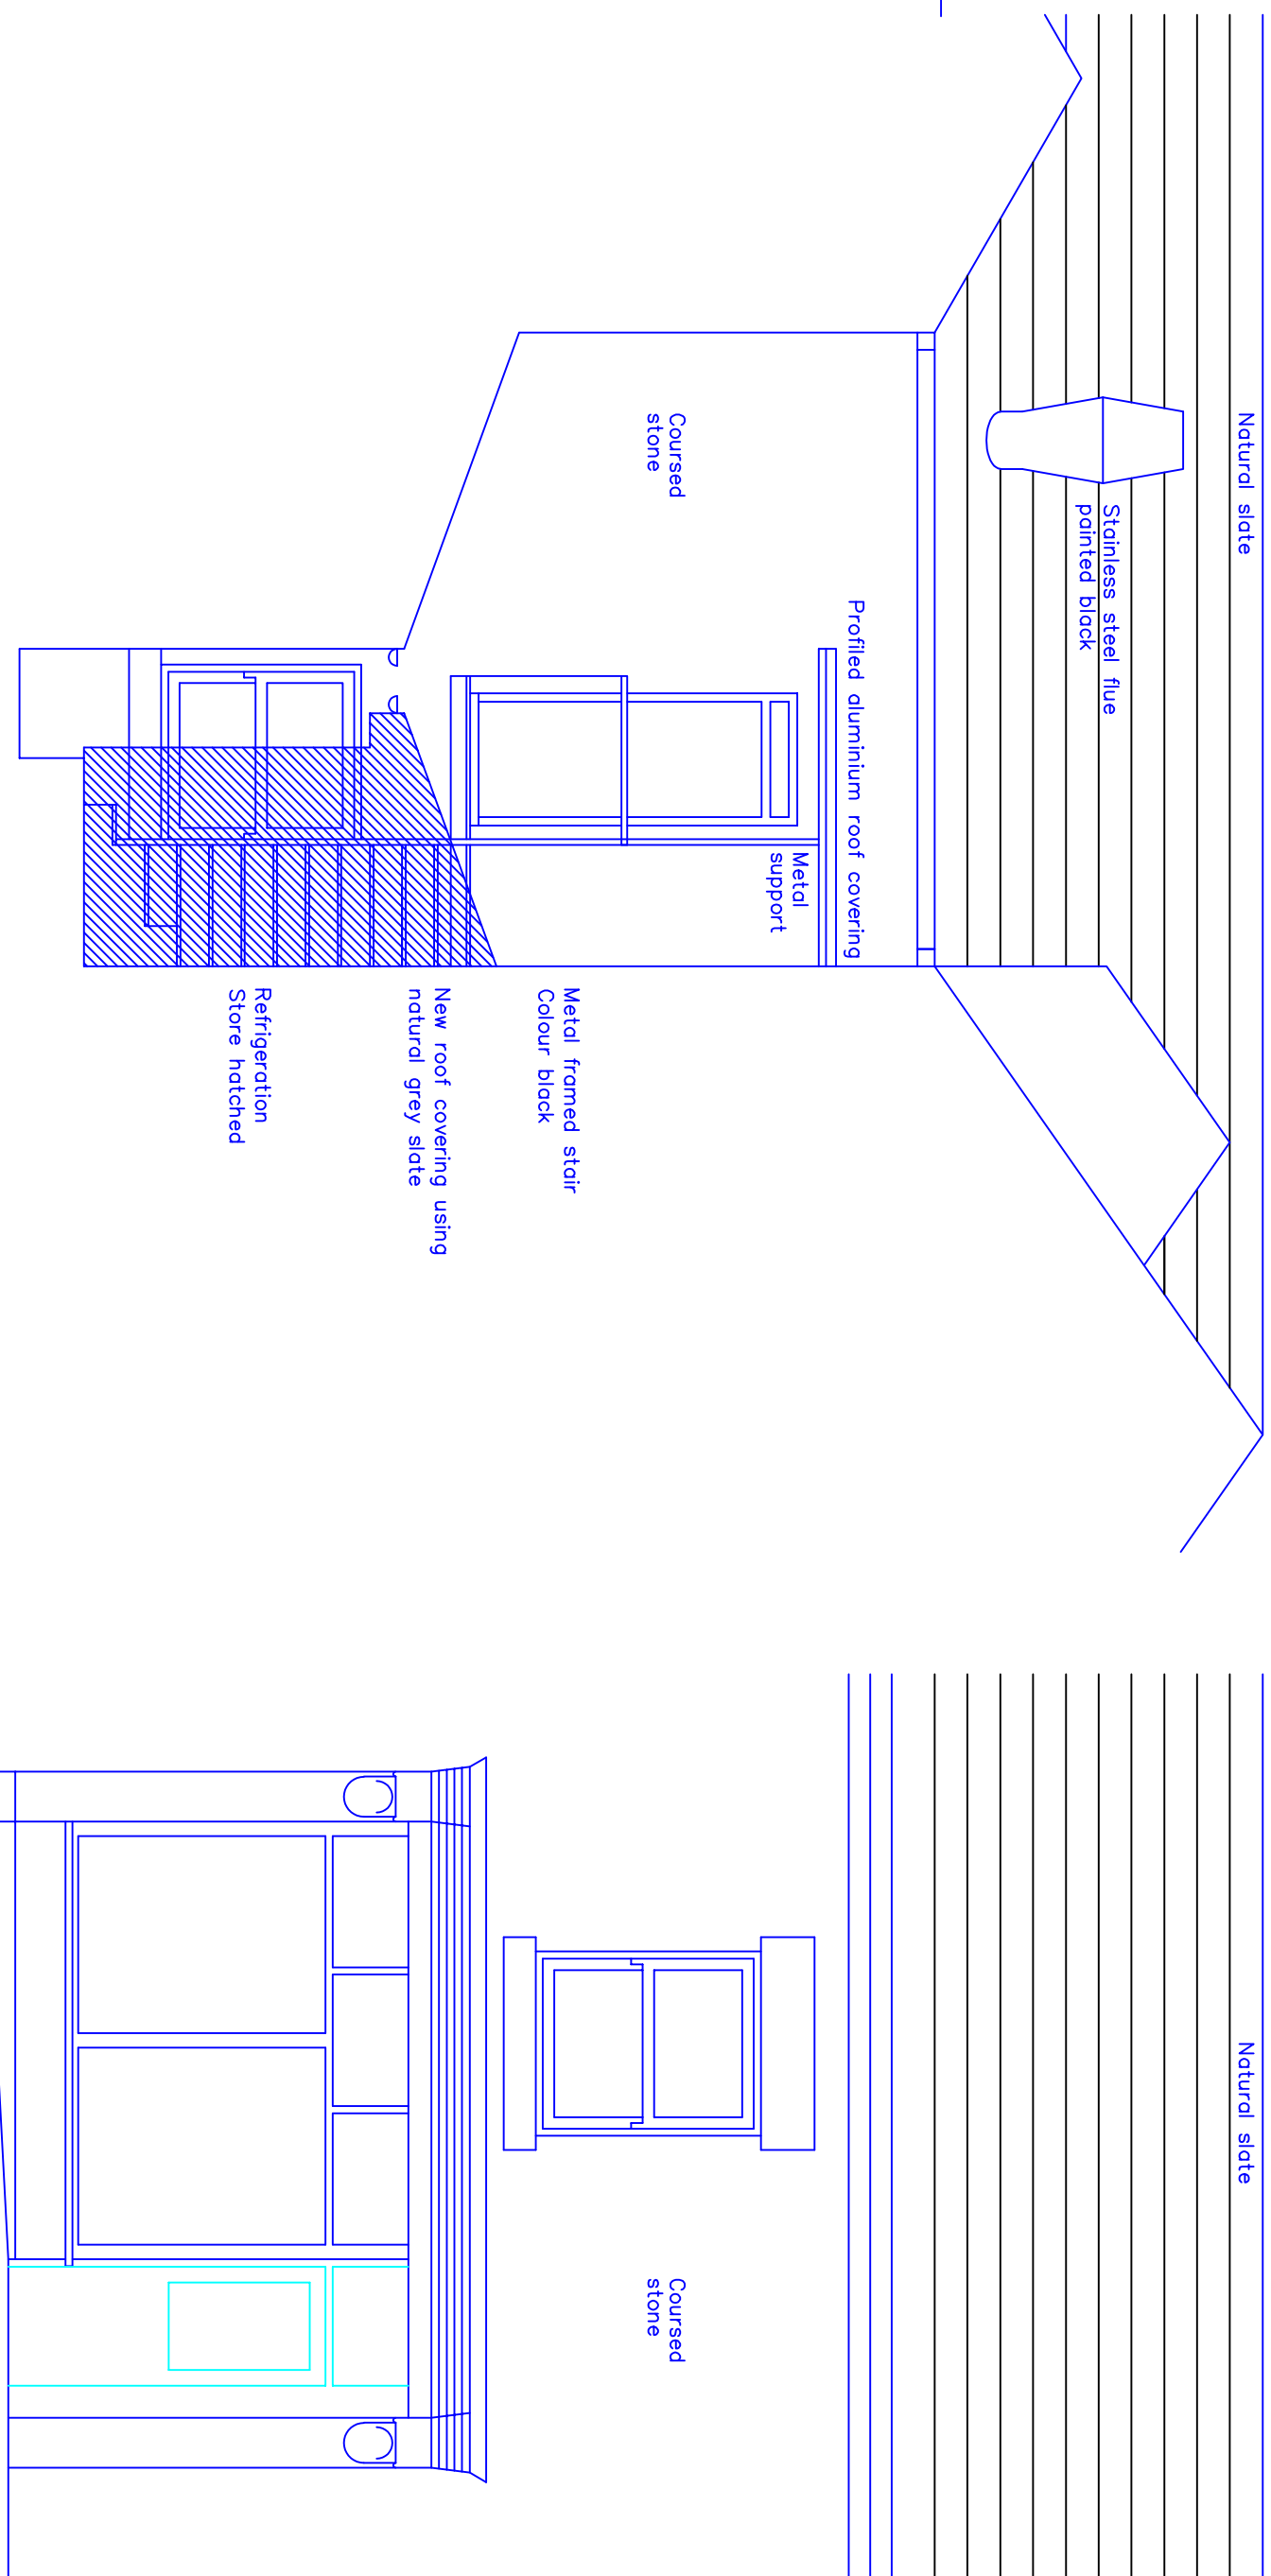


Proposed Rear Elevation

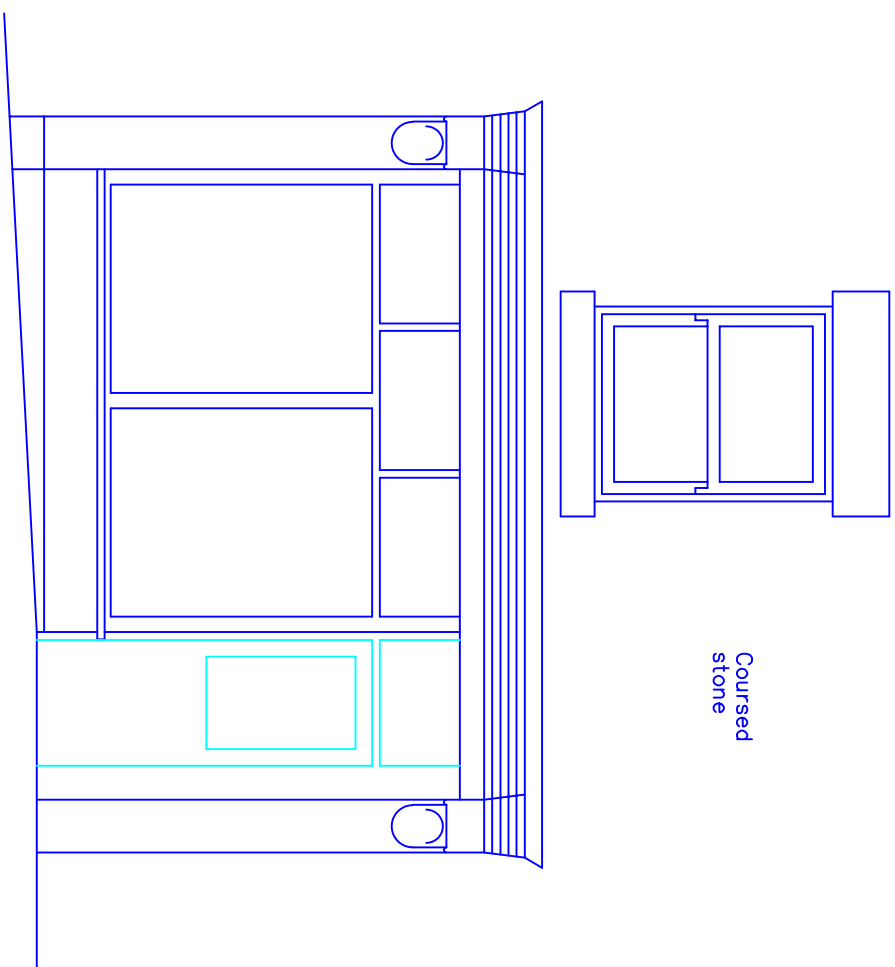


Proposed Front Elevation

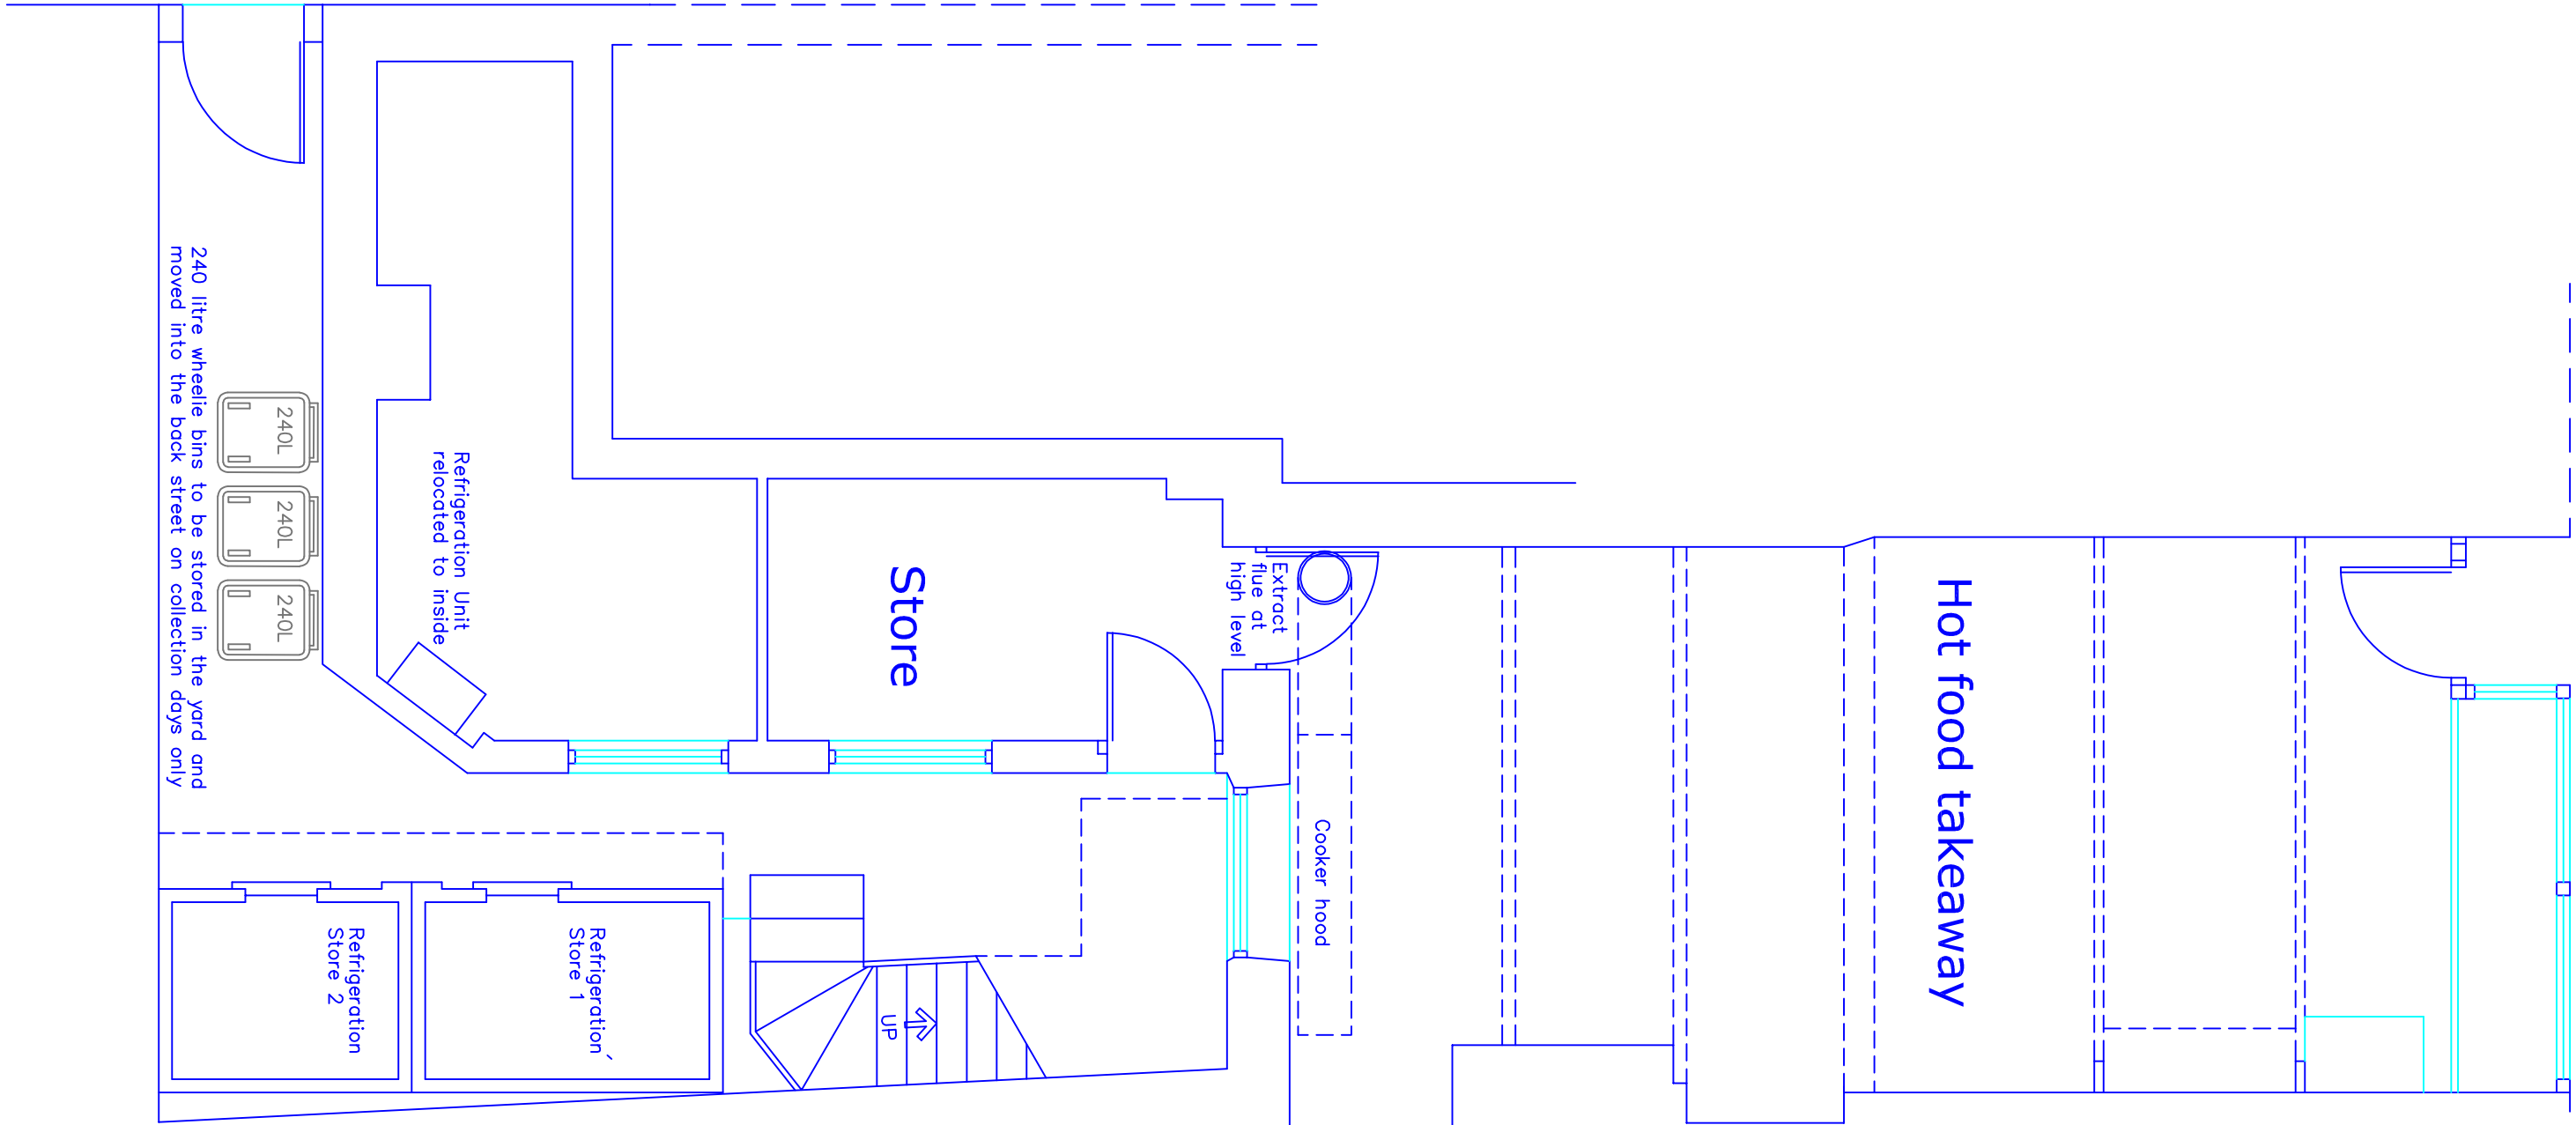


Proposed Plan
Ground Floor

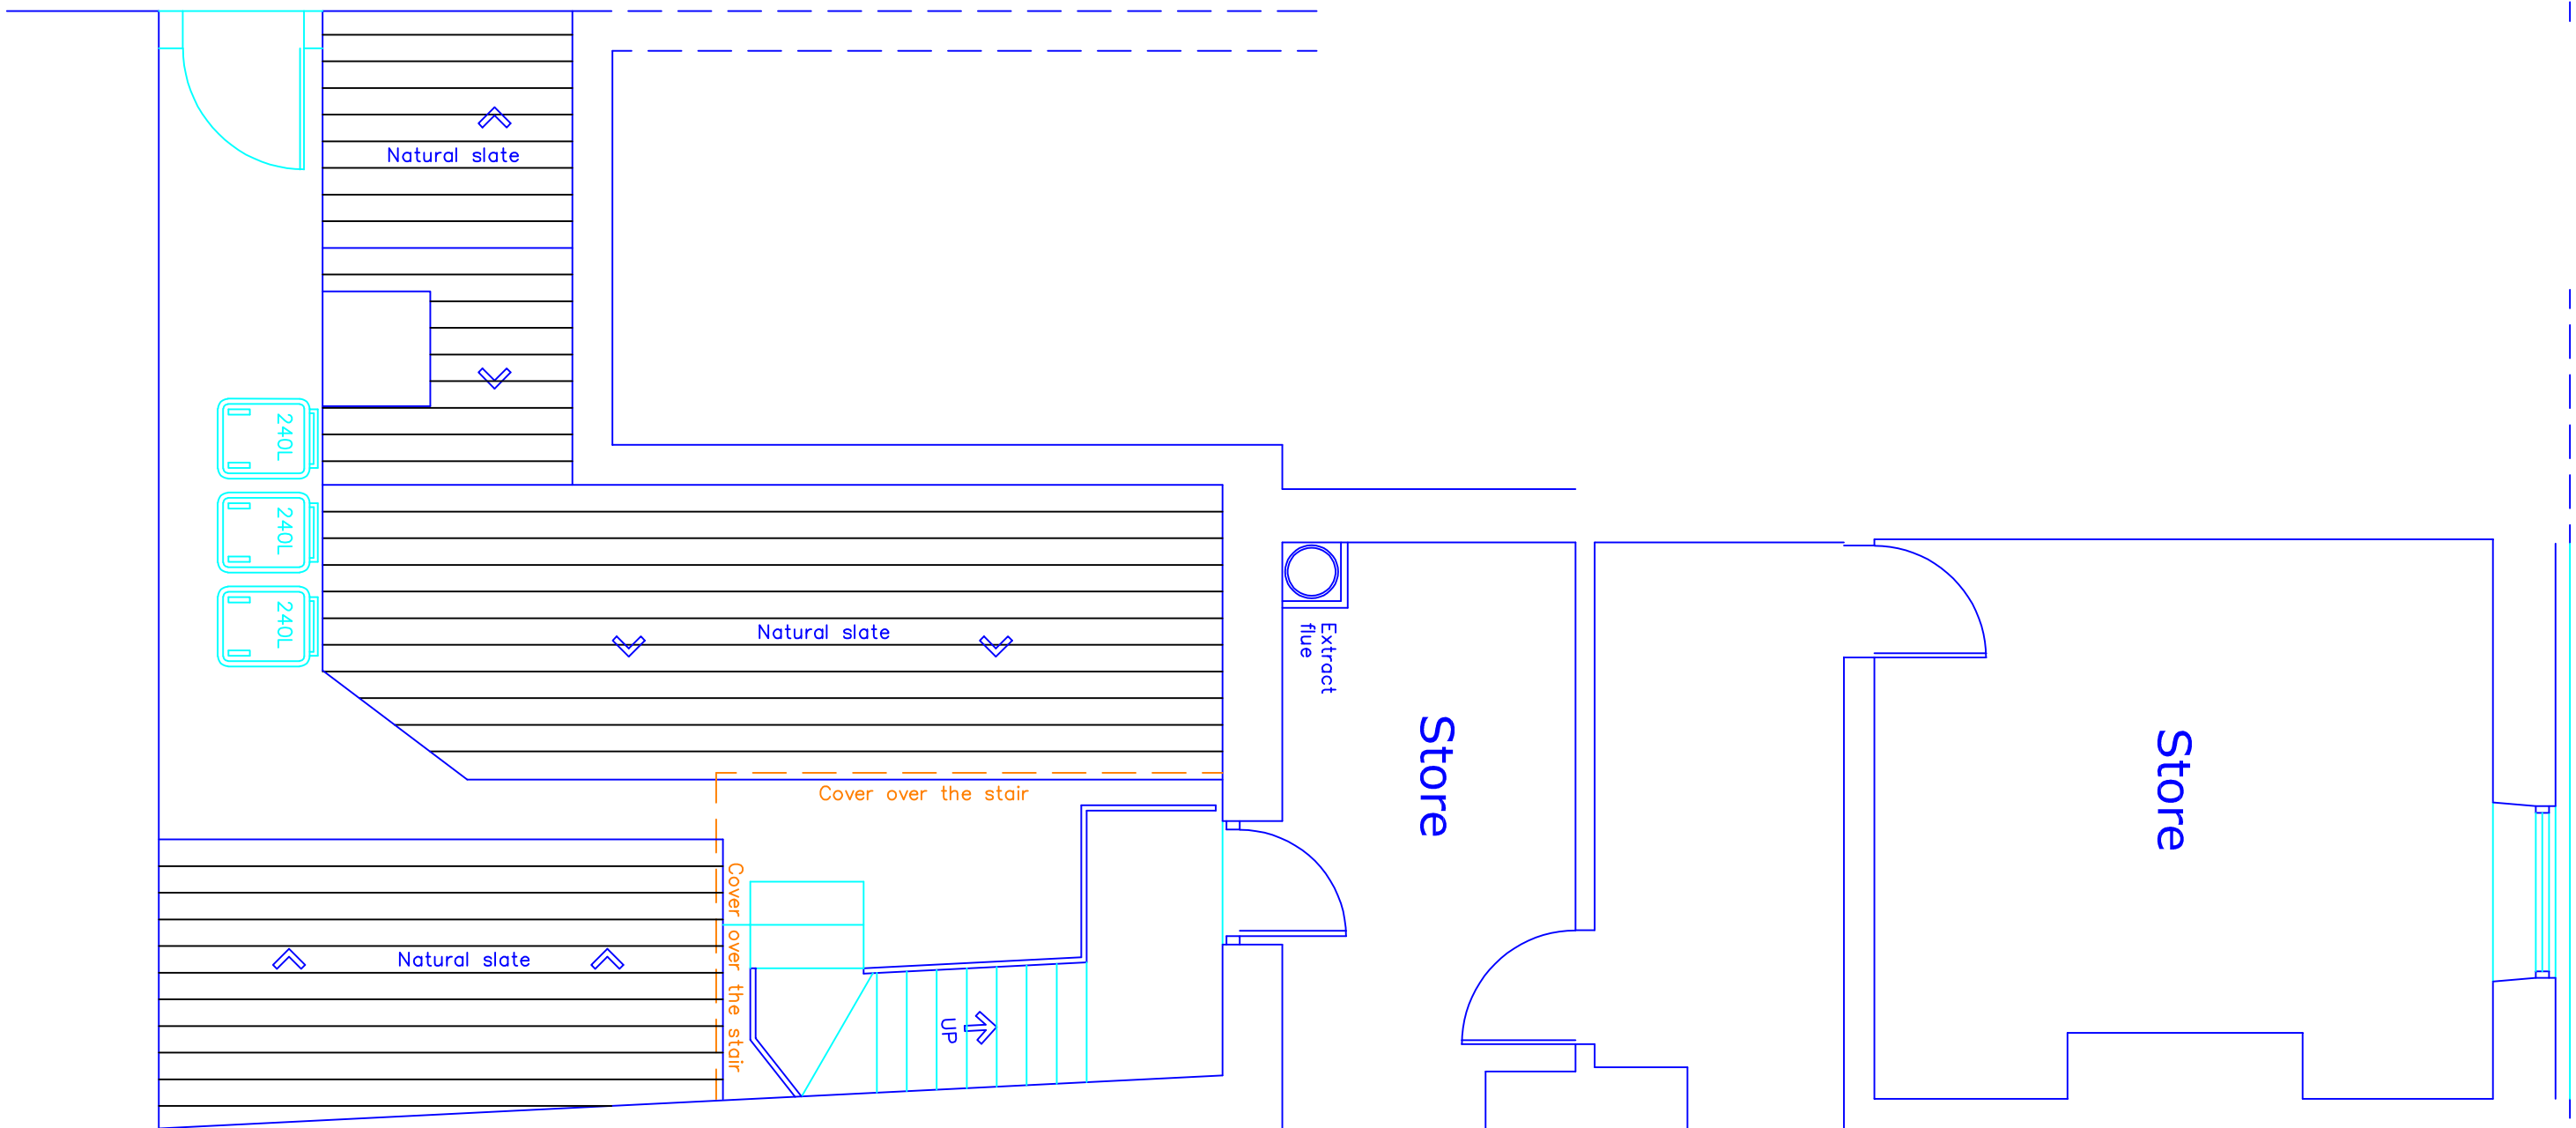

Proposed Plan
First Floor

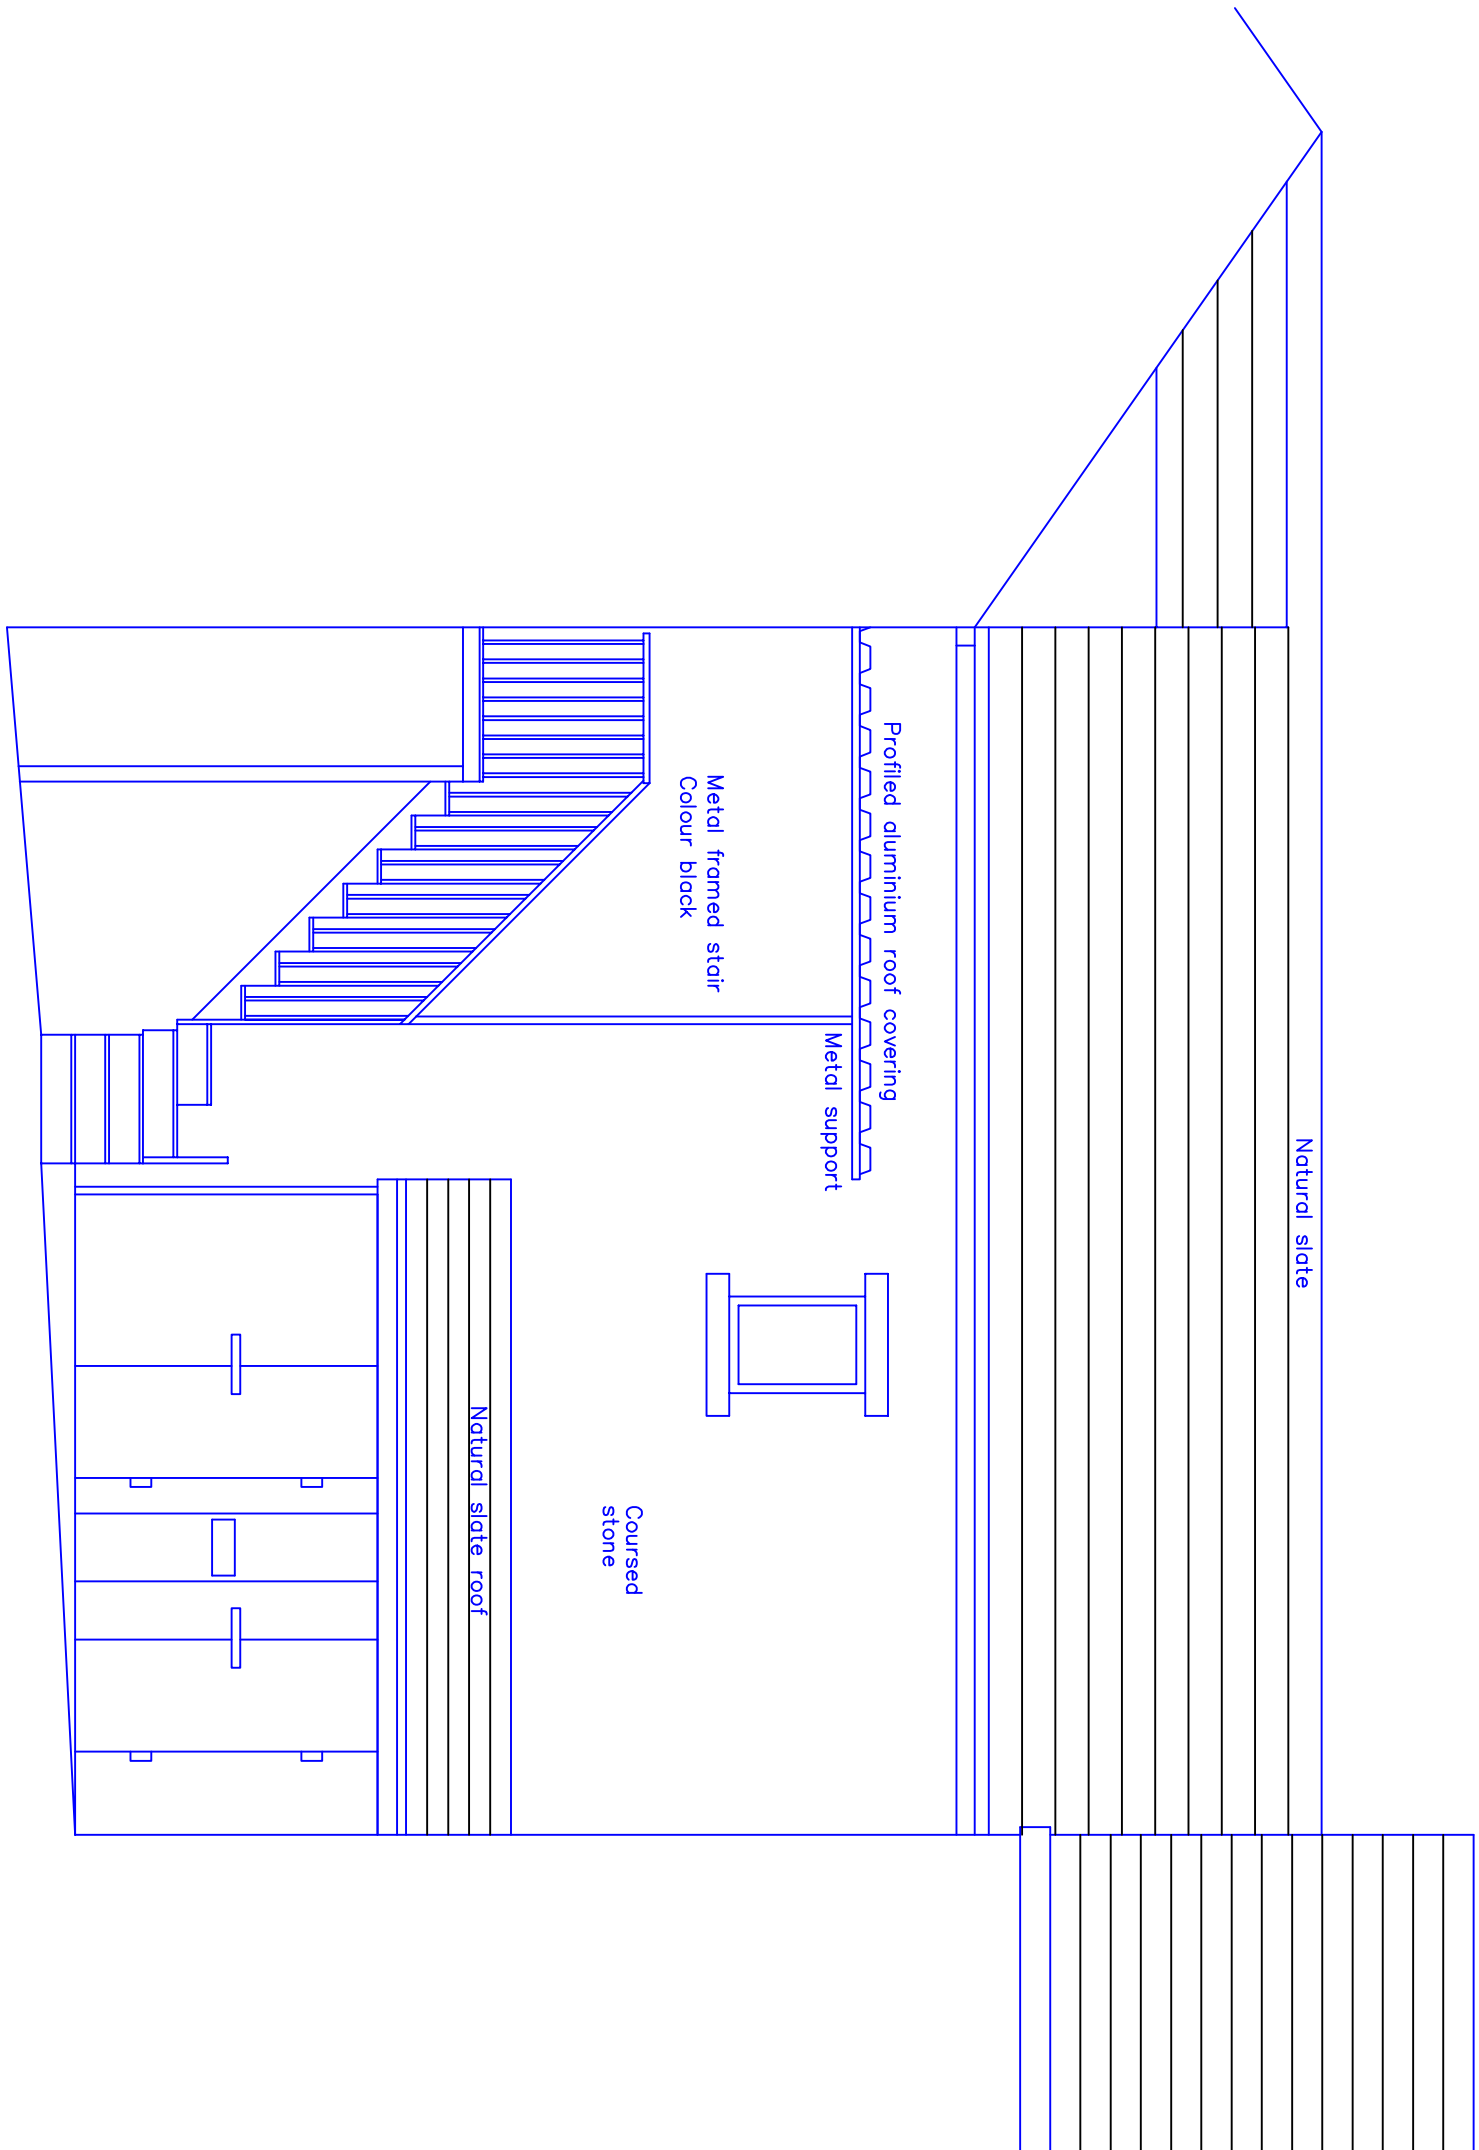

Proposed Side Elevation

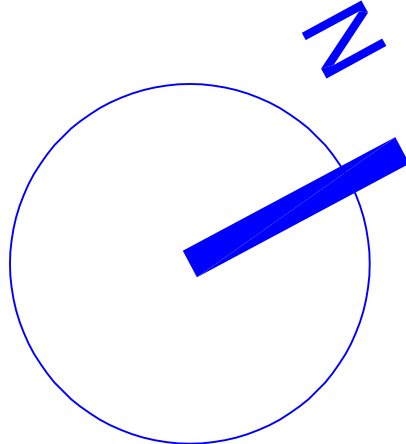

- E Cover added over the stair 11.03.2024
- D Slate roof added over refrigeration 18.11.2021
- C Rear stair amended as-built 02.11.2020
- B Refrigeration as installed with canopy 14.09.2020
- A Extract flue internal
- Side elevation added with stair
- Bins indicated / flue reduced in height 20.08.2020

This drawing and design concept is the property of PPV design. It should not be reproduced without written permission

0 1 2 3 m

62 Bridge Street
Rambottom
BLD 9AG
scale 1:50 @ A1
June 2020

PM7-02E
Proposed Plans & Elevations

PPV design Ltd

2 Helmsshore Road, Holcombe Village
Rambottom, Lancashire BL8 4PA
Gary Dearden (B&K home) DipArch RIBA
gary@ppv-design.co.uk www.ppv-design.co.uk
T: 01706 6221791 M: 07112 669482