









Google

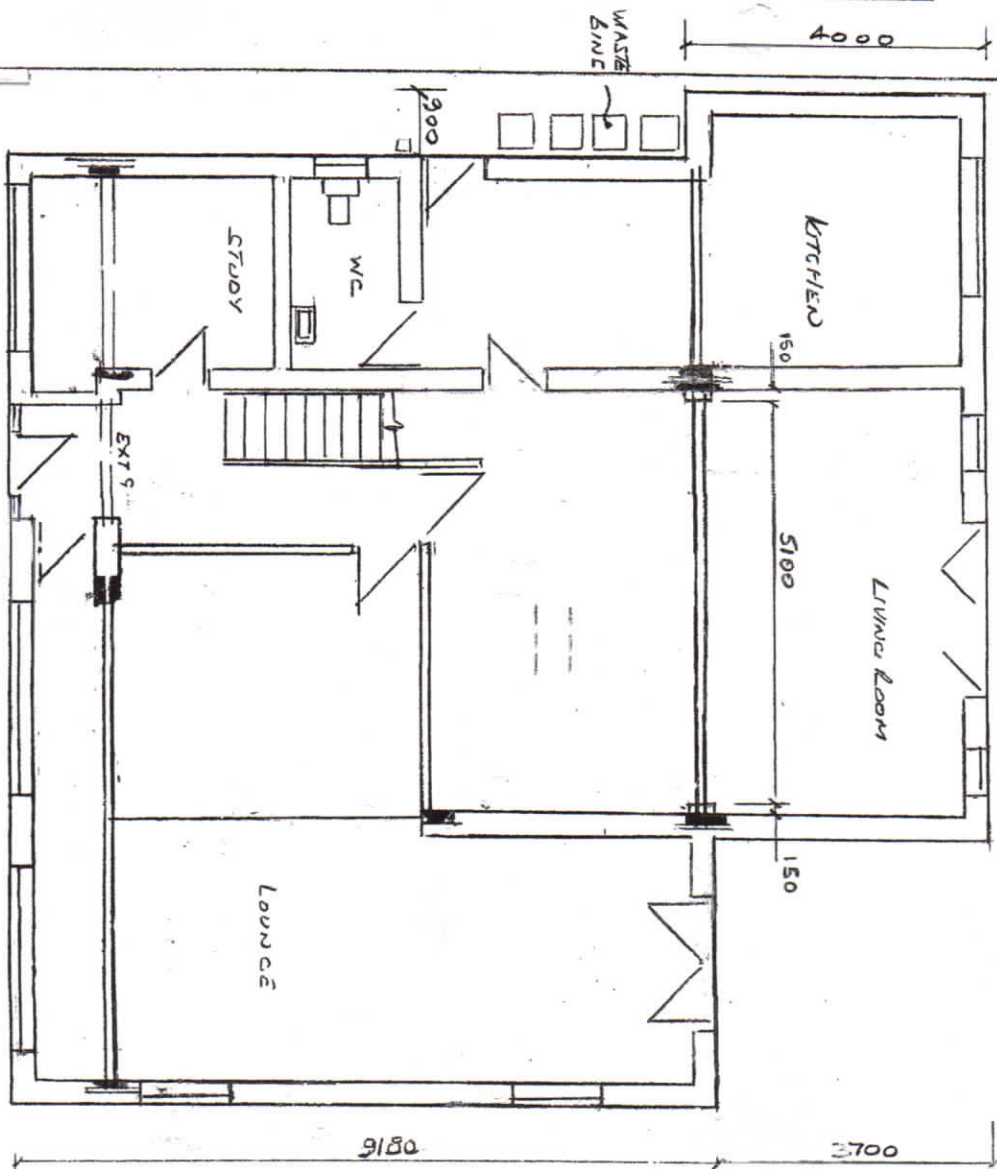

PROPOSED Ground Floor
PLAN

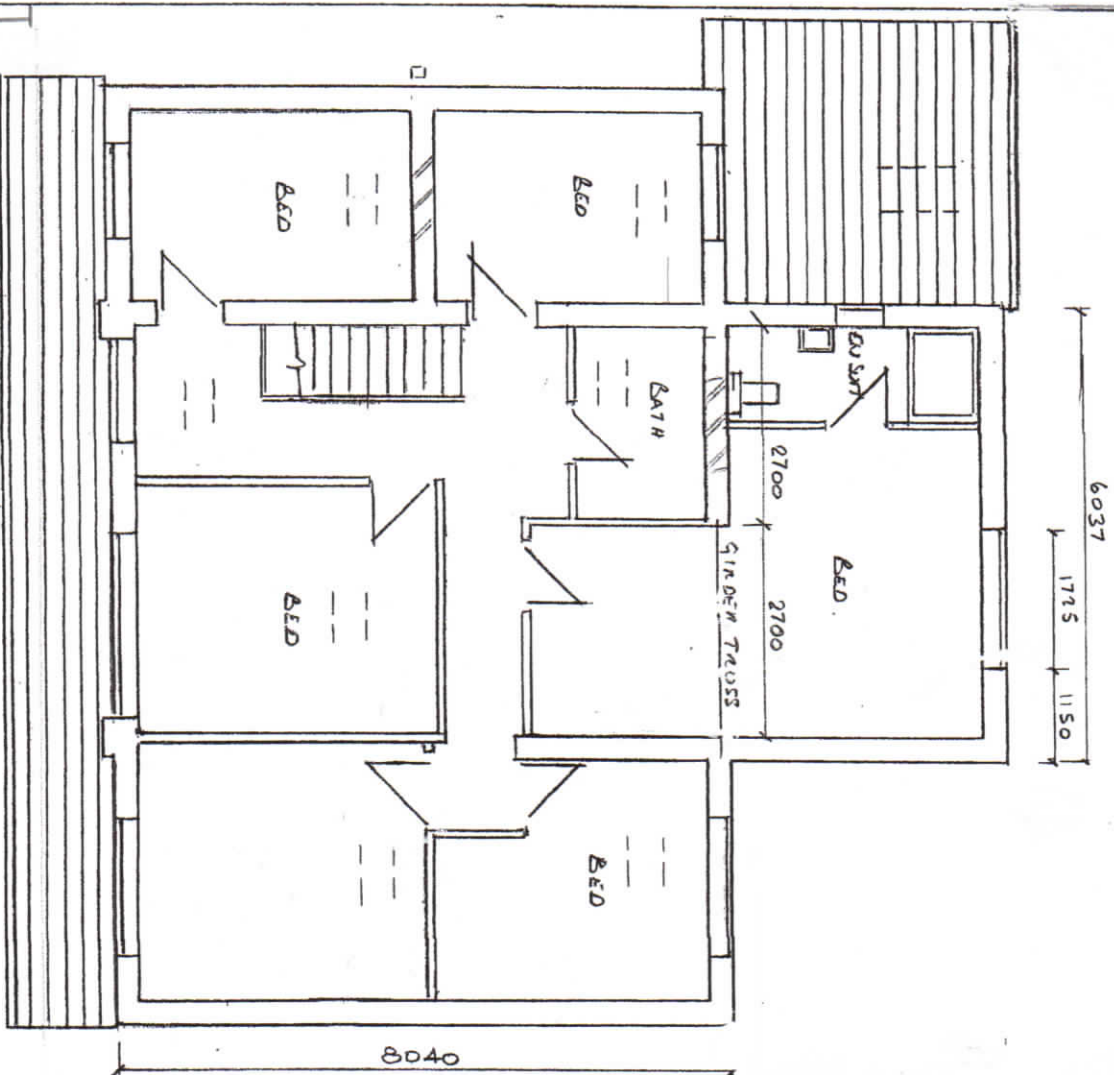

PROPOSED First Floor
PLAN

CALL PARKING
ENTRANCE & EXIT

EXISTING
BOUNDARY
FENCE

NEW BOUNDARY WALL

LANDSCAPED
FOOTPATH

WALL FOUNDATION
TOTAL WIDTH
PROPERTY BOUNDARY

REV 5

Thompson Designs
Tel 0161 705 1458 Mob 07884 318634

Sheet 4 BOUNDARY WALL
As Built Plans
2 Skegness Close
Bury BL8 1EQ
Scale 1:100 @ A3 Date July 2023