


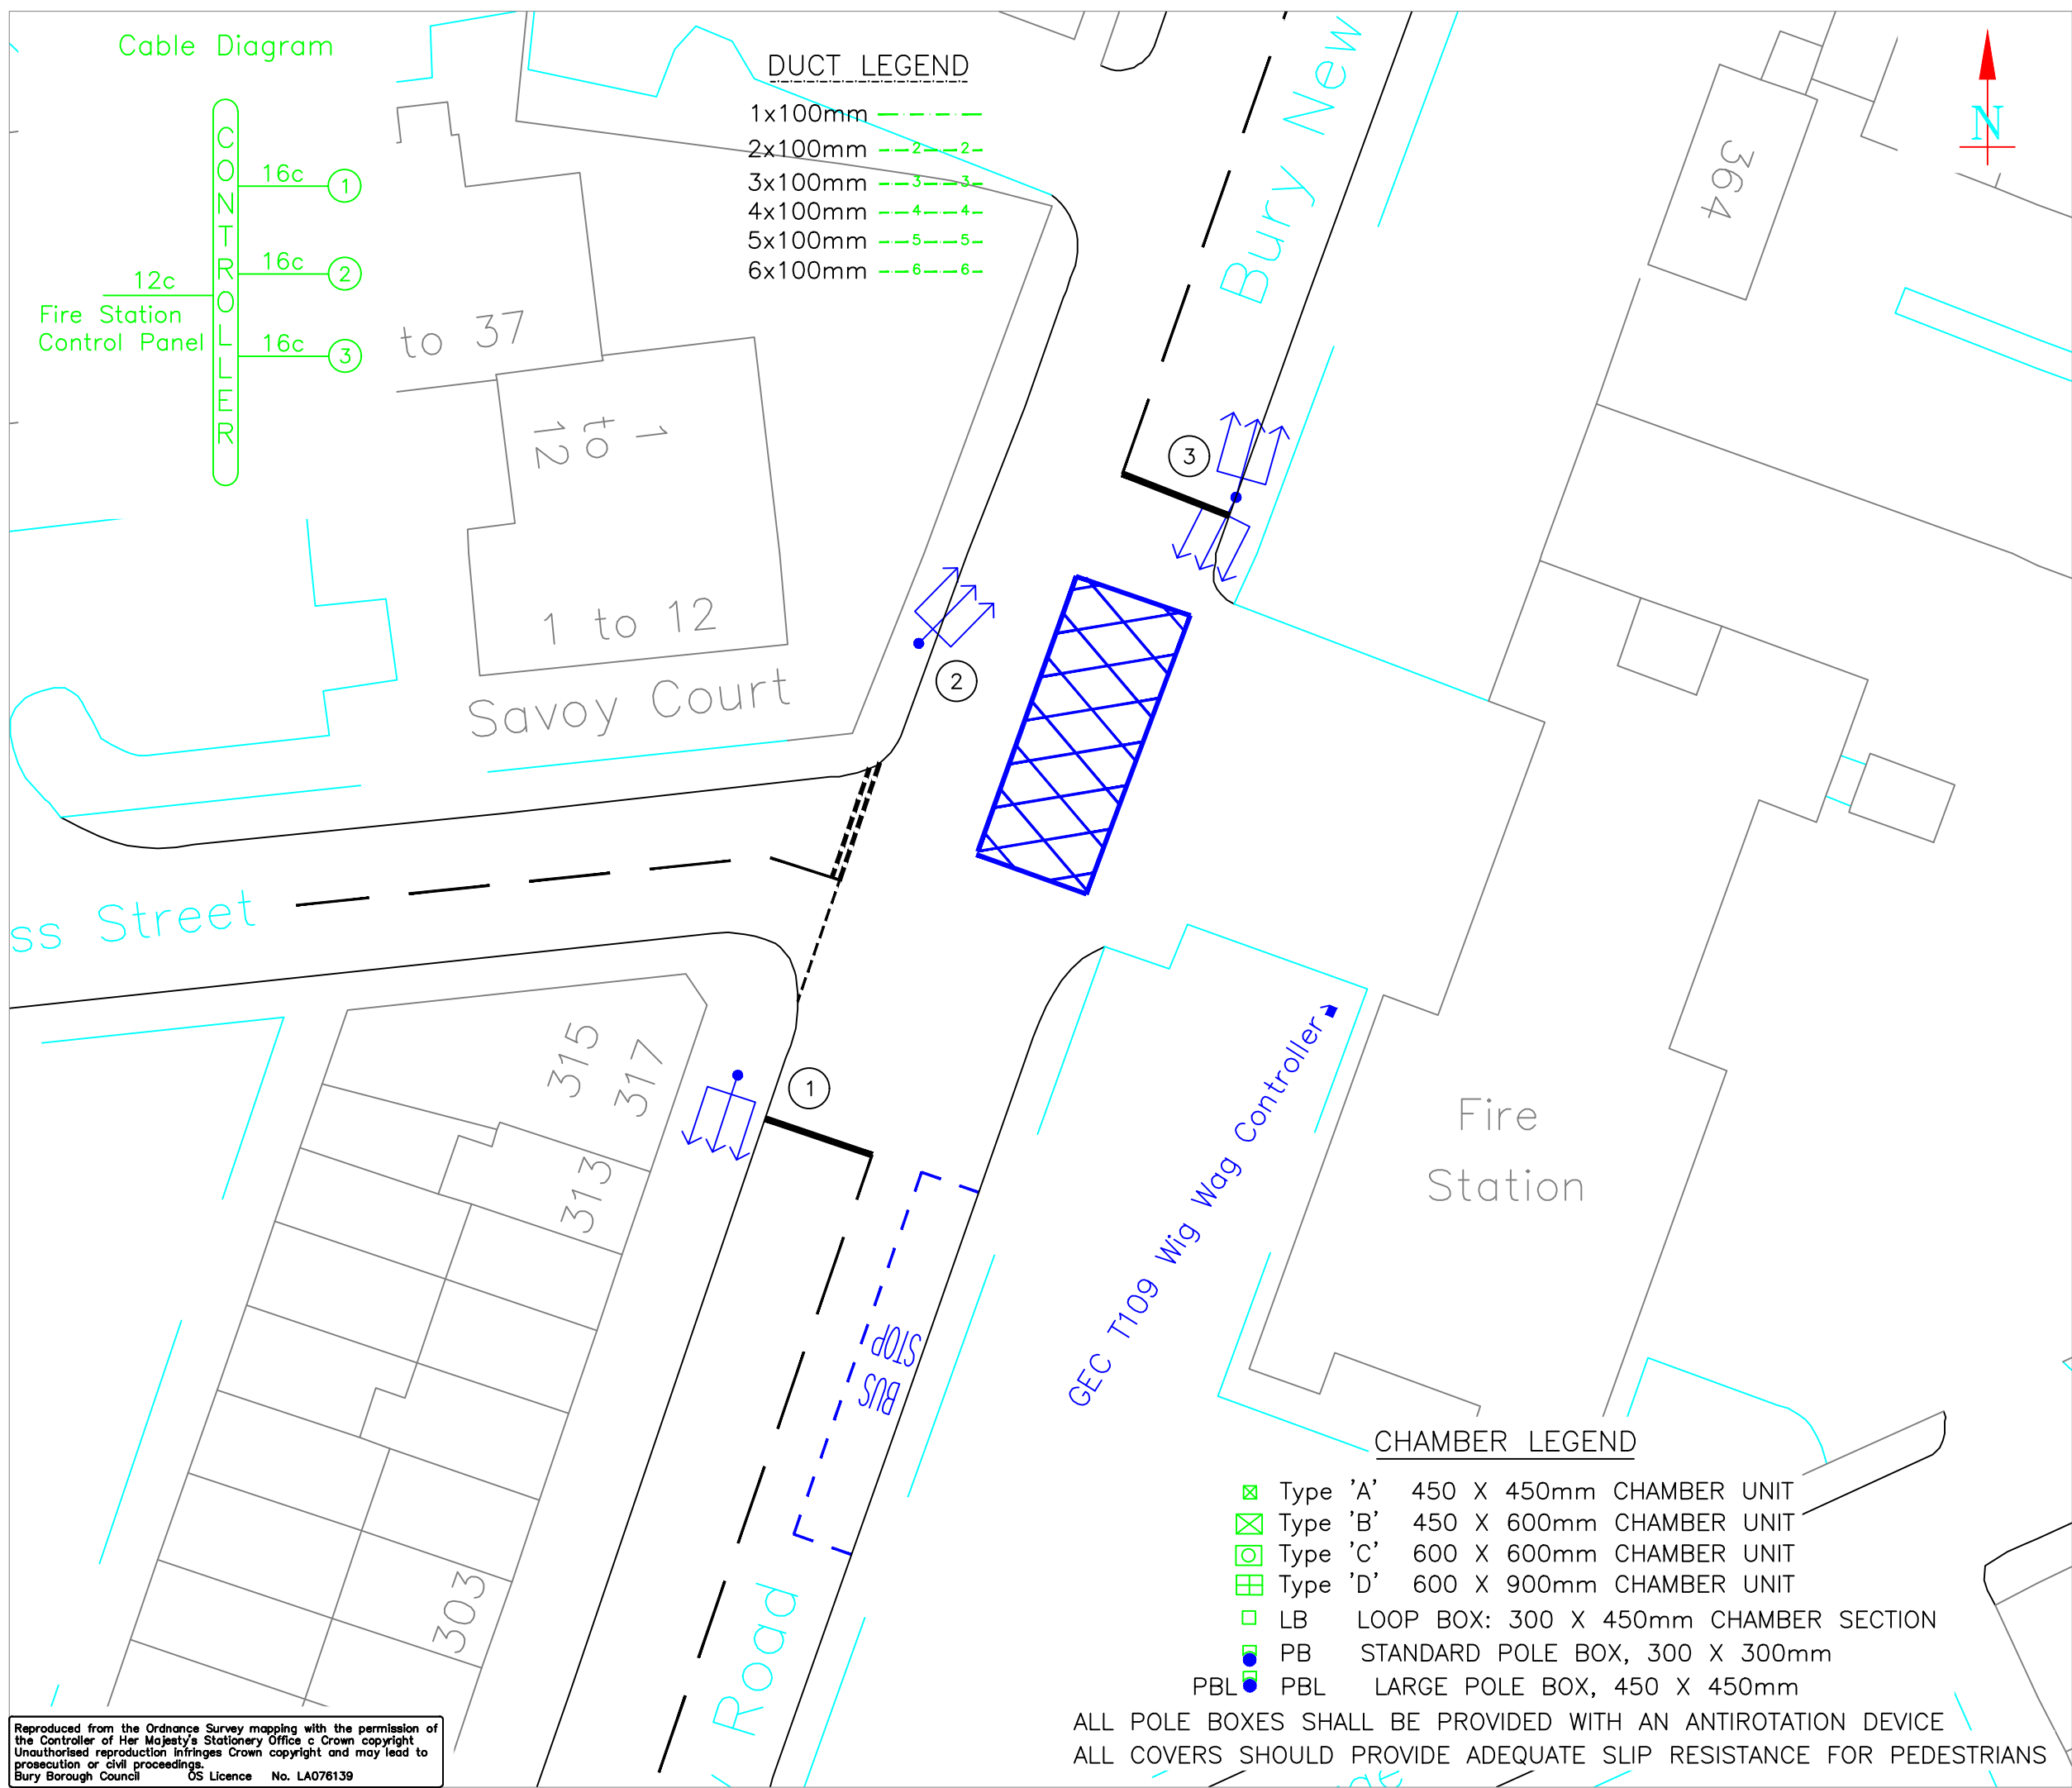

Staging Diagrams

1	2
3	4

Notes:

1) All ducting information is purely indicative.

A	Cable Diagram Added	06/11/02	DGS
---	---------------------	----------	-----

REVISIONS

DATE	BY	APP
------	----	-----

Bury New Rd/Whitefield Fire Station, Lily Hill
Bury (2/067)

SCALE 1:200

0.0	1	2	3	4	5	6	7	8	9	10	11	12
-----	---	---	---	---	---	---	---	---	---	----	----	----

OS-REF		CHECKED ON SITE BY	PM
DATE	06/11/02	CHECKED BY	
STATUS	As Built	DRAWN BY	DGS
ORIGINAL DRAWING SIZE	A3	CAD FILE	Wig2-067
XREF			REV
DRAWING No.	A3/02/2-067/02		A

Association of Greater Manchester Authorities

GREATER MANCHESTER URBAN TRAFFIC CONTROL UNIT