


Cable Diagram

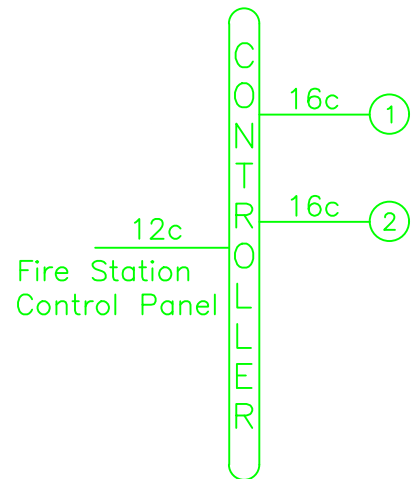

DUCT LEGEND

- 1x100mm
- 2x100mm
- 3x100mm
- 4x100mm
- 5x100mm
- 6x100mm

1 to 12
Savoy Court

BURY NEW ROAD

Yunex,ST950 WIG WAG
Controller & Haldo

Stat Demand Unit

T5

T3

VISITOR CAR
PARKING

SECURITY
GATE

TURN-OUT
APRON

W
CA

1

2

3


4

Notes:
1) All ducting information is purely
indicative.

B	New Controller , Haldo and Signal Heads	10/12/25	DJW
A	Cable Diagram Added	06/11/02	DGS

REVISIONS	DATE	BY	APP
-----------	------	----	-----

Bury New Rd/Whitefield Fire Station, Lily Hill
Bury (2/067)

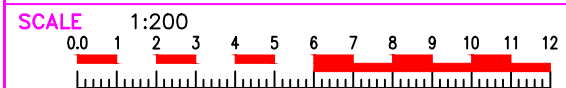

OS-REF		CHECKED ON SITE BY	PM
DATE	06/11/02	CHECKED BY	
STATUS	As Built	DRAWN BY	DGS
ORIGINAL DRAWING SIZE	A3	CAD FILE	Wig2-067

XREF		REV
------	--	-----

DRAWING No.	A3/02/2-067/02	B
----------------	----------------	---

