




2A Cook Street,
 Bury, Lancashire,
 BL9 0RP,
 0161 8717405

email: ipsuk@live.co.uk


As-Built Elevations

of 52-54 Water Street, Radcliffe, M26 4DF


Scale :1 : 100 on A3	All Dimensions in Meters
Ref: IPS/R/52-54/M264DF	Date : 03/10/2022
As-Built	
SHT 4 of 4	

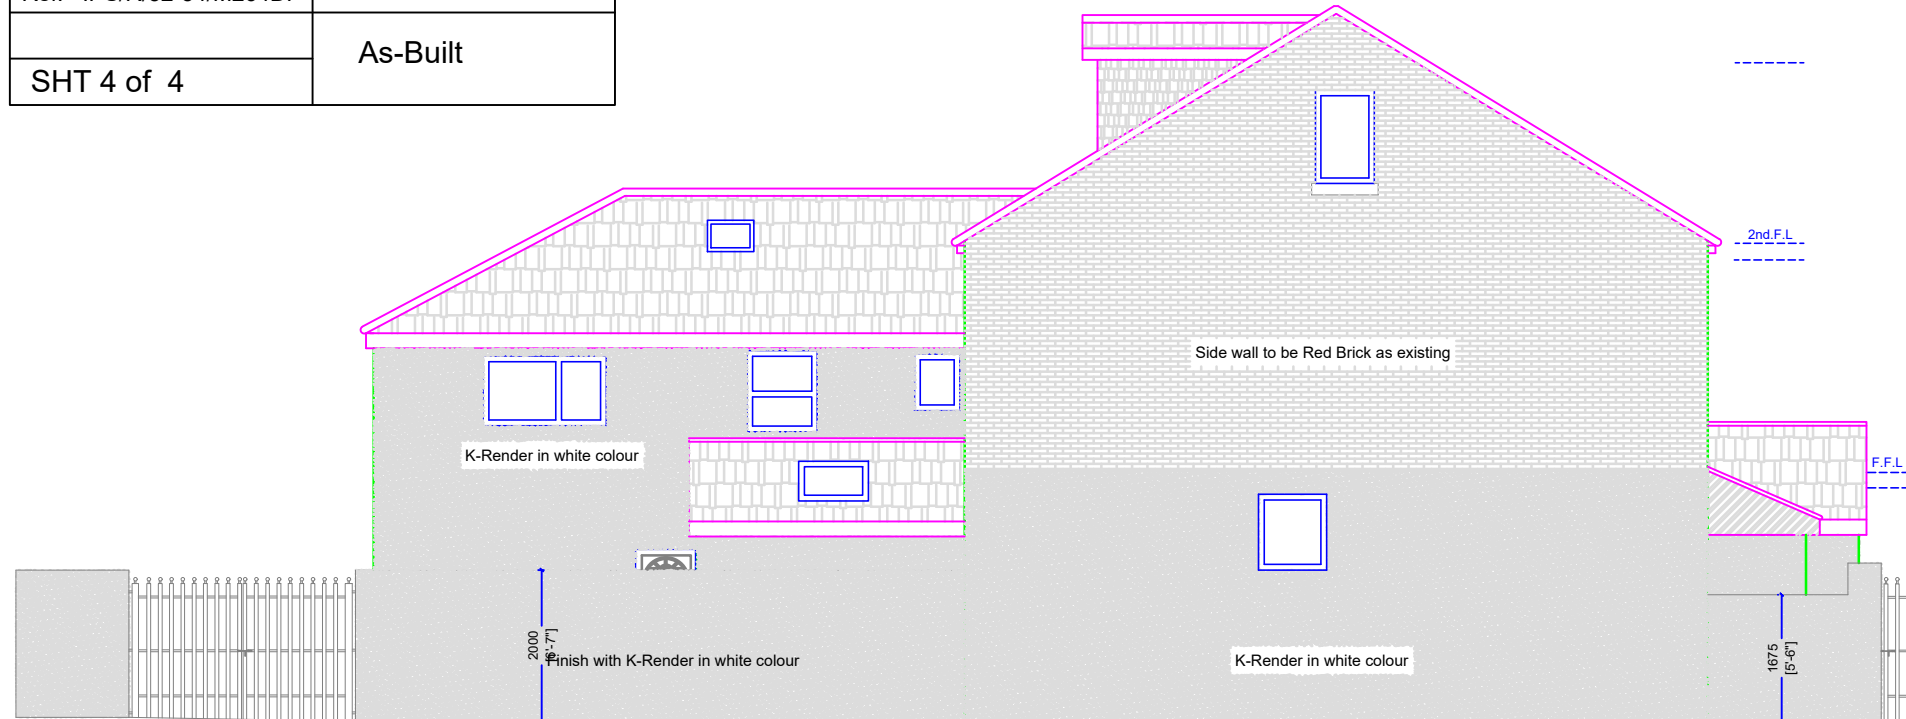


PROPOSED SIDE ELEVATION Incl. Boundary (WEST)

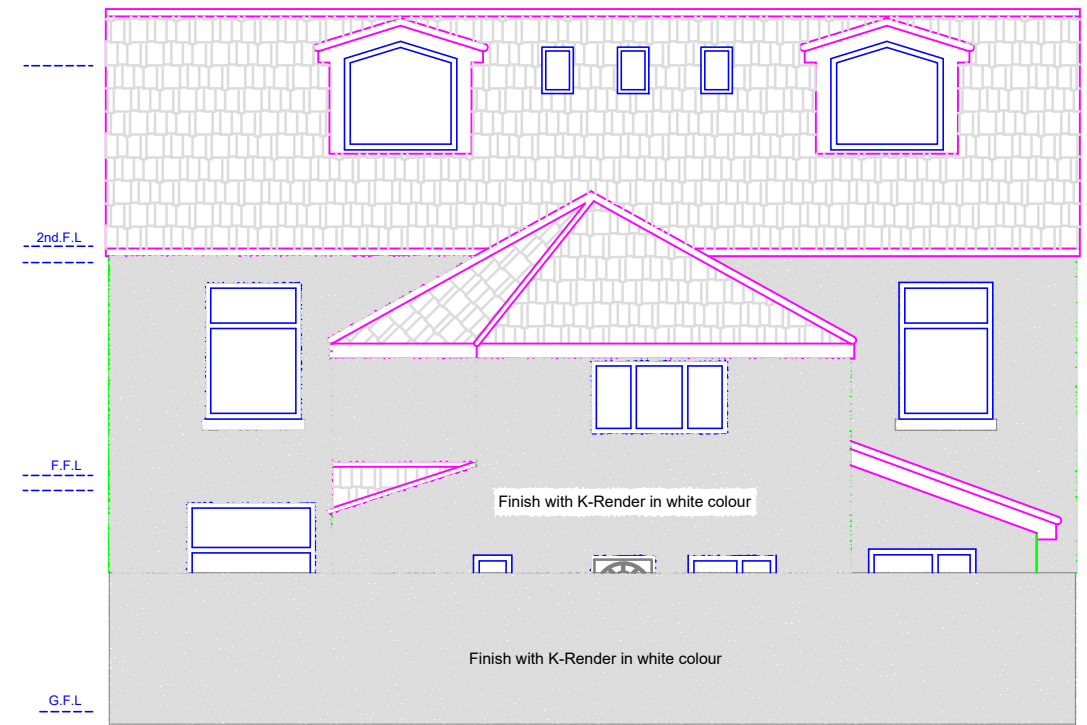

PROPOSED REAR ELEVATION Incl. Boundary

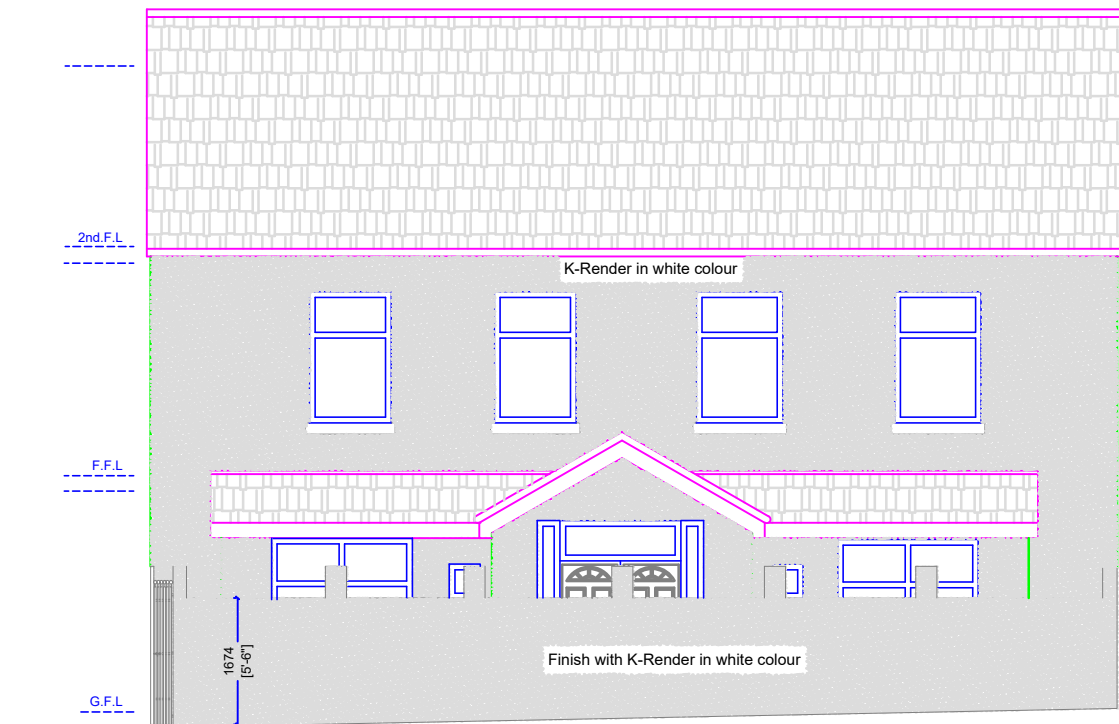

PROPOSED FRONT ELEVATION Incl. Boundary

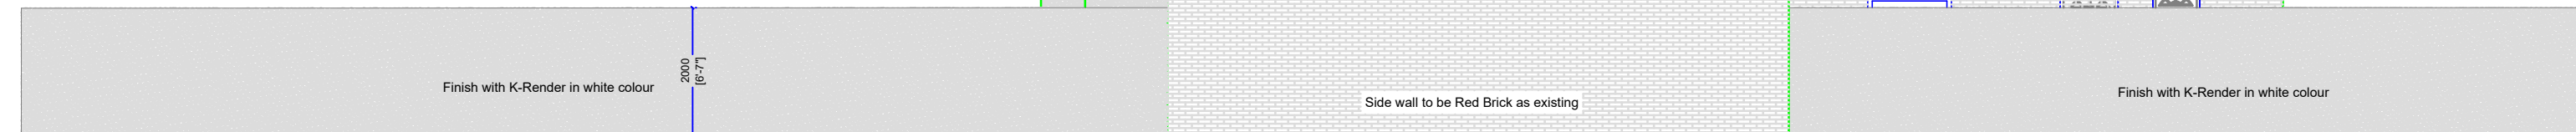

PROPOSED SIDE ELEVATION Incl. Boundary (EAST)

This drawing is the property of IPS Architects and copyright is reserved by them.
 This drawing is not to be copied or disclosed by or to any unauthorized person without the prior written consent of IPS Architects.

Do not scale from this drawing.

All dimensions are to be checked on site prior to construction, manufacture of any components and ordering of materials and equipment.

Any discrepancies are to be reported to the architects for clarification.

All materials and workmanship to be accordance with the current British Standards and codes of practice.

This drawing is to be read in conjunction with all relevant Architectural Structural Engineers, Mechanical Engineers, Electrical Engineers and Specialists drawings and specifications.

