



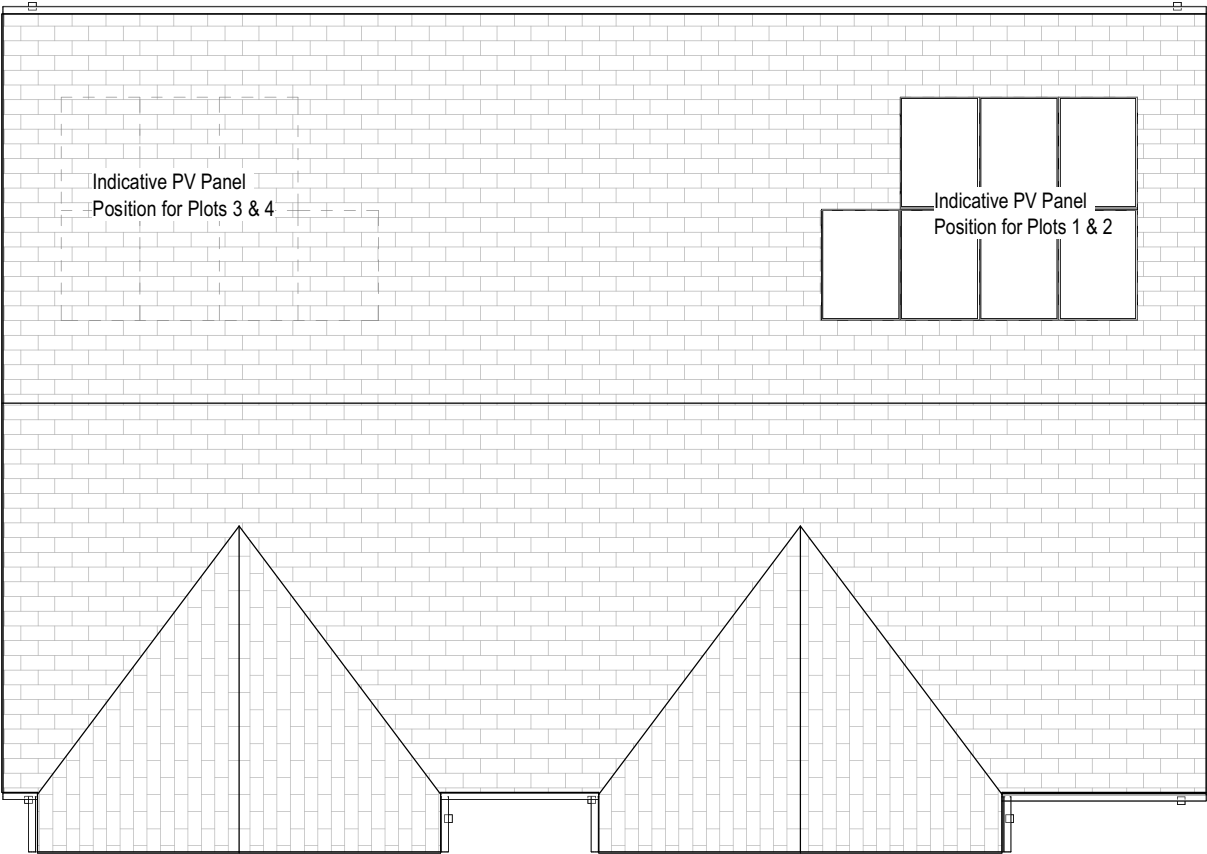

ROOF PLAN
1 : 100

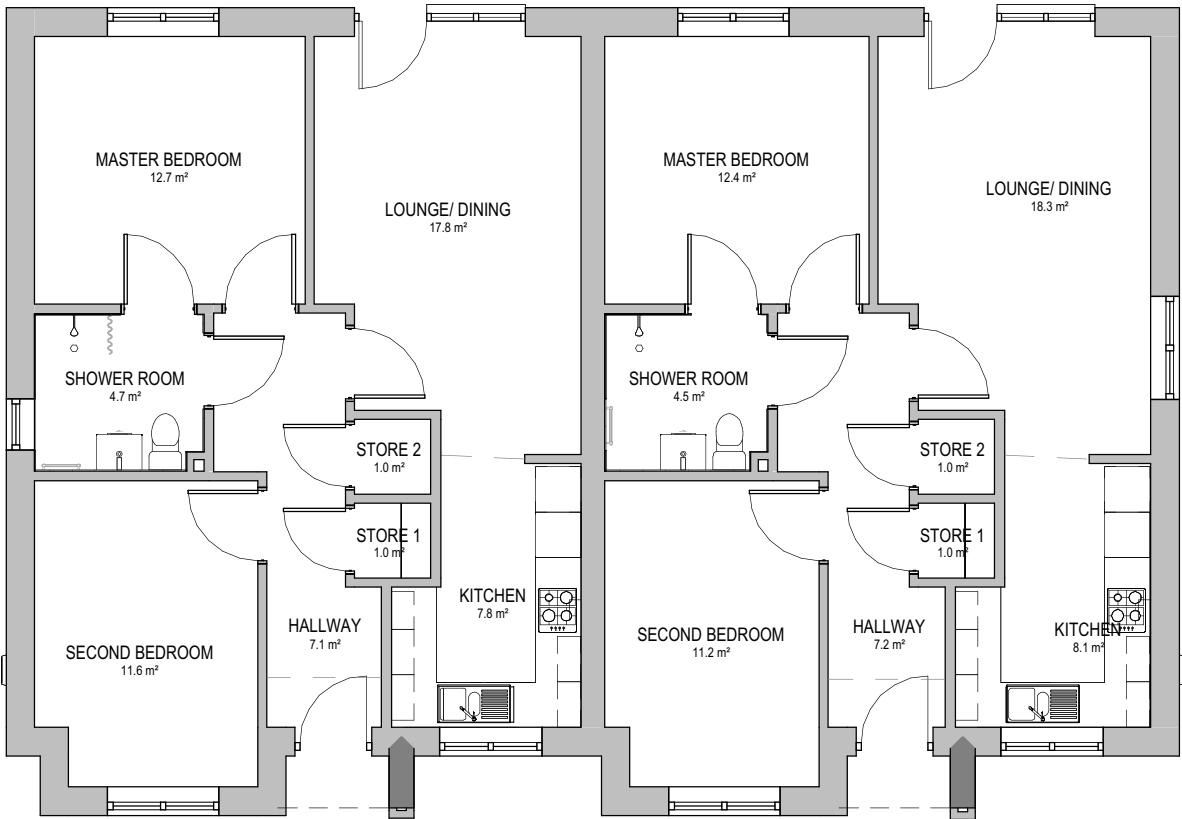

FLOOR PLAN
1 : 100

Notes

The Contractor is to check all dimensions and conditions on site before commencing. Do not scale from this drawing.
This drawing remains the copyright of POZZONI Architecture Ltd.

Scale Bars

TO BE USED ONLY AS GUIDANCE

1:100	mm		1000		3000		5000
1:200	mm			5000		8000	
1:500	M		5		15		25
1:1250	M		10		30		50
							70

Please refer to drawing 6071 -POZ-XX-ZZ-DR-A-1351 Planning-
Bungalow Elevations for position of PV panels

P04	NMA - Additional lift to stair 2 and indicative positions of PV panels	LRR	01/12/25
P03	Planning Issue	BAP	16/05/24
P02	Room labels corrected	EM	14/03/24
P01	Issued for pre-app planning advice	EM	19/01/24
Rev	Description	By	Date

Client

ARCON HOUSING ASSOCIATION
(BOLTON AT HOME)

Job

FLETCHER FOLD ROAD, BURY

Drawing

PLANNING - BUNGALOW
FLOOR & ROOF PLAN

BSRef

POZ Ref

6071_1211

Rev

P04

Date

19/01/24

Scale

1 : 100

@ A3

3D CoOrd

2D CoOrd

Approved

EM

EM

JW

Project Status

Planning

Tender

Construction

Design

Contract

As Built

pozzoni

Woodville House
2 Woodville Road
Altrincham
WA14 2FH

+44 161 928 7848
architects@pozzoni.co.uk
www.pozzoni.co.uk