

Notes

GENERAL NOTES

THE CONTRACTOR IS ADVISED TO VISIT THE SITE PRIOR TO ALL LOCAL CONDITIONS & RESTRICTIONS LIKELY TO AFFECT THE EXECUTION OF THE WORKS. NO CLAIMS ARISING FROM FAILURE TO DO SO WILL BE CONSIDERED.

THIS DRAWING IS TO BE READ IN CONJUNCTION WITH ALL OTHER DRAWINGS, SCHEDULES & SPECIFICATIONS RELATING TO THE PROJECT AND ANY DISCREPANCIES NOTIFIED TO THE CONTRACT ADMINISTRATOR IMMEDIATELY.

THE CONTRACTOR IS TO CHECK ALL DIMENSIONS ON SITE PRIOR TO COMMENCING WORKS OR ORDERING ANY MATERIALS. DO NOT SCALE OFF DRAWINGS..

ALL WORKMANSHIP AND MATERIALS TO COMPLY WITH BUILDING REGULATIONS.BRITISH STANDARDS.CODES OF PRACTICE, MANUFACTURERS INSTRUCTIONS.AGREEMENT CERTIFICATES ETC.ALL MATERIALS SHALL BE SUITABLE FOR PURPOSE.

THE CONTRACTOR IS TO MAKE GOOD ALL

- THE CONTRACTOR TO CHECK AND VERIFY ALL BUILDING AND SITE DIMENSIONS, LEVELS AND SEWER INVERT LEVELS AT CONECTION POINTS BEFORE WORK COMMENCES.
- THIS DRAWING MUST BE READ WITH AND CHECKED AGAINST ANY STRUCTURAL OR SPECIALIST DRAWINGS PROVIDED.
- THE CONTRACTOR IS TO COMPLY IN ALL ASPECTS WITH THE CURRENT BUILDING REGULATIONS WHETHER OT NOT SPECIFICALLY STATED ON THESE DRAWINGS
- NO DIMENSIONS ARE TO BE SCALED FROM THIS DRAWING, ALL DIMENSION TO BE CHECKED BEFORE WORK COMMENCES AND ANY DISCREPANCY TO BE REPORTED TO CLIENT.
- ALL WORKS TO COMPLY WITH THE WORKMANSHIP CLAUSES IN BS8000 SERIES AND TO BE IN FULL COMPLIANCE WITH BUILDING REGULATIONS.
- CONTRACTOR IS TO NOTIFY BUILDING CONTROL AT THE APPROPRIATE STAGES IN CONSTRUCTION - NECESSARY FOR THEM TO DETERMINE THE WORKS STATUTORY COMPLIANCE.

WORKS DISTURBED.

THE CONTRACTOR TO COMPLY WITH CDM REGULATIONS AND HEALTH AND SAFETY REQUIREMENTS WHERE APPROPRIATE.

.

Text Key

- Proposed facing brick to match existings
- Proposed Tiles to Match Existing Roof Covering
- Proposed PVCu Double Glazed Windows
- Proposed PVCu Obscured Double Glazed Windows
- Bi-Fold Aluminium or Anthracite External Door
- Composite Double Glazed doors
- Roof Light - Velux roof window or lantern
- Dormer hanging tiles fore rated or non combustible
- Flat roof EPDM or GRP roof covering

Rev	Description	Date	Dr by	App by
original by	date created	01/10/25	NK	
NK				




Enquiries@nkarchitectural.co.uk

0161 818 4727

www.NKARCHITRCTURAL.co.uk

client name			
Mr Muhammad Amir			
project			
7 woodland Crescent Prestwich M25 9WQ			
drawing			
AS BUILT ELEVATIONS			
computer file		plot date	
C:\Users\nk\OneDrive\NKArch\7 Woodland Crescent Prestwich\7 woodland Crescent Prestwich M25 9WQ.V2.rvt			
project number		scale	
2025.0082721.22		1 : 50 @A1	
drawing number		rev	issue status
A102			

This drawing is to be read in conjunction with all related drawings. All dimensions must be checked and verified on site before commencing any work or producing shop drawings. The originator should be notified immediately of any discrepancy. This drawing is copyright and remains the property of NK Architectural.

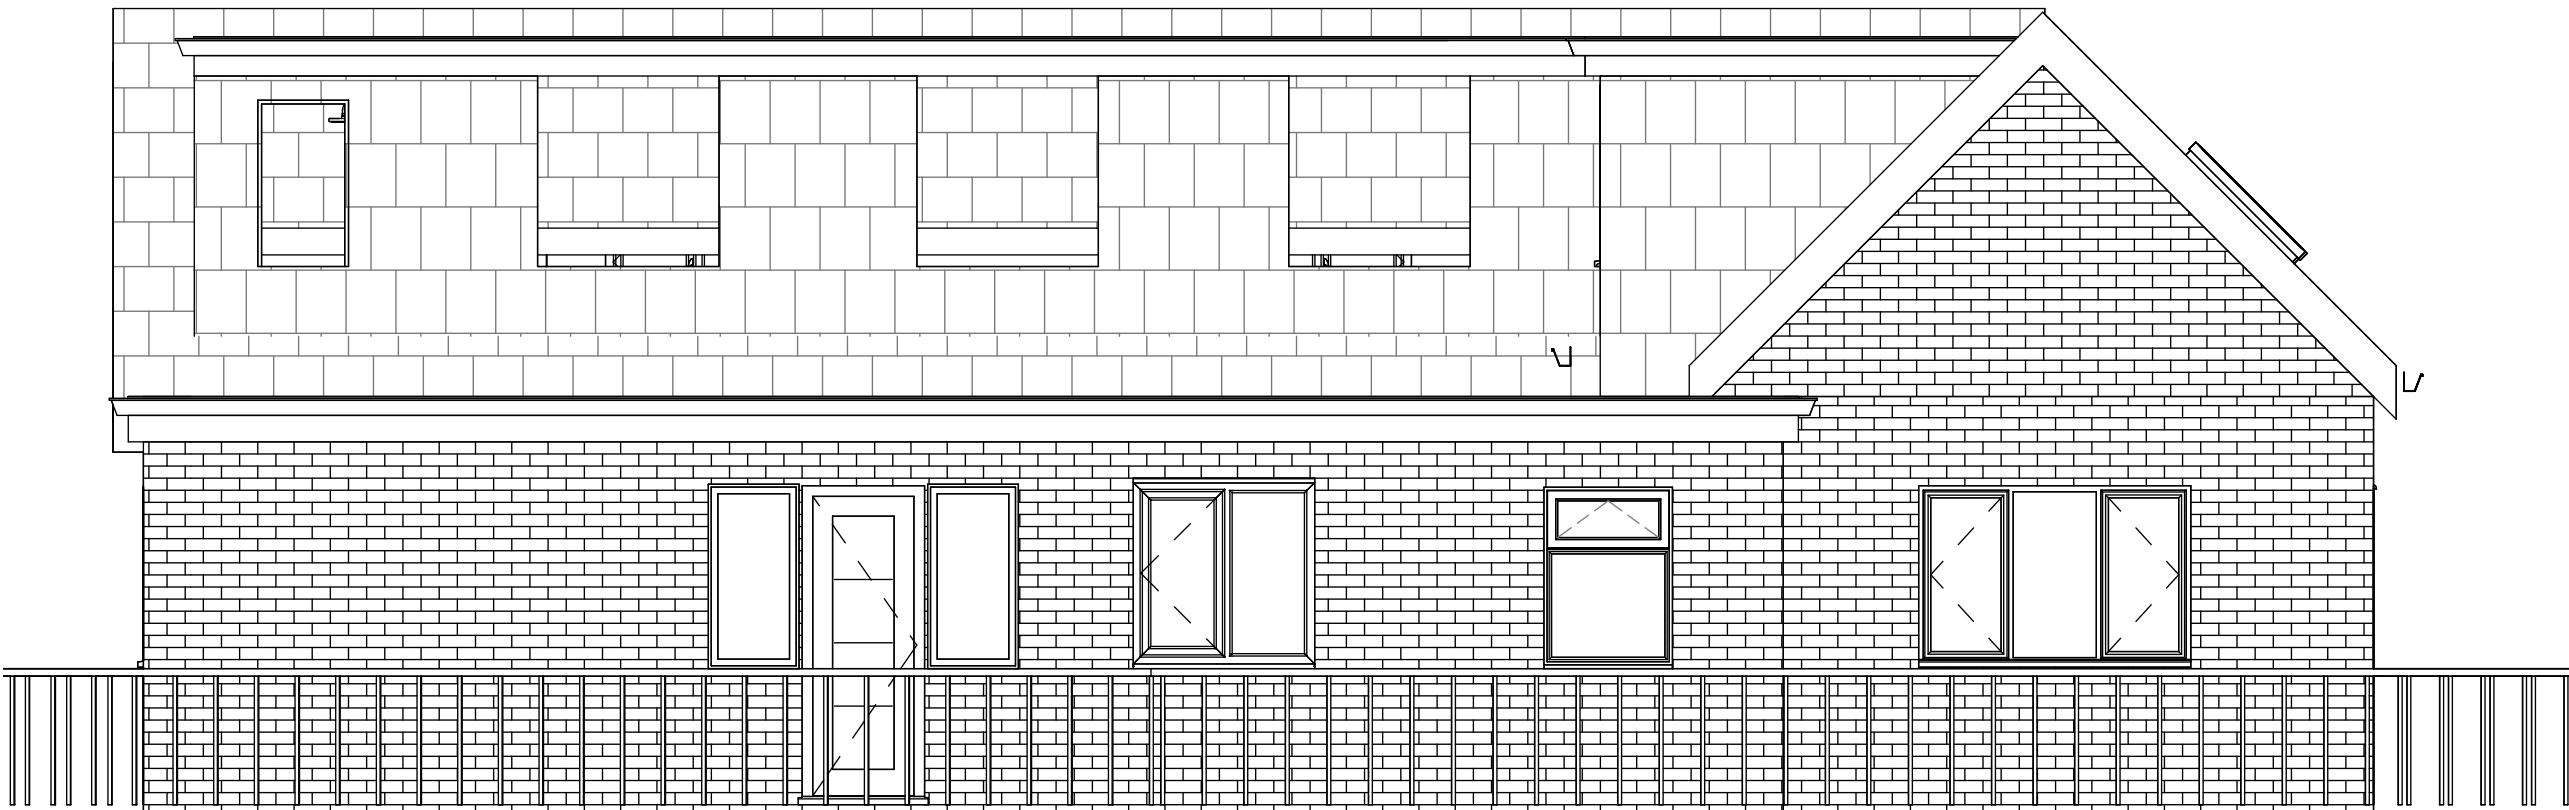


South Elevation
Scale 1:50
PROPOSED



North Elevation
Scale 1:50
PROPOSED



West Elevation
Scale 1:50
PROPOSED

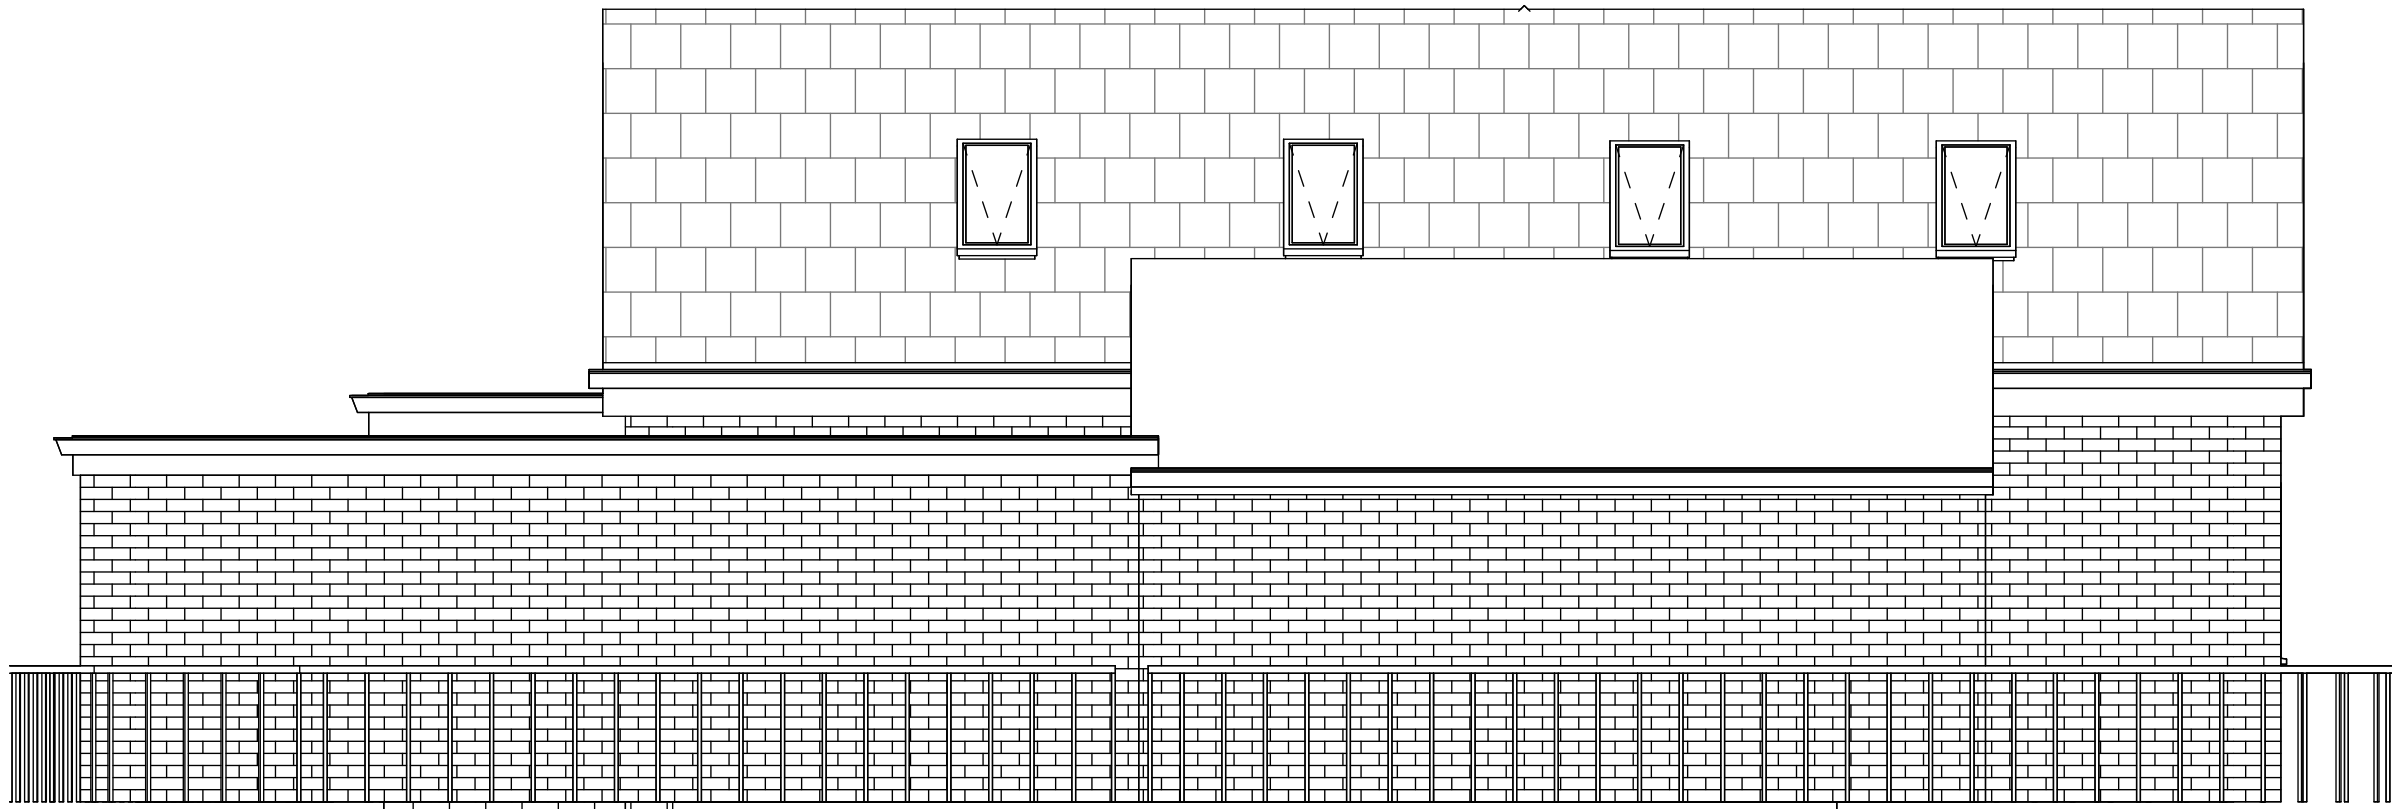

East Elevation
Scale 1:50
PROPOSED