




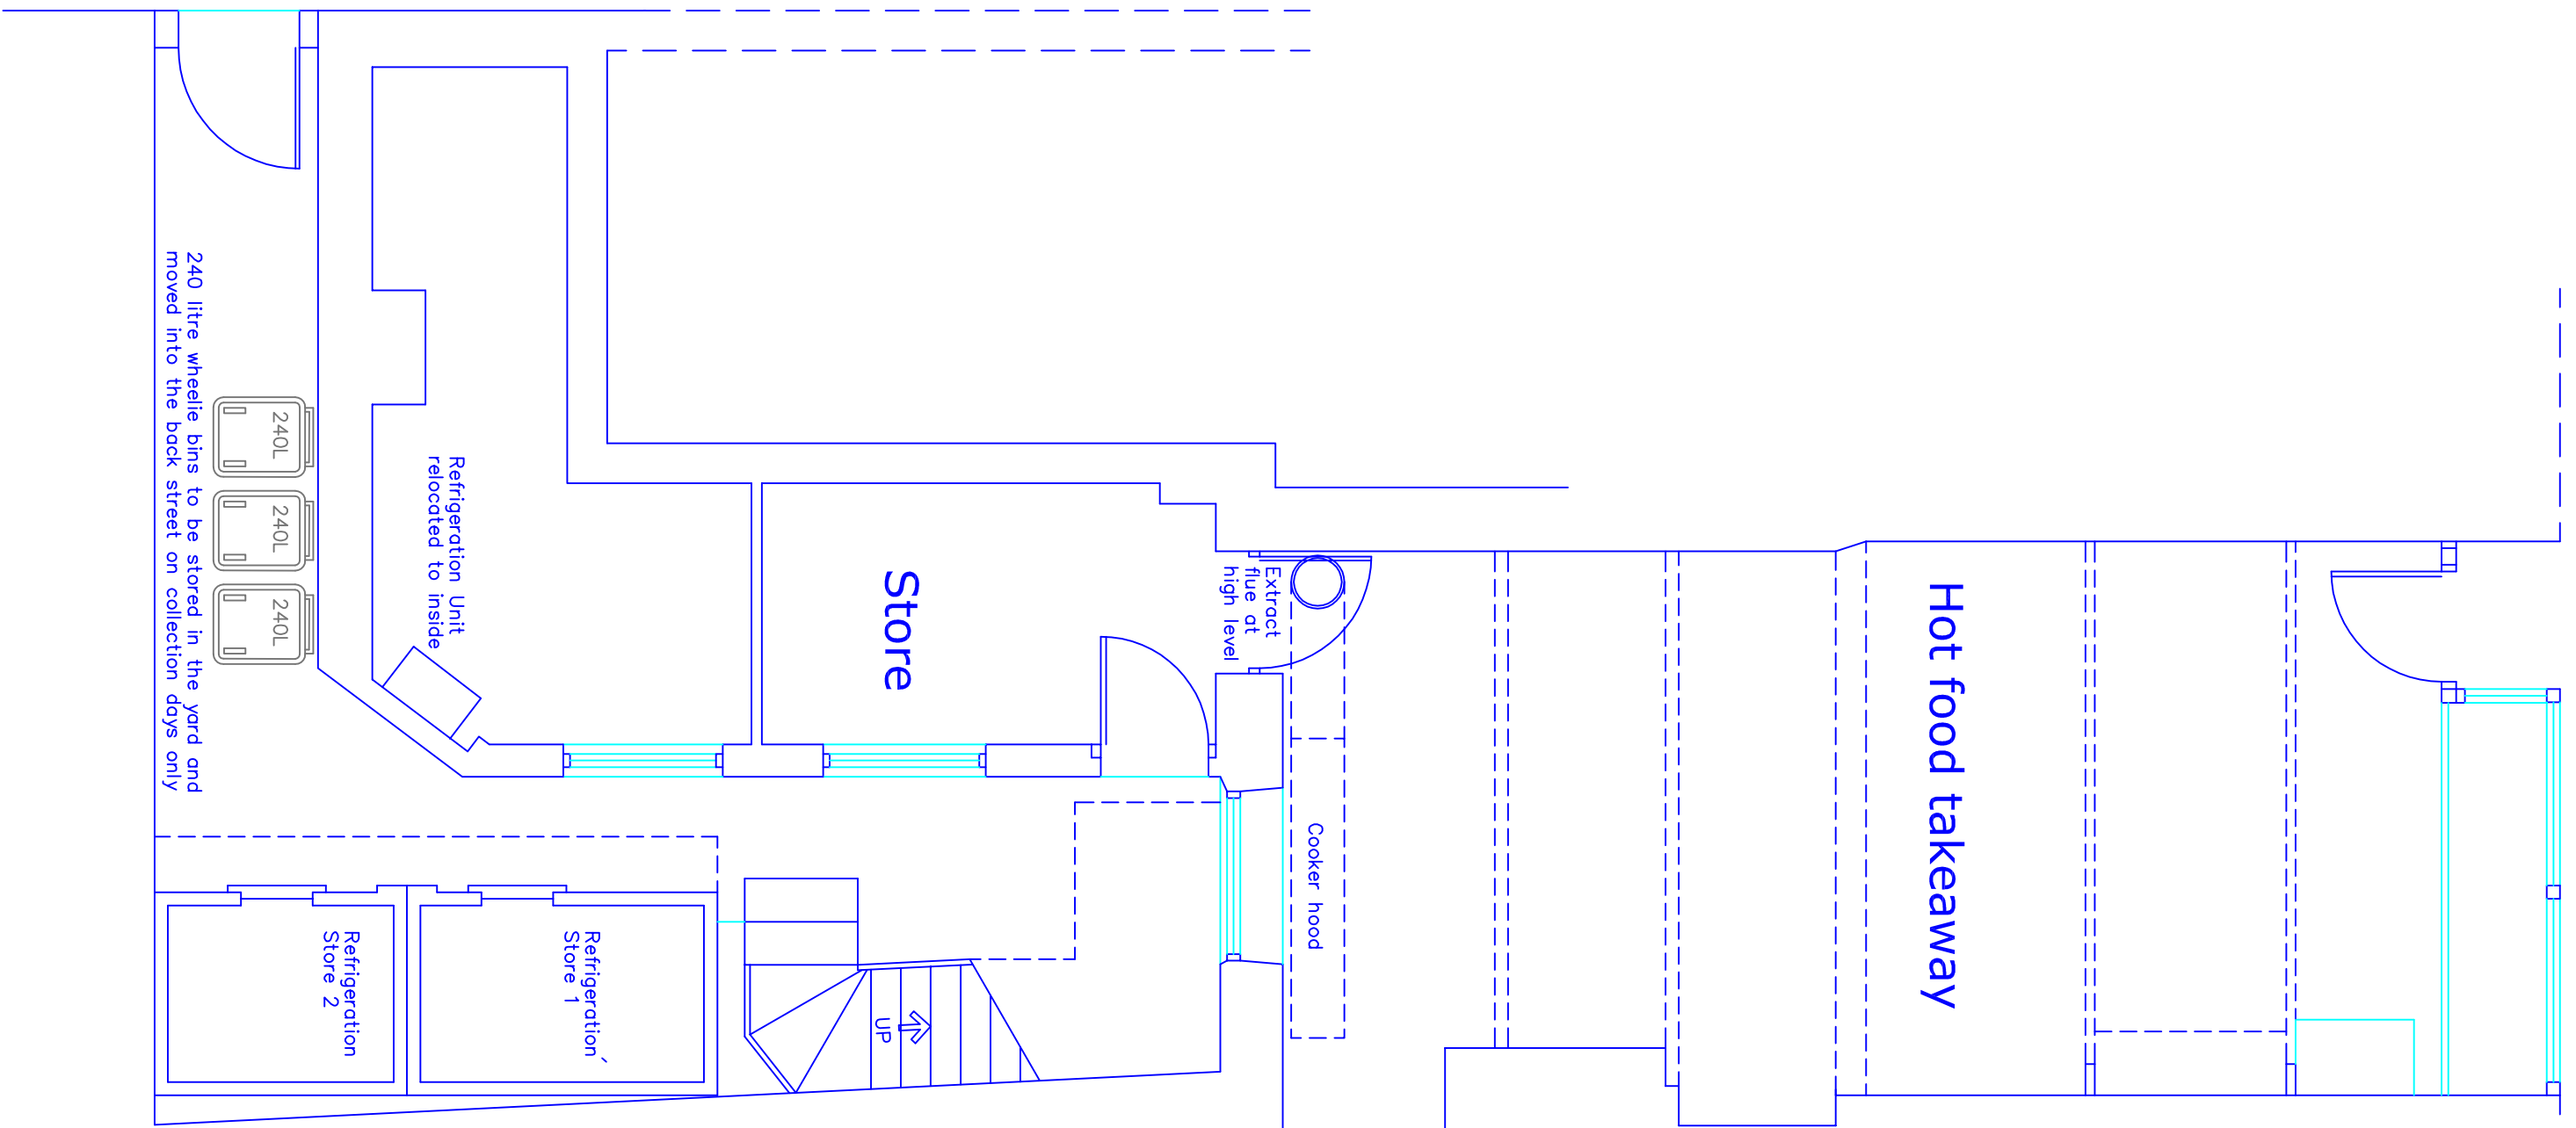


Proposed Plan  
Ground Floor

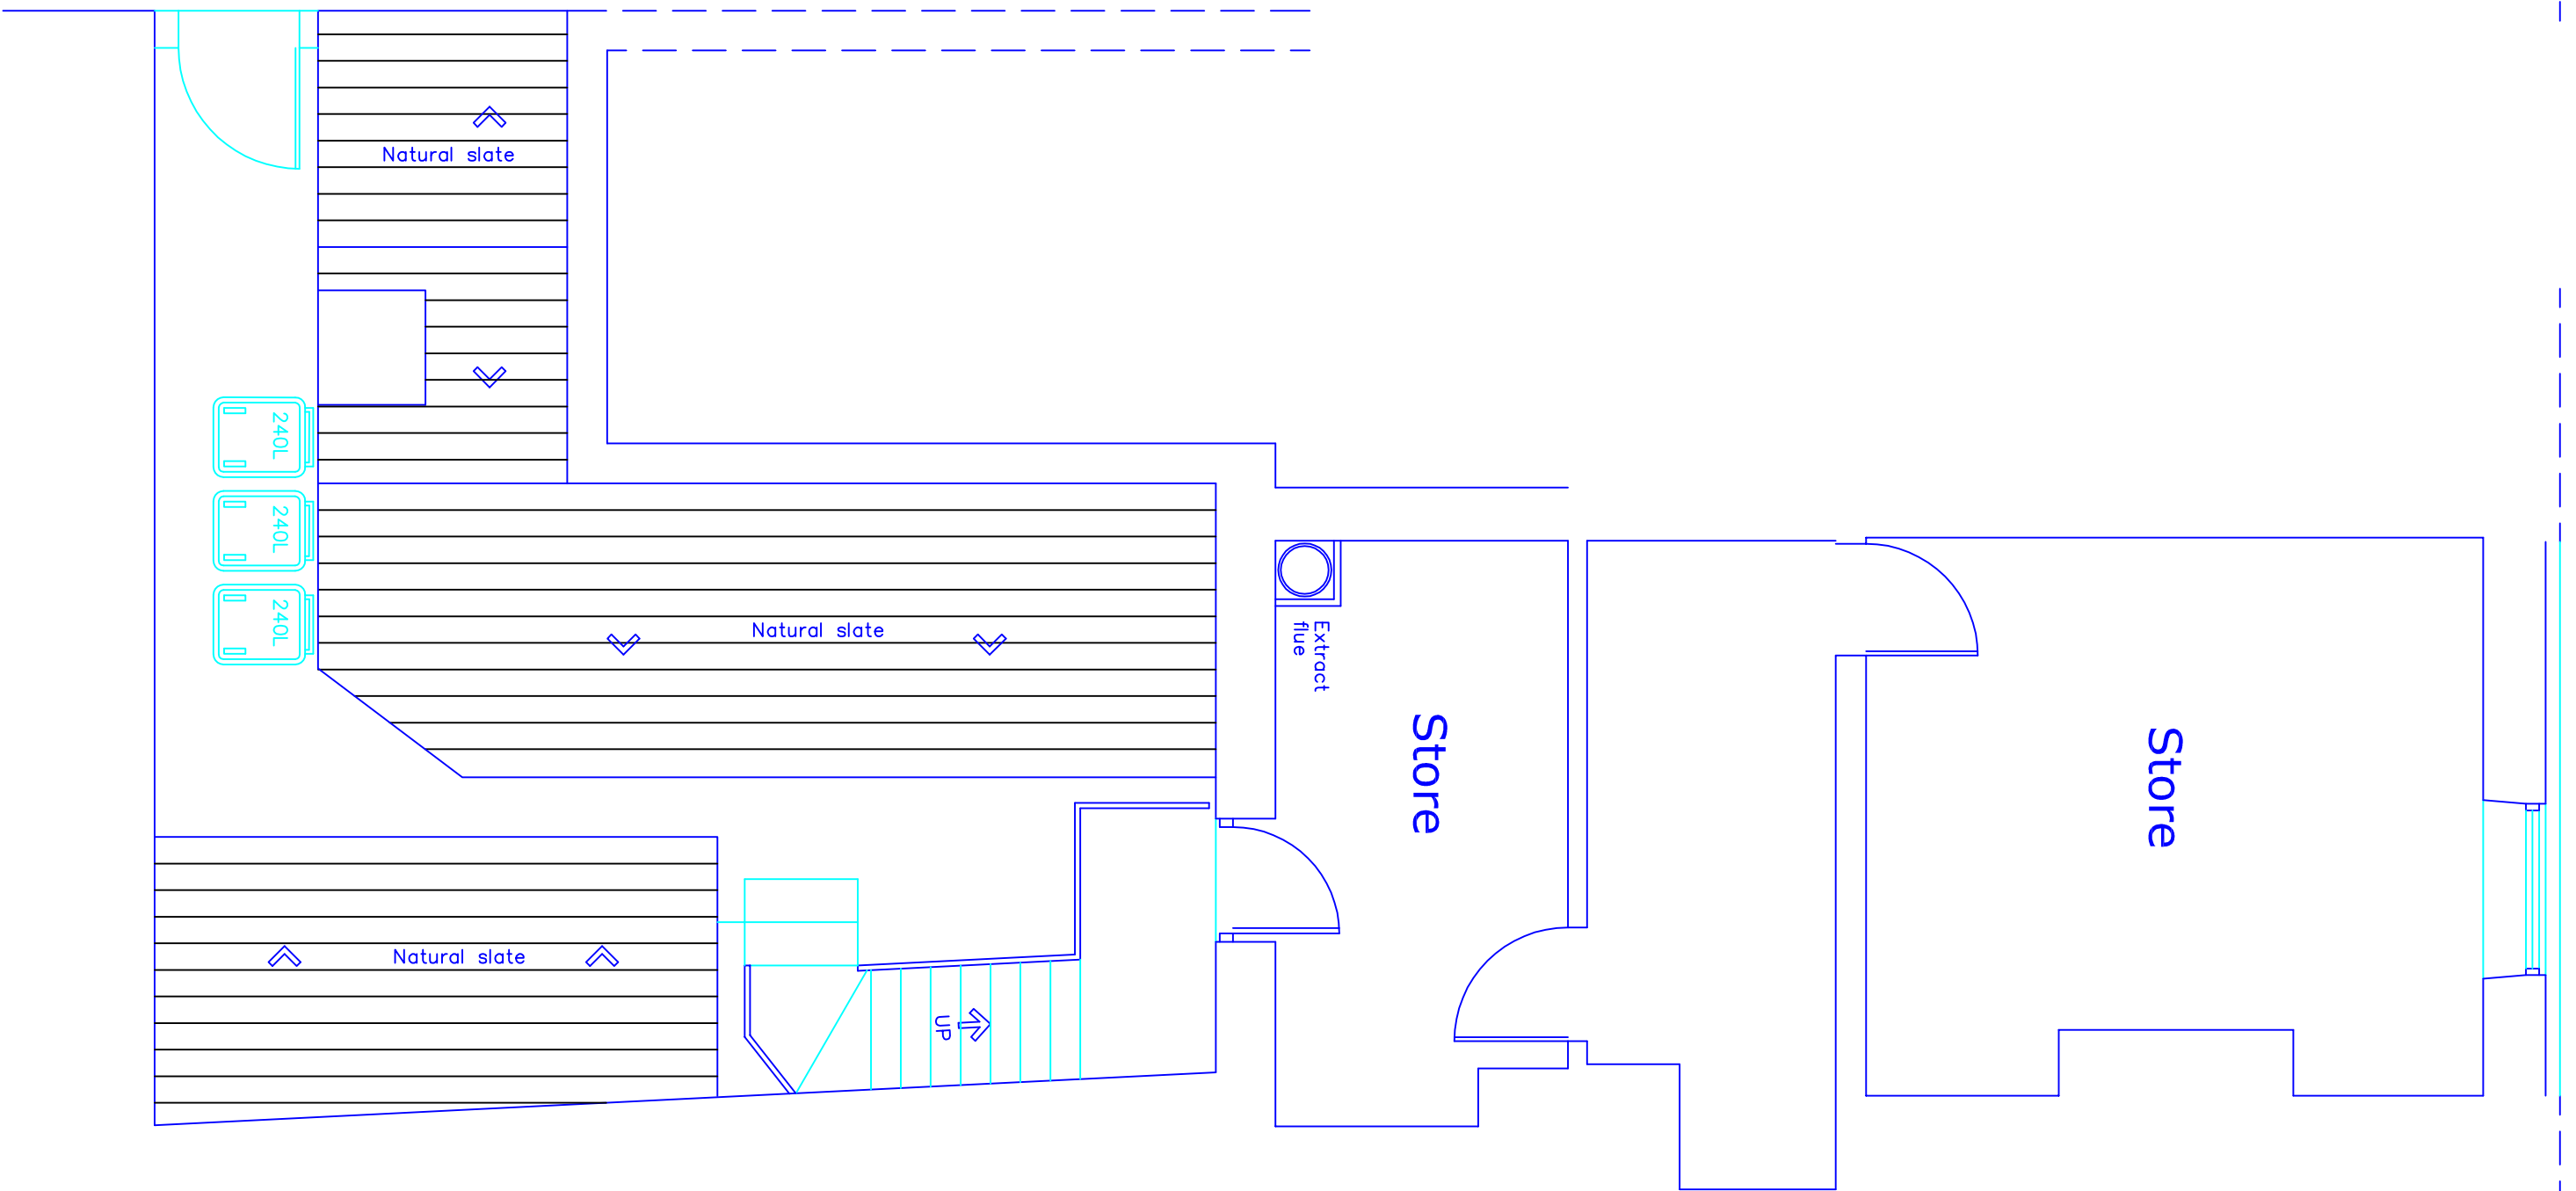


Proposed Plan  
First Floor

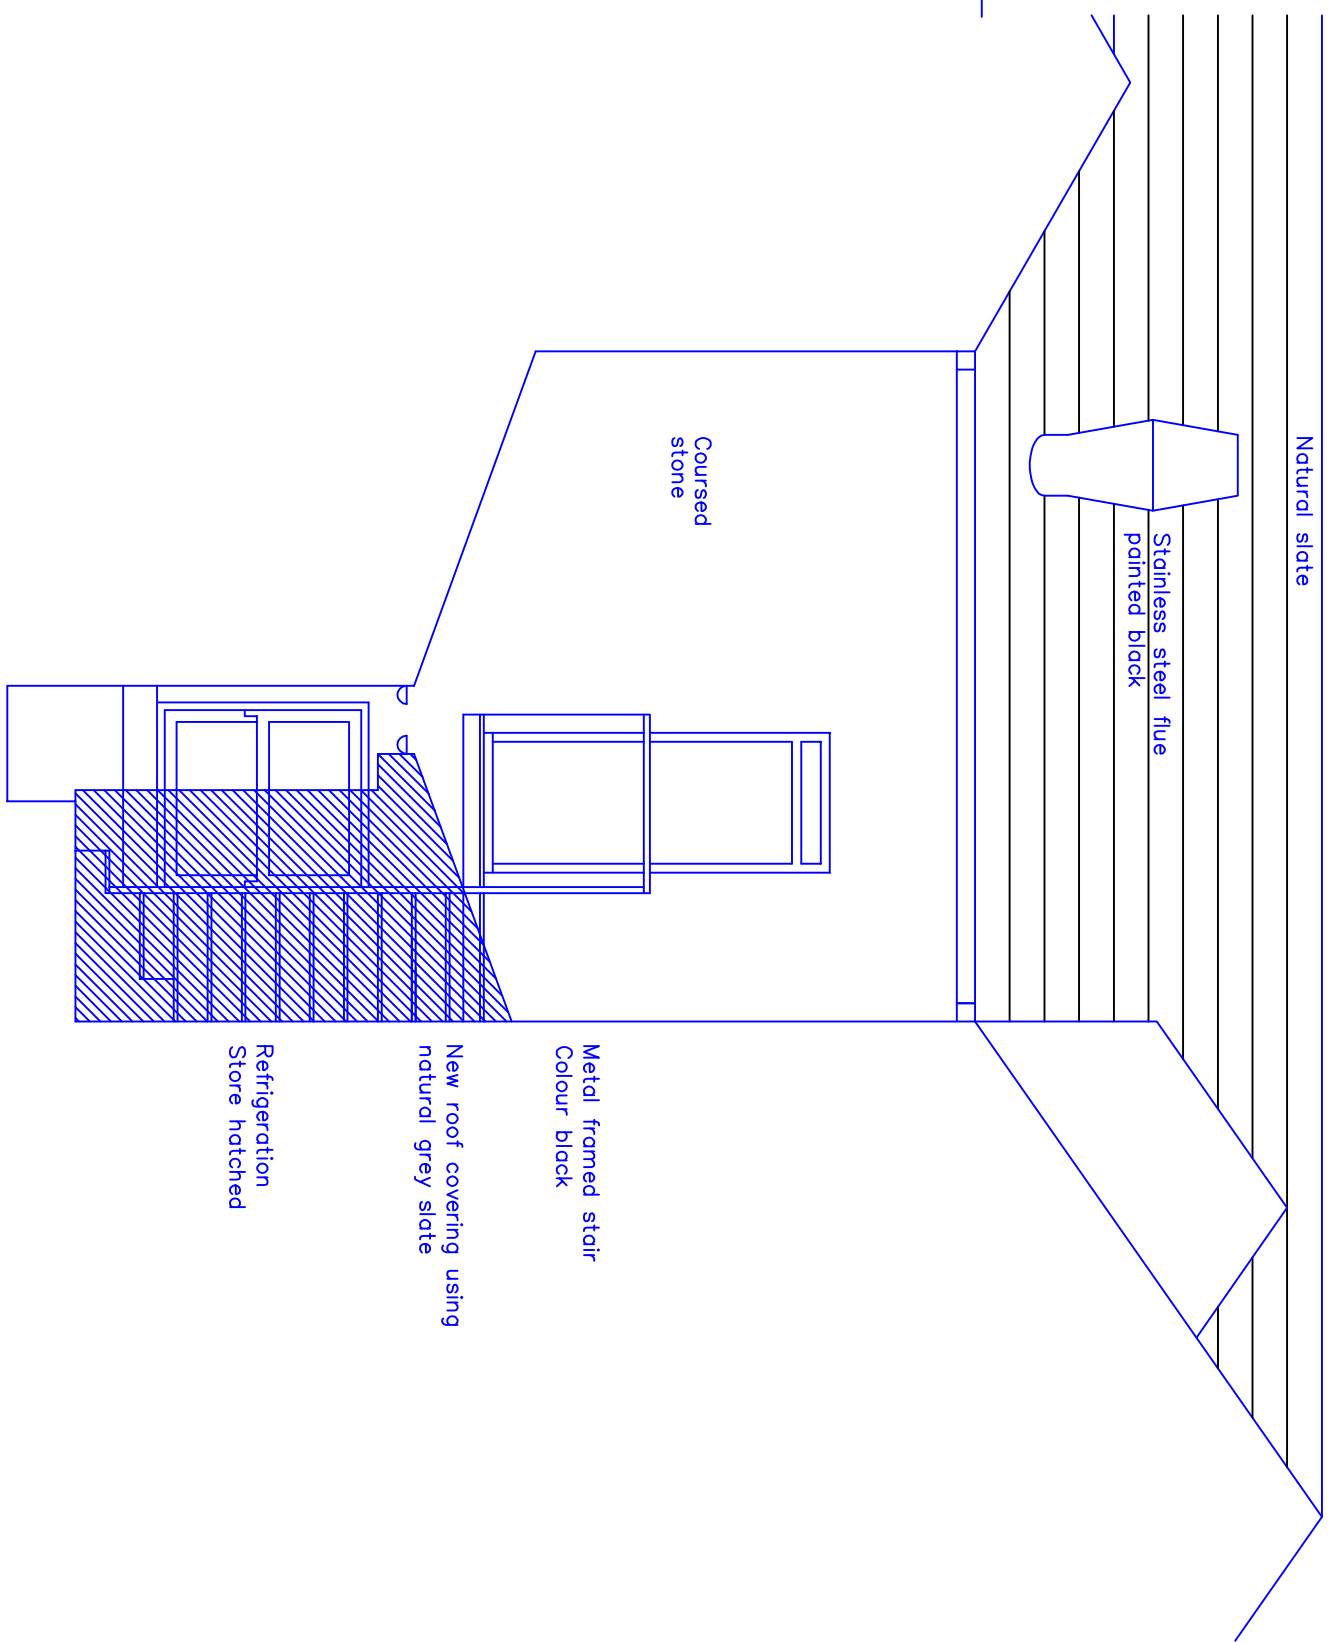


Proposed Rear Elevation

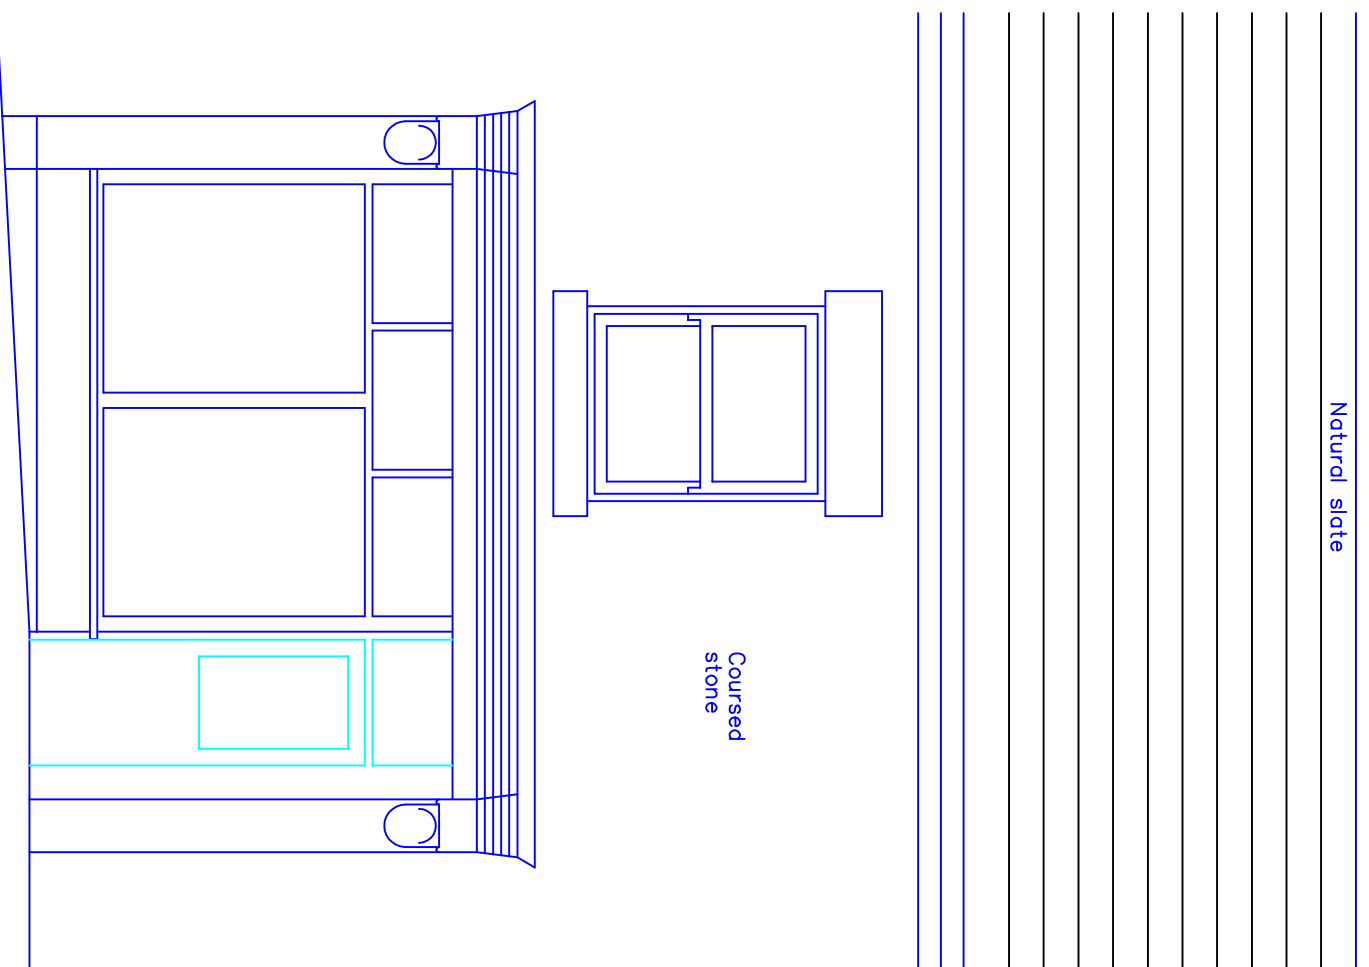

Proposed Front Elevation

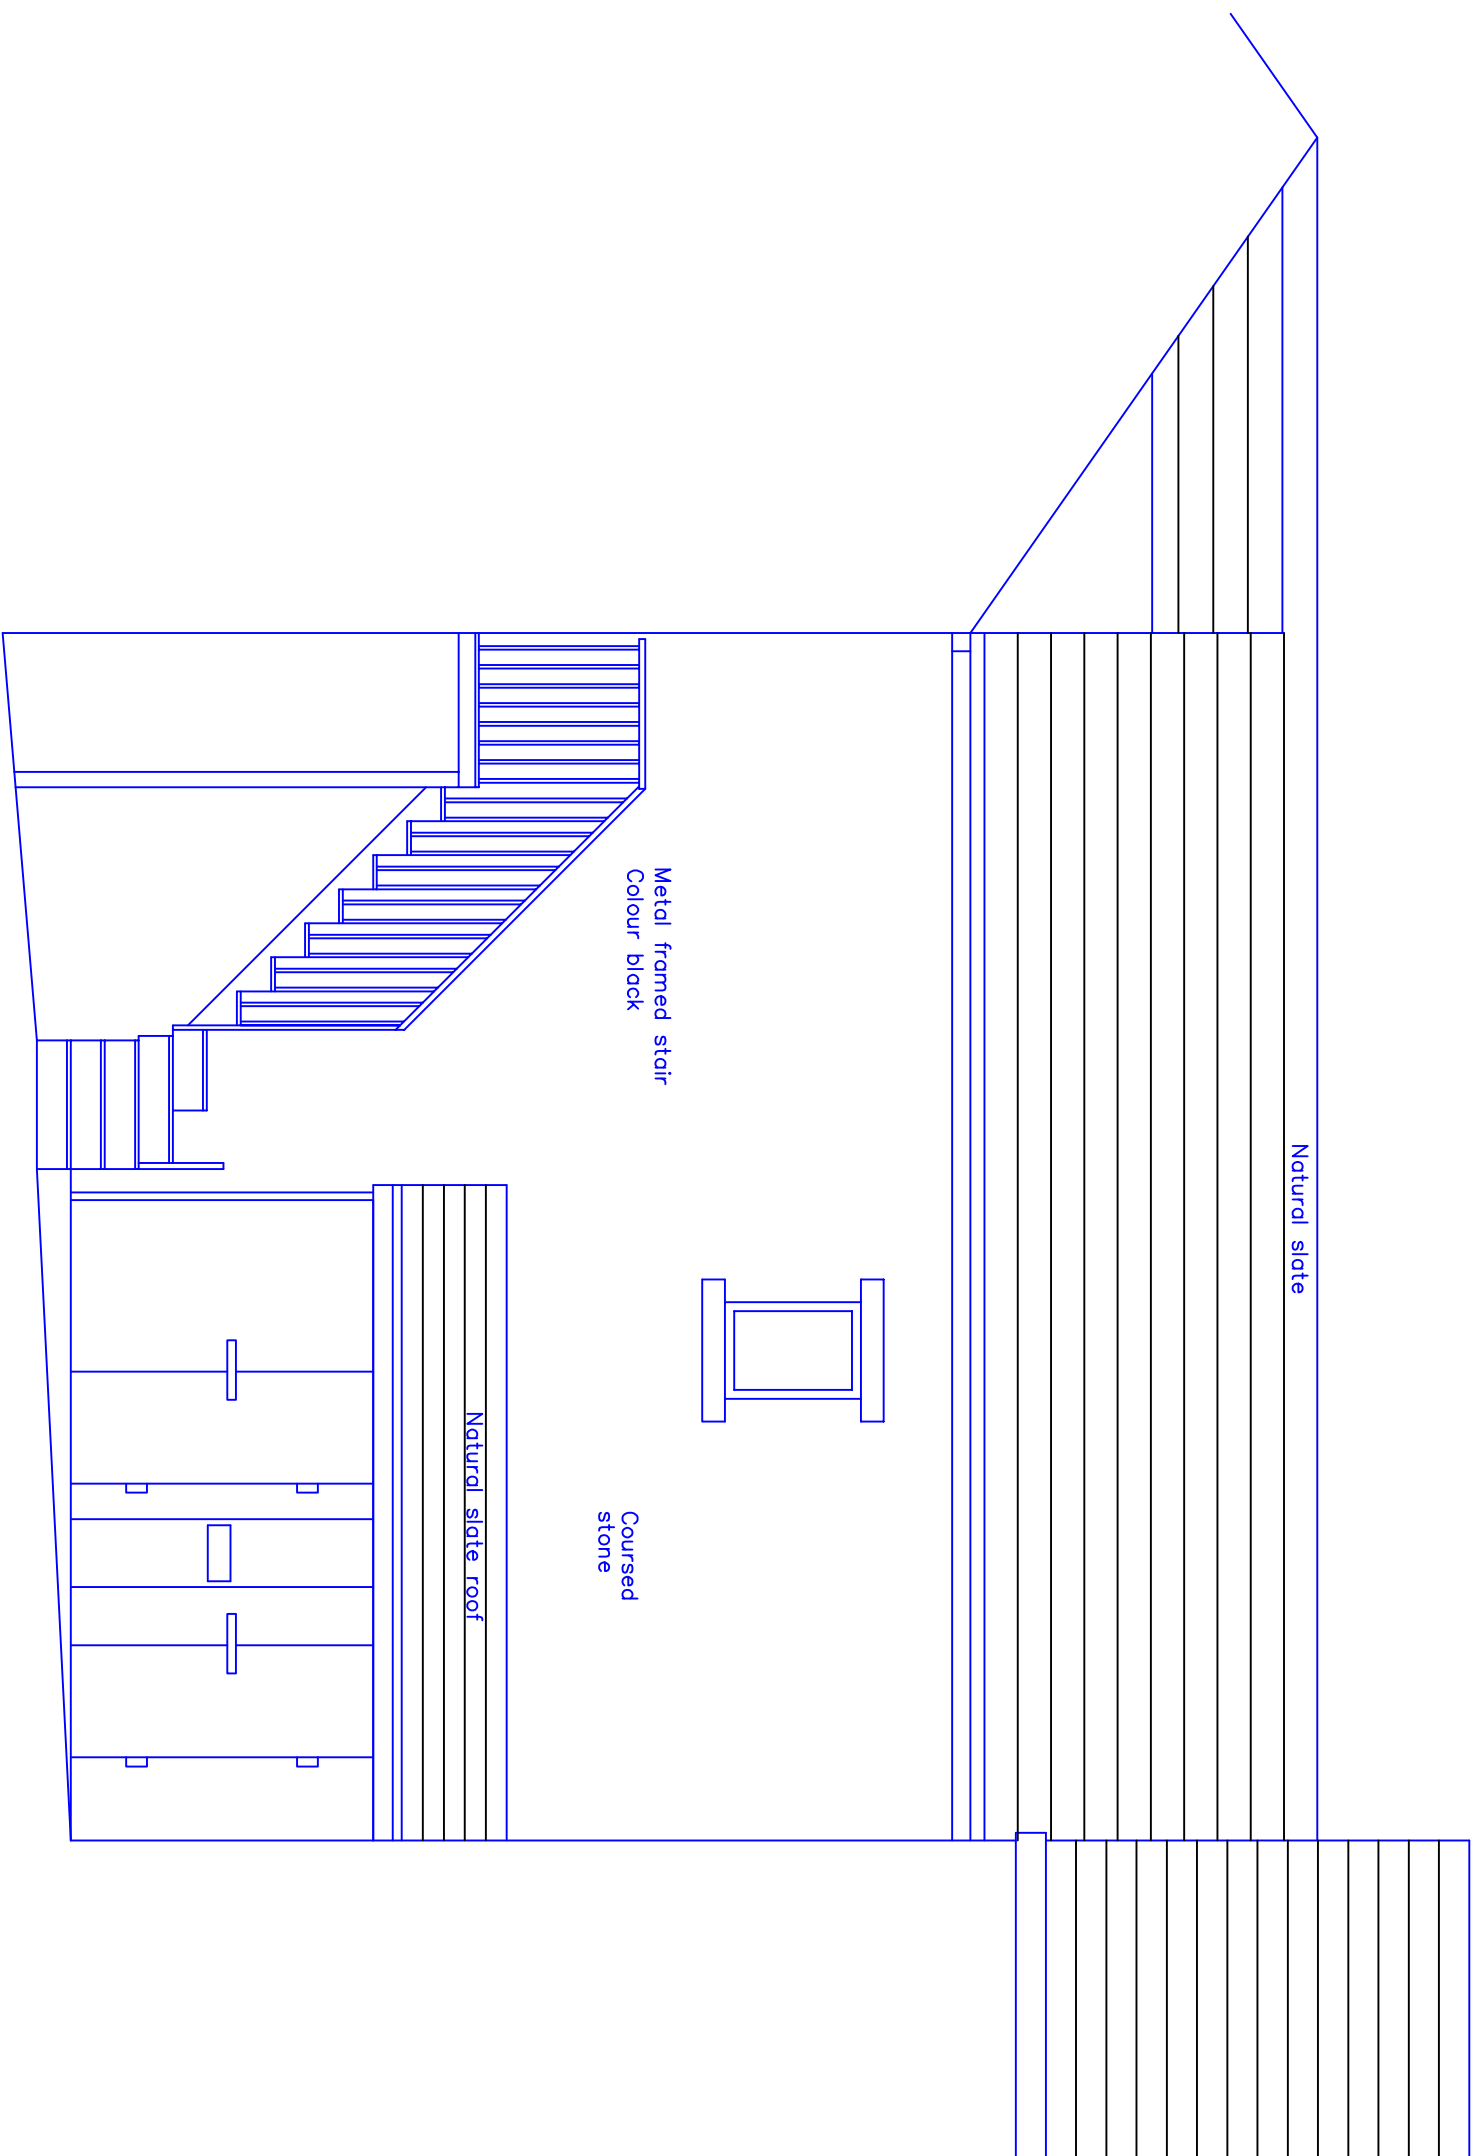

Proposed Side Elevation

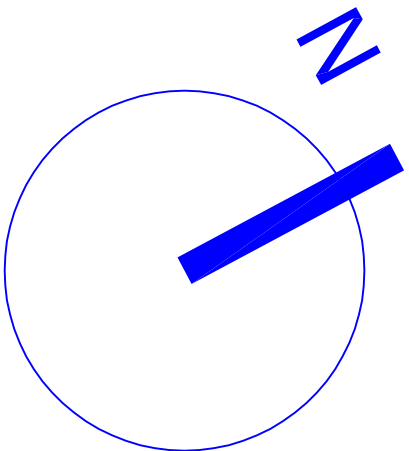

- D Site roof added over refrigeration 18.11.2021
- C Rear stair amended as-built 02.11.2020
- B Refrigeration as installed with canopy 14.09.2020
- A Extract flue internal
- A Side elevation added with stair
- A Bins indicated / flue reduced in height 20.08.2020

This drawing and design concept is the property of PPV design. It should not be reproduced without written permission

0 1 2 3 m

62 Bridge Street  
Rambottom  
BLD 9AG  
scale 1:50 @ A1  
June 2020

PM7-02D  
Proposed Plans & Elevations

PPV design Ltd

2 Helmshore Road, Holcombe Village  
Rambottom, Lancashire BL8 4PA  
Gary Dearden (JK home) DpArch RJBA  
gar@ppv-design.co.uk www.ppv-design.co.uk  
T: 01706 622175 M: 07112 669482