




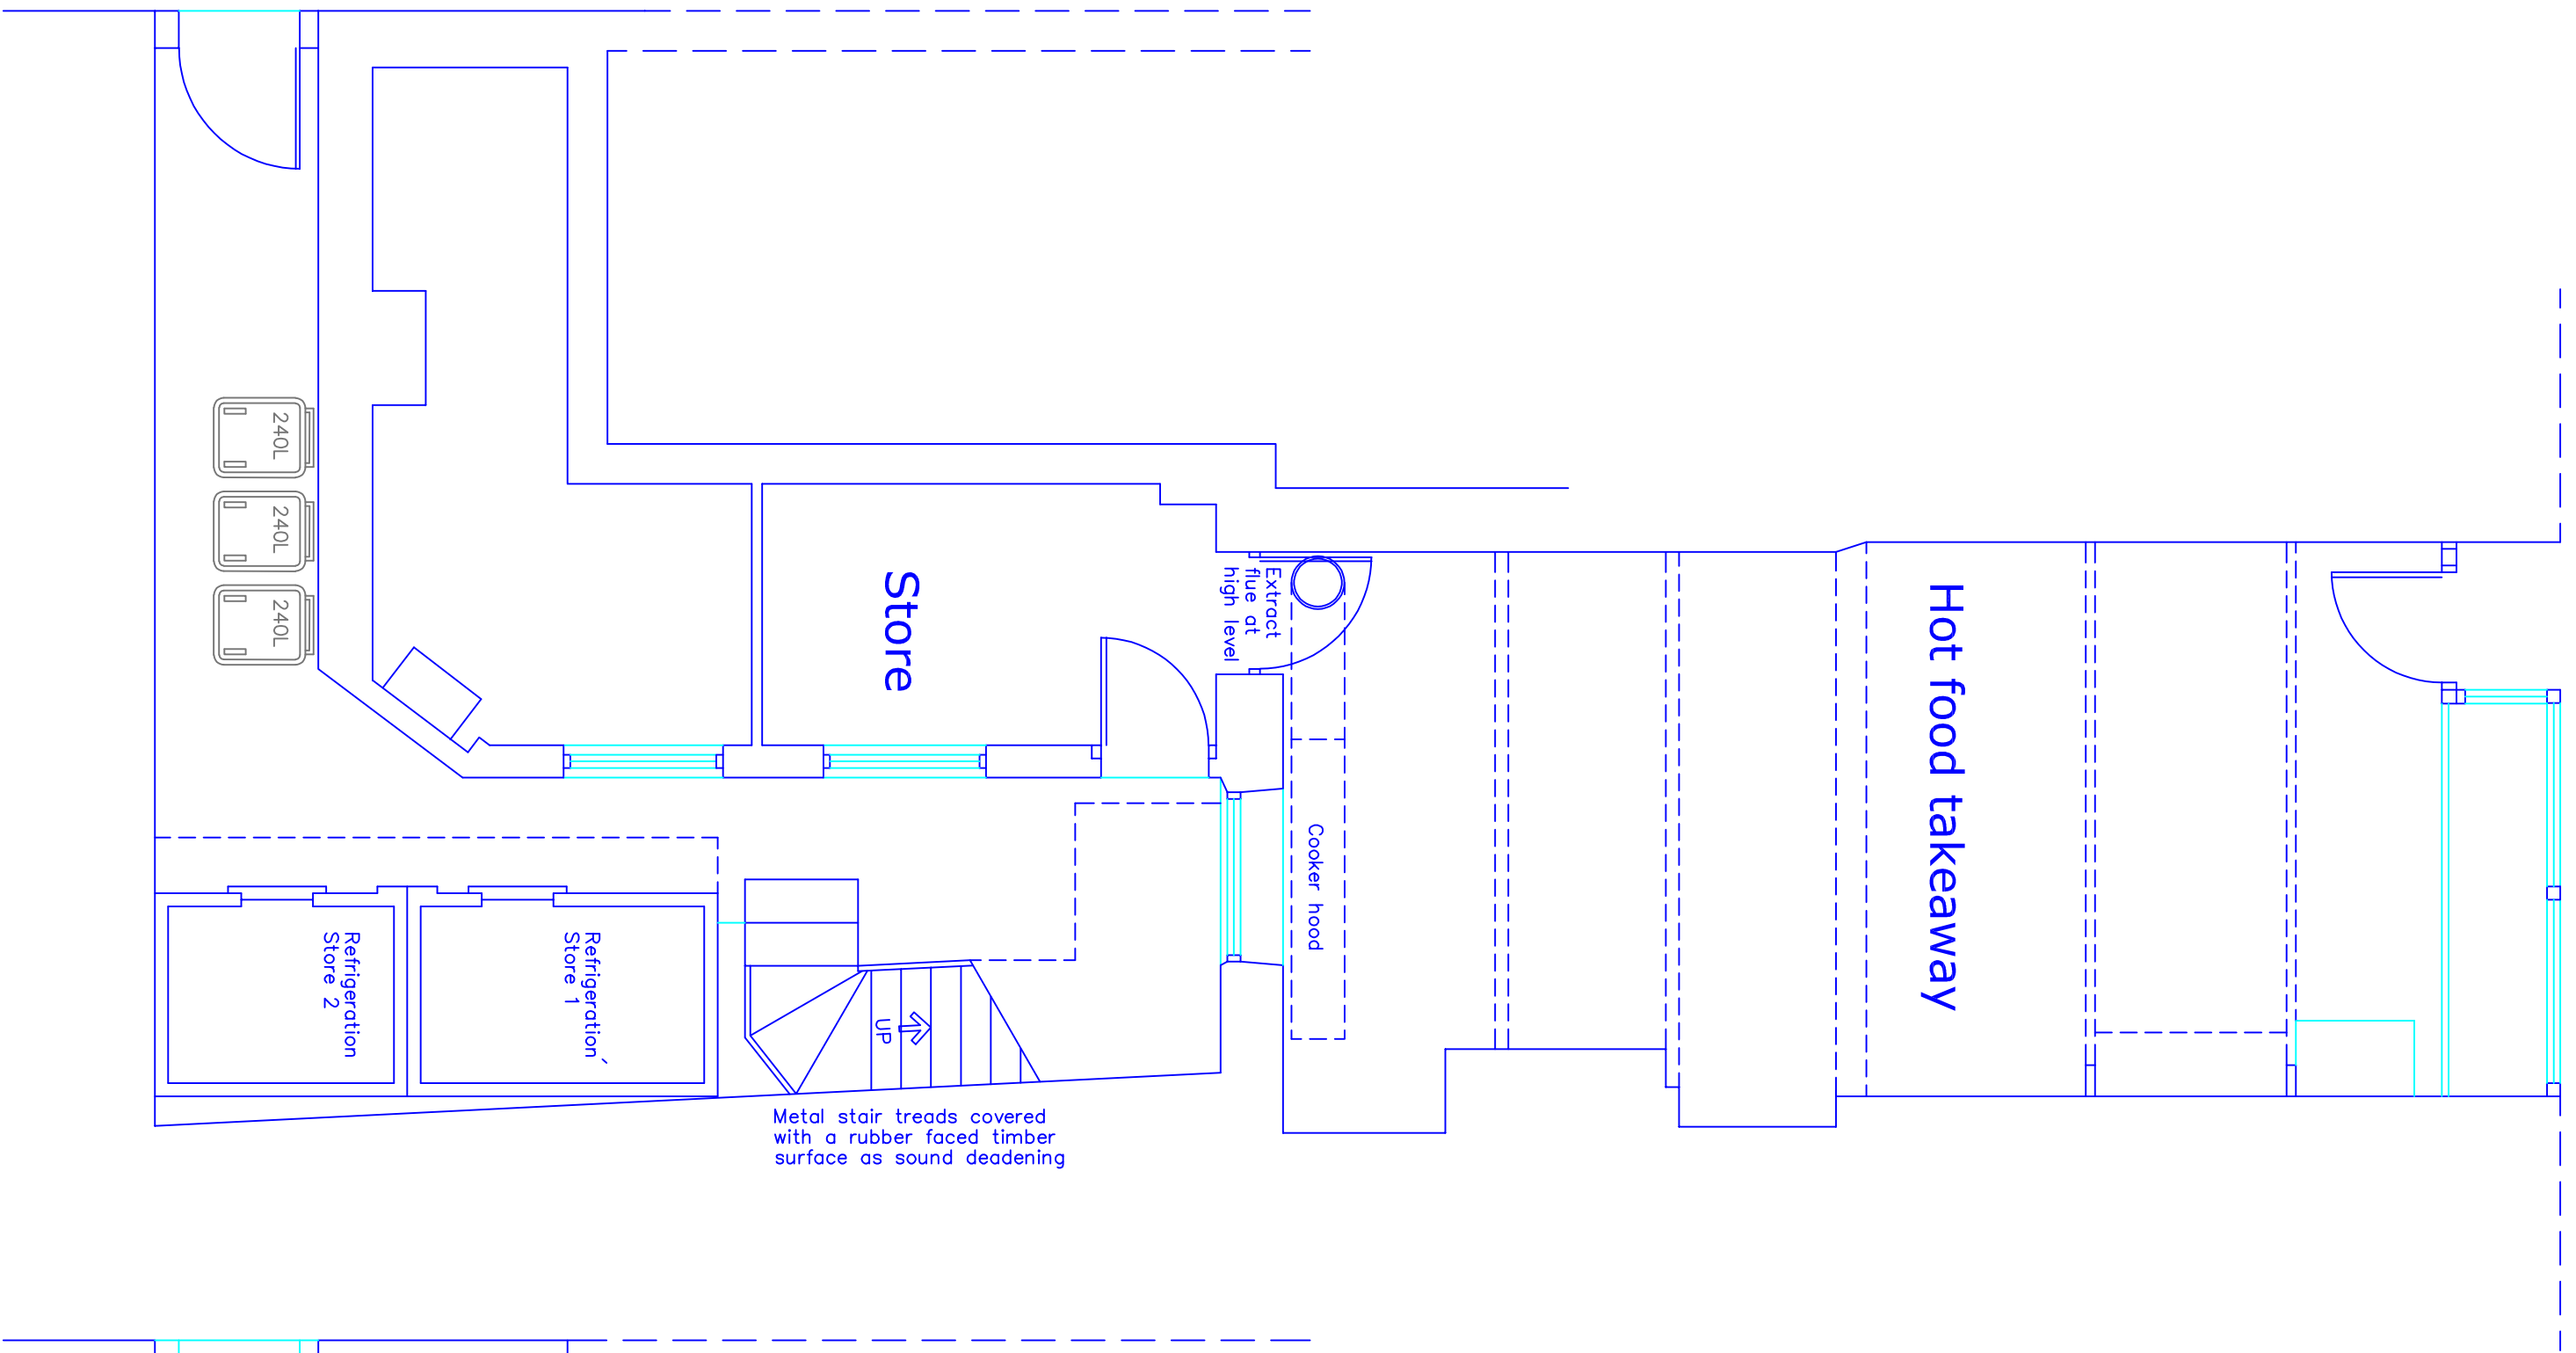


Proposed Plan
Ground Floor

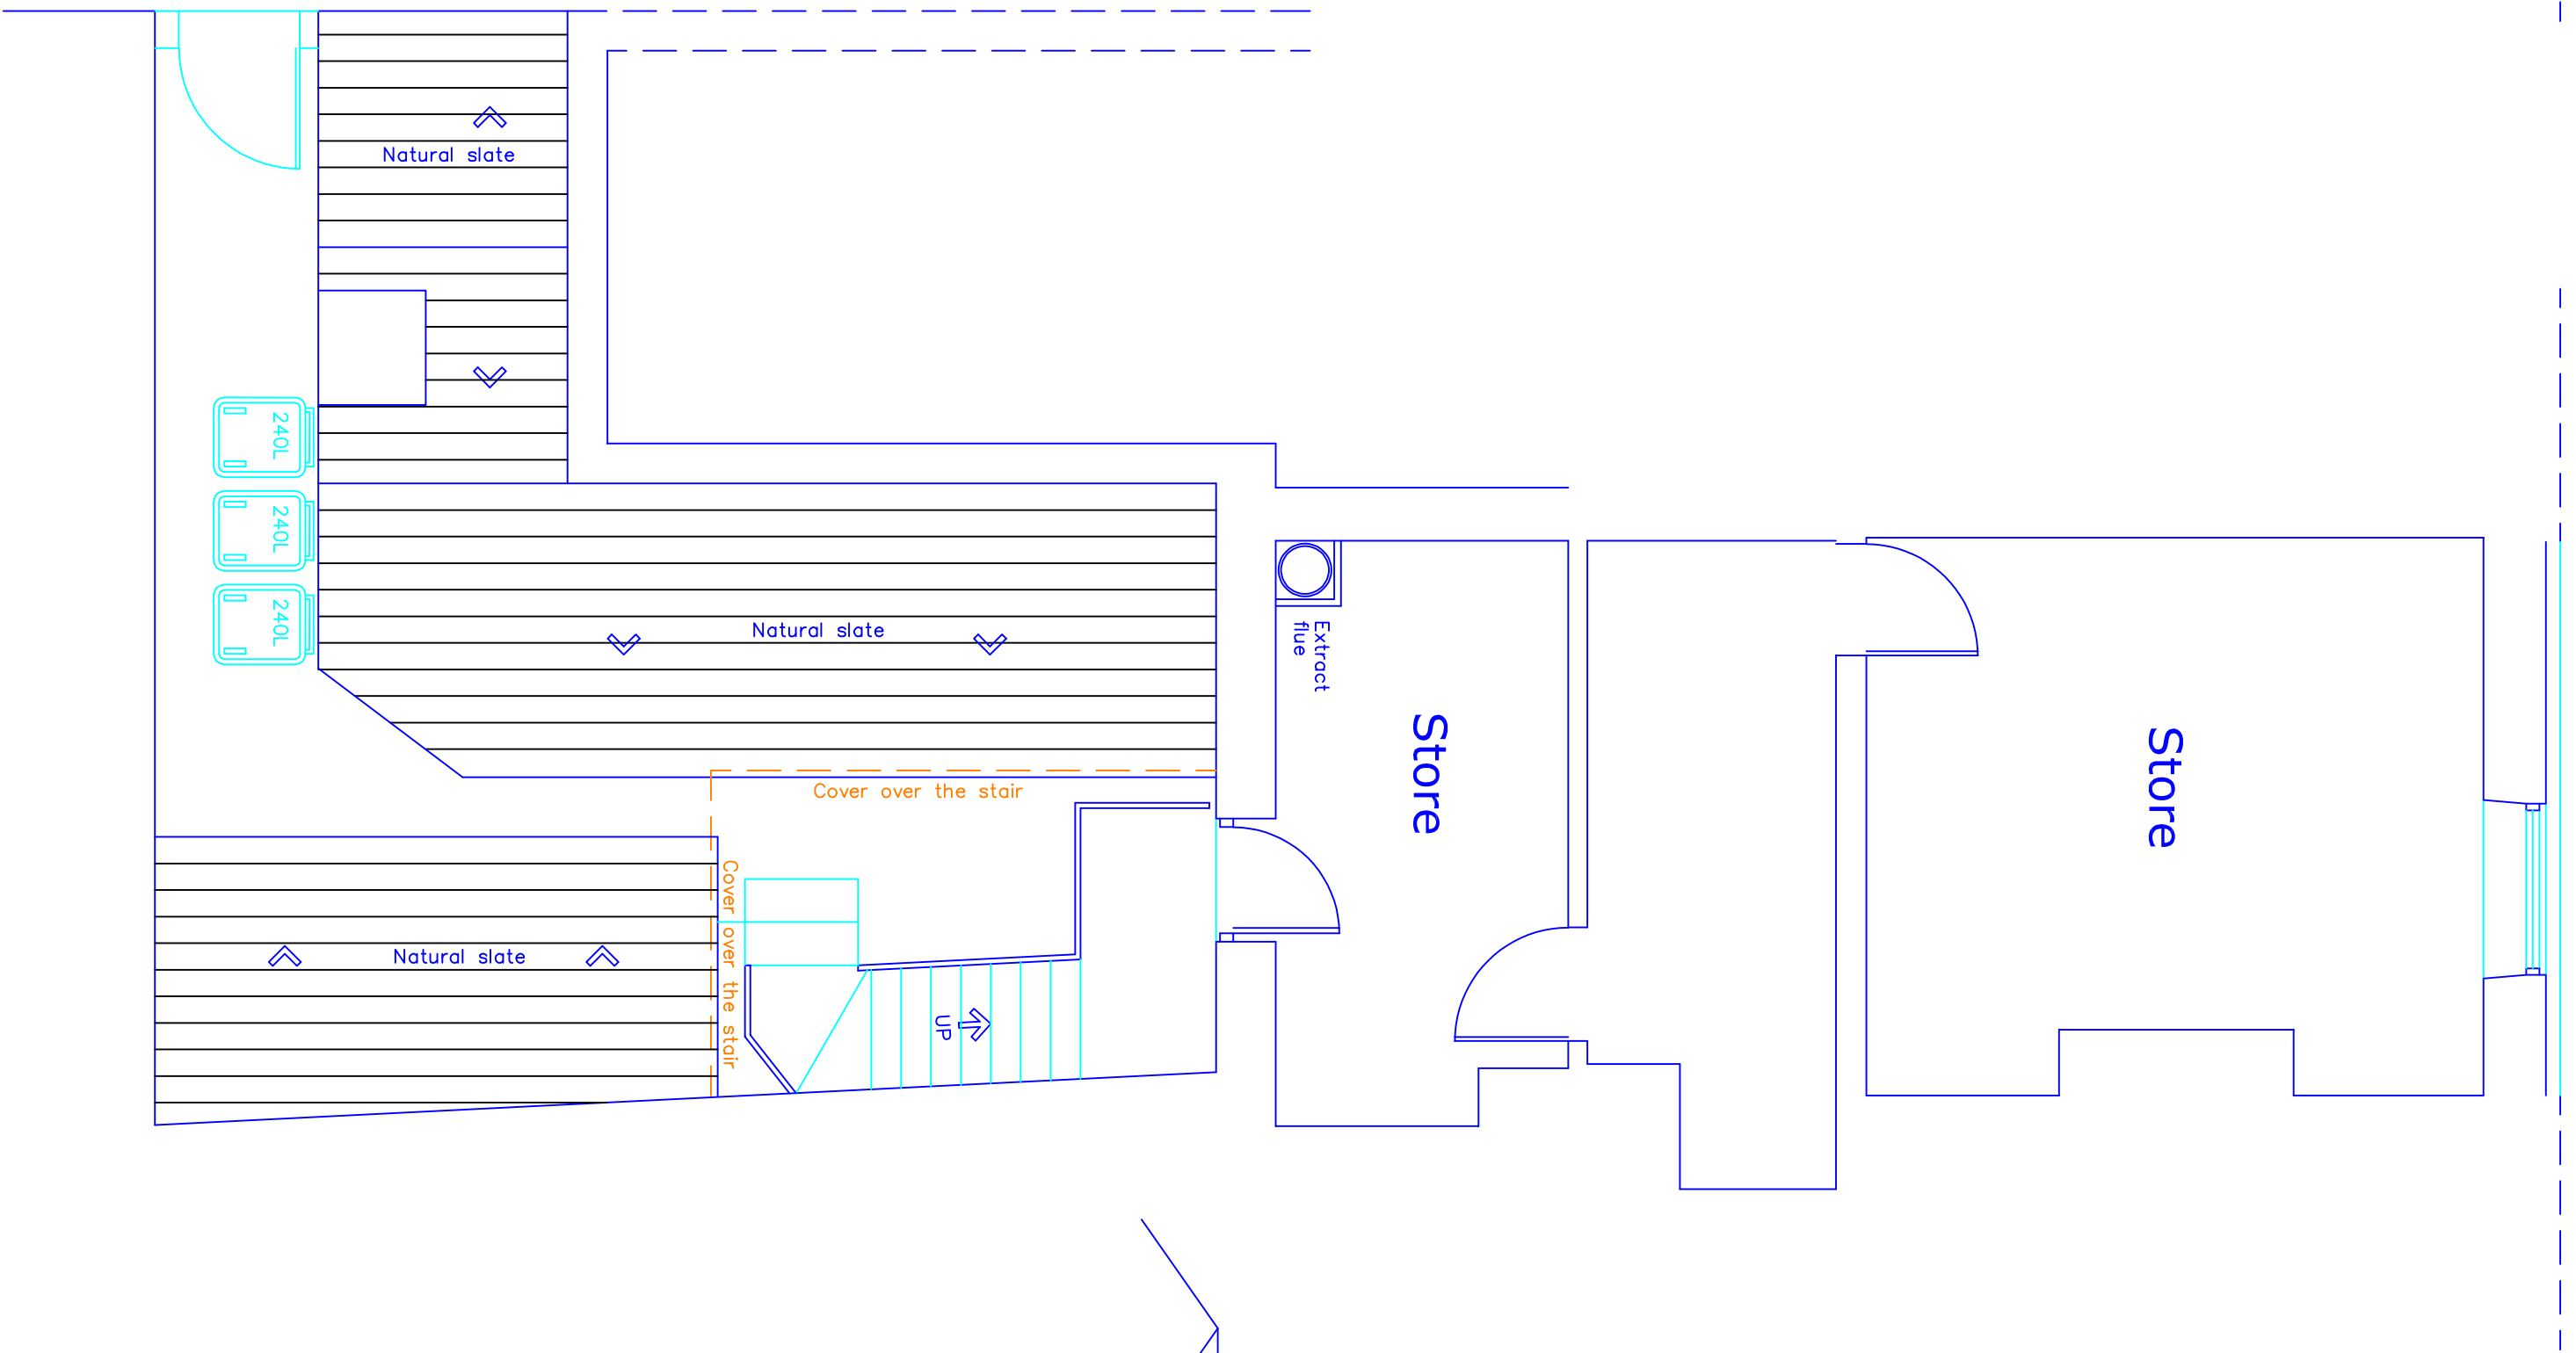


Proposed Plan
First Floor

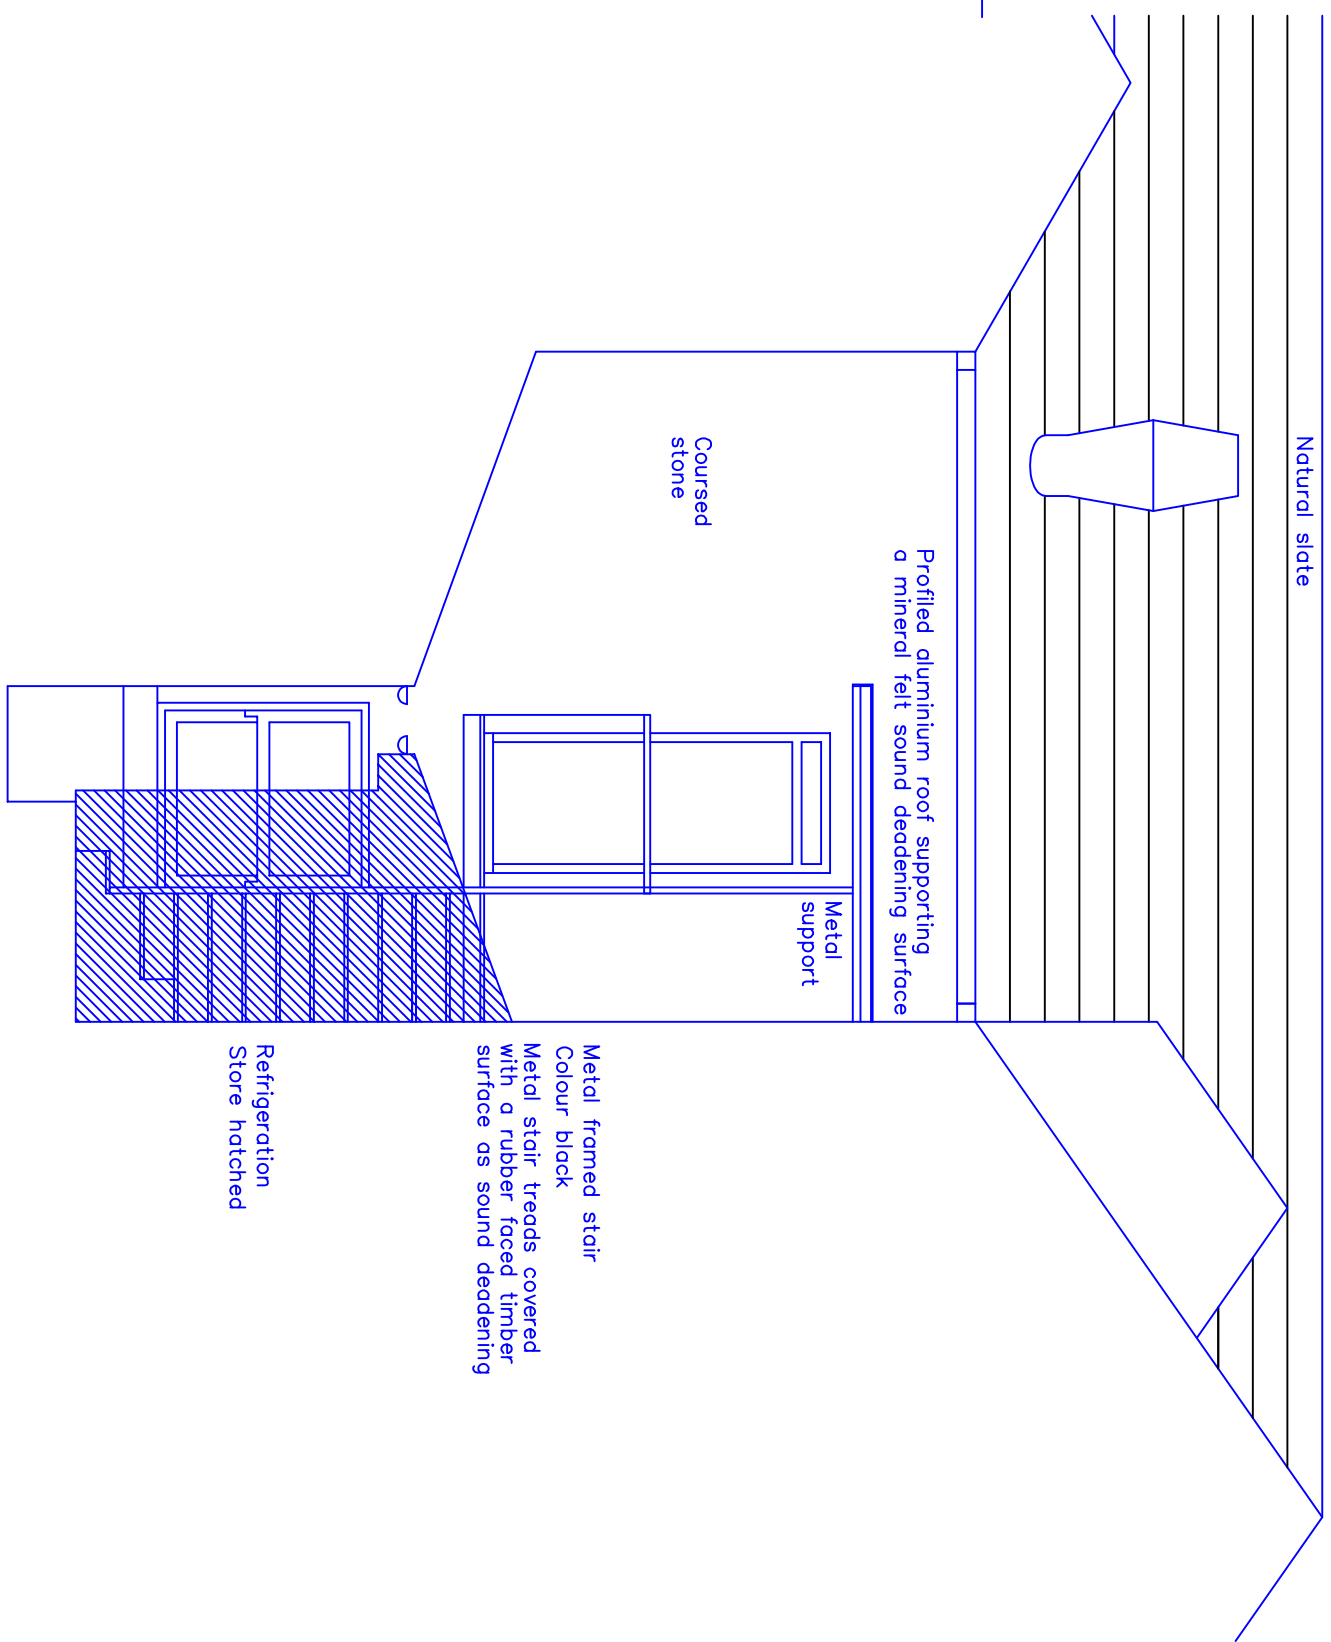

Proposed Rear Elevation

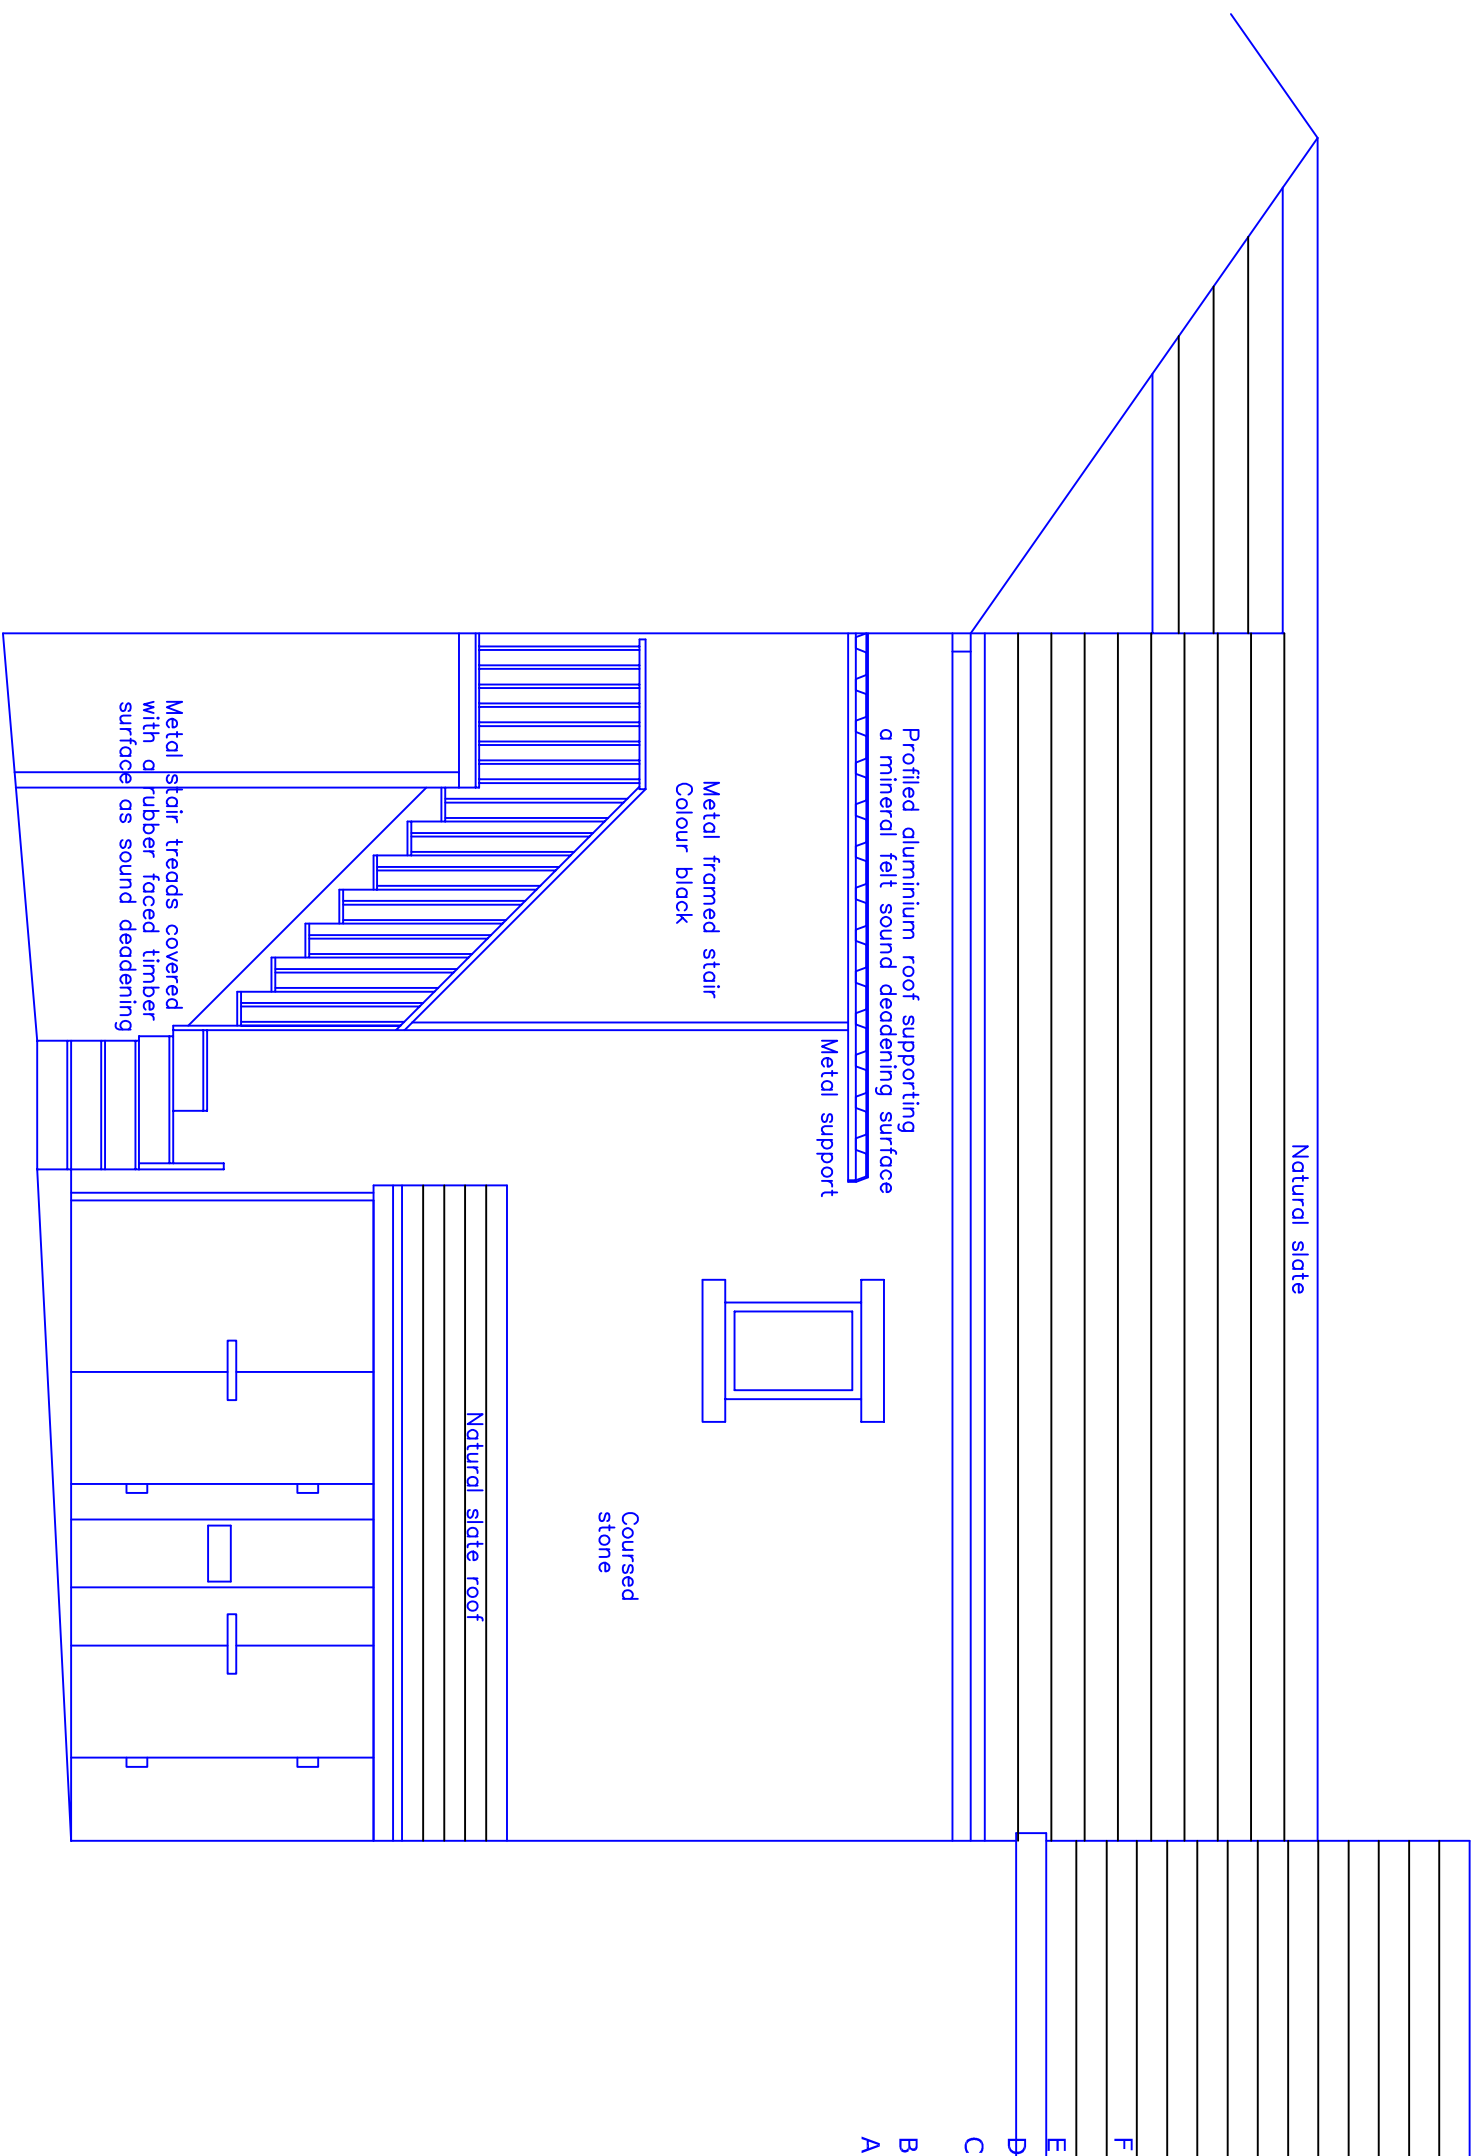

Proposed Side Elevation

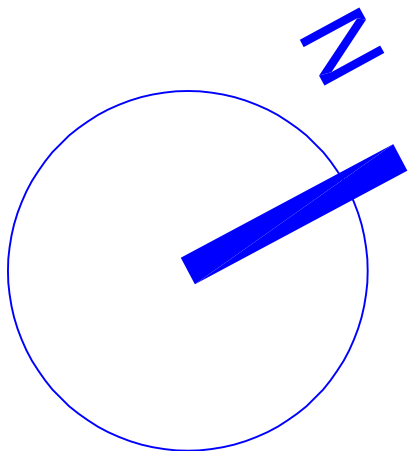

- F Rubber added to the timber treads
- E Felt added to the canopy as sound deadening
- D Cover added over the stairs
- C Slate roof added over refrigeration
- B Rear stair amended as-built
- A Refrigeration as installed with canopy
- Side elevation added with stair
- Bins indicated / Felt reduced in height

This drawing and design concept is the property of PPV design. It should not be reproduced without written permission

0 1 2 3 m

62 Bridge Street
Ramsbottom
BL0 9AG
scale 1:50 @ A1
June 2020

Proposed Plans & Elevations
PM7-02F
P P V design Ltd

2 Helmshore Road, Helmshore Village
Ramsbottom, Lancashire BL8 4PA
Gary Dearden (B&H) DipArch RIBA
gar@ppv-design.co.uk www.ppv-design.co.uk
T: 01706 622791 M: 07112 669482