


DRAWING UPDATES
02.03.26:

1. F18 boulders with seats reinstated at central steps.
2. P03 boulders at central steps reinstated.
3. Levels at central steps amended to meet reinstated boulders.
4. CCTV and lighting columns updated in key to reflect Bowker drawing reference, specification and coordinated locations.
5. Drainage coordinated with AJP latest information.

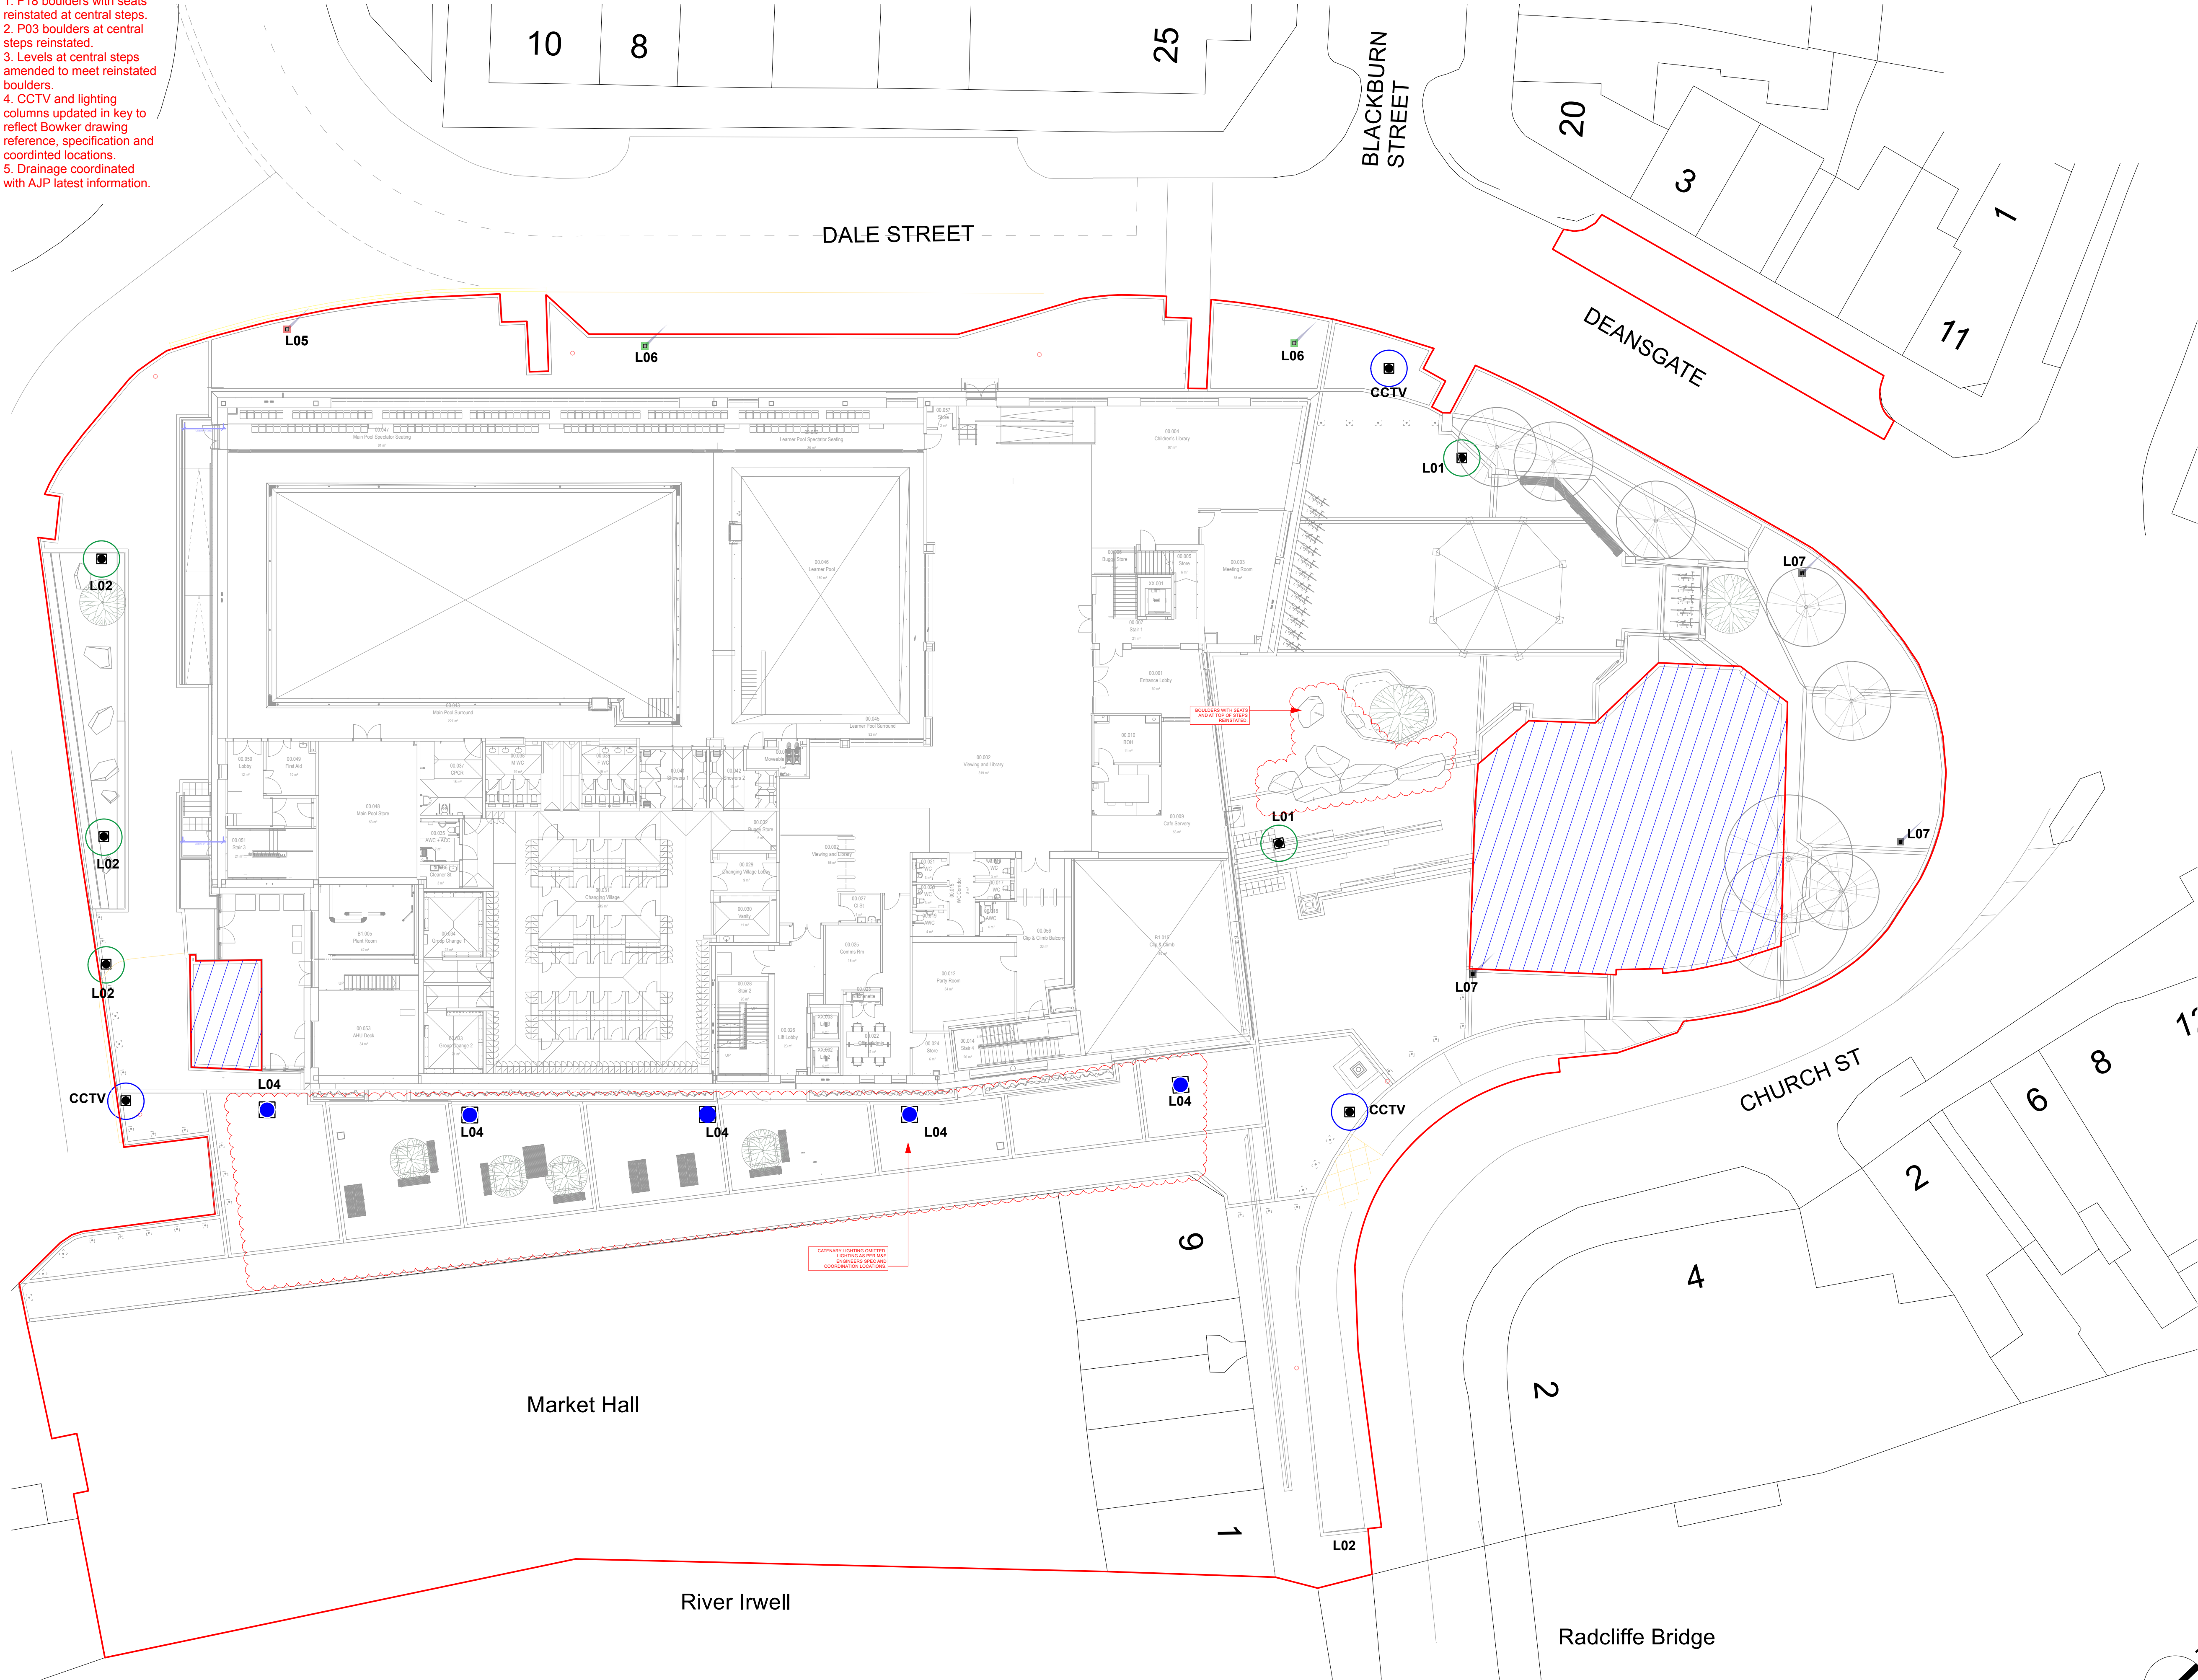

THIS DRAWING IS COPYRIGHT PROTECTED AND MAY NOT BE REPRODUCED IN WHOLE OR PART WITHOUT WRITTEN AUTHORITY FROM THE OWNER.

- NOTES:
1. Do not scale from this drawing.
 2. Always work to noted dimensions.
 3. All dimensions are in millimetres unless otherwise stated.
 4. All setting out, levels and dimensions to be agreed on site.
 5. The dimensions of all materials must be checked on site before being laid out.
 6. This drawing must be read with the relevant specification clauses and detail drawings.
 7. Order of construction and setting out to be agreed on site.

KEY:

- Project Redline Boundary
- Existing Site Structures - no proposed works

M&E

- L01/L02 L01 & L02 LIGHTING COLUMN (BOWKER)**
Refer to Bowker M&E engineer's drawing RADHUB-CBL-V4-XX-DR-ME-6001 P05 for specification
- CCTV**
CCTV LOCATIONS (BOWKER)
Specification subject to adoptable standards
Refer to Bowker M&E engineer's drawing RADHUB-CBL-V4-XX-DR-ME-6001 P05 for specification
- L04**
L04 LIGHTING COLUMN (BOWKER)
Refer to Bowker M&E engineer's drawing RADHUB-CBL-V4-XX-DR-ME-6001 P05 for specification
Lighting as per M&E engineer spec and location. Column lighting removed.

- L05**
LIGHTING COLUMN - REMOVED AND RE-ERECTED (WSP)
Remove from store and re-erect existing road lighting column (8m nominal height) and luminaire.

Refer to WSP drawing 70092923-WSP-HLG-RCHUB-DR-LI-0002 P01 for information.

- L06**
LIGHTING COLUMN (WSP PROPOSED)
Proposed malialite galvanized steel road lighting column (bury sign column 14730) of 10m nominal height with planted base including a post top adaptor with 60mm spigot complete with a post top mounted philips digistreet medium (80p762 dr10 224km 80 led cw) led luminaire installed at zero degree tilt and a new phillips city touch cms node. lantern shall run at 50% light output and set to 11xkm (as agreed with bmbc)

Refer to WSP drawing 70092923-WSP-HLG-RCHUB-DR-LI-0002 P01 for information.

- L07**
EXISTING COLUMN RETAINED (WSP)
Existing column and luminaire to remain

Refer to WSP drawing 70092923-WSP-HLG-RCHUB-DR-LI-0002 P01 for information.

S3-C09	02-03-2026	Construction	JTN	RM
S3-C08	28-10-2025	Construction	JTN	RM
S3-C07	22-10-2025	Construction	JD	RM
S3-C06	04-07-2025	Construction	JD	JTN
S3-C05	17-04-2025	Construction	LT	JTN
S3-C04	10-04-2025	Construction	JTN	RM
S3-C03	21-03-2025	Construction	JTN	RM
S3-C02	24-01-2025	Construction	JTN	RM
S3-C01	24-04-2024	Construction	JTO	RM
S3-P12	28-06-2023	Highway & Binstore updates	RM	RM
S3-P11	26-05-2023	Stage 04 Issue	JTO	RM
S2-P10	23-02-2023	BIN STORE SHOWN	RM	RM
S2-P09	17-02-2023	FOR PLANNING	RM	RM
S2-P08	27-01-2023	STAGE 03	JTO	RM
S2-P07	17-10-2022	STAGE 03	JTO	RM
S2-P06	05-08-2022	STAGE 03	JTO	RM
S2-P05	19-07-2022	STAGE 03	JTO	RM
S2-P04	16-06-2022	STAGE 03	JTO	RM
S2-P03	10-05-2022	STAGE 03	JTO	RM
S2-P02	25-01-2022	STAGE 02	JTO	RM
S2-P01	20-01-2022	STAGE 02	JTO	RM

Revision	Date	Description	Drawn	Appr.
----------	------	-------------	-------	-------

Planit I.E. Limited
E: info@planit-ie.com W: planit-ie.com
MANCHESTER
2 Back Grafton St., Altrincham, WA14 1DY
T: 0161 928 9281
LONDON
Unit 6 Waterside, 44-48 Wharf Road, London,
N1 7UX
T: 0207 253 5678
LIVERPOOL
Tempest 5.3, 12 Tithebarn Street, Liverpool, L2
2DT
T: 0151 363 1230

Client Bury Council

Project Radcliffe Civic Hub

Drg Title M&E

Created on 04-01-2022JTO
Created by JTO
Approved by RM

Scale 1:200
Size A1
Workstage Construction

Drg No. RADHUB-PIE-00-00-DR-L-0006 S3
Suitability C09
Revision