


DRAWING UPDATES
02.03.26:

1. F18 boulders with seats reinstated at central steps.
2. P03 boulders at central steps reinstated.
3. Levels at central steps amended to meet reinstated boulders.
4. CCTV and lighting columns updated in key to reflect Bowker drawing reference, specification and coordinated locations.
5. Drainage coordinated with AJP latest information.

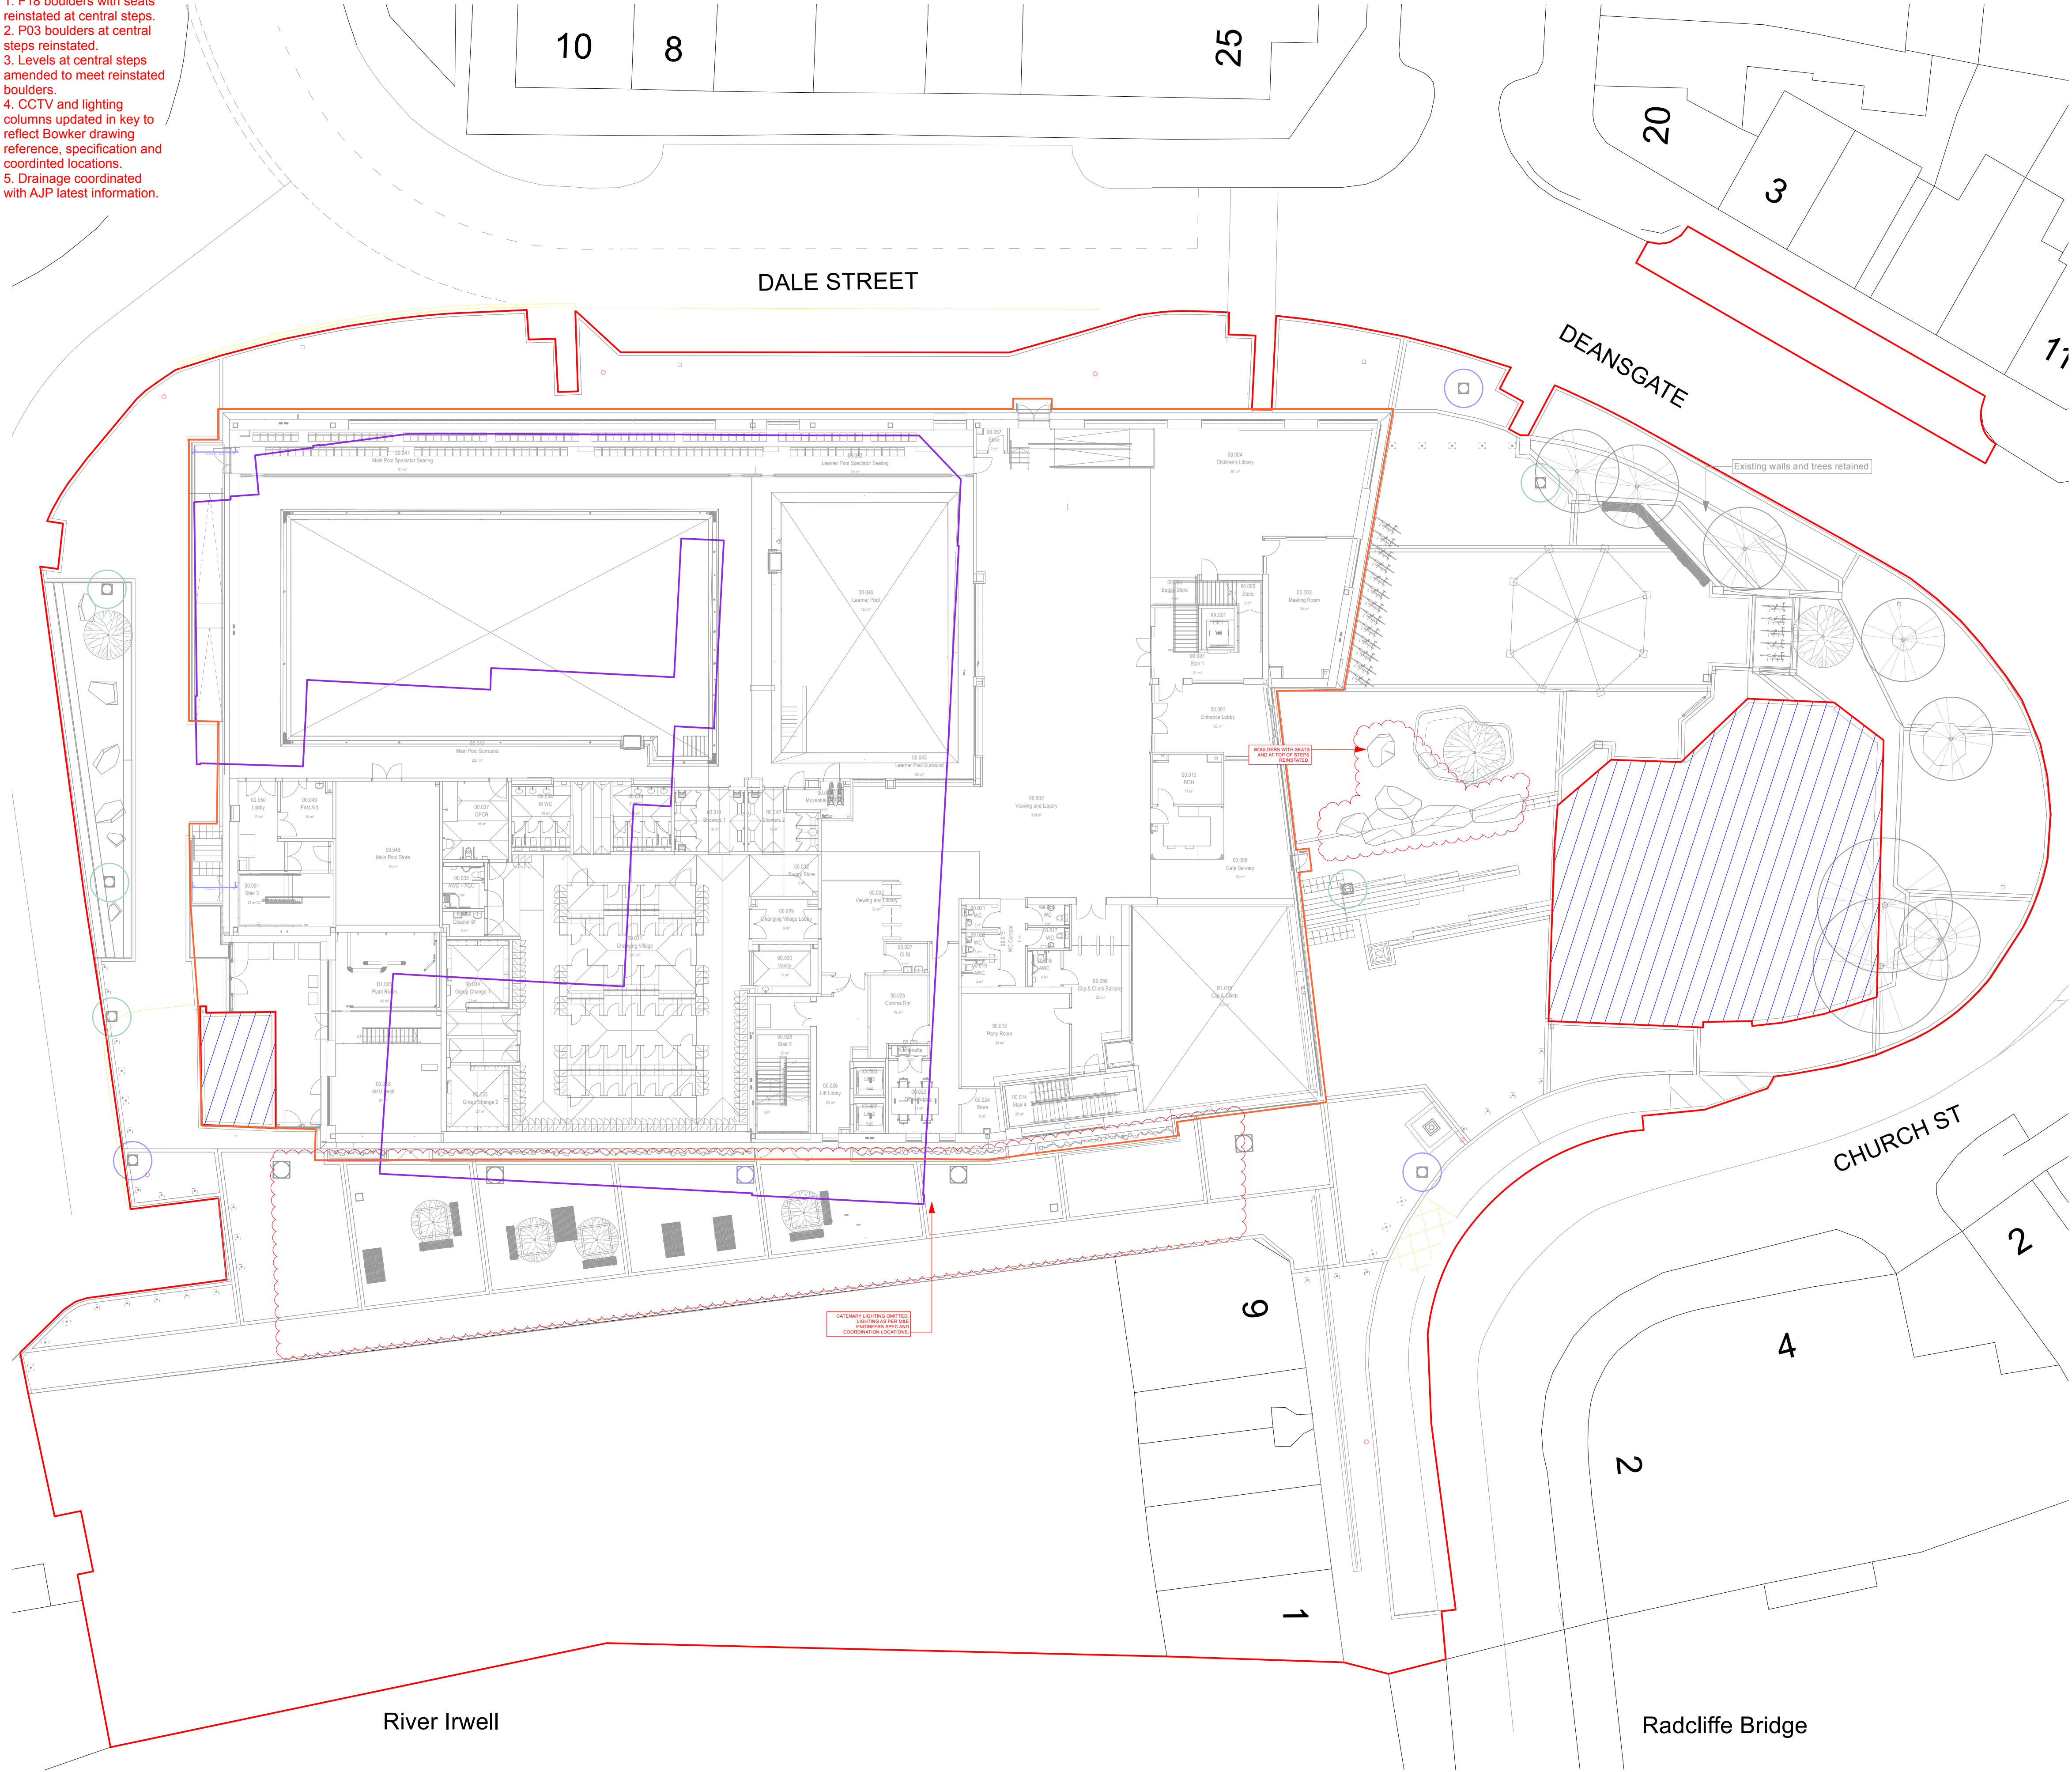

THIS DRAWING IS COPYRIGHT PROTECTED AND MAY NOT BE REPRODUCED IN WHOLE OR PART WITHOUT WRITTEN AUTHORITY FROM THE OWNER.

NOTES:
1. Do not scale from this drawing.
2. Always work to noted dimensions.
3. All dimensions are in millimetres unless otherwise stated.
4. All setting out, levels and dimensions to be agreed on site.
5. The dimensions of all materials must be checked on site before being laid out.
6. This drawing must be read with the relevant specification clauses and detail drawings.
7. Order of construction and setting out to be agreed on site.

TOTAL AREA IN RED LINE BOUNDARY: 10763.665 sq m

KEY

- Project Redline Boundary
- Existing Site Structures - no proposed works
- Existing Building Footprint
- Adoption Line Boundary

S3-C09	02-03-2026	Construction	JTN	RM
S3-C08	28-10-2025	Construction	JTN	RM
S3-C07	22-10-2025	Construction	JD	RM
S3-C06	04-07-2025	Construction	JD	JTN
S3-C05	17-04-2025	Construction	LT	JTN
S3-C04	10-04-2025	Construction	JTN	RM
S3-C03	21-03-2025	Construction	JTN	RM
S3-C02	24-01-2025	Construction	JTN	RM
S3-C01	24-04-2024	Construction	JTO	RM
S3-P14	28-06-2023	Highway & Binstore updates	RM	RM
S3-P13	26-05-2023	Stage 04 Issue	JTO	RM
S2-P12	23-02-2023	BIN STORE SHOWN	RM	RM
S2-P11	17-02-2023	FOR PLANNING	RM	RM
S2-P10	13-02-2023	STAGE 03	JTO	RM
S2-P09	27-01-2023	STAGE 03	JTO	RM
S2-P08	24-01-2023	STAGE 03	JTO	RM
S2-P07	17-10-2022	STAGE 03	JTO	RM
S2-P06	05-08-2022	STAGE 03	JTO	RM
S2-P05	19-07-2022	STAGE 03	JTO	RM
S2-P04	16-06-2022	STAGE 03	JTO	RM
S2-P03	10-05-2022	STAGE 03	JTO	RM
S2-P02	25-01-2022	STAGE 02	JTO	RM
S2-P01	20-01-2022	STAGE 02	JTO	RM

Revision	Date	Description	Drawn	Appr.

Planit I.E. Limited
E: info@planit-ie.com W: planit-ie.com
MANCHESTER
2 Back Grafton St., Altrincham, WA14 1DY
T: 0161 928 9281
LONDON
Unit 6 Waterside, 44-48 Wharf Road, London,
N1 7UX
T: 0207 253 5678
LIVERPOOL
Tempest 5.3, 12 Tithebarn Street, Liverpool, L2
2DT
T: 0151 363 1230

Client **Bury Council**

Project **Radcliffe Civic Hub**

Drg Title **Project Boundaries**

Created on	Created by	Approved by
04-01-2022	JTO	RM

Scale	Size	Workstage
1:200	A1	Construction

Drg No.	Suitability	Revision
RADHUB-PIE-00-00-DR-L-0007	S3	C09

© Planit I.E. Limited