


DRAWING UPDATES
02.03.26:

1. F18 boulders with seats reinstated at central steps.
2. P03 boulders at central steps reinstated.
3. Levels at central steps amended to meet reinstated boulders.
4. CCTV and lighting columns updated in key to reflect Bowker drawing reference, specification and coordinted locations.
5. Drainage coordinated with AJP latest information.

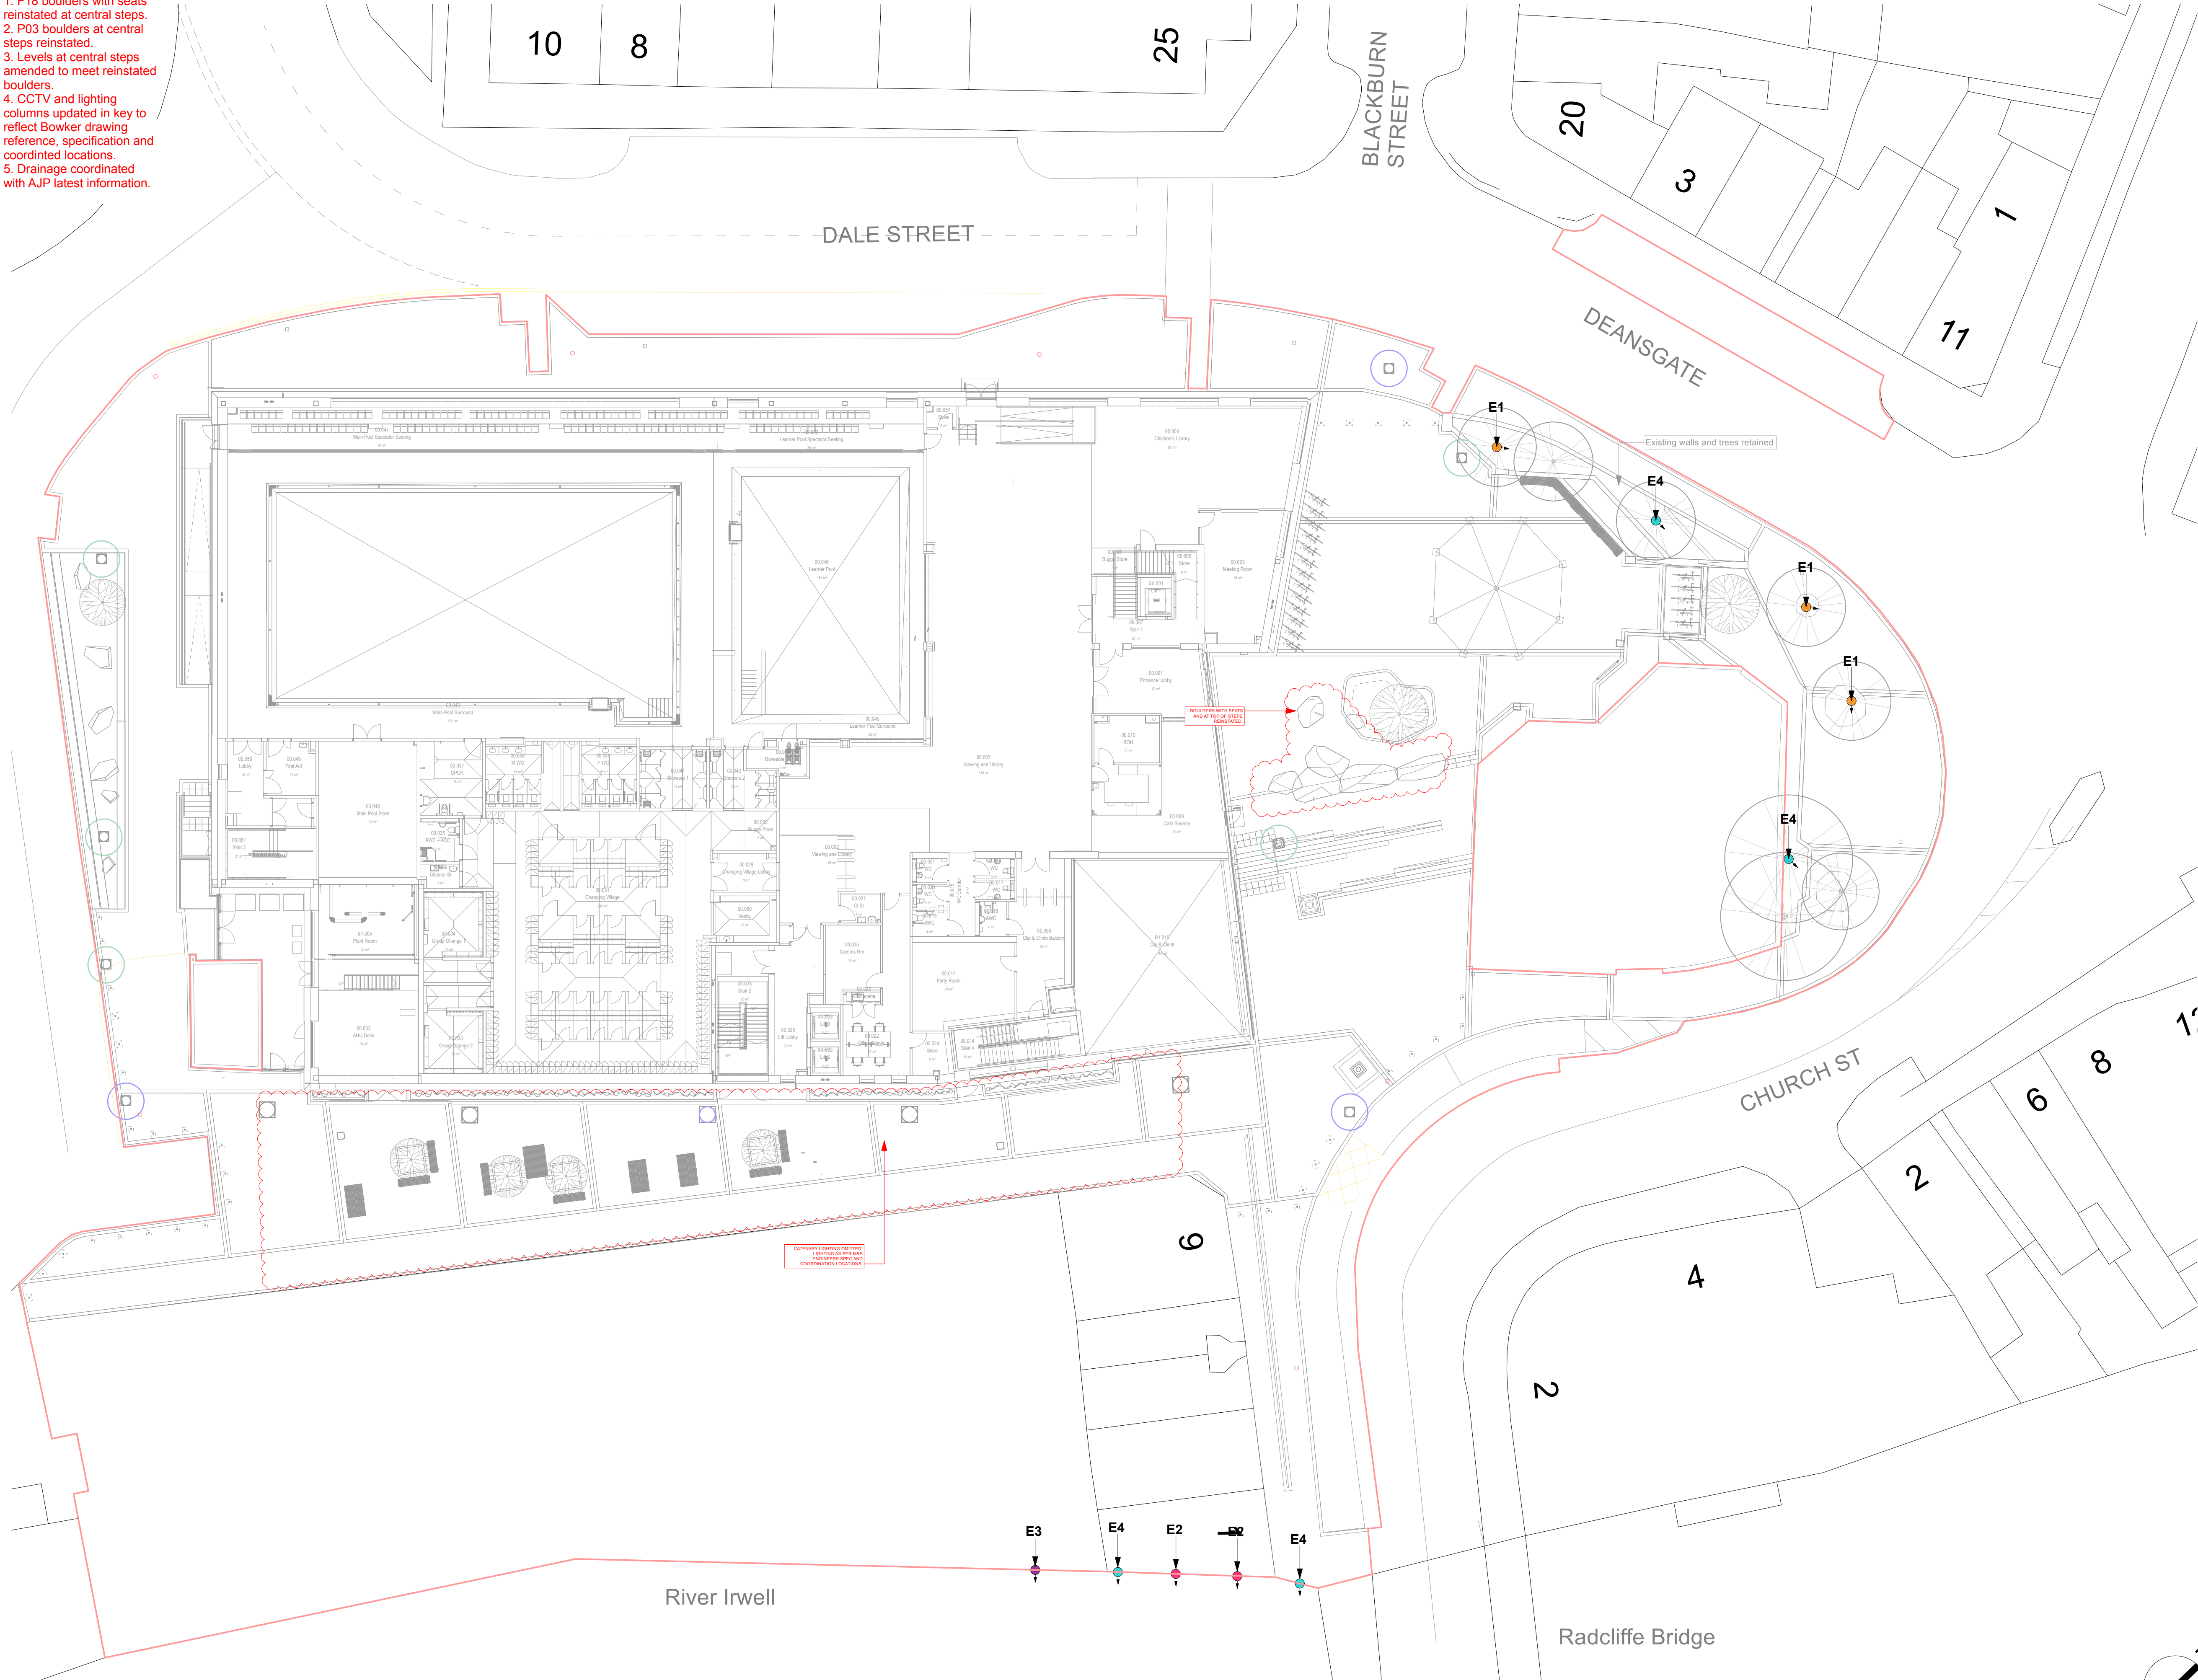

THIS DRAWING IS COPYRIGHT PROTECTED AND MAY NOT BE REPRODUCED IN WHOLE OR PART WITHOUT WRITTEN AUTHORITY FROM THE OWNER.

- NOTES:
1. Do not scale from this drawing.
 2. Always work to noted dimensions.
 3. All dimensions are in millimetres unless otherwise stated.
 4. All setting out, levels and dimensions to be agreed on site.
 5. The dimensions of all materials must be checked on site before being laid out.
 6. This drawing must be read with the relevant specification clauses and detail drawings.
 7. Order of construction and setting out to be agreed on site.

- KEY:
- Project Redline Boundary
 - Existing Site Structures - no proposed works

- E1** **NEST BOX [E1]**
Location: See plan for placement on existing trees
Direction: Face away from prevailing winds, rain and strong sunlight.
Height: 2m above ground
Quantity: 3no.
Note: For specification of nest box refer to Ecologist EMMP document
- E2** **SPARROW TERRACE [E2]**
Location: See plan for placement along river edge
Direction: Face away from prevailing winds, rain and strong sunlight.
Height: 2m above ground under wall eaves if possible
Quantity: 2no.
Note: For specification of terrace refer to Ecologist EMMP document
- E3** **BAT BRICK [E3]**
Location: See plan for placement along river edge
Height: 4m above ground
Quantity: 1no.
Note: For specification of bat brick refer to Ecologist EMMP document
- E4** **BAT BOX [E4]**
Location: See plan for placement along river edge and in existing trees
Height: 3-4m above ground
Quantity: 4no.
Note: For specification of bat box refer to Ecologist EMMP document

Note:
Refer to Ecologist EMMP Report 2482901_Radcliffe Hub_EMMP (AH)(RE)(ML)(AH) 010224 for more information.
Blocked sand martin nest holes will be reopened following construction ensuring nesting provision is available upon project completion.

S3-C10	02-03-2026	Construction	JTN	RM
S3-C09	28-10-2025	Construction	JTN	RM
S3-C08	22-10-2025	Construction	JD	RM
S3-C07	04-07-2025	Construction	JD	JTN
S3-C06	08-05-2025	Construction	JTN	RM
S3-C05	17-04-2025	Construction	LT	JTN
S3-C04	10-04-2025	Construction	JTN	RM
S3-C03	21-03-2025	Construction	JTN	RM
S3-C02	24-01-2025	Construction	JTN	RM
S3-C01	24-04-2024	Construction	JTO	RM
S3-P10	06-02-2024	Stage 04	JTO	RM
S3-P09	30-01-2024	Stage 04	JTO	RM
S3-P08	28-06-2023	Highway & Binstore updates	RM	RM
S3-P07	26-05-2023	Stage 04 Issue	JTO	RM
S2-P06	23-02-2023	BIN STORE SHOWN	RM	RM
S2-P05	27-01-2023	STAGE 03	JTO	RM
S2-P04	17-10-2022	STAGE 03	JTO	RM
S2-P03	05-08-2022	STAGE 03	JTO	RM
S2-P02	19-07-2022	STAGE 03	JTO	RM
S2-P01	16-06-2022	STAGE 03	JTO	RM

Revision	Date	Description	Drawn	Apprv.
----------	------	-------------	-------	--------

Plant I.E. Limited
E: info@plant-ie.com W: plant-ie.com
MANCHESTER
2 Back Grafton St., Altrincham, WA14 1DY
T: 0161 928 9281
LONDON
Unit 6 Waterside, 44-48 Wharf Road, London, N1 7UX
T: 0207 253 5678
LIVERPOOL
Tempest 5.3, 12 Tithebarn Street, Liverpool, L2 2DT
T: 0151 363 1230

Client **Bury Council**

Project **Radcliffe Civic Hub**

Drg Title **Ecological Enhancement**

Created on **13-06-2022** Created by **JTO** Approved by **RM**

Scale **1:200** Size **A1** Workstage **Construction**

Drg No. **RADHUB-PIE-00-00-DR-L-0010** Suitability **S3** Revision **C10**