



HOLLY HEDGE
REFER TO
ROWBOTTOMS TREE
REPORT


STILTED HEDGE
REFER TO
ROWBOTTOMS TREE
REPORT

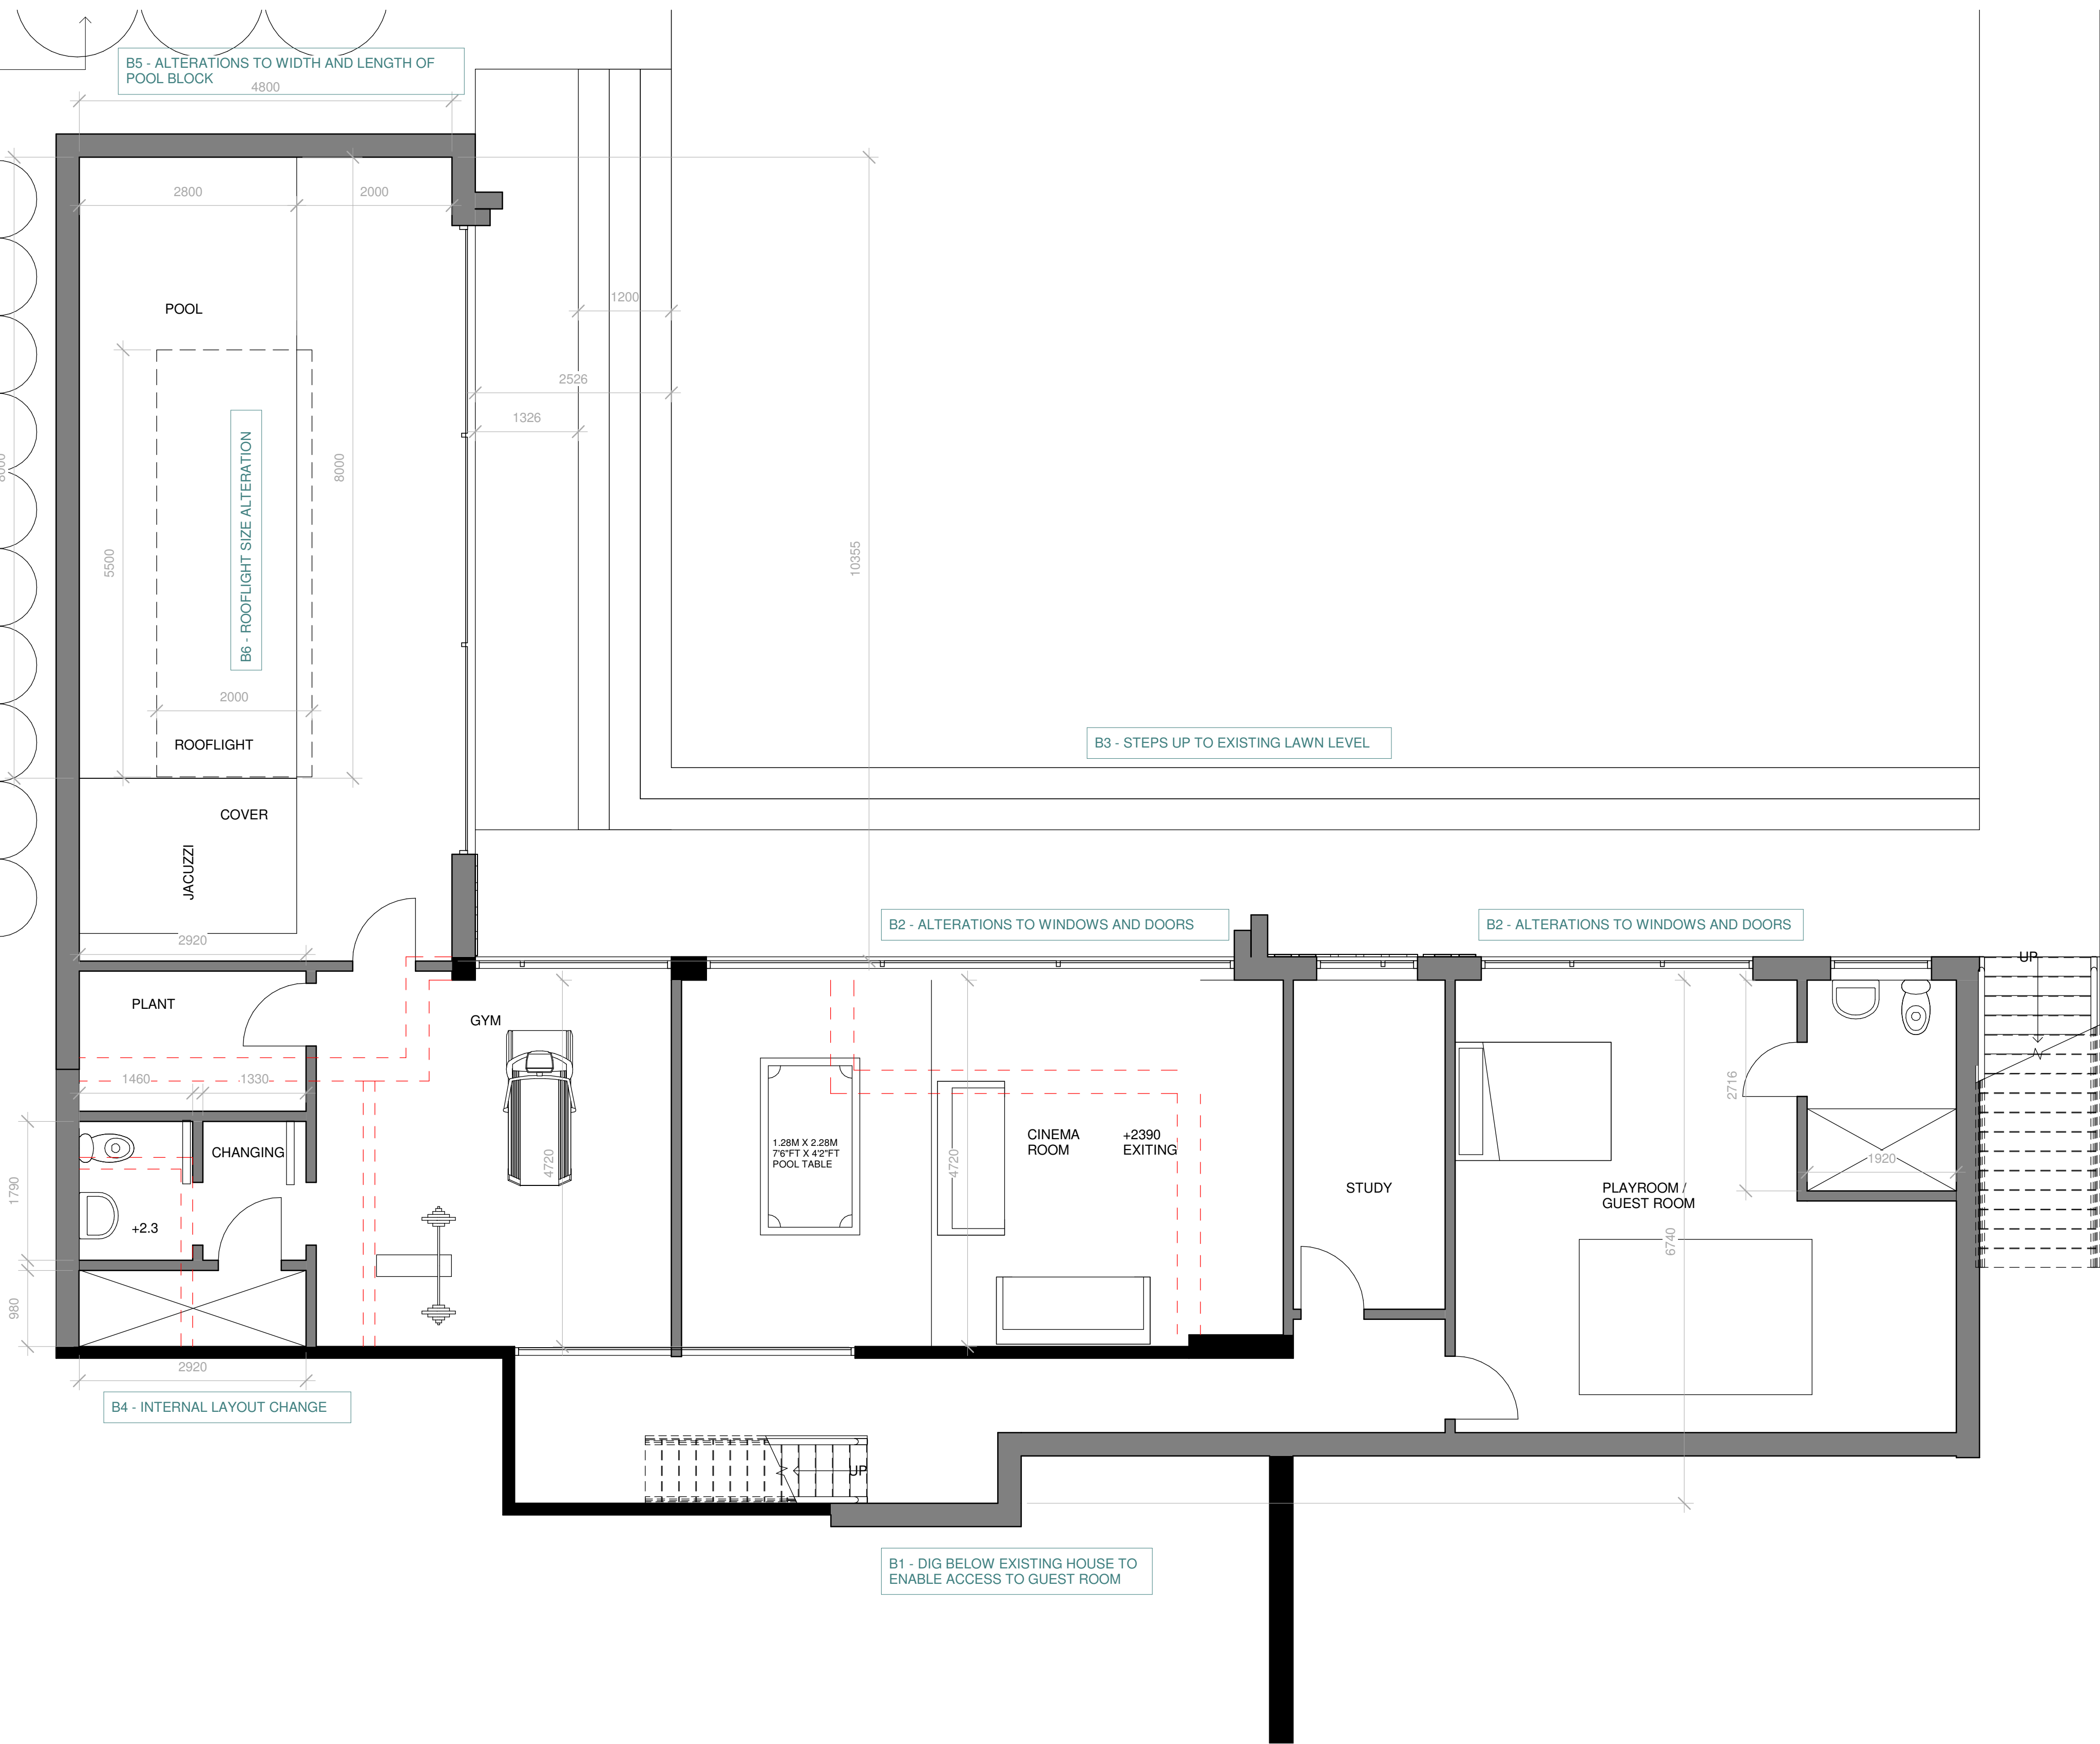

Basement
1 : 50

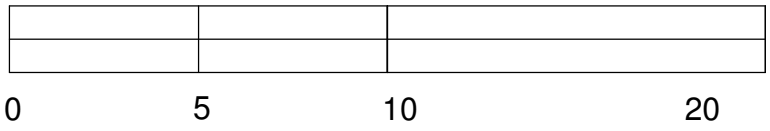

SCALE BAR 1:200

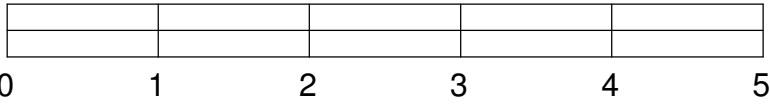

SCALE BAR 1:50



Location Plan North Point

The contractor must verify all dimensions on site before commencing any work or fabrication drawings. If this drawing exceeds the quantities taken in any way Northedge Architecture are to be informed before the work is initiated. Only figured dimensions are to be taken from this drawing. Do not scale off this drawing. Drawings are based on Ordnance Survey and / or existing record drawings - design and drawing content issued subject to detailed Site Survey, Structural Survey, Site Investigations, Planning and Statutory Requirements and Approvals. Authorised reproduction from Ordnance Survey Map with permission of the Controller of Her Majesty's Stationery Office. Crown Copyright reserved. Northedge Architecture Copyright.

Drawing Notes:

Rev:	Description:	Revised By:	Issue Date:
R1	Initial Issue	UA	05.10.19
R2	Updated	UA	19.02.21
R3	Updated	UA	22.02.21
R4	Updated	UA	17.07.21
R5	Updated	UA	22.07.21
R6	Updated	UA	08.11.21
R7	Updated	UA	20.01.22
R8	Updated	UA	01.06.22
R9	Updated	UA	18.08.22

Project:
21 Sheepfoot Lane,
Prestwich

Drawing Title:
Proposed Basement

Scale: 1 : 50@A1 Original Issue Date:
Original Drawn By: Author Original Checked by: Checker

Drawing Number: Revision:
19-60-20-006 R9

Reason For Issue:
Concept

NORTHEDGE
ARCHITECTURE
T: 07380266466
design@northedgearchitecture.co.uk
www.northedgearchitecture.co.uk