



Copyright of this drawing is vested in BPM Architectural and it must not be copied or reproduced without written consent. Figured dimensions only are to be taken from this drawing. DO NOT SCALE OFF THIS DRAWING IF IN DOUBT ASK

All contractors must visit the site and be responsible for taking and checking all dimensions relative to their work.
BPM architectural are to be advised of any variation between drawings and site conditions.


Electronic data/ drawings issued as 'read only' and should not be interrogated for measurement.
All dimensions and levels should be 'read only' from those values stated in text, on the drawings

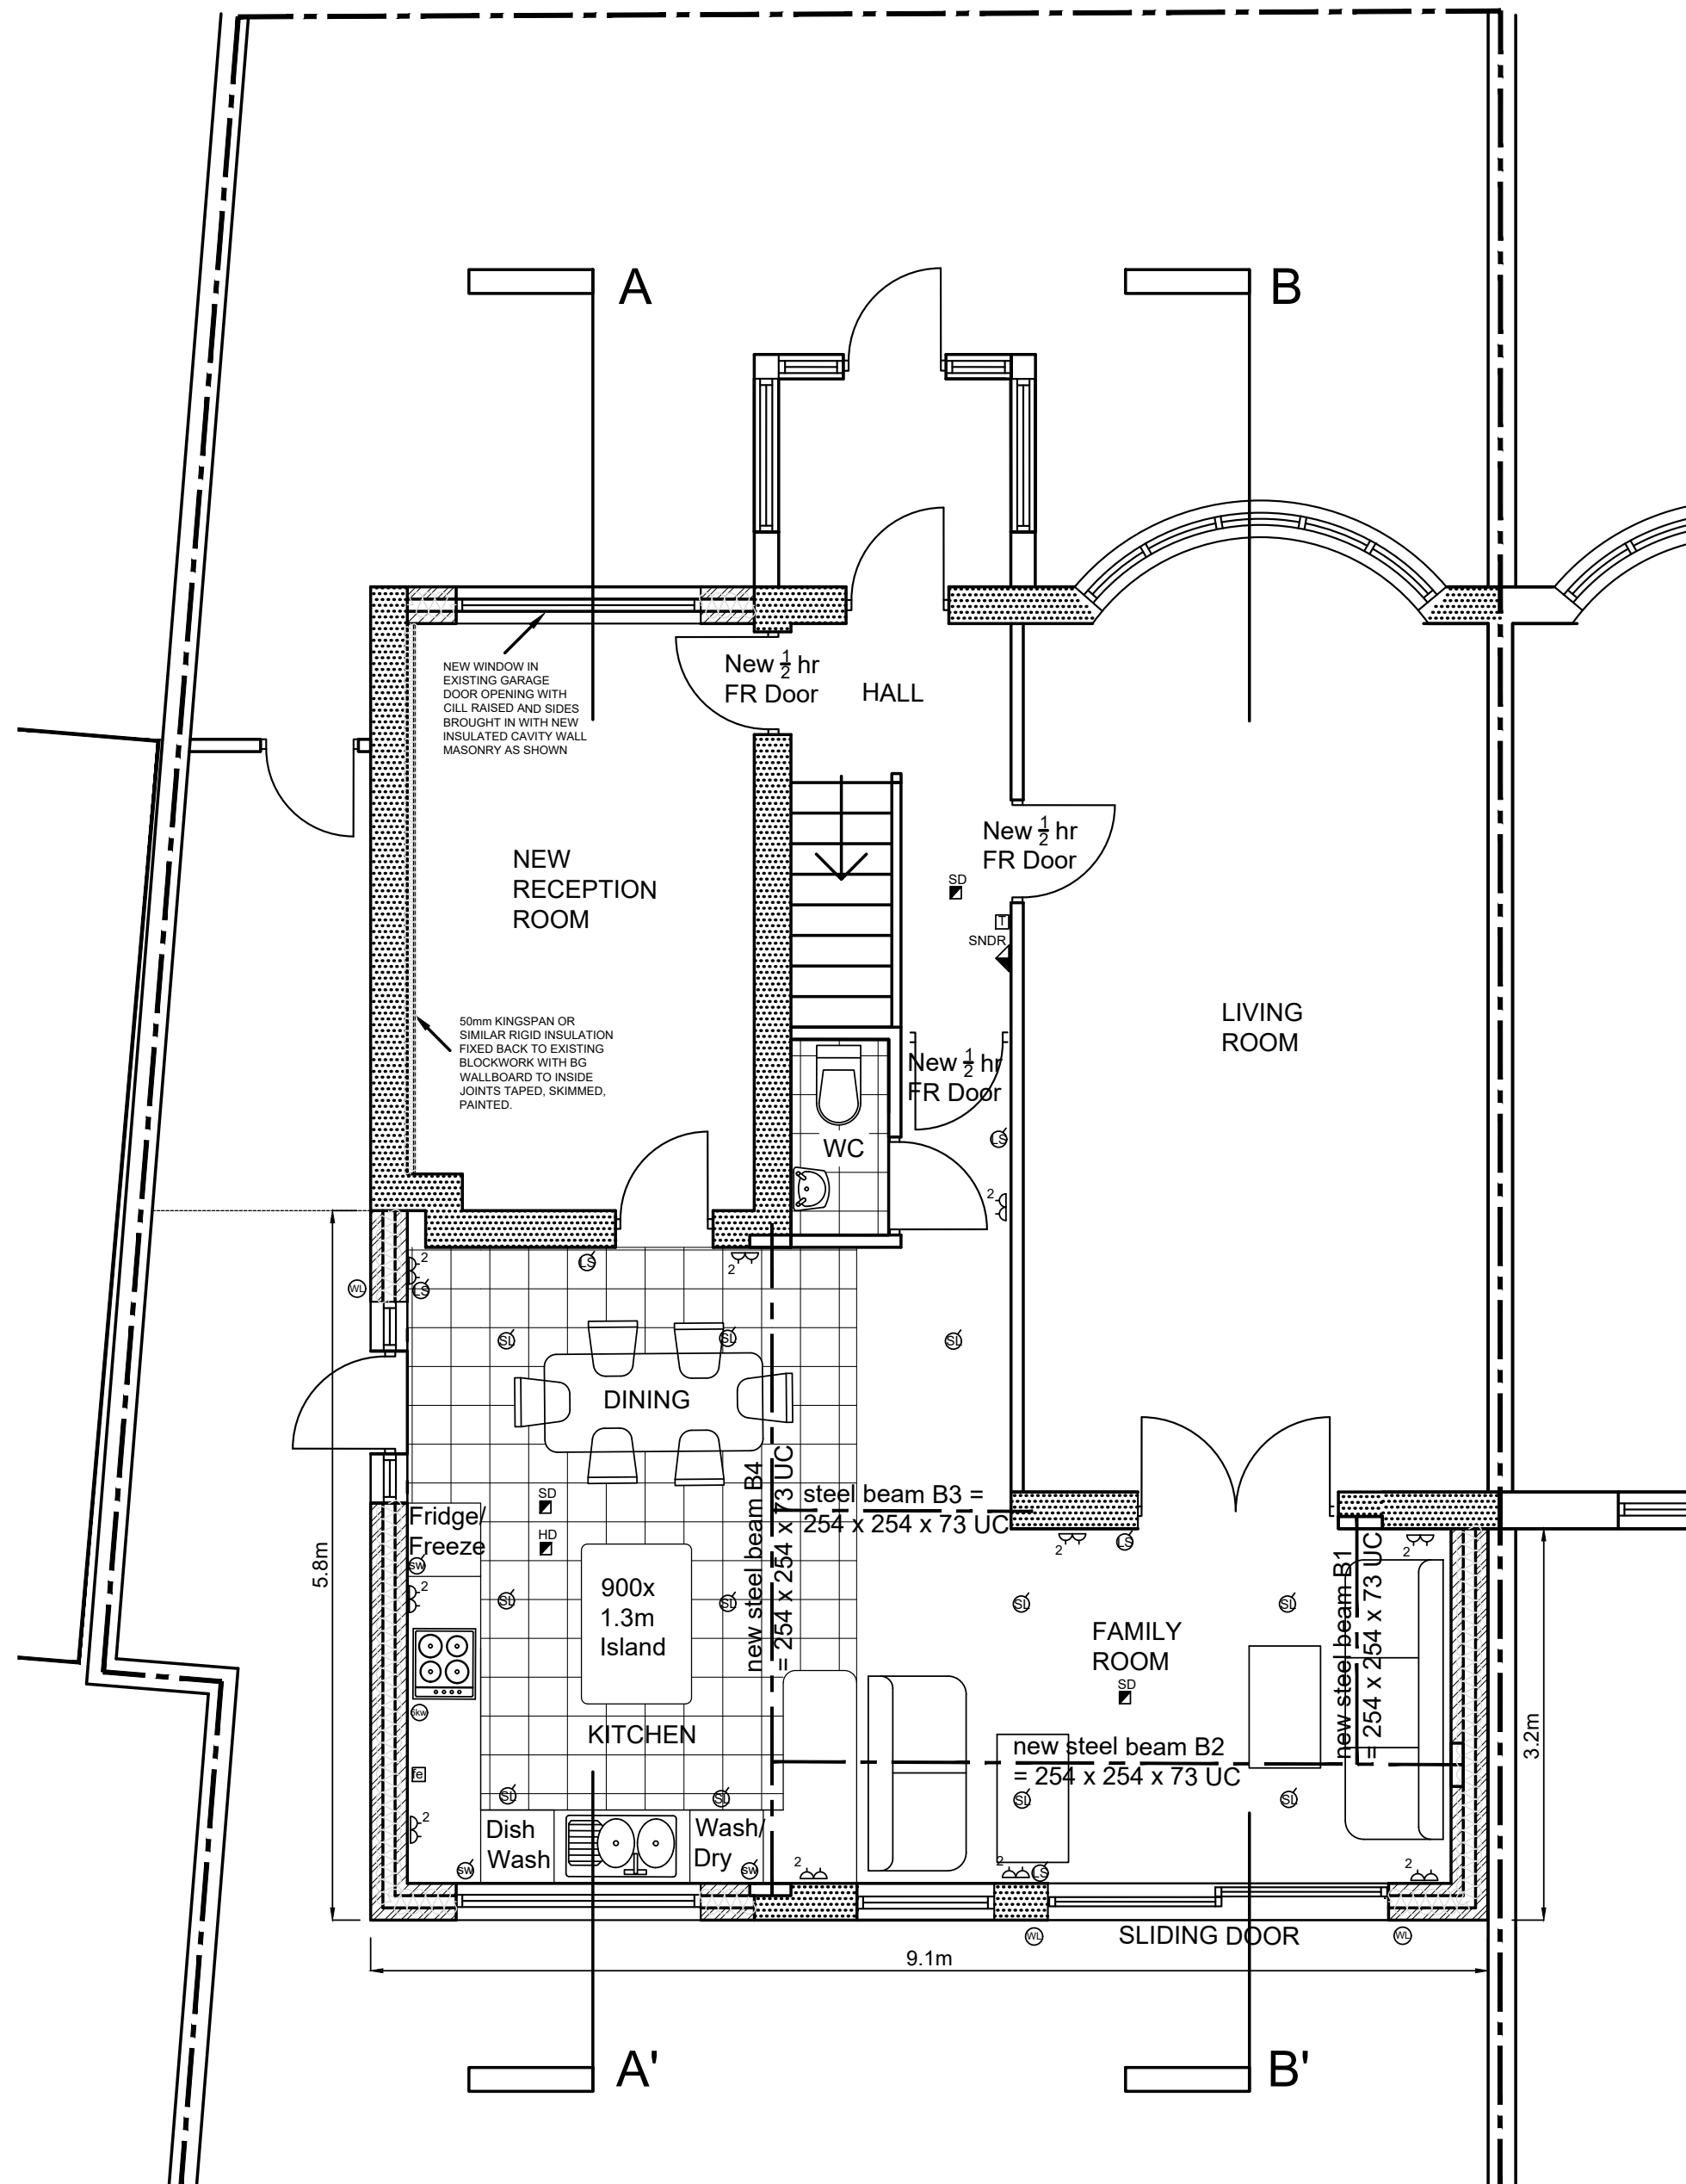

PROPOSED GROUND FLOOR PLAN

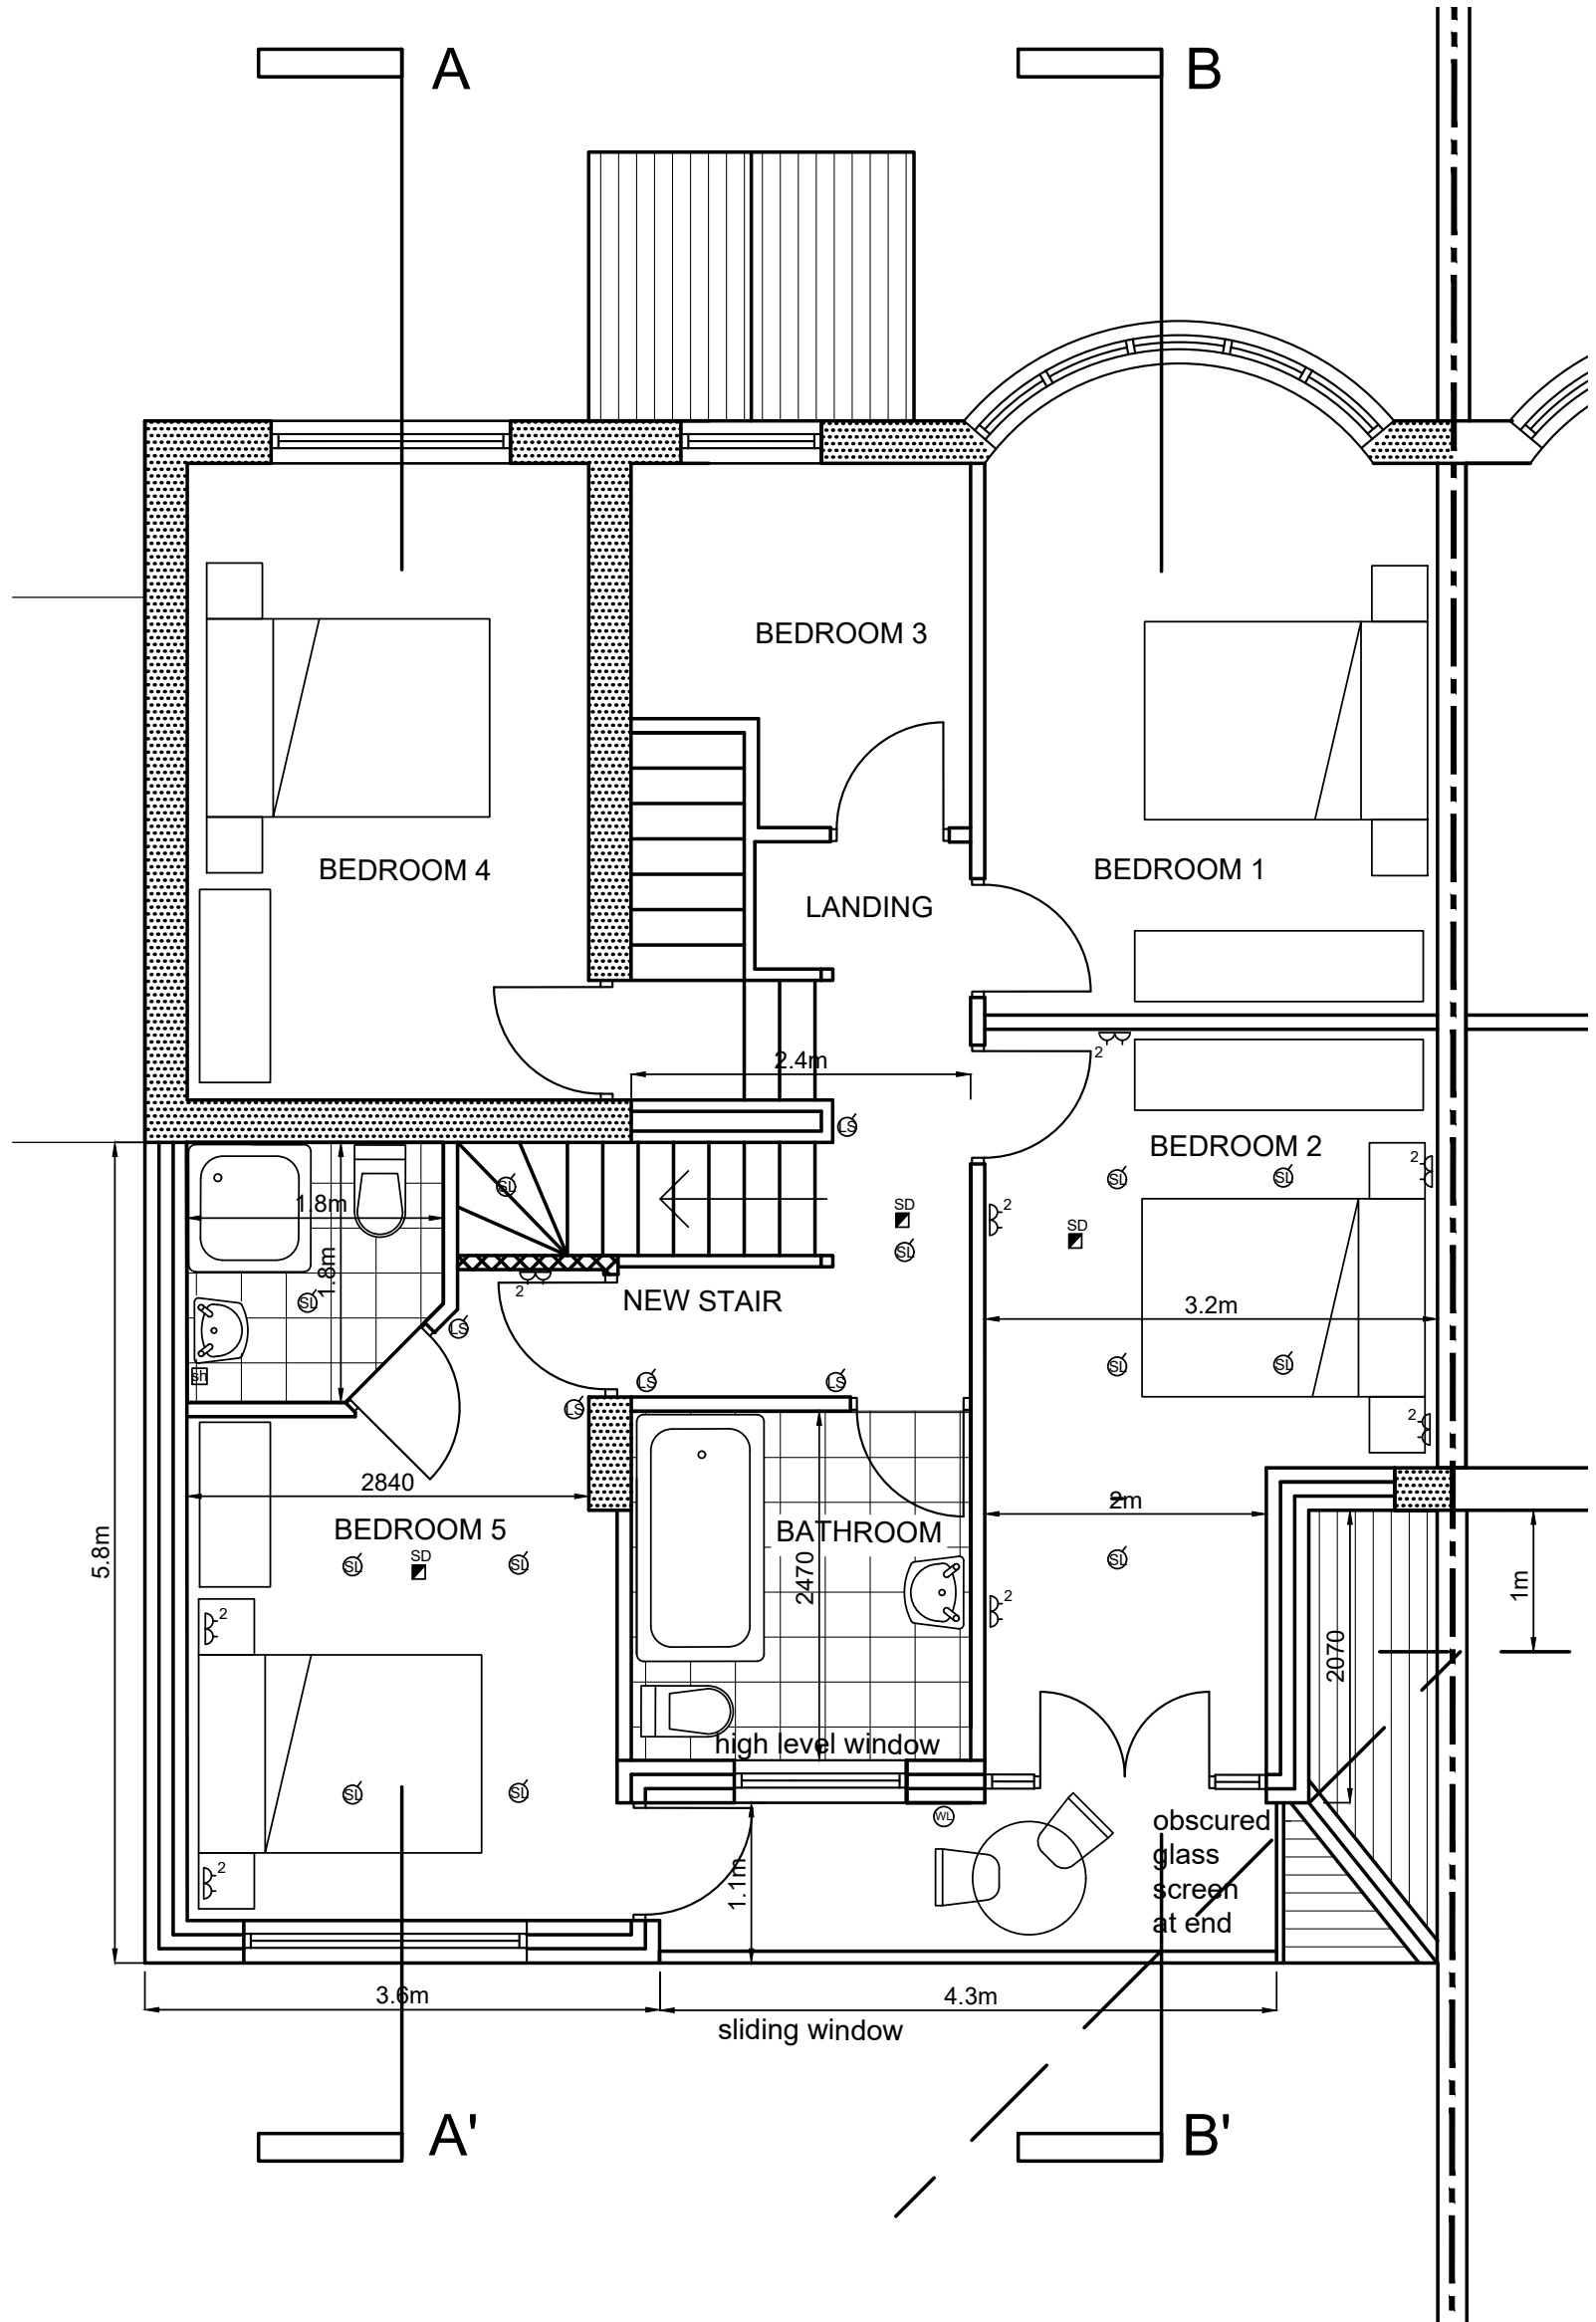

PROPOSED FIRST FLOOR PLAN

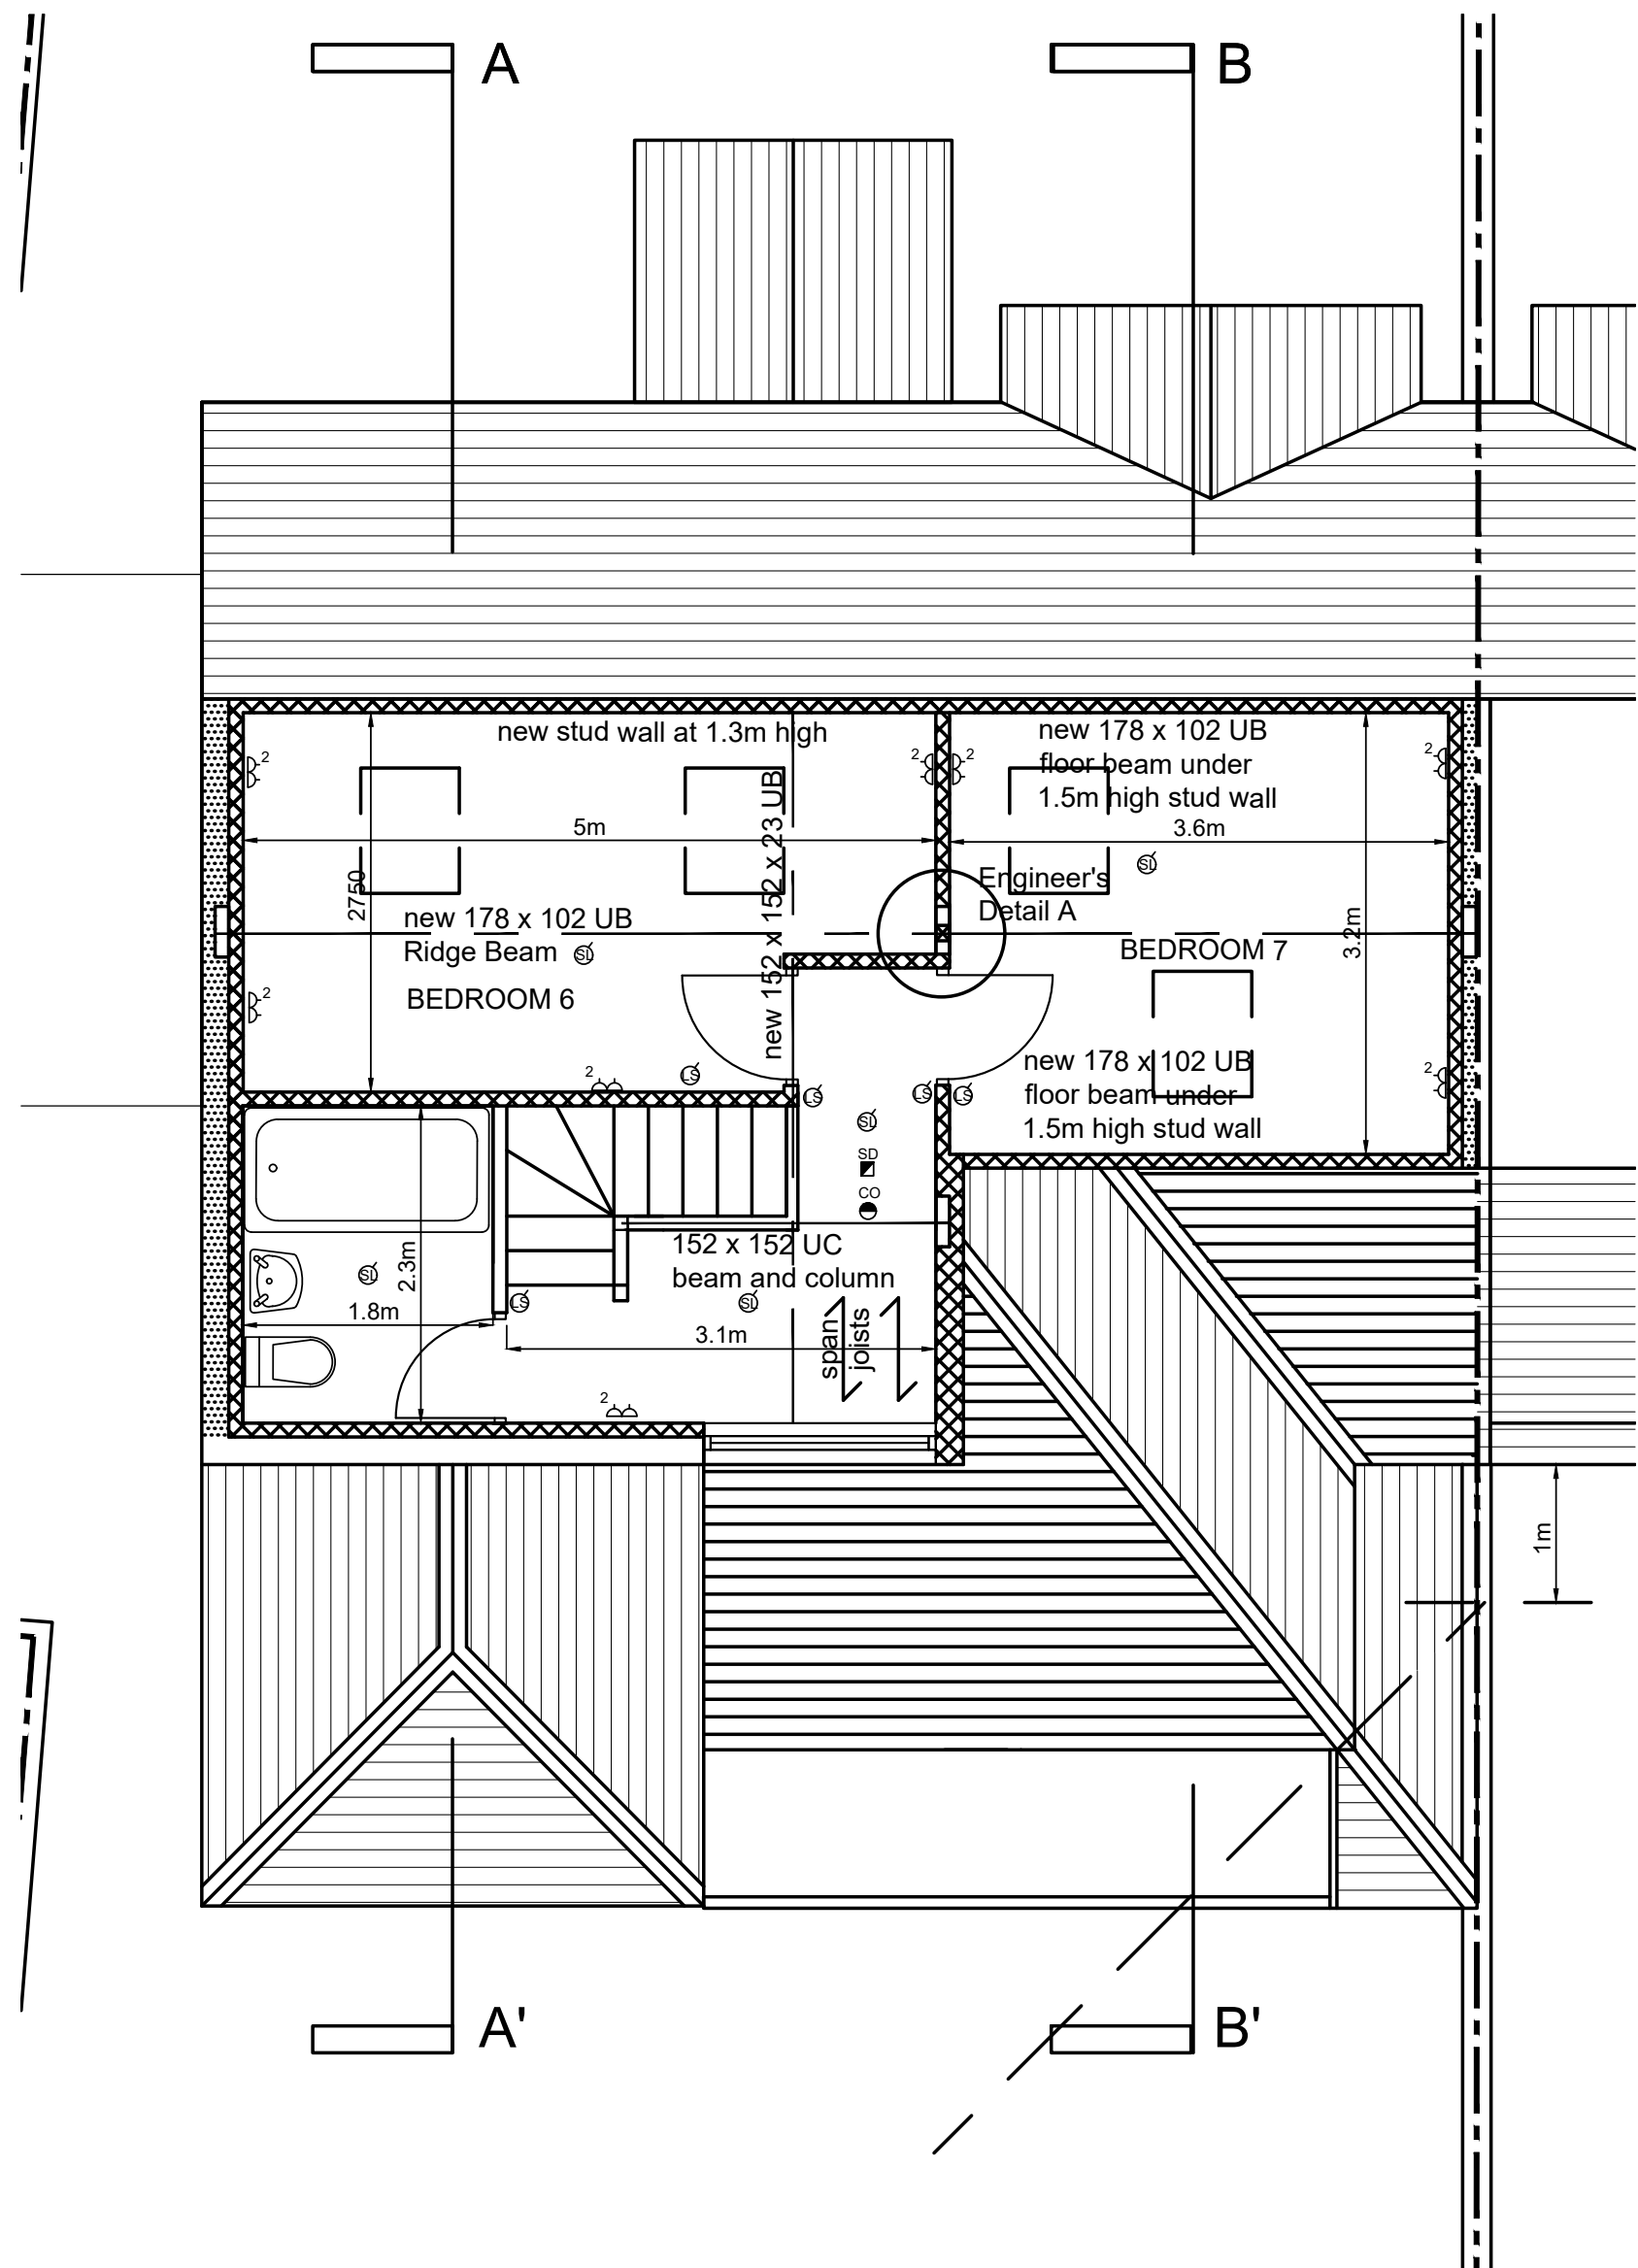

PROPOSED LOFT PLAN

REV: | DATE: | DETAILS:

BM ARCHITECTURAL DESIGNS
128 GLOSSOP ROAD,
MARPLE BRIDGE,
STOCKPORT SK6 5EL
TEL: 07415 493002

PROJECT: 56 WINDSOR ROAD,
PRESTWICH,
BURY, M25 0DE

TITLE: PROPOSED LAYOUT- PLANS

CLIENT: MR. RAJ SINGH AND FAMILY

SCALE: 1:50 @A1 DATE: 10/ 2022 DRAWN: BM

STATUS: AS BUILT PLANS

DRAWING NO: BM/0521/WINDS2/PL2 REV: