



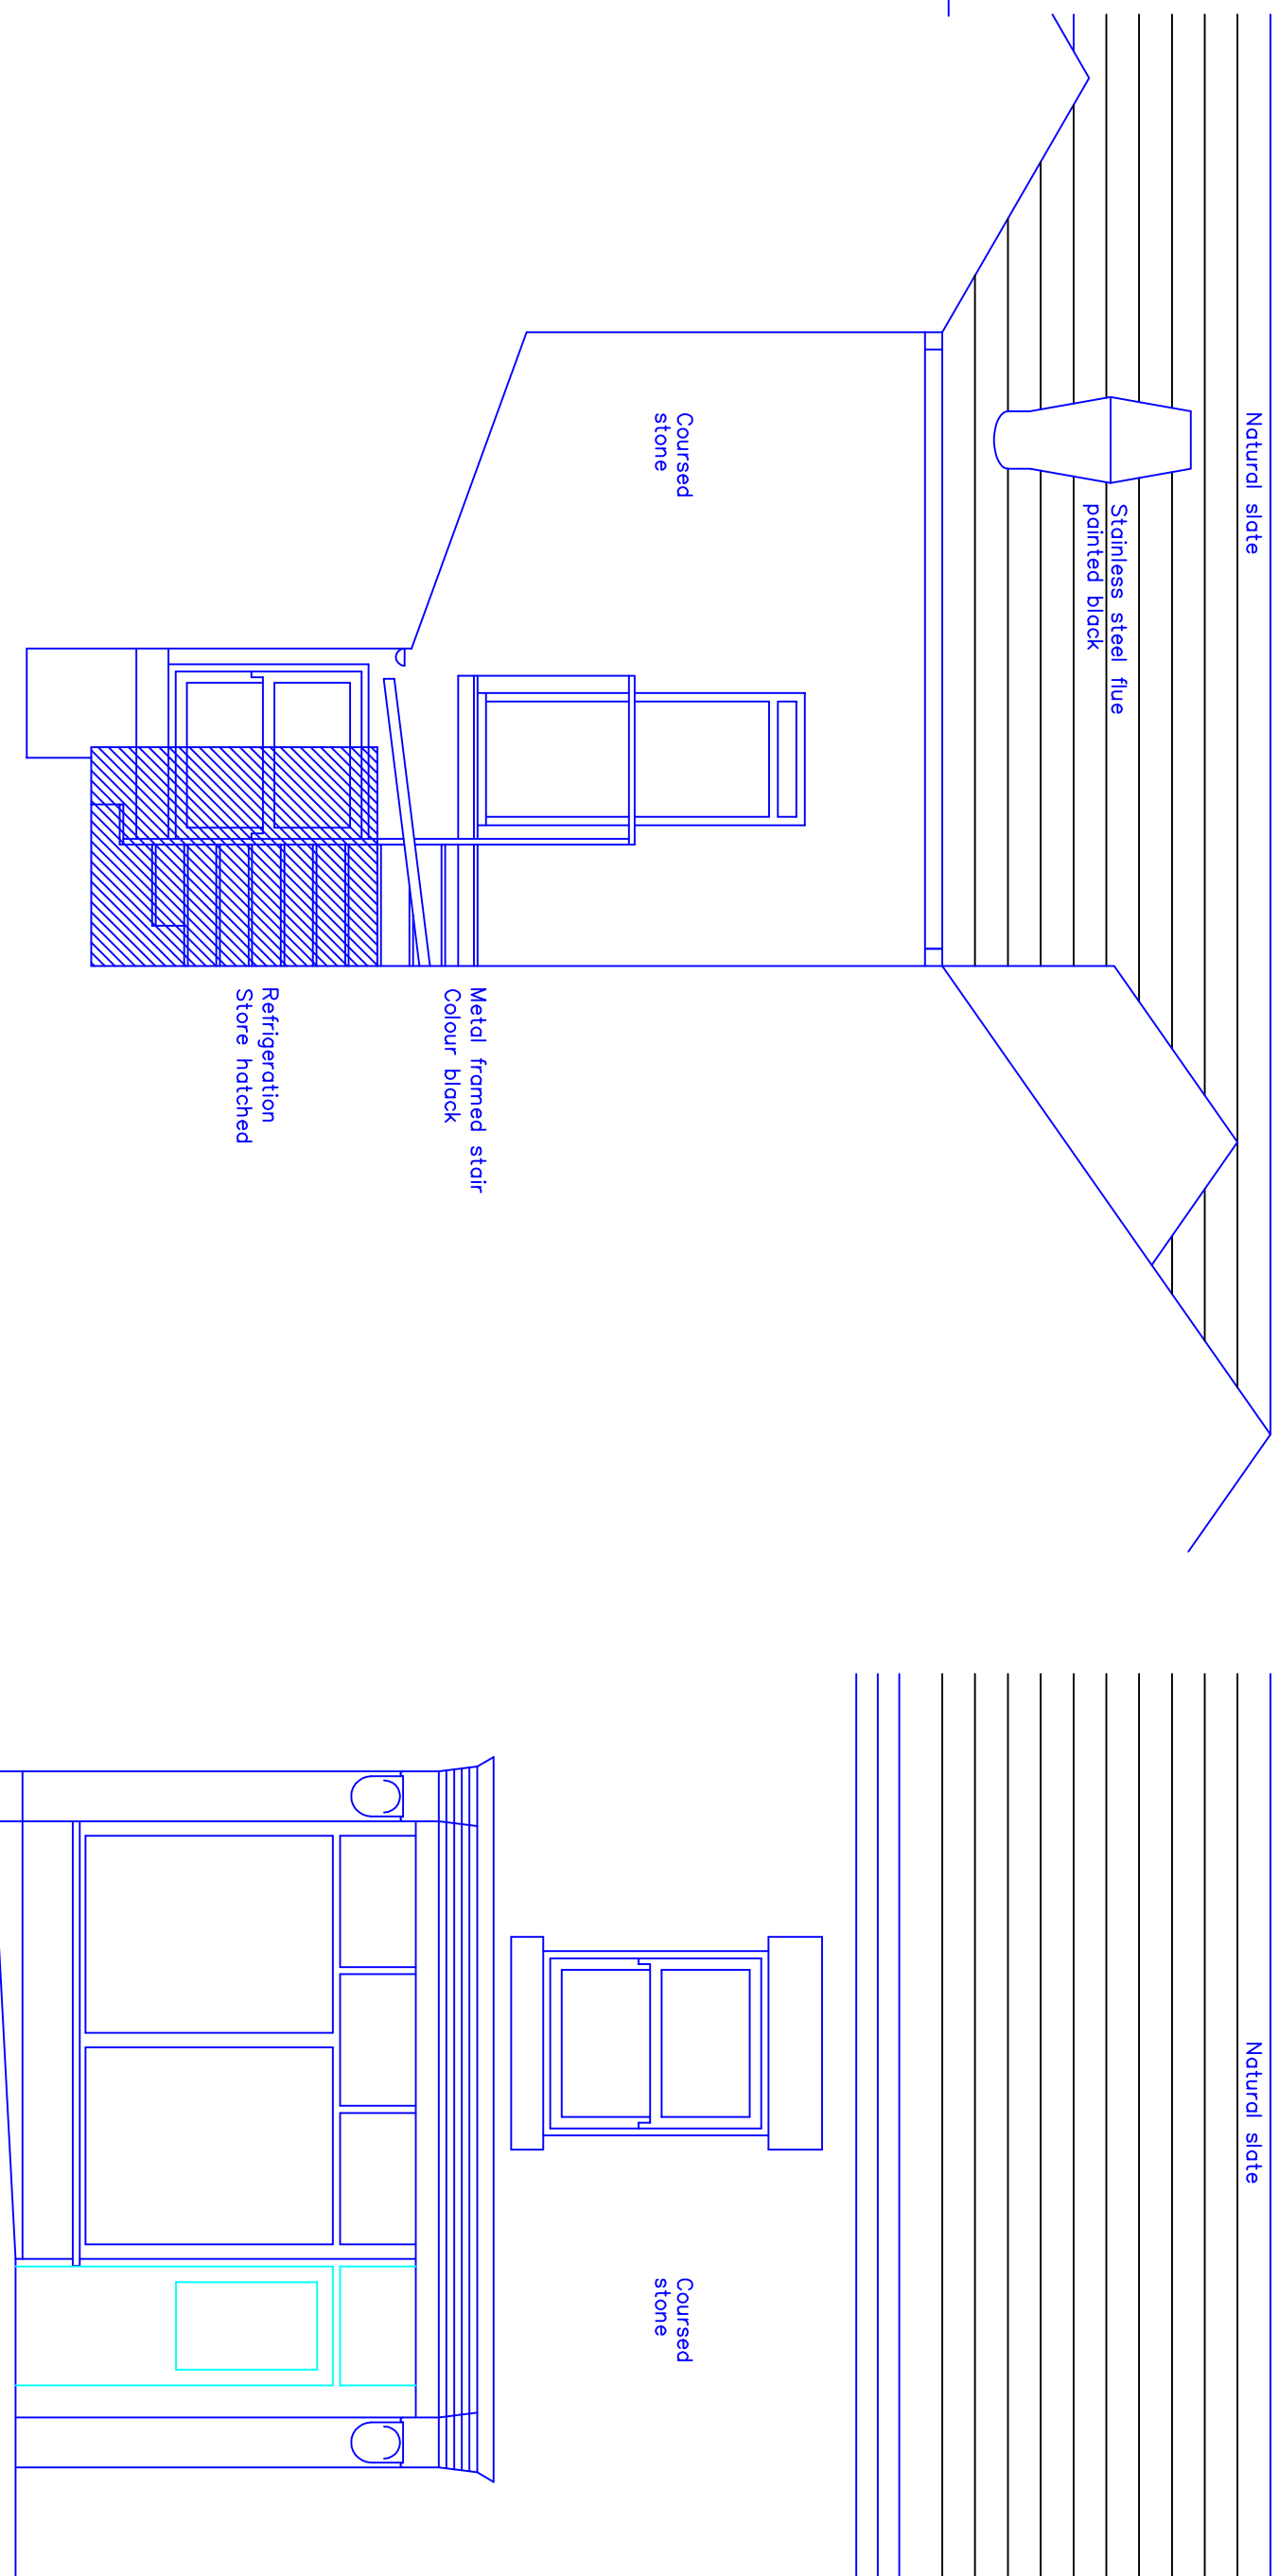


As~built Rear Elevation

As~built Front Elevation

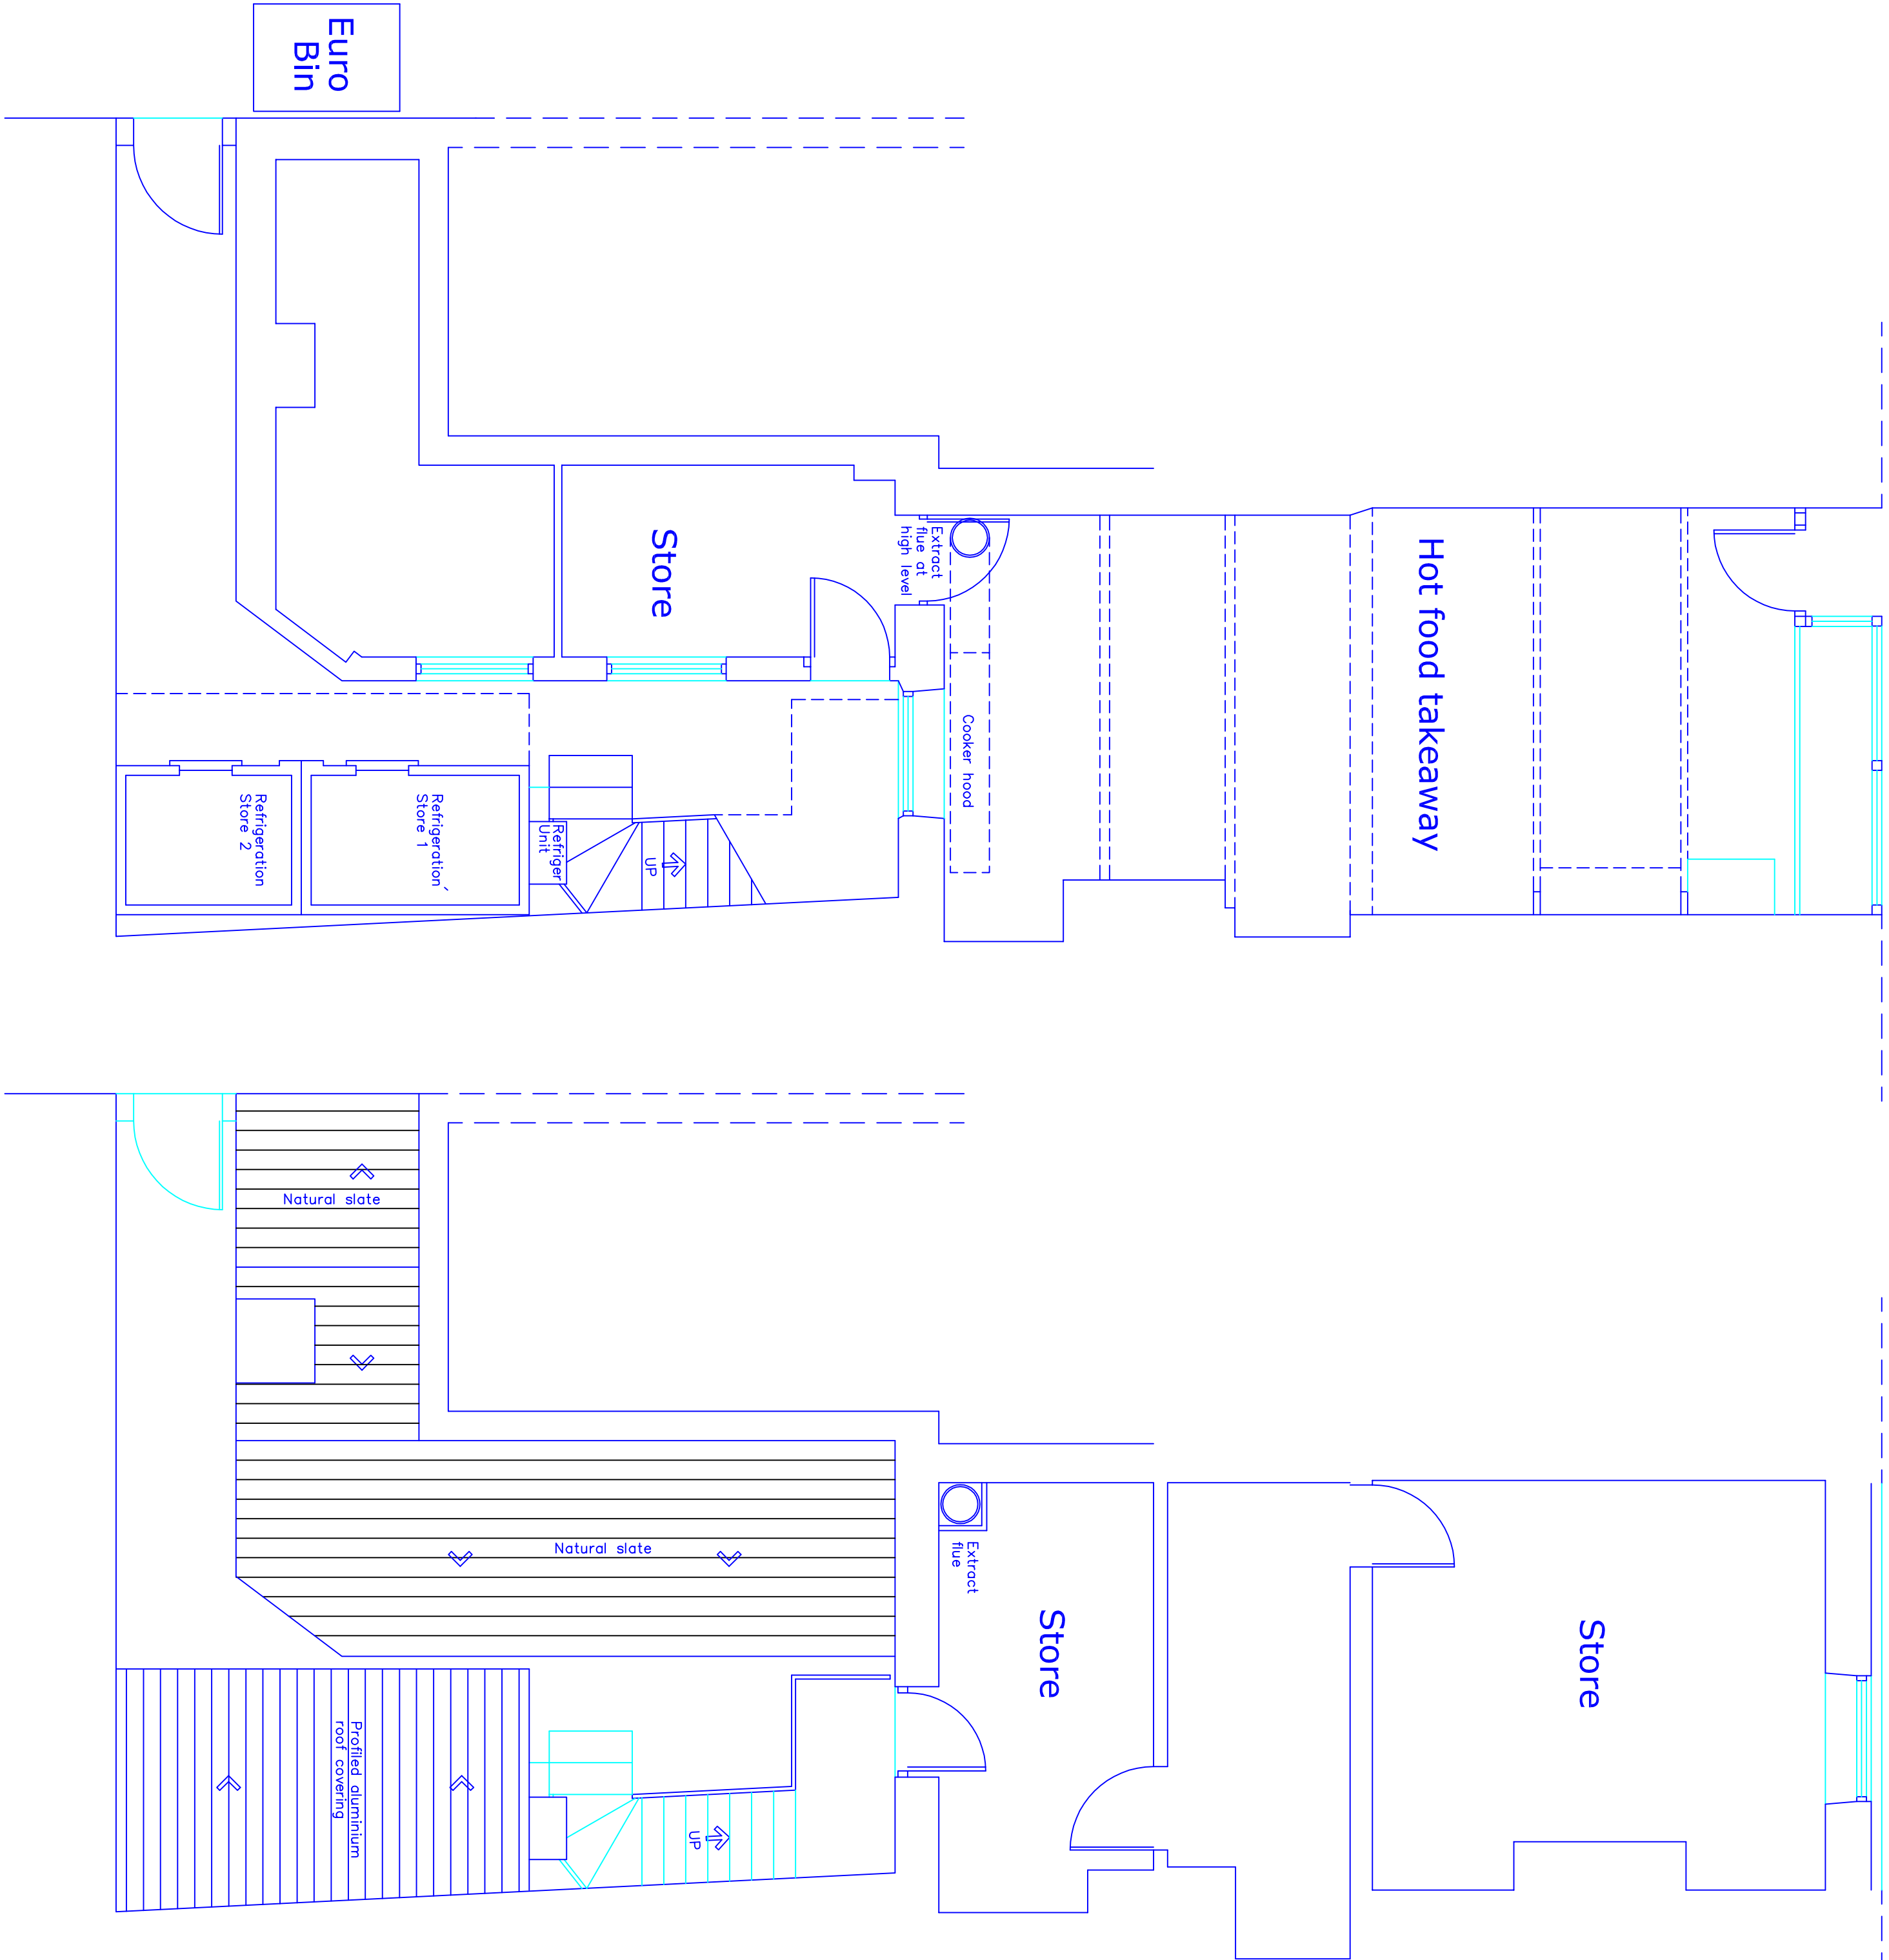


As~built Plan
Ground Floor

As~built Plan
First Floor

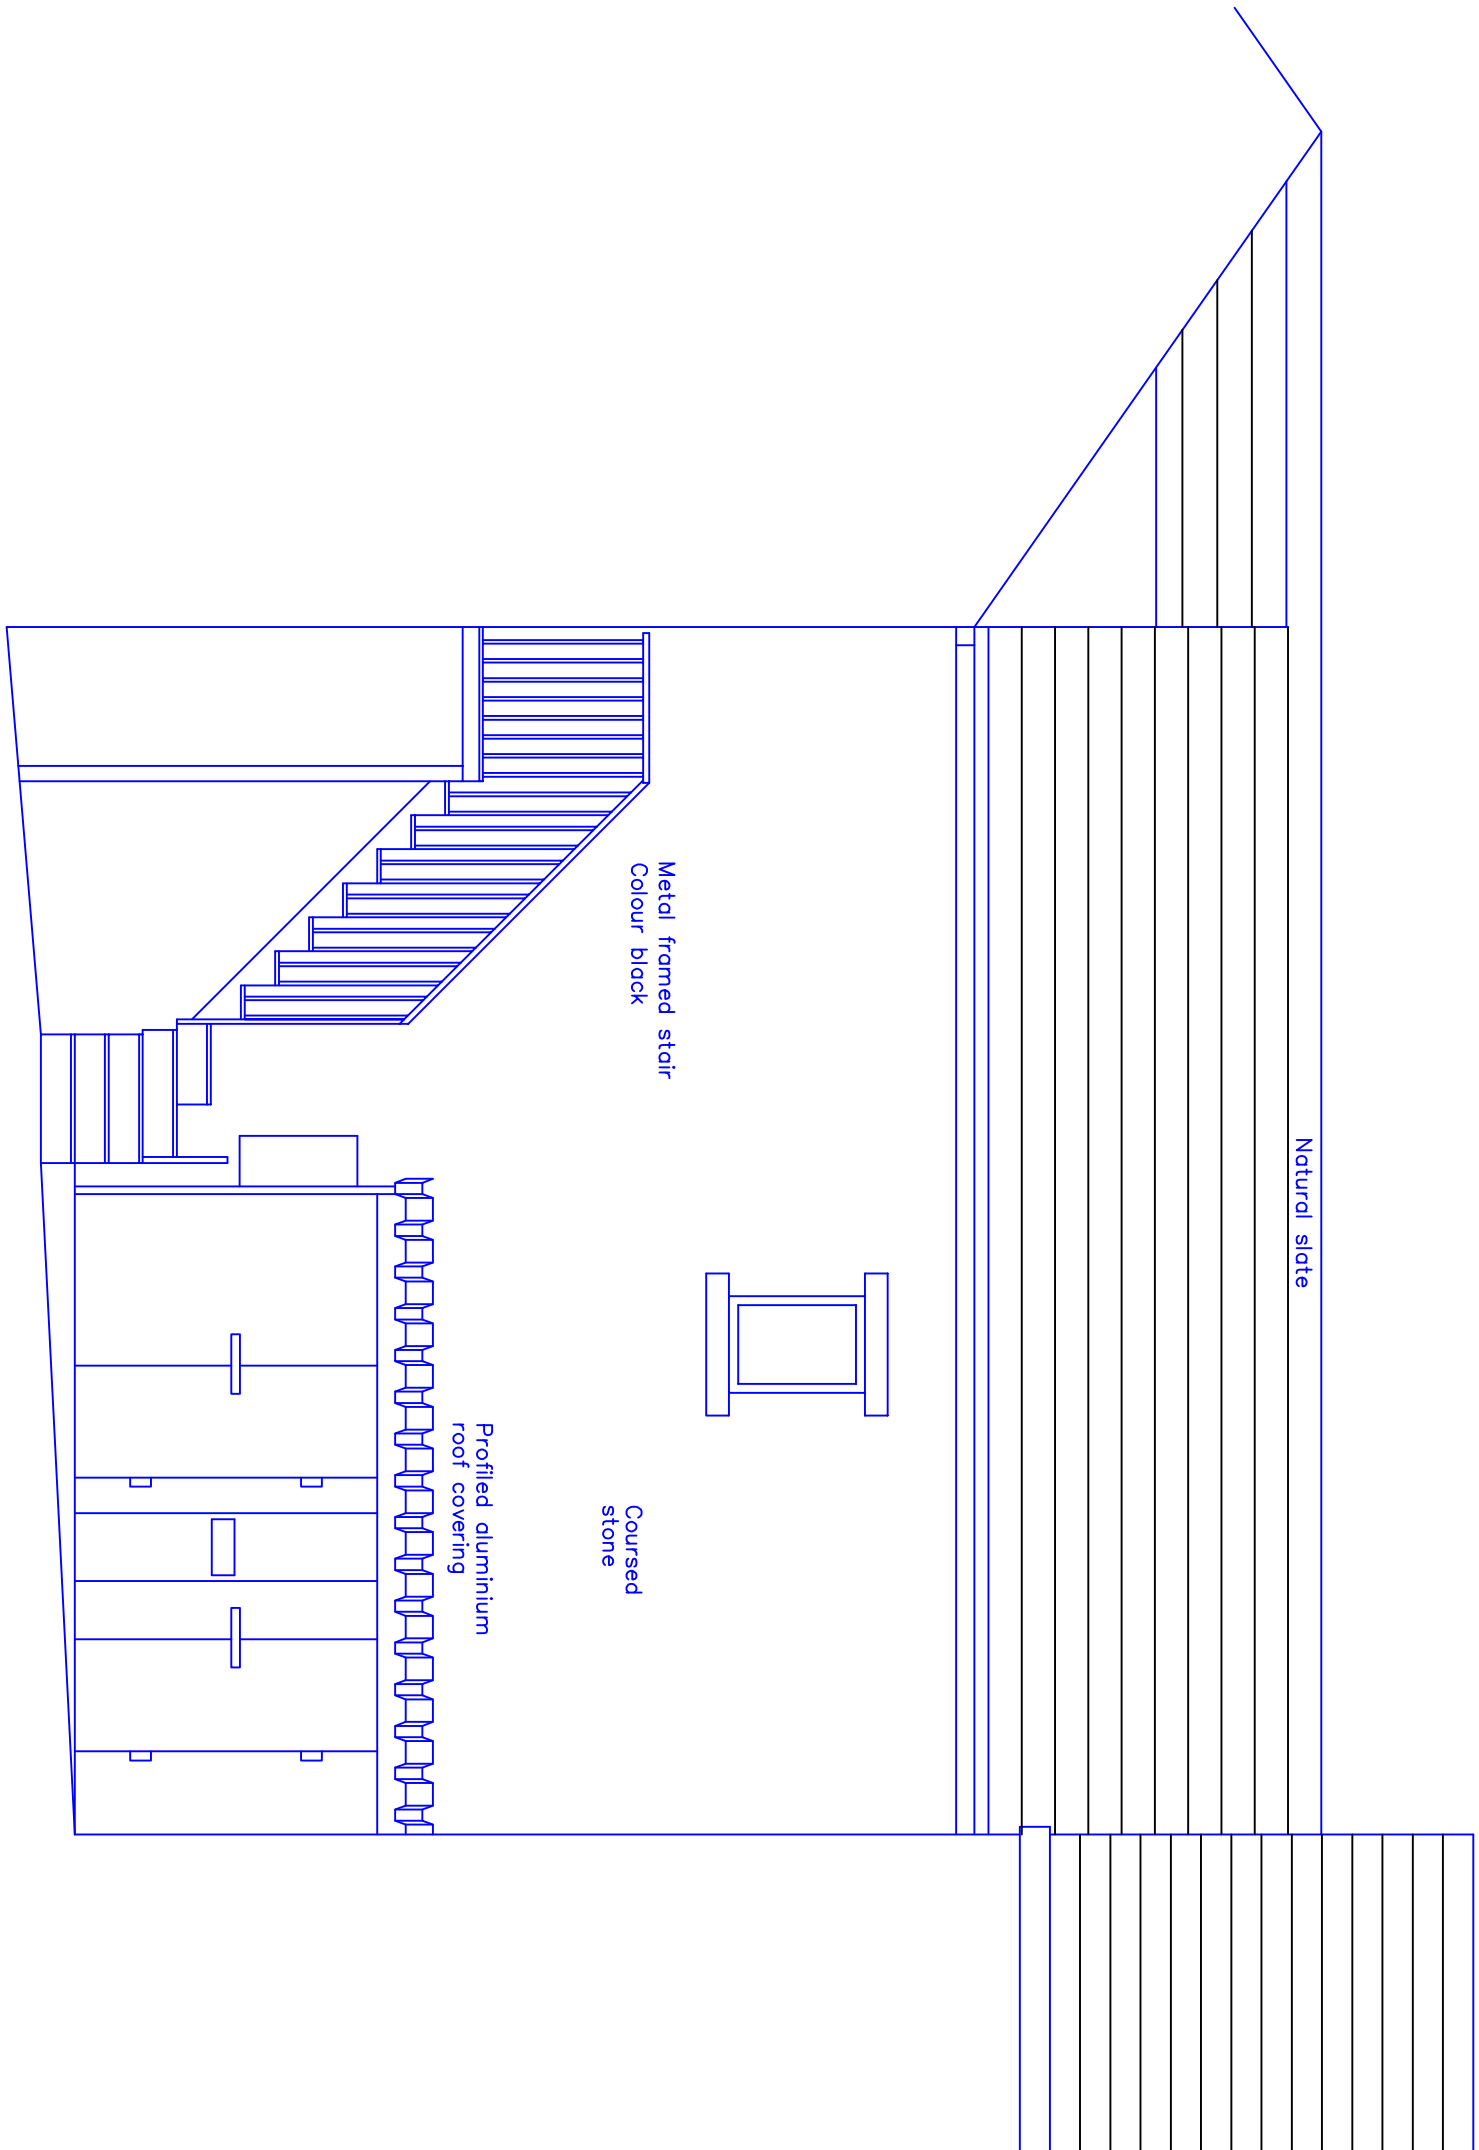

As~built Side Elevation

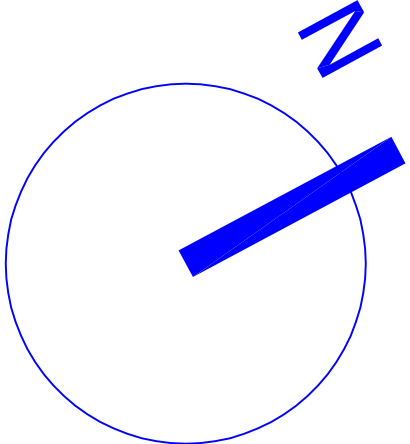

- C Rear stair amended as-built 02.11.2020
B Refrigeration as installed with canopy 14.09.2020
A Extract flue internal
Side elevation added with stair
Bins indicated / flue reduced in height 20.08.2020

This drawing and design concept is the property of PPV design. It should not be reproduced without written permission

0 1 2 3 m

62 Bridge Street scale 1:50 @ A1
Ramsbottom June 2020
BU0 9AG

PM7-02C As~built Plans & Elevations
P P V design Ltd

2 Helmshore Road, Helmshore Village
Ramsbottom, Lancashire BL8 4PA
Gary Dearden (B&H) DpArch RBA
garden@ppv-design.co.uk www.ppv-design.co.uk
T. 01706 622751 M. 07712 669482