
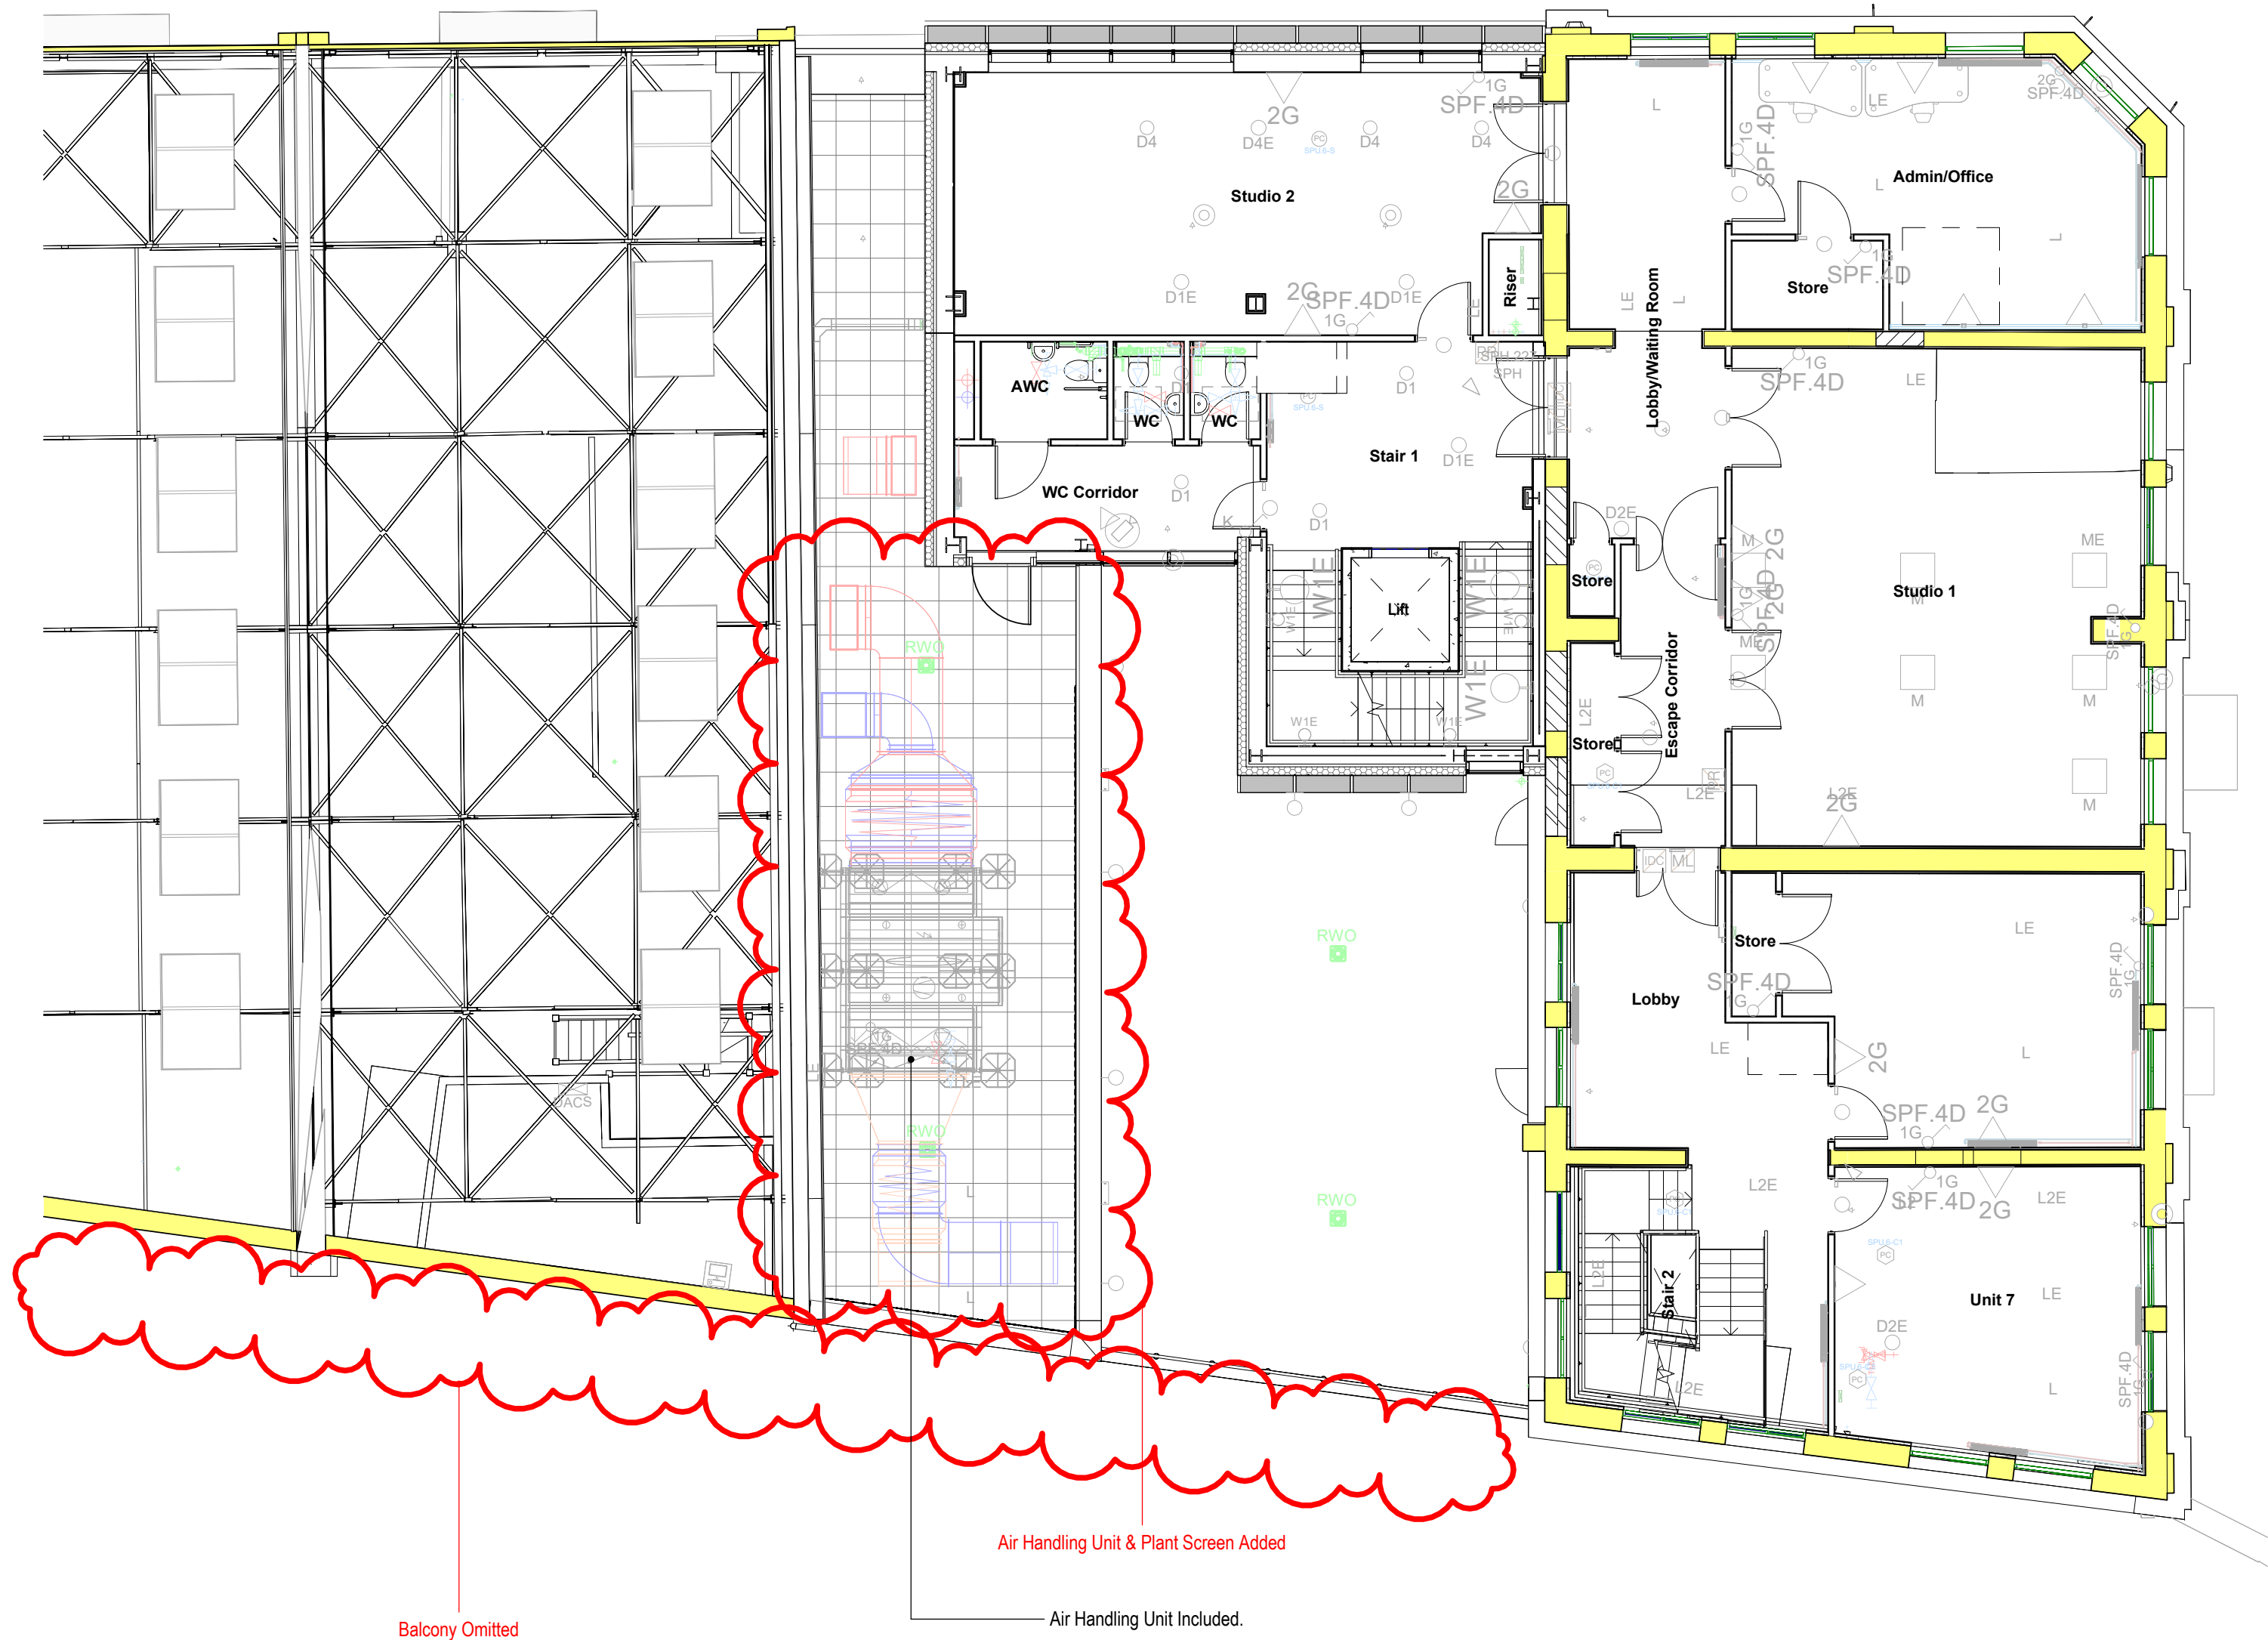



Notes
The Contractor is to check all dimensions and conditions on site before commencing. Do not scale from this drawing.
This drawing remains the copyright of POZZONI Architecture Ltd.

Scale Bars		TO BE USED ONLY AS GUIDANCE			
1:100	mm	0	1000	2000	3000
1:200	mm	0	1000	2000	3000
1:500	m	0	10	20	30
1:1250	m	0	10	20	30

KEYPLAN

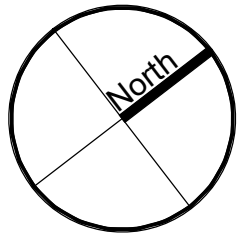

Level 01 Planning

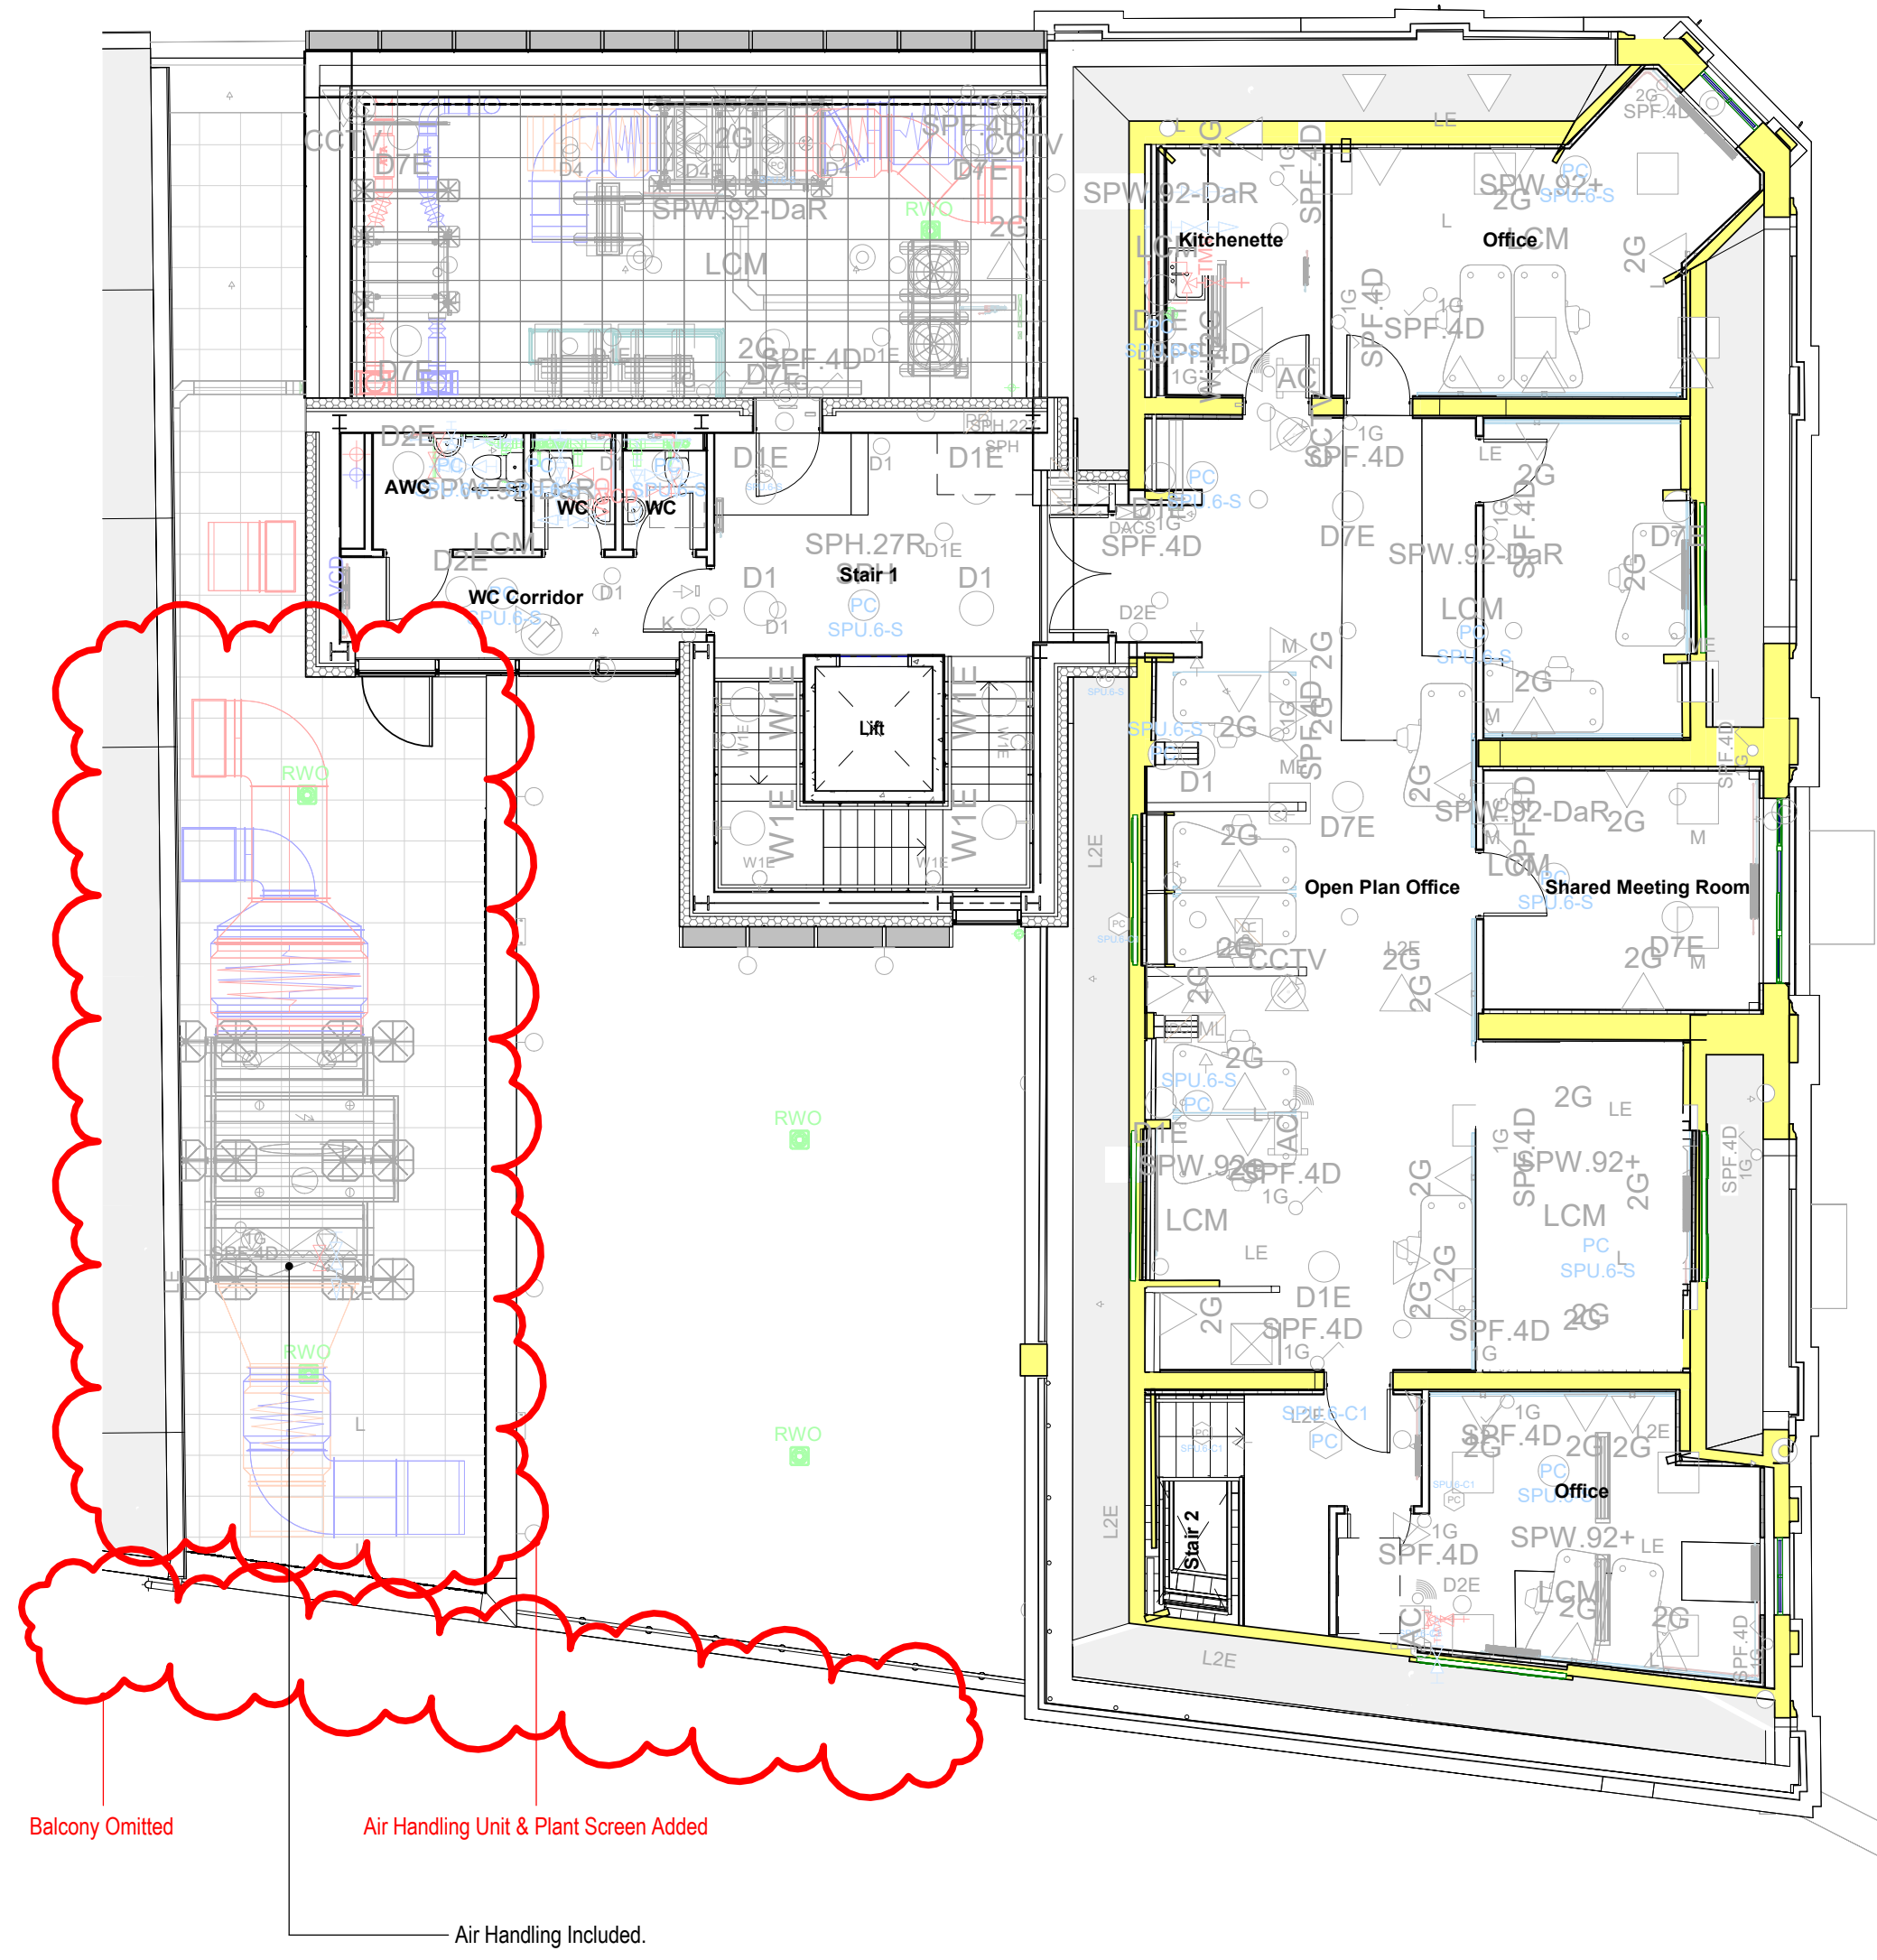

Level 02 Planning

P08	Non-Material Amendment - Balcony omitted; Air Handling Unit added	MBR	09.02.24
P07	Issued for Planning	DY	23.02.23
P06	Updated to suit client comment. Balcony length reduced + alternative escape route and associated provisions to Market accommodation omitted.	DAS	10.01.23
P05	Stage 3 issue	AT	14.10.22
P04	General Layout Updates	AT	09.09.22
P03	General updates to comments	LM	12.08.22
P02	Updated - new sections added	LM	29.07.22
P01	Doors shown double swing	SS	08.06.22
Rev	Description	By	Date

Vinci Construction UK Ltd

Radcliffe Market Chambers & Basement
Planning - GA Floor Plan - First + Second Floor

P5860_1202 Rev P08

1202

03/07/23 Scale 1 : 100 @ A1

DM DAS TT

Planning Tender Construction

Design Contract As Built

pozzoni

10-12 Emerald Street
London
WC1N 3QA

Woodville House
2 Woodville Road
Altrincham
WA14 2FH

+44 20 7078 0079
architects@pozzoni.co.uk

+44 161 928 7848
www.pozzoni.co.uk

C:\Users\mbranco\Documents\RADHUB-POZ-V2-ZZ-M3-A-0001_michael.branco.rvt 20/02/2024 11:51:05