




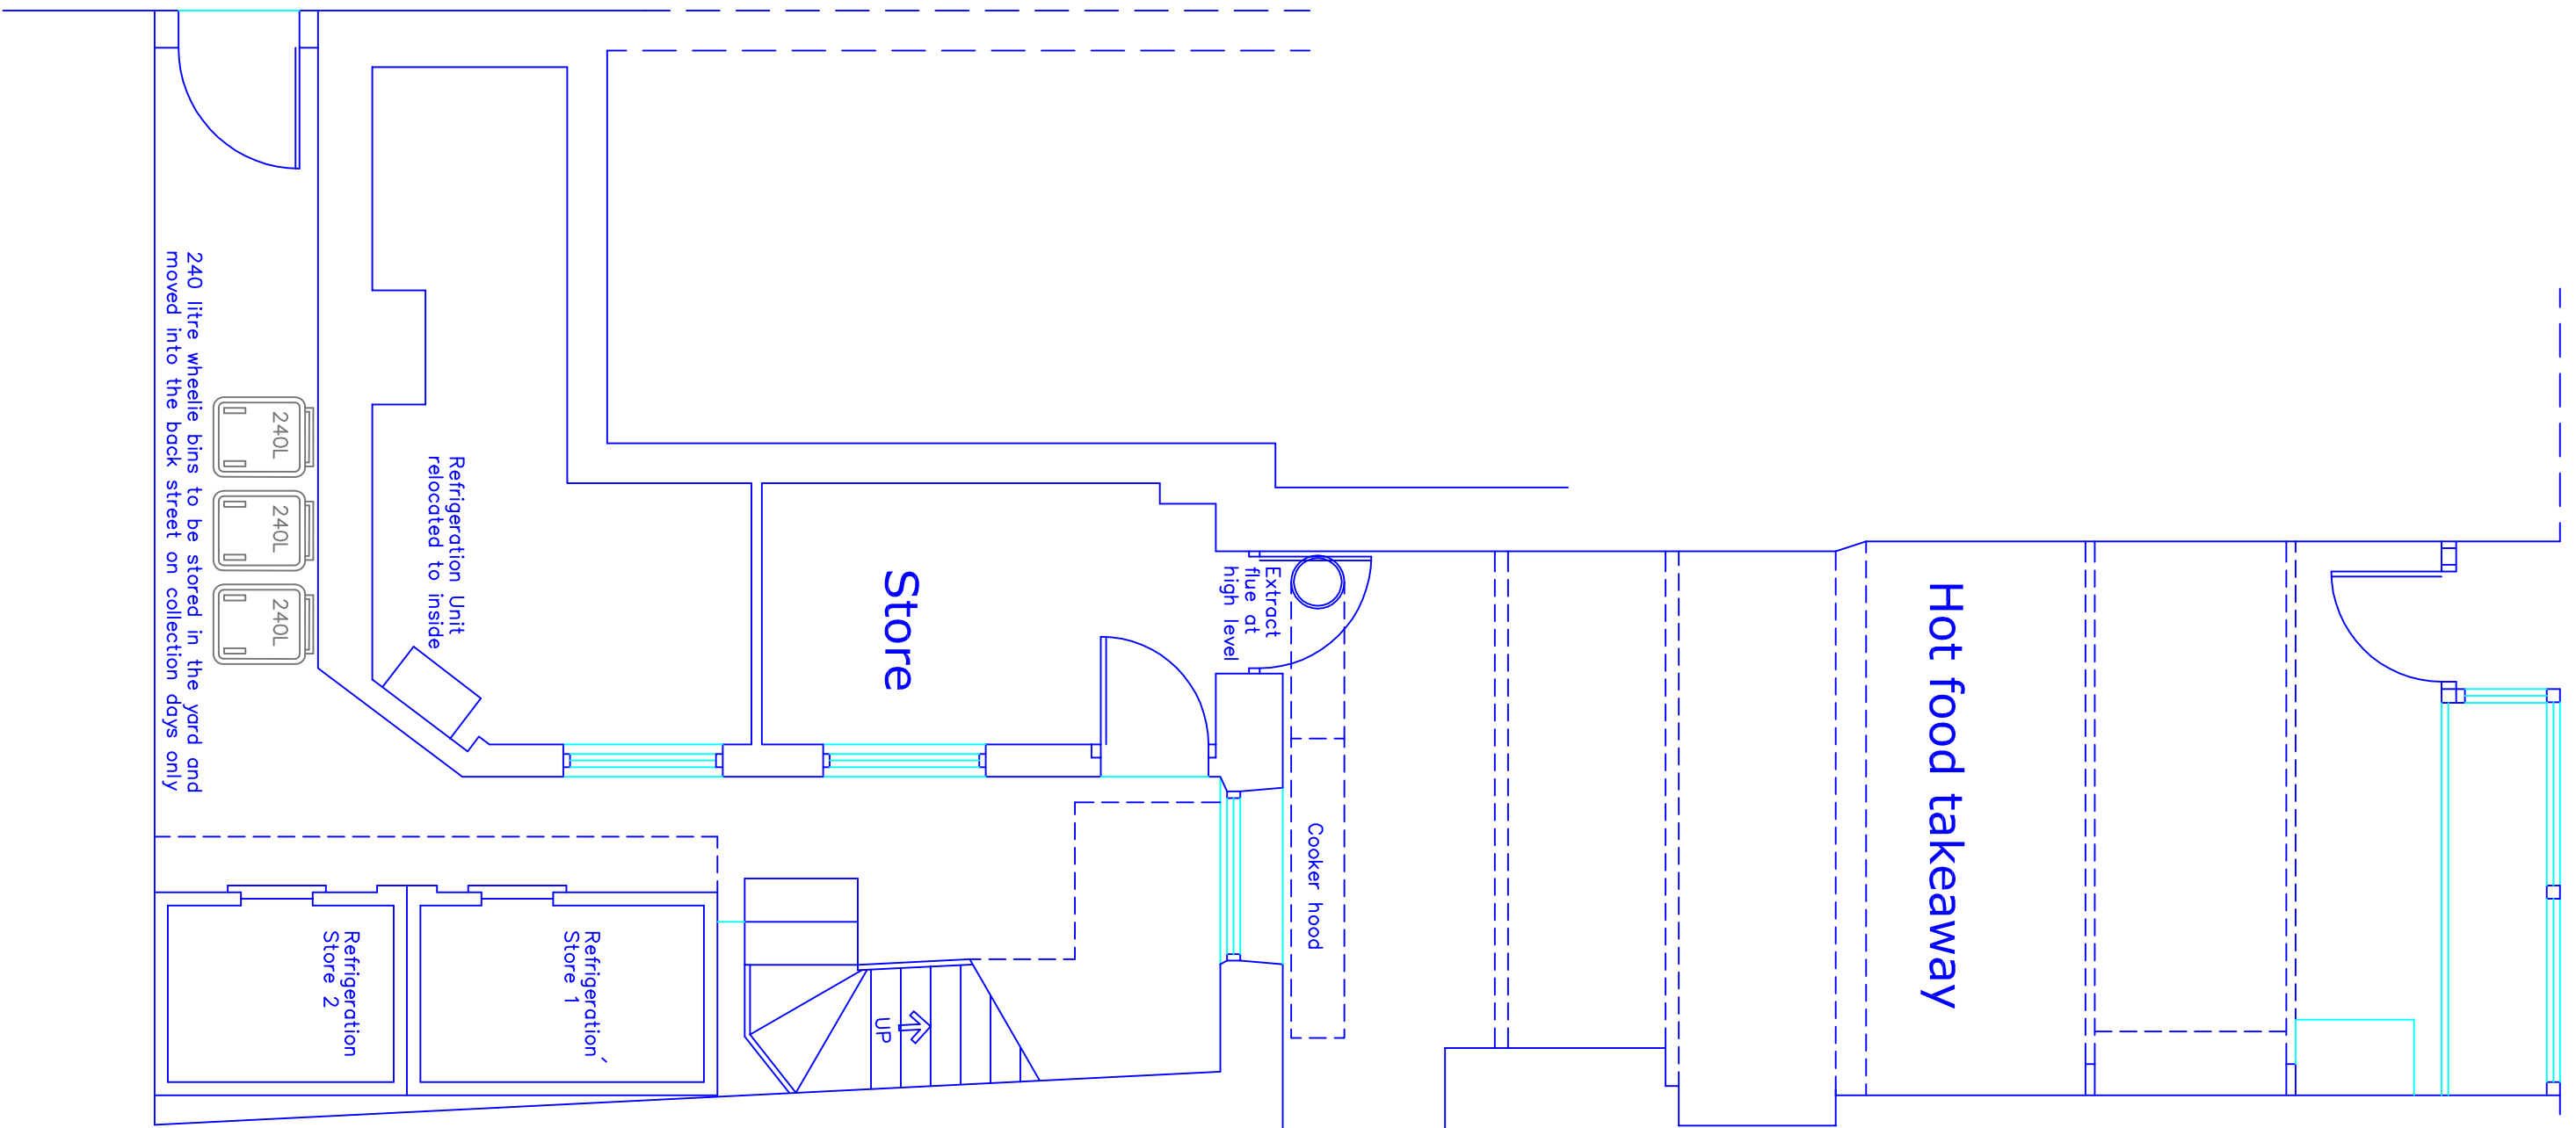


As~built Plan
Ground Floor

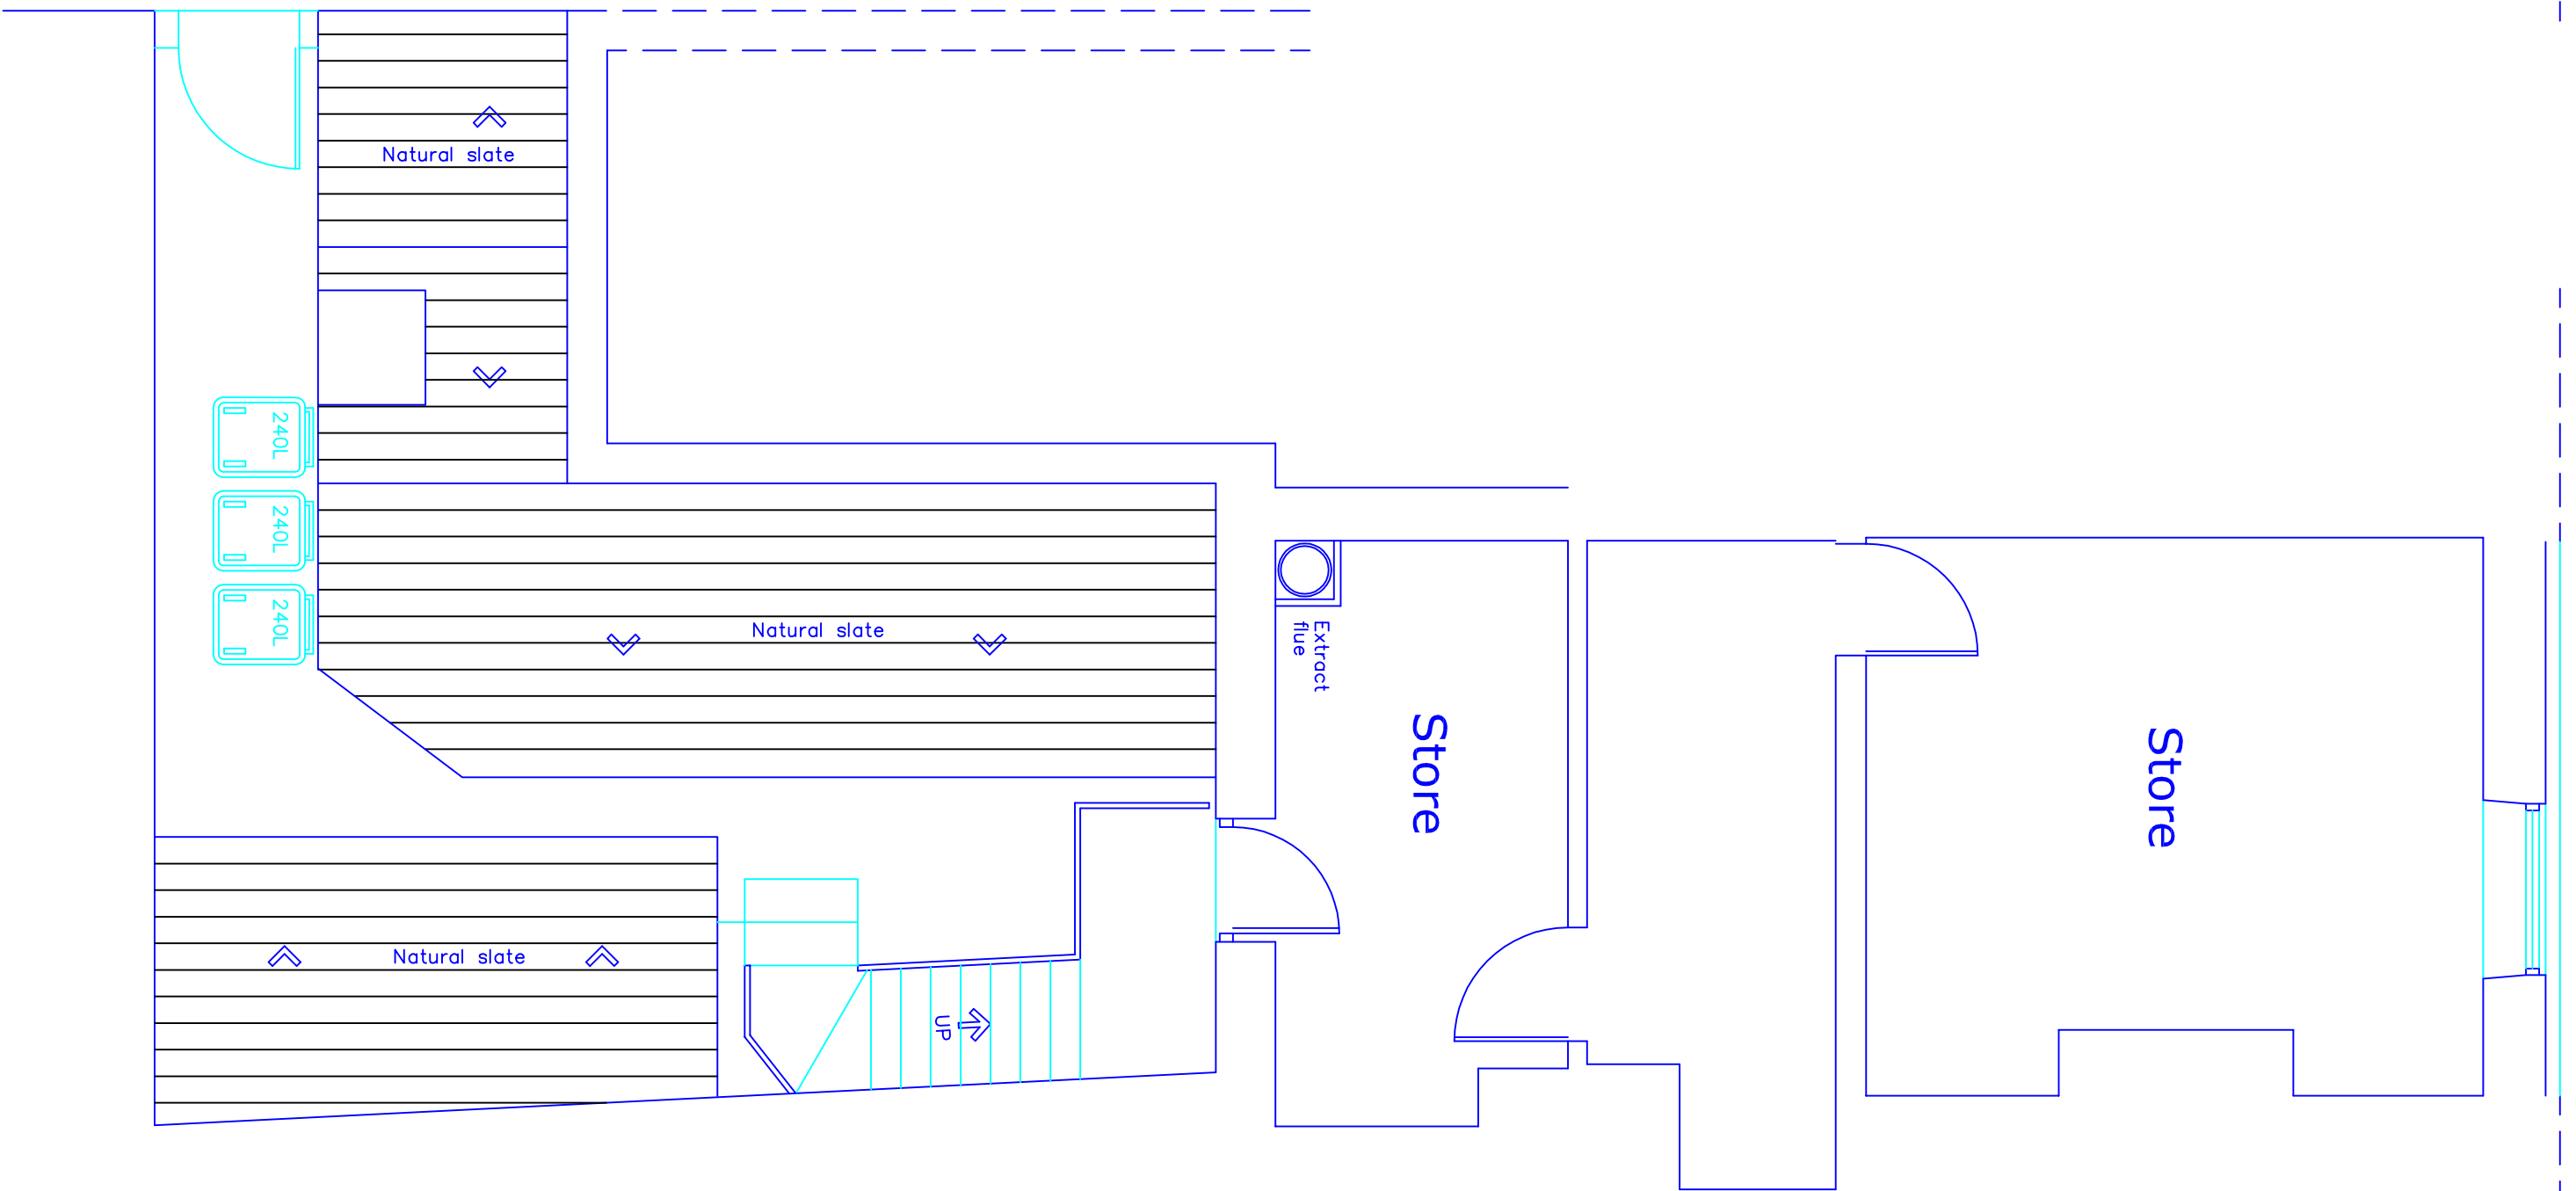


As~built Plan
First Floor

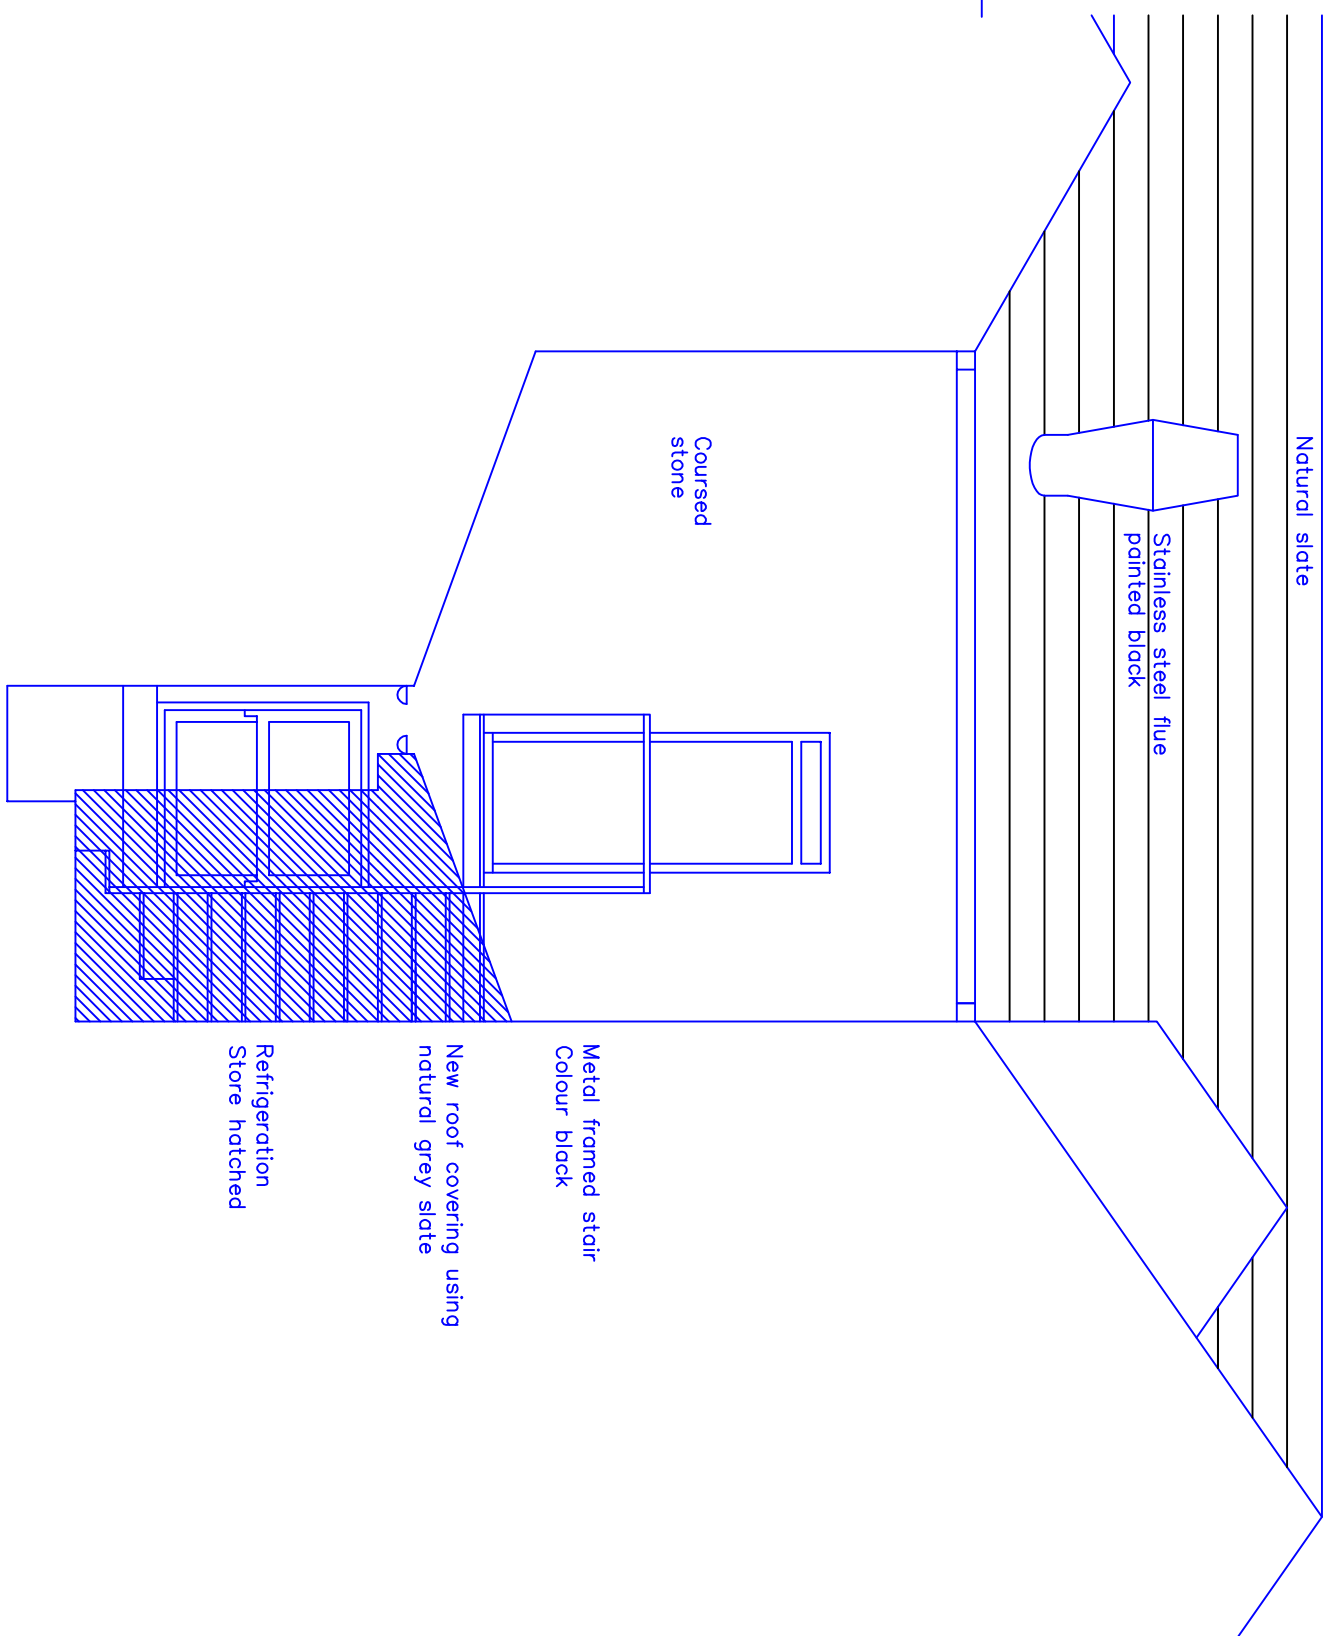


As~built Rear Elevation

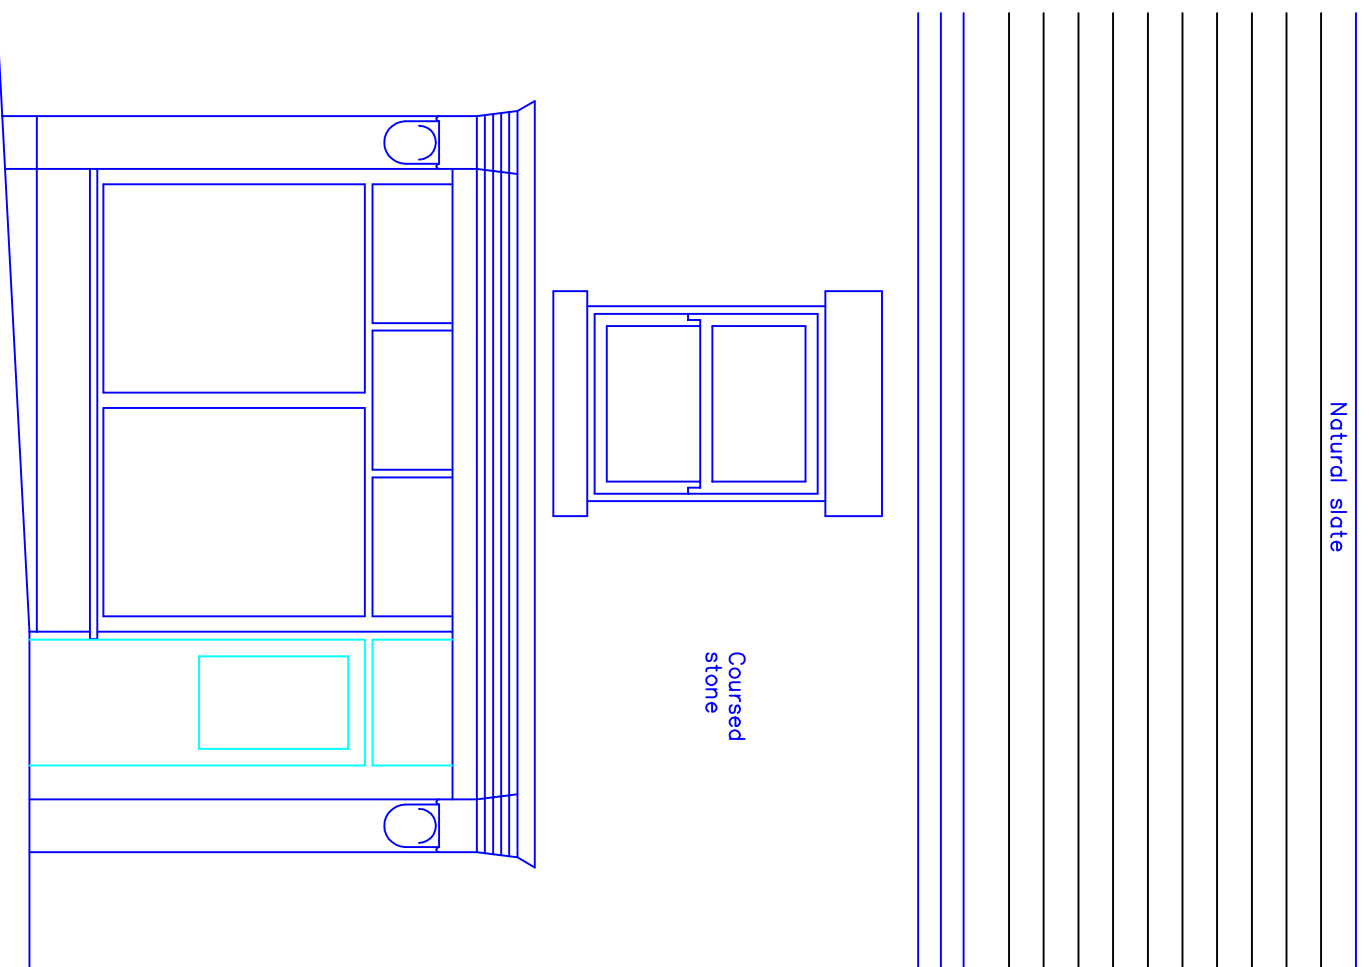

As~built Front Elevation

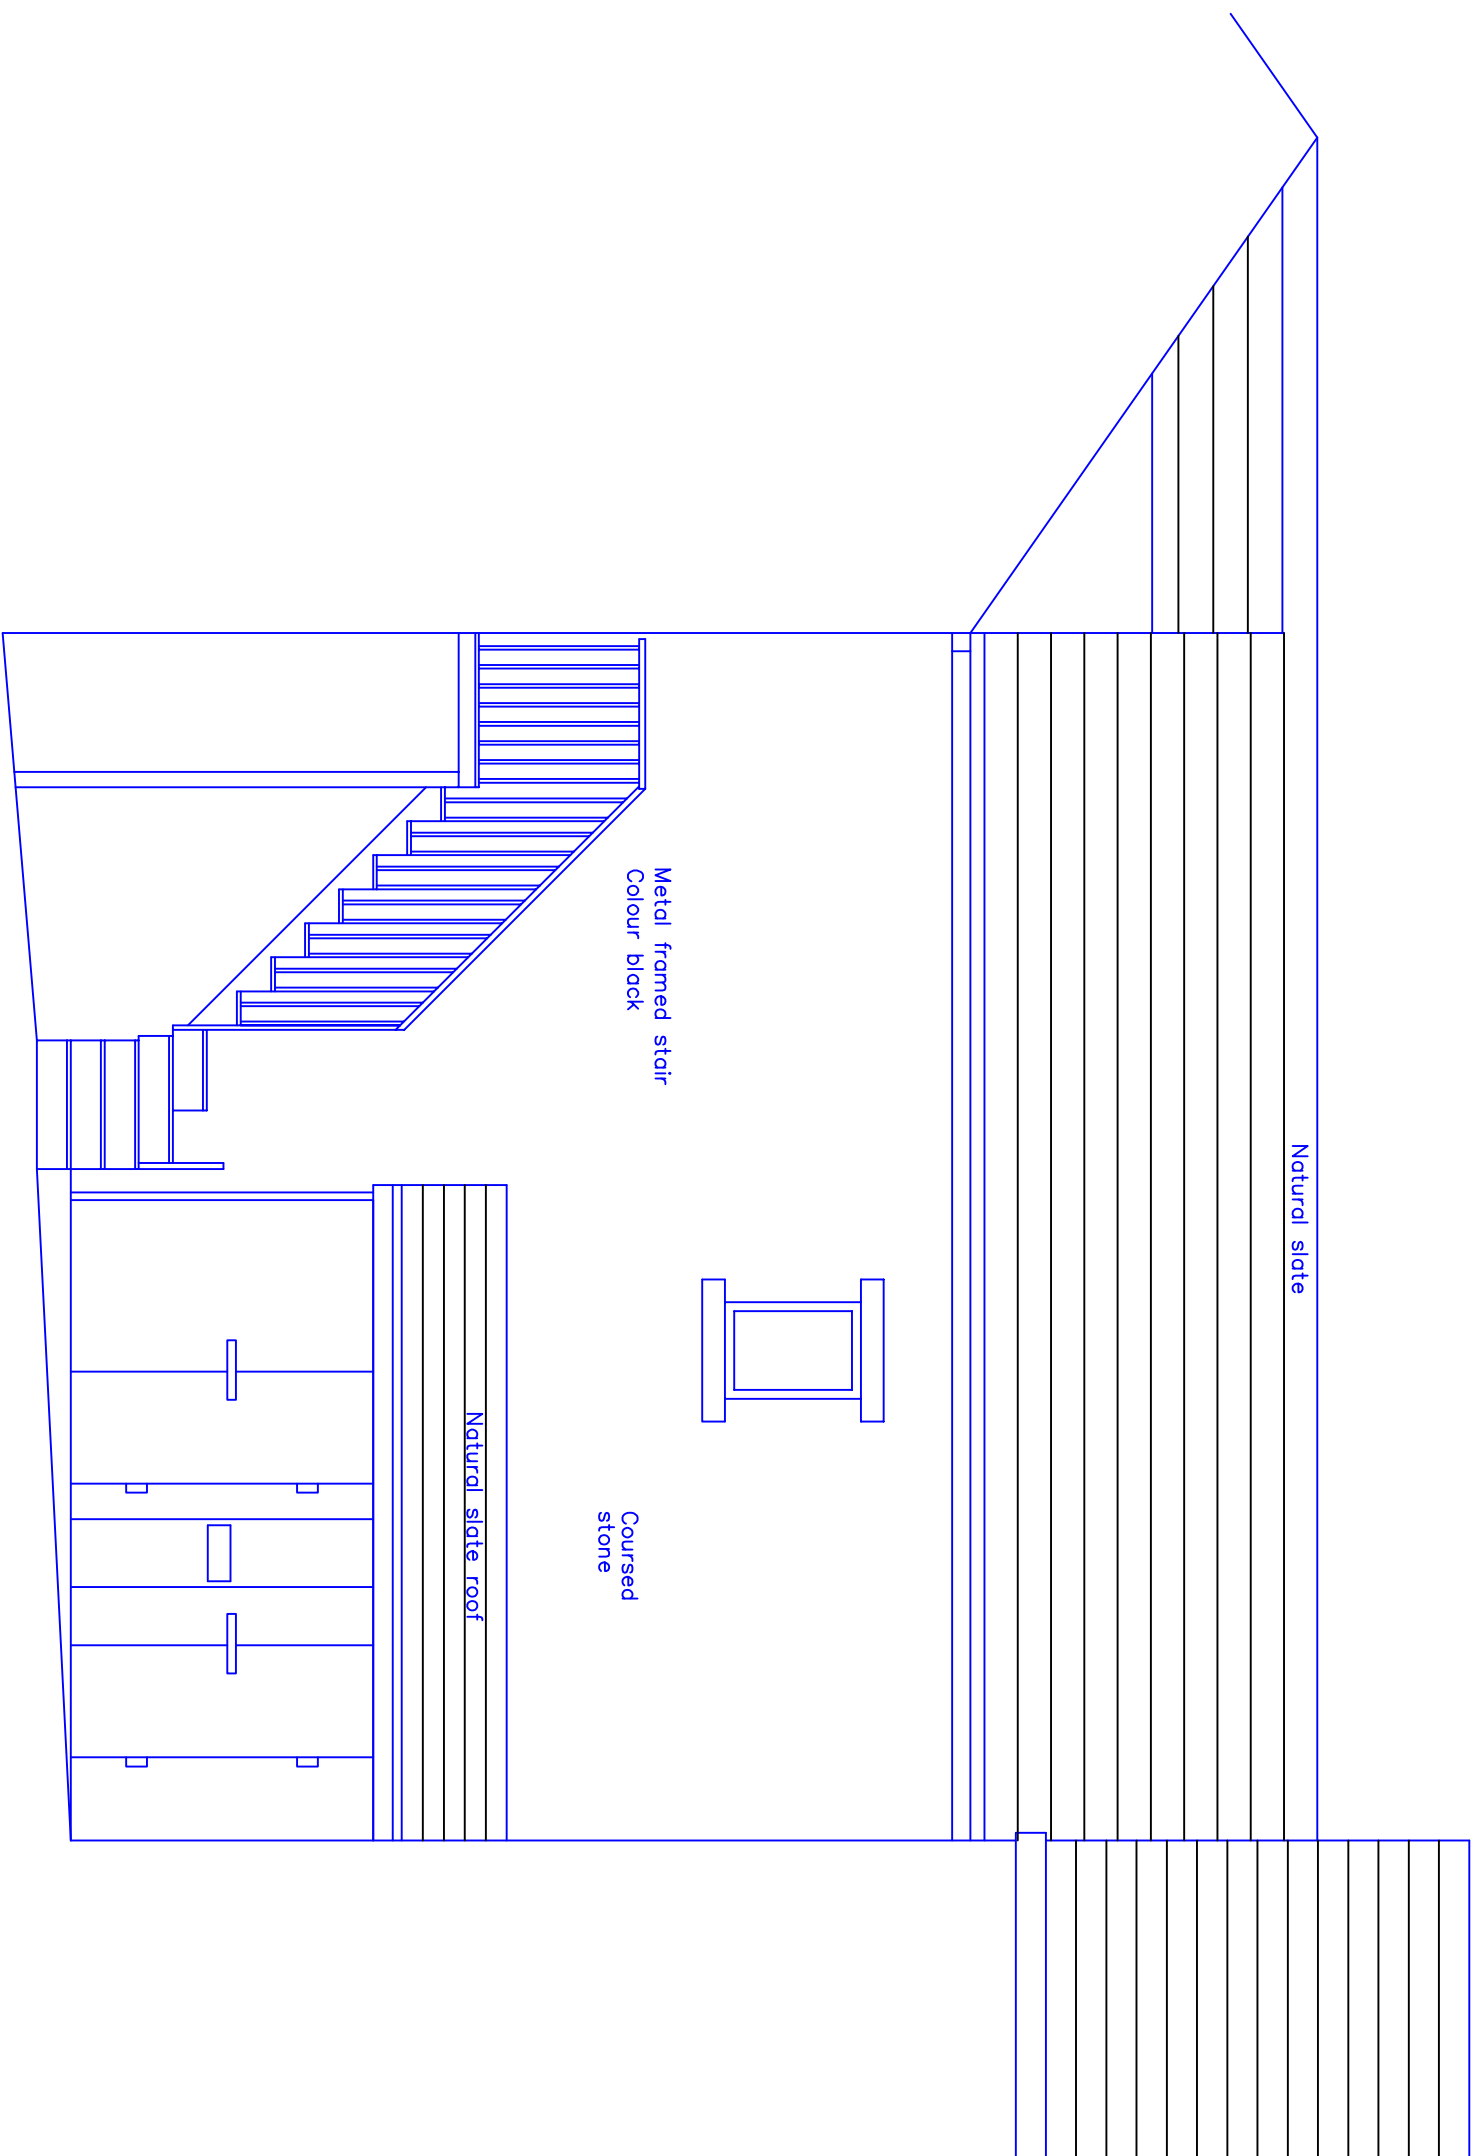

As~built Side Elevation

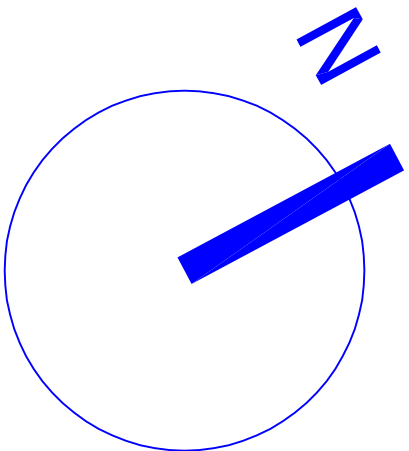

- D Site roof added over refrigeration 18.11.2021
C Rear stair amended as-built 02.11.2020
B Refrigeration as installed with canopy 14.09.2020
A Extract flue internal 20.08.2020
Side elevation added with stair
Bins indicated / flue reduced in height

This drawing and design concept is the property of PPV design. It should not be reproduced without written permission

0 1 2 3 m

62 Bridge Street
Rambottom
BLD 9AG

scale 1:50 @ A1
June 2020

PM7-02D
Proposed Plans & Elevations
P P V design Ltd

2 Helmshore Road, Holcombe Village
Rambottom, Lancashire BL8 4PA
Gary Dearden (JK home) DpArch RJA
garden@ppv-design.co.uk www.ppv-design.co.uk
T: 01706 622175 M: 07112 669482