



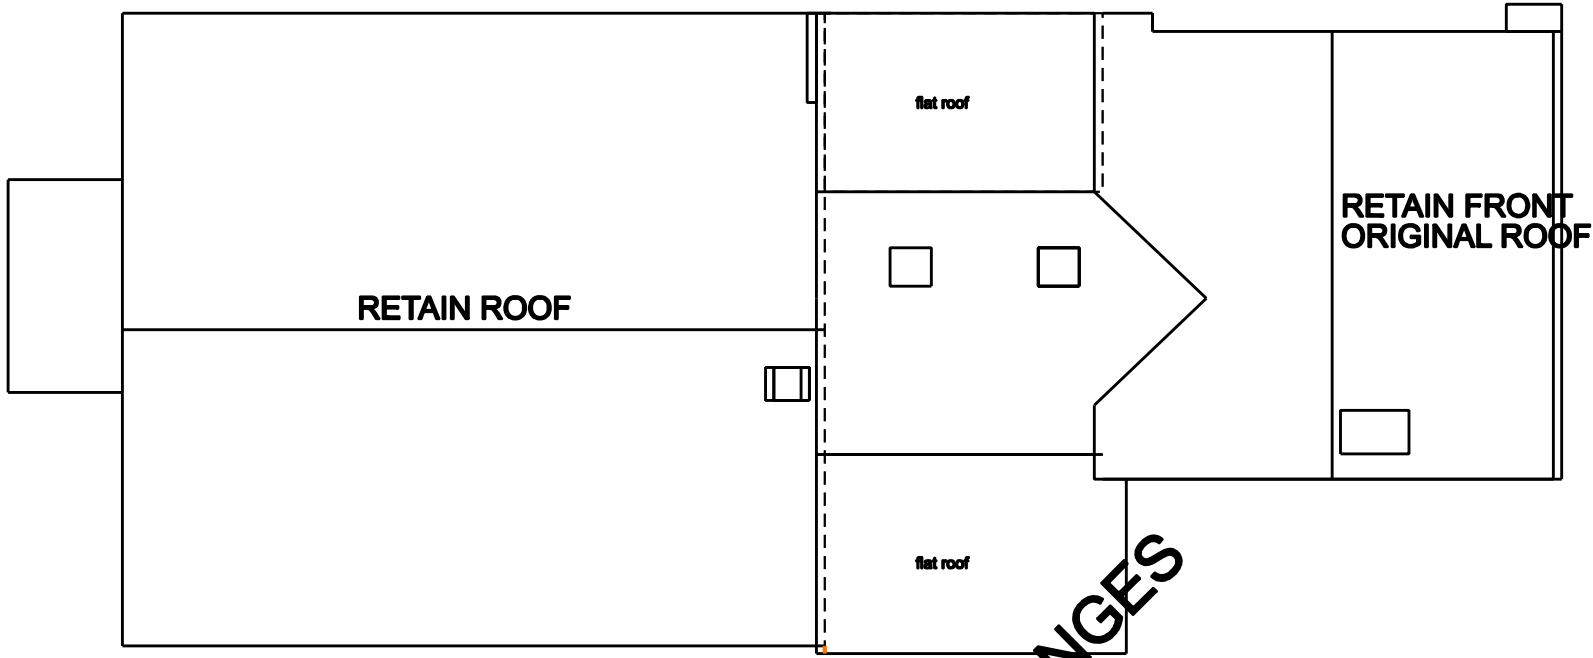


PROPOSED ROOF PLAN

NO CHANGES

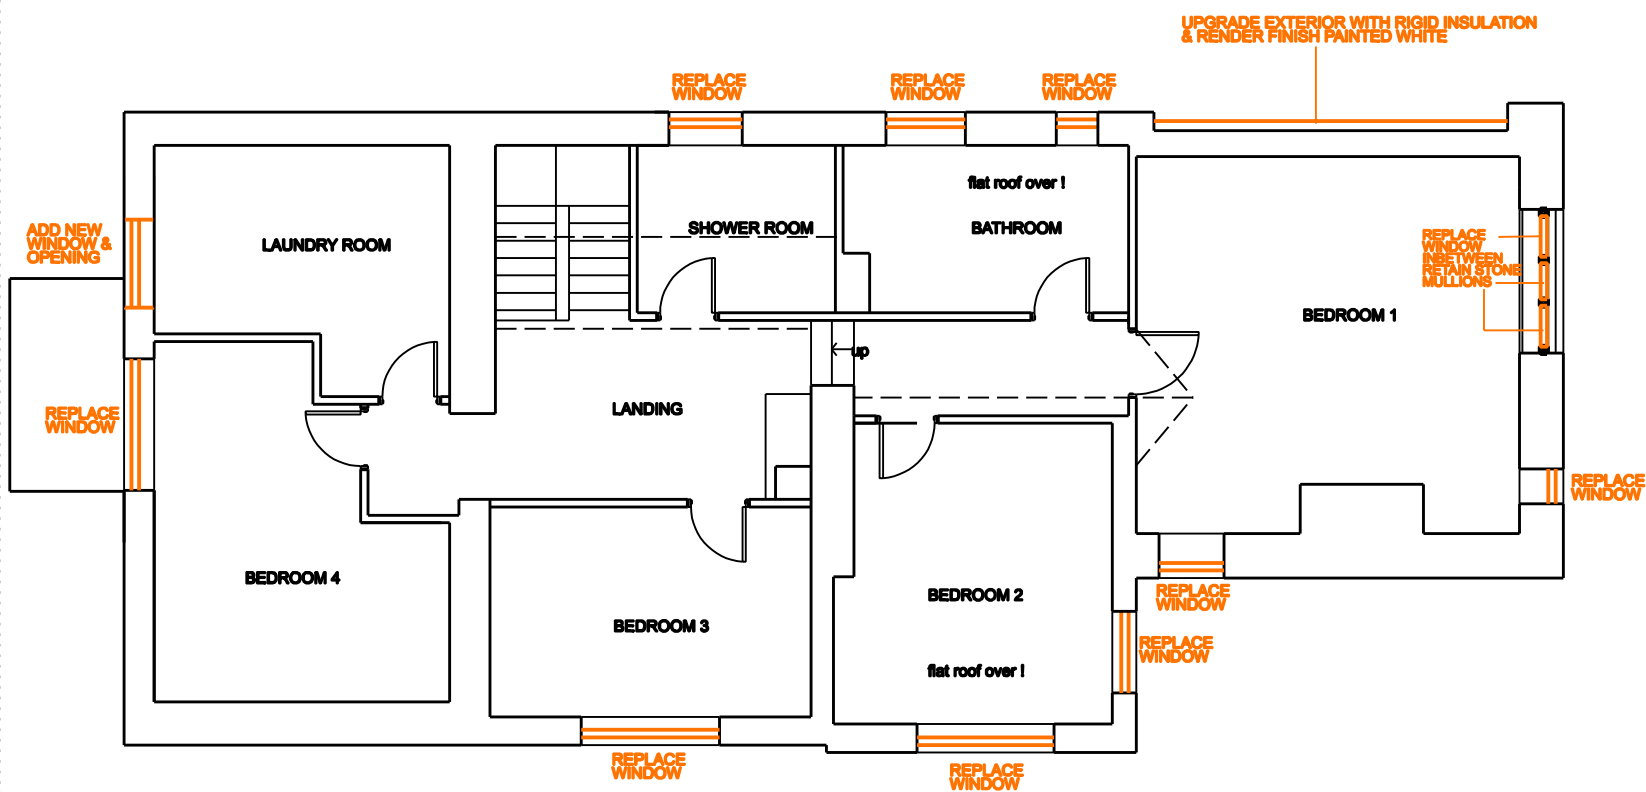

PROPOSED FIRST FLOOR PLAN

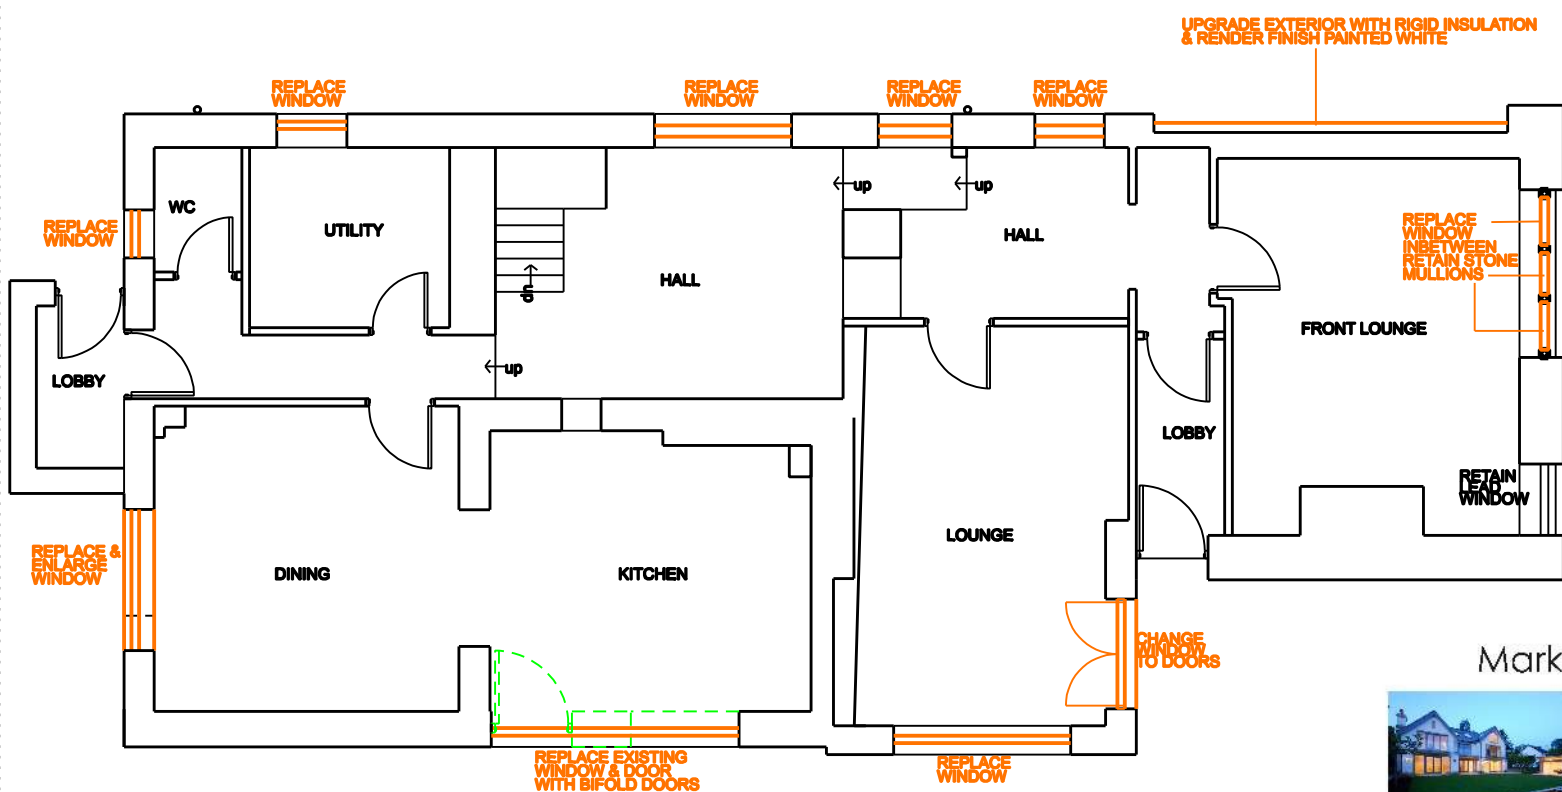

PROPOSED GROUND FLOOR PLAN

- DEMOLITION INDICATED IN GREEN DOTTED
- BLACK LINES ON PLAN INDICATE EXISTING TO BE RETAINED.
- ORANGE LINES ON PLAN INDICATE PROPOSED WORKS.

BAST HOUSE FARM COTTAGE
MANCHESTER ROAD
BURY BL9 5LZ

Drwg. No: 20234/ 04 / 03

Date : OCTOBER 2024

Scale 1:100 @ A3

Rev 18TH MAY 2025

Mark Thorley design limited



Mark Thorley MCIAT, MSAI, MFPWS

Chartered Architectural Technologist, Party wall surveyor & Architectural Illustrator.

Mobile : 07986 453541
email : mark@mark-thorley.com
website www.markthorleydesign.com

3 PROPOSED PLANS