
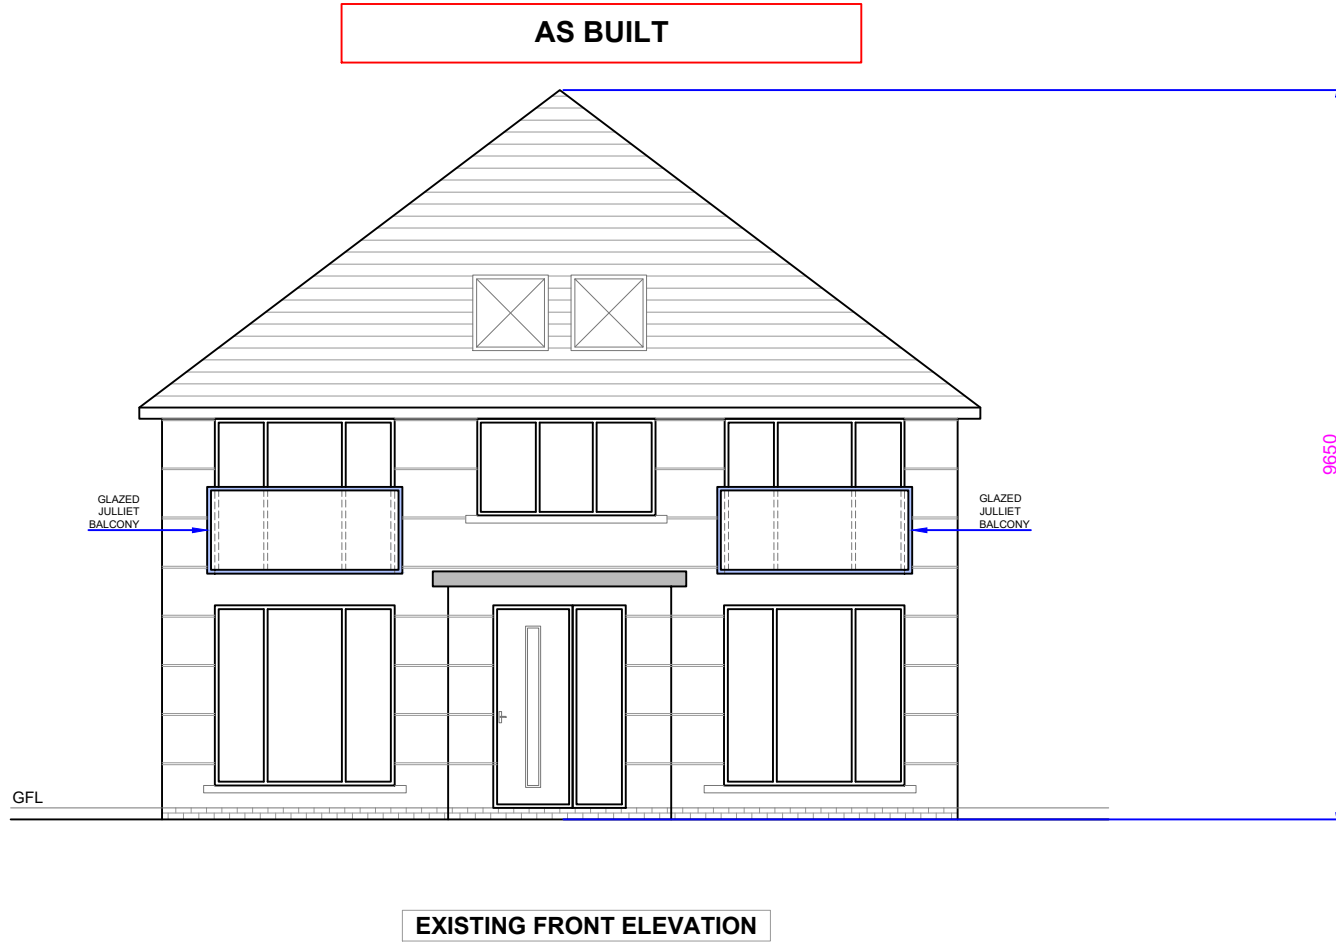
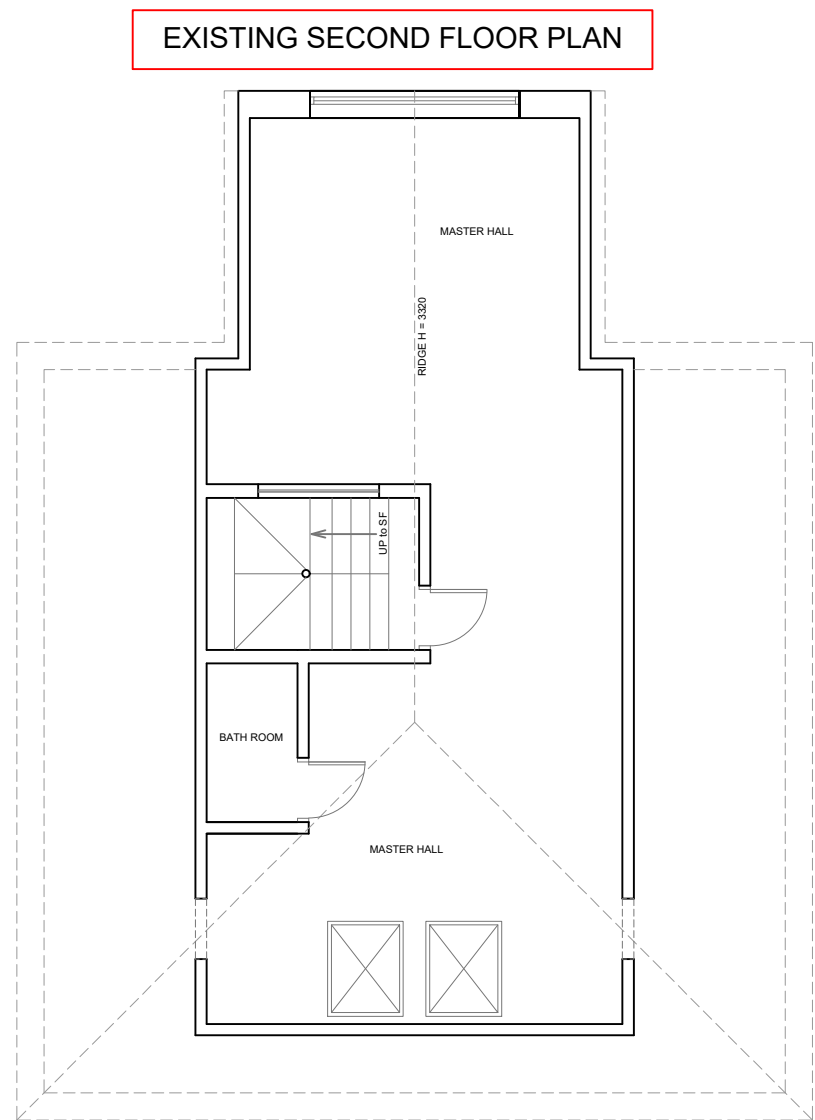
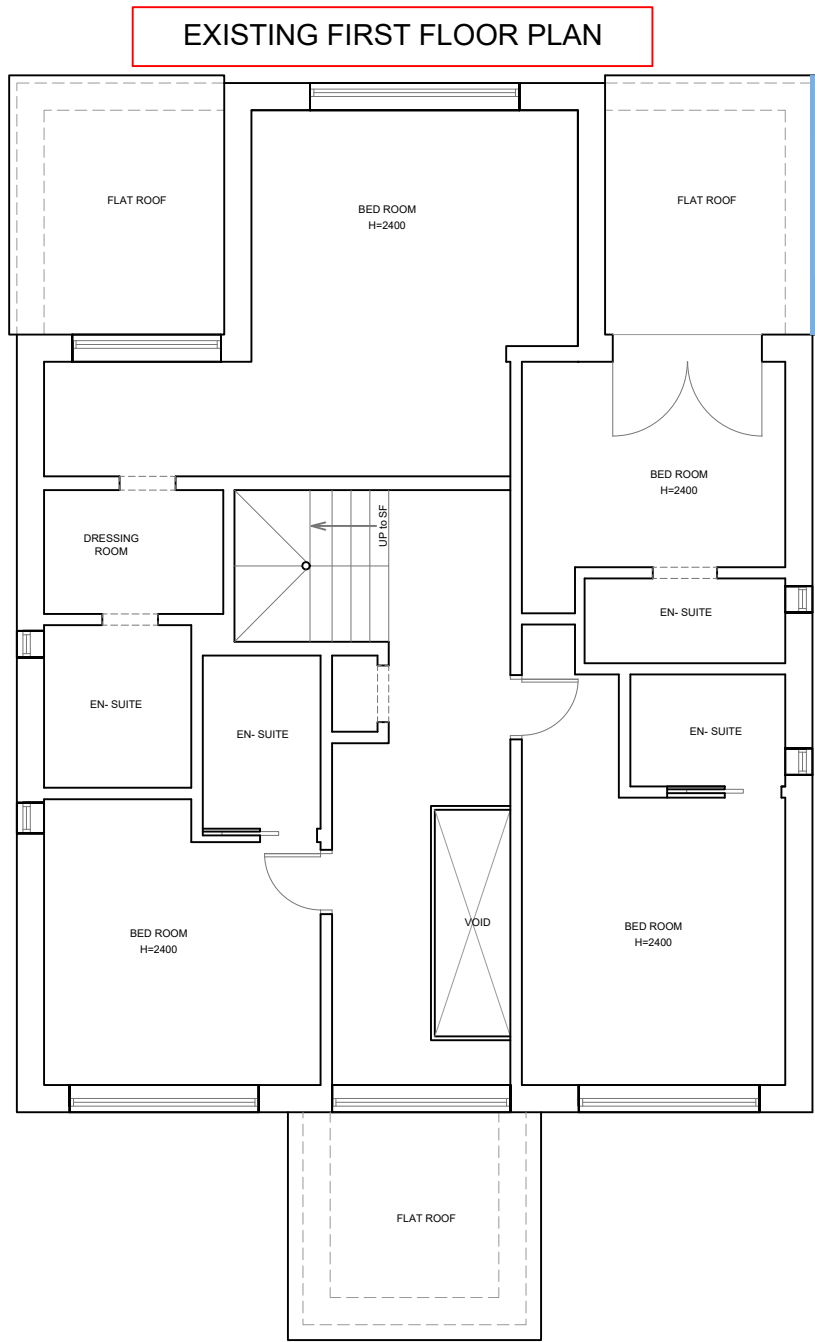


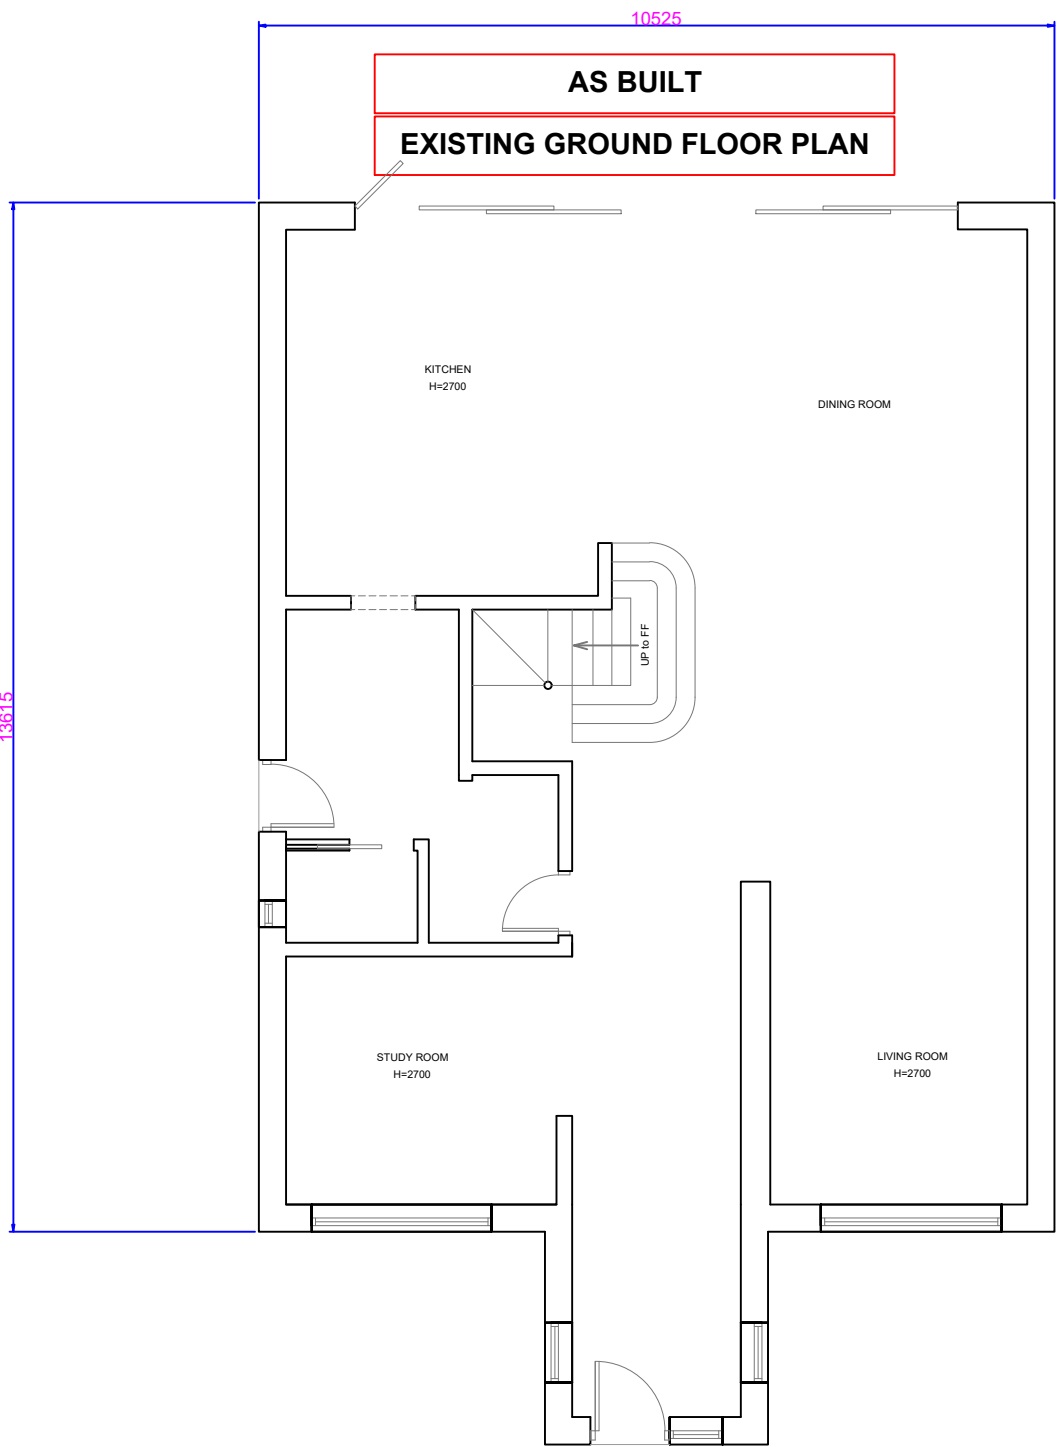

NOTES

REVISIONS

PROJECT: 22 COCKEY MOOR ROAD, BURY.
NEW BUILD DWELLING ALTERATIONS

CLIENT: SAEED

SCALE: 1:100 @ A1 SHEET

REFERENCE NO: 1423 AS BUILT

BARRY CULLEN
ARCHITECTURE LTD
email: barrycullenarchitecture@gmail.com
mob: 07851262695