





1 Proposed Block Plan
1:100

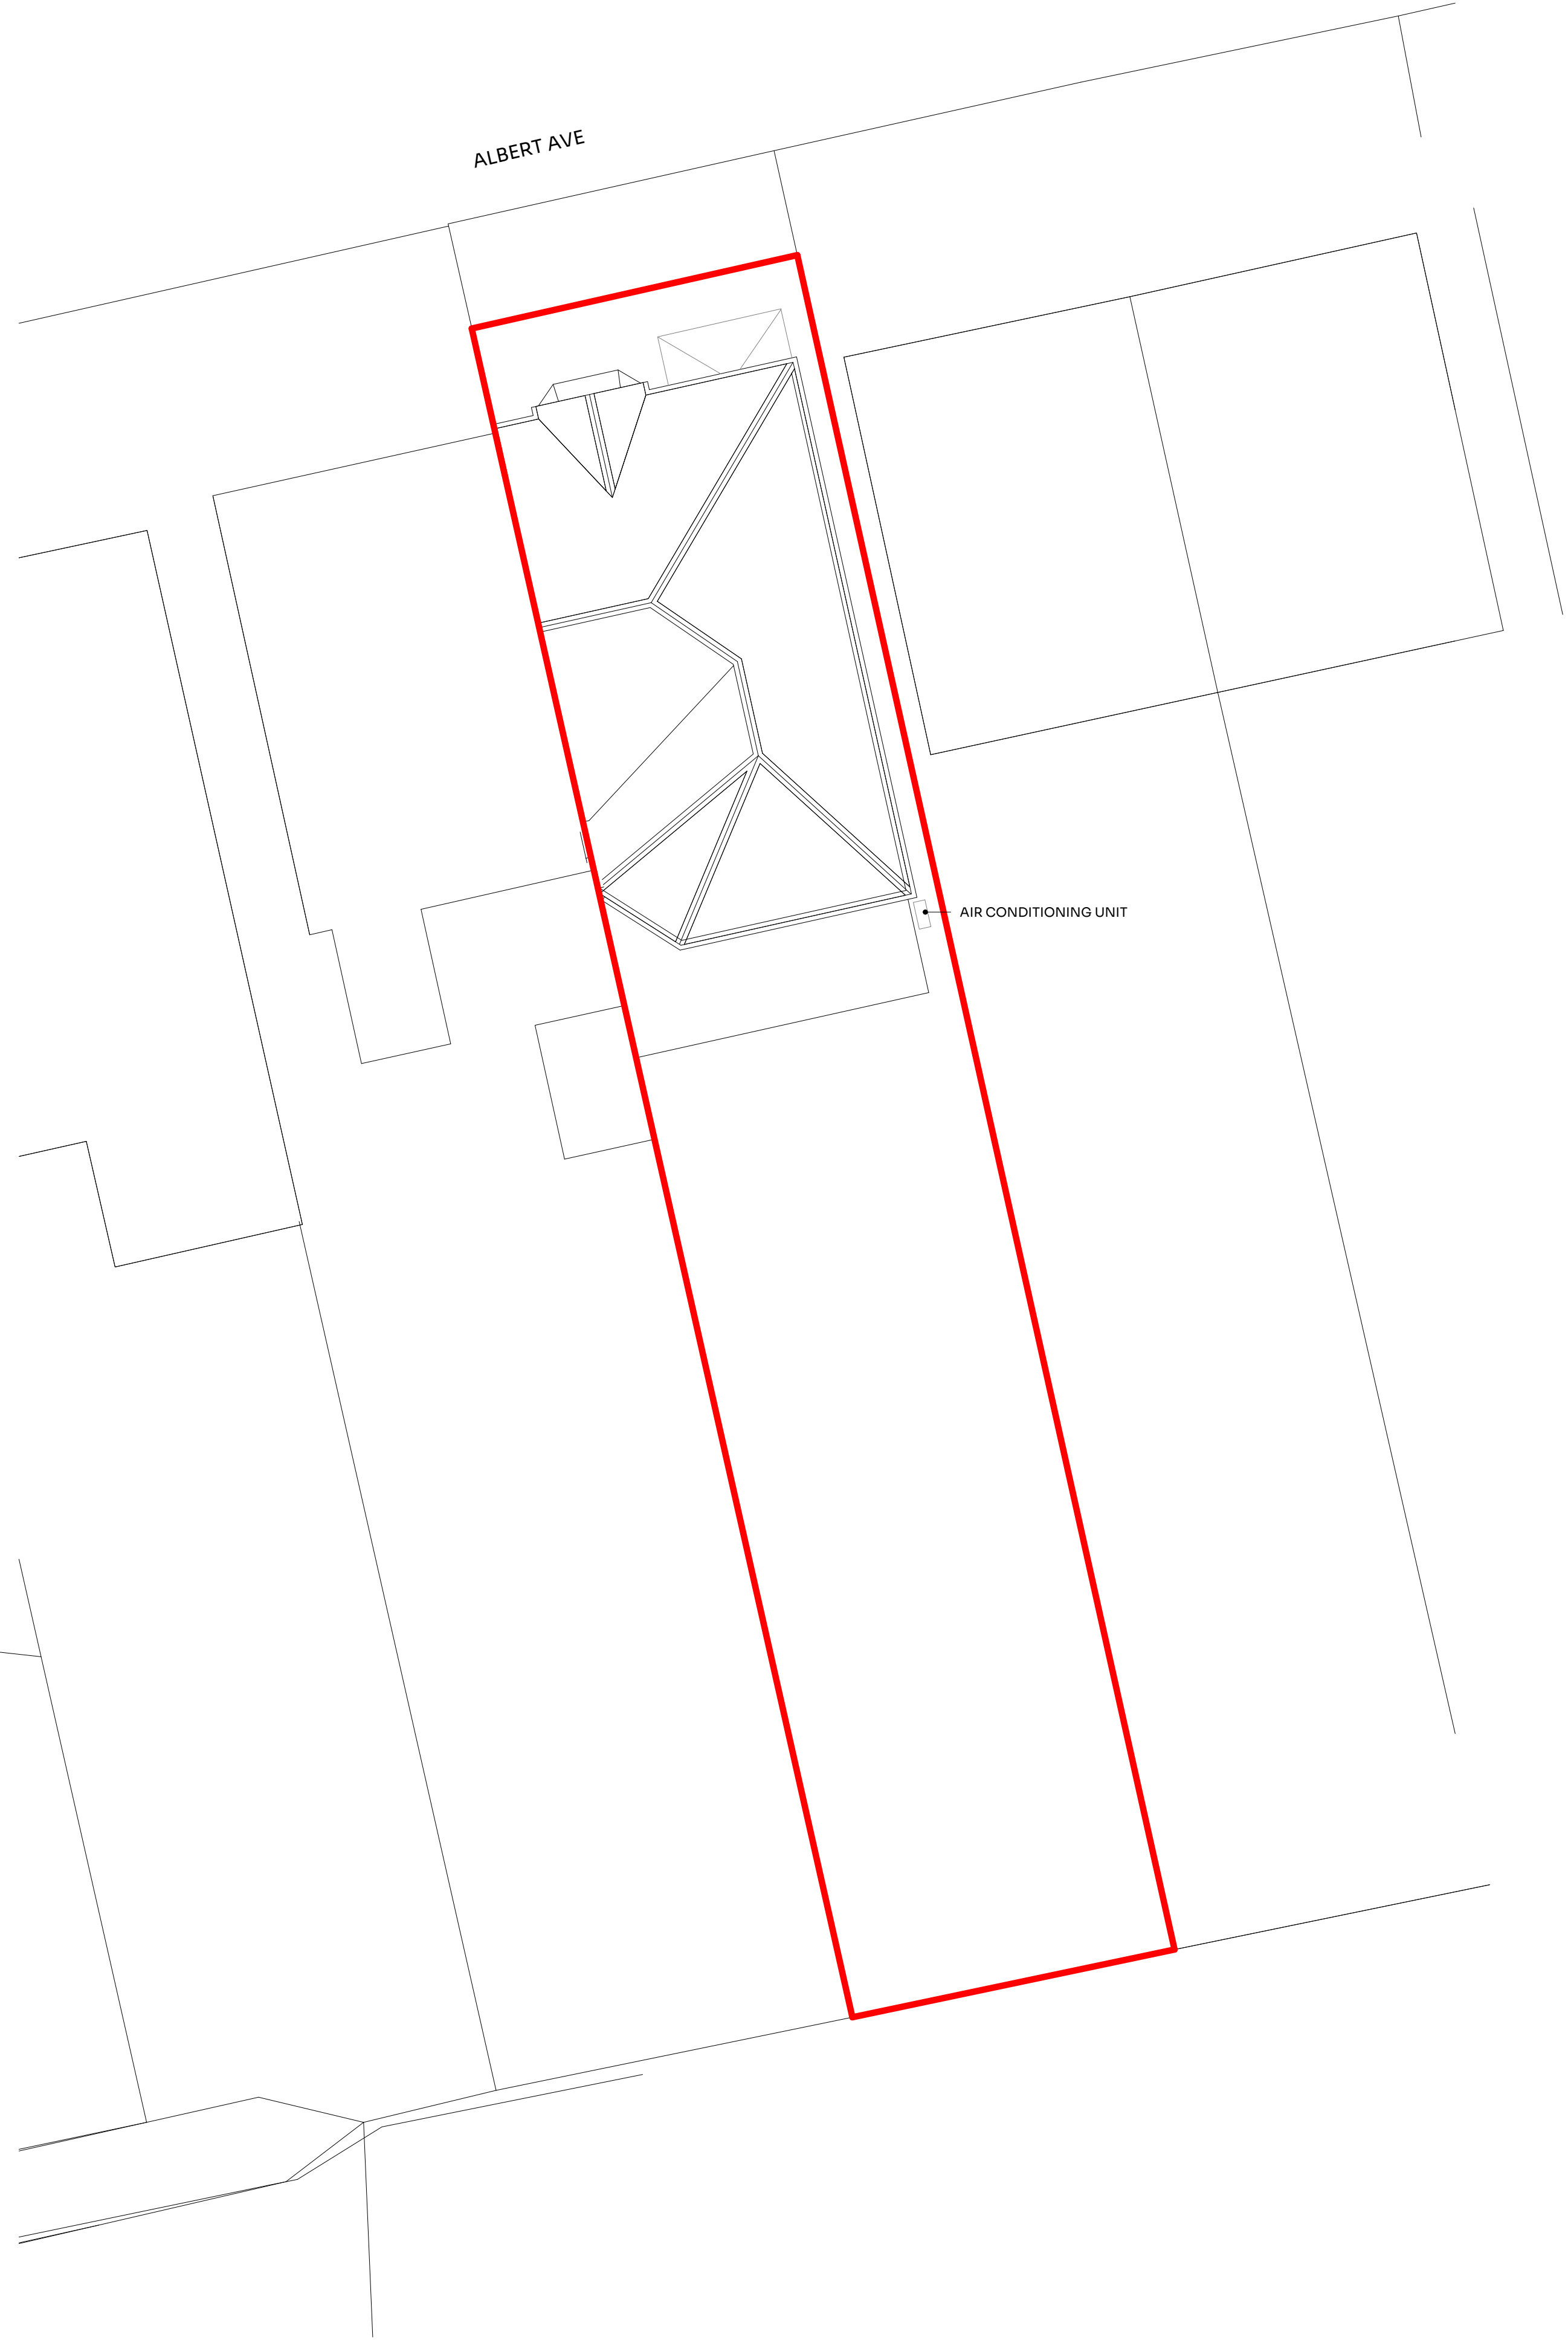

North

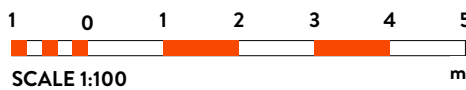

PL1 Issued for Planning AL 22 08 23
PL2 Issued for Planning AL 19 02 24

REV	Details	By	Date
-----	---------	----	------

Stamp:		AS BUILT	
--------	--	----------	--

JCD ARCHITECTURE + PLANNING 
studio@jcdesigngroup.co.uk 0161 698 2954

Project No:
JC82

Project:
No. 52 Albert Ave

Drawing No: A1.5	Revision: PL2
-----------------------------------	--------------------------------

Title:
AS BUILT SITE PLAN

Project Address:
52 Albert Ave Prestwich, Manchester M25
Q1X

Scale on A1: 1 : 100	Drawn by: AL	Checked by: JC
--------------------------------	------------------------	--------------------------

General Notes
This drawing must be read in conjunction with JCDs specification and all other relevant documentation and drawings

All dimensions are to be checked on site with any discrepancies reported to the designer prior to the work being carried out.

JCD accept no liability for any expense, loss or damage of whatsoever nature and however arising from any variation made to this drawing or in the execution of the work to which it relates which has not been referred to them and their approval obtained.

This drawing is copyright and is sent to you in confidence. It must not be copied, used or disclosed in whole or in part to third parties without our written permission. It remains the property of JCD and must be returned on request.

© JCD Design Group Ltd