




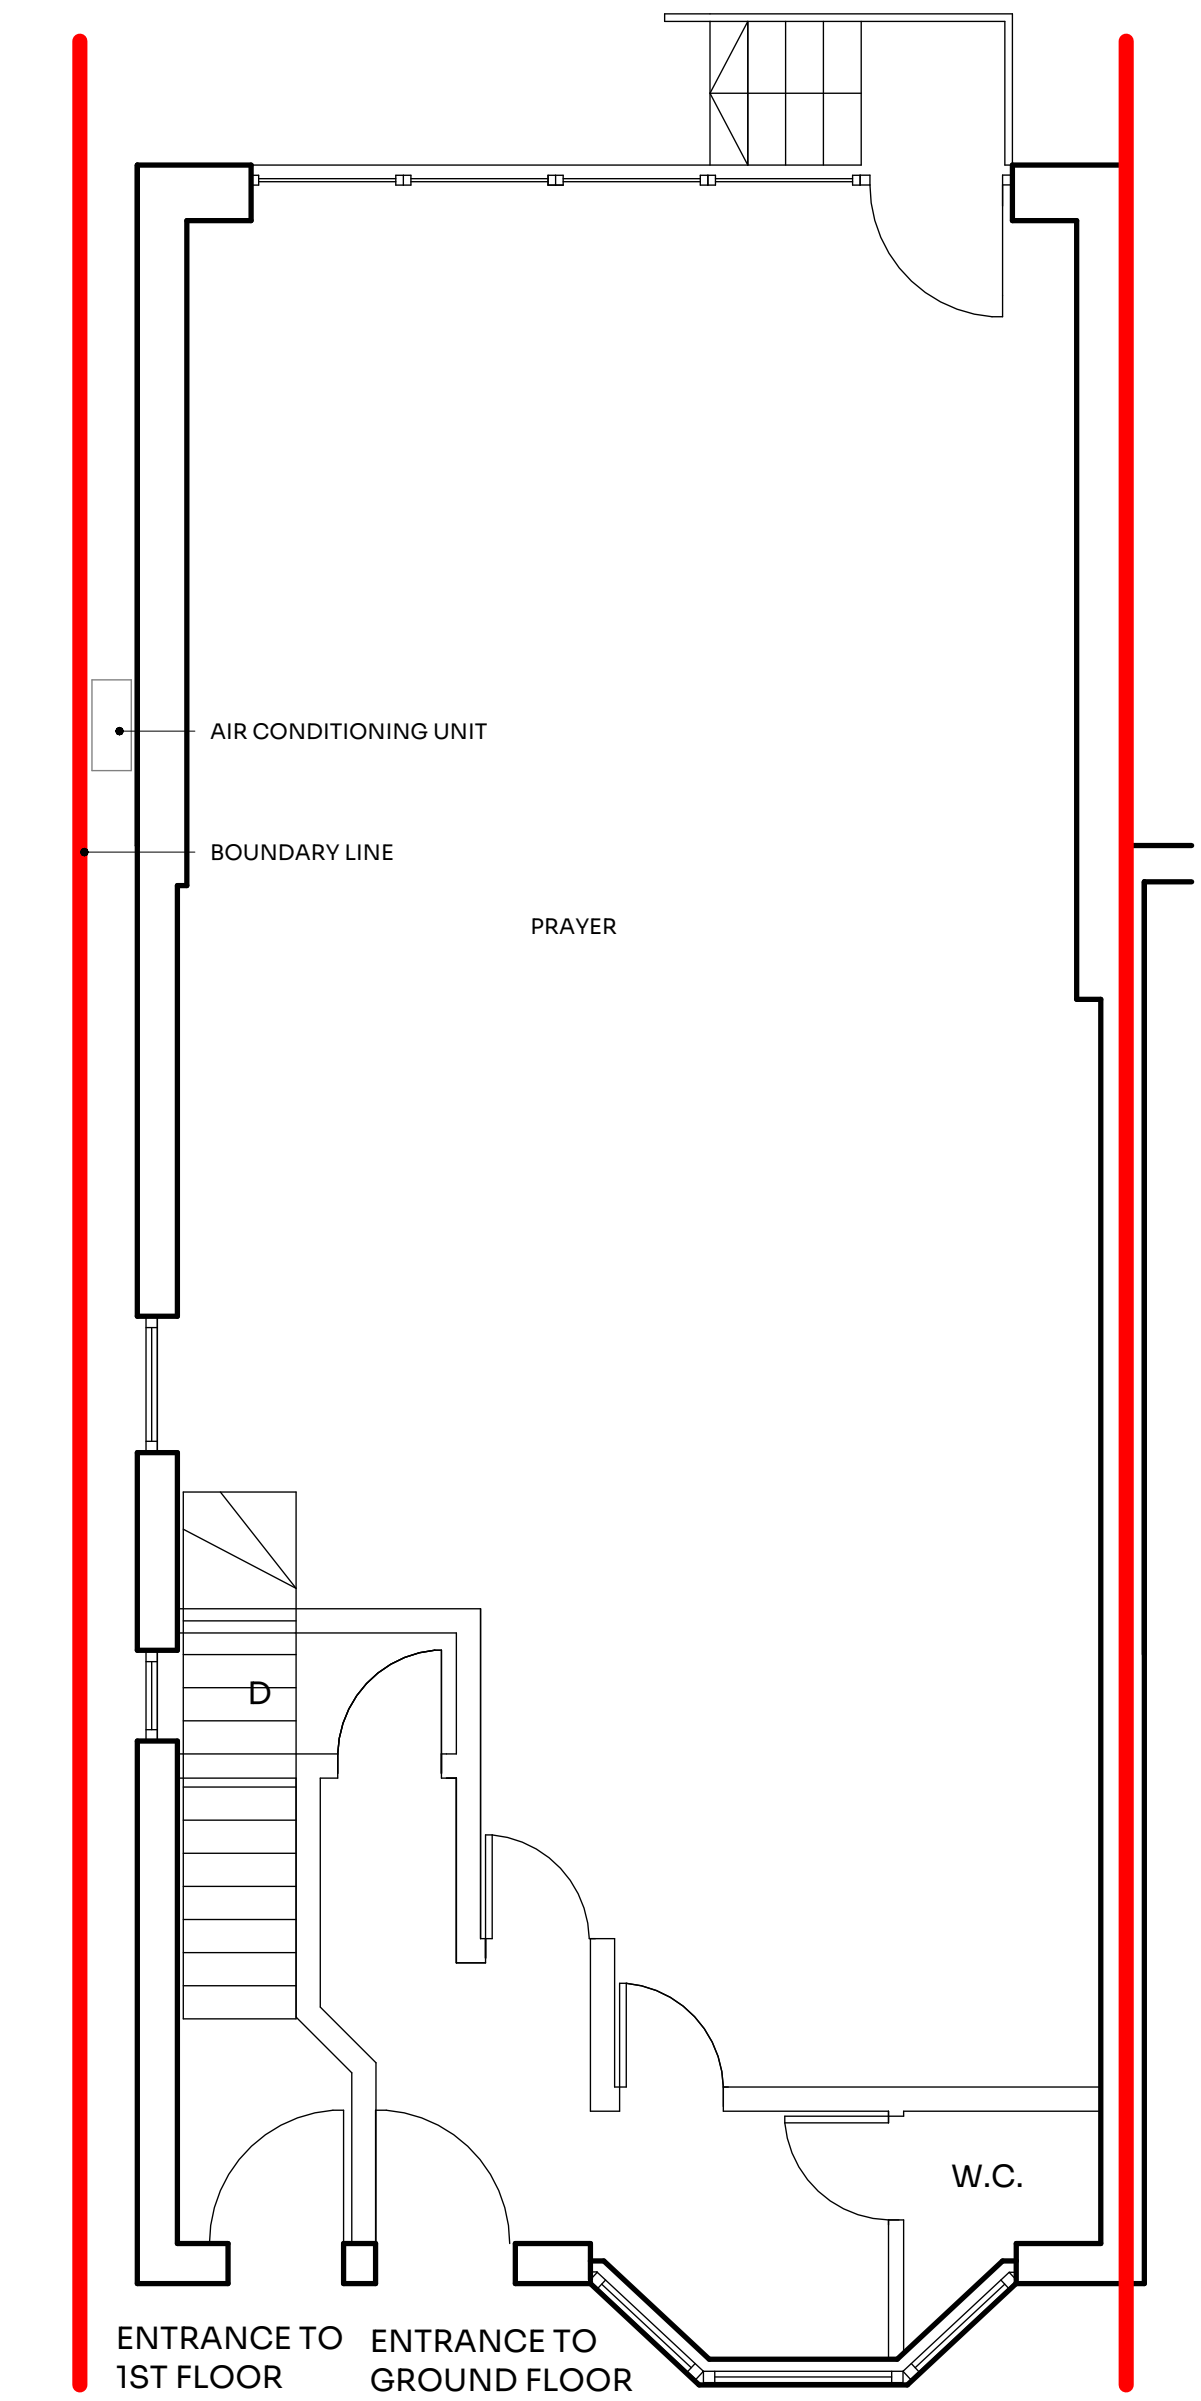

1 Ground Floor
1: 50

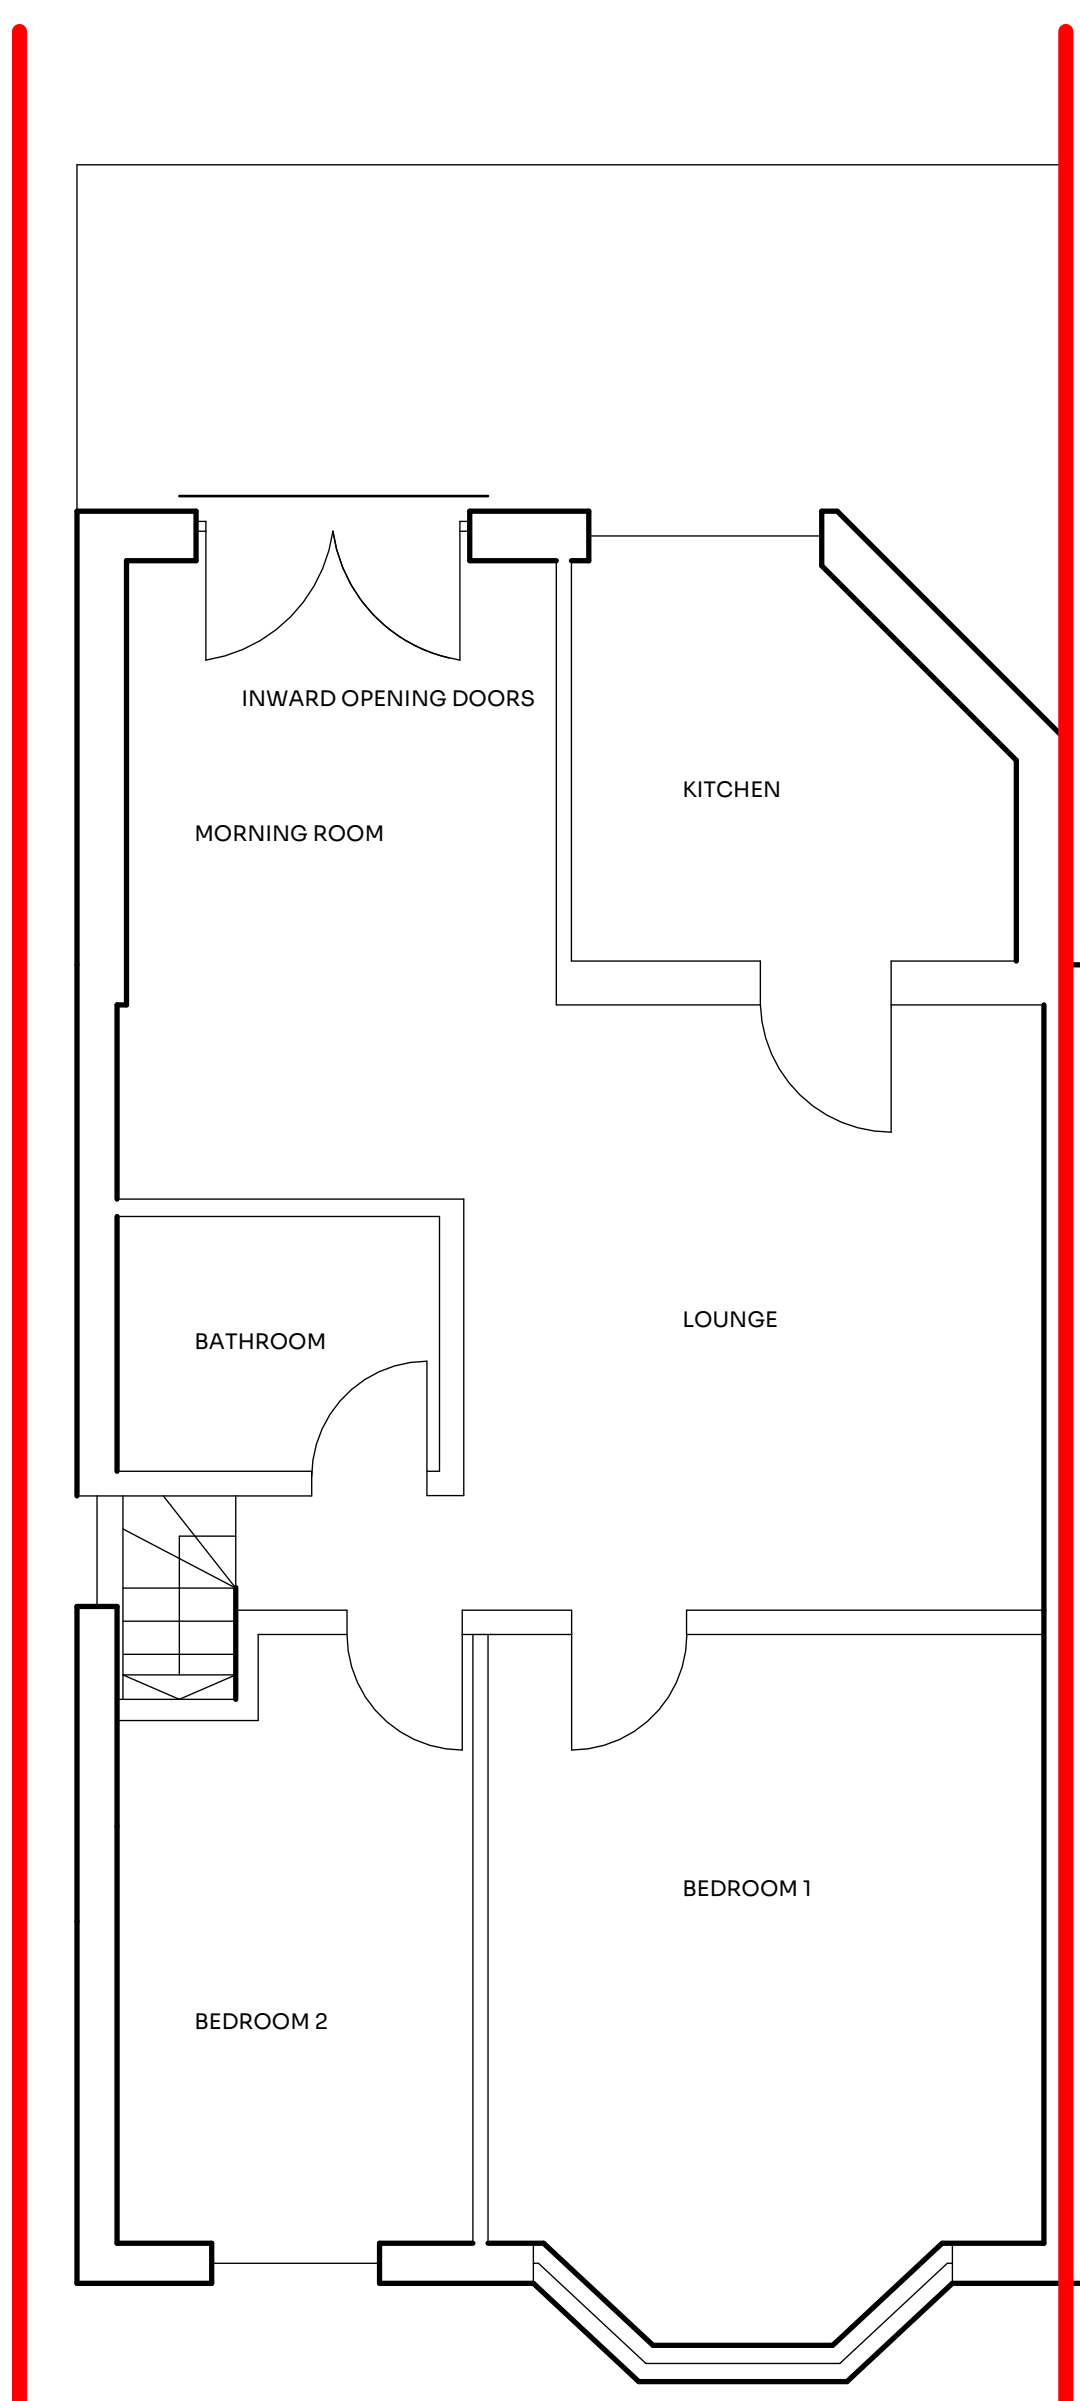


2 First Floor
1: 50

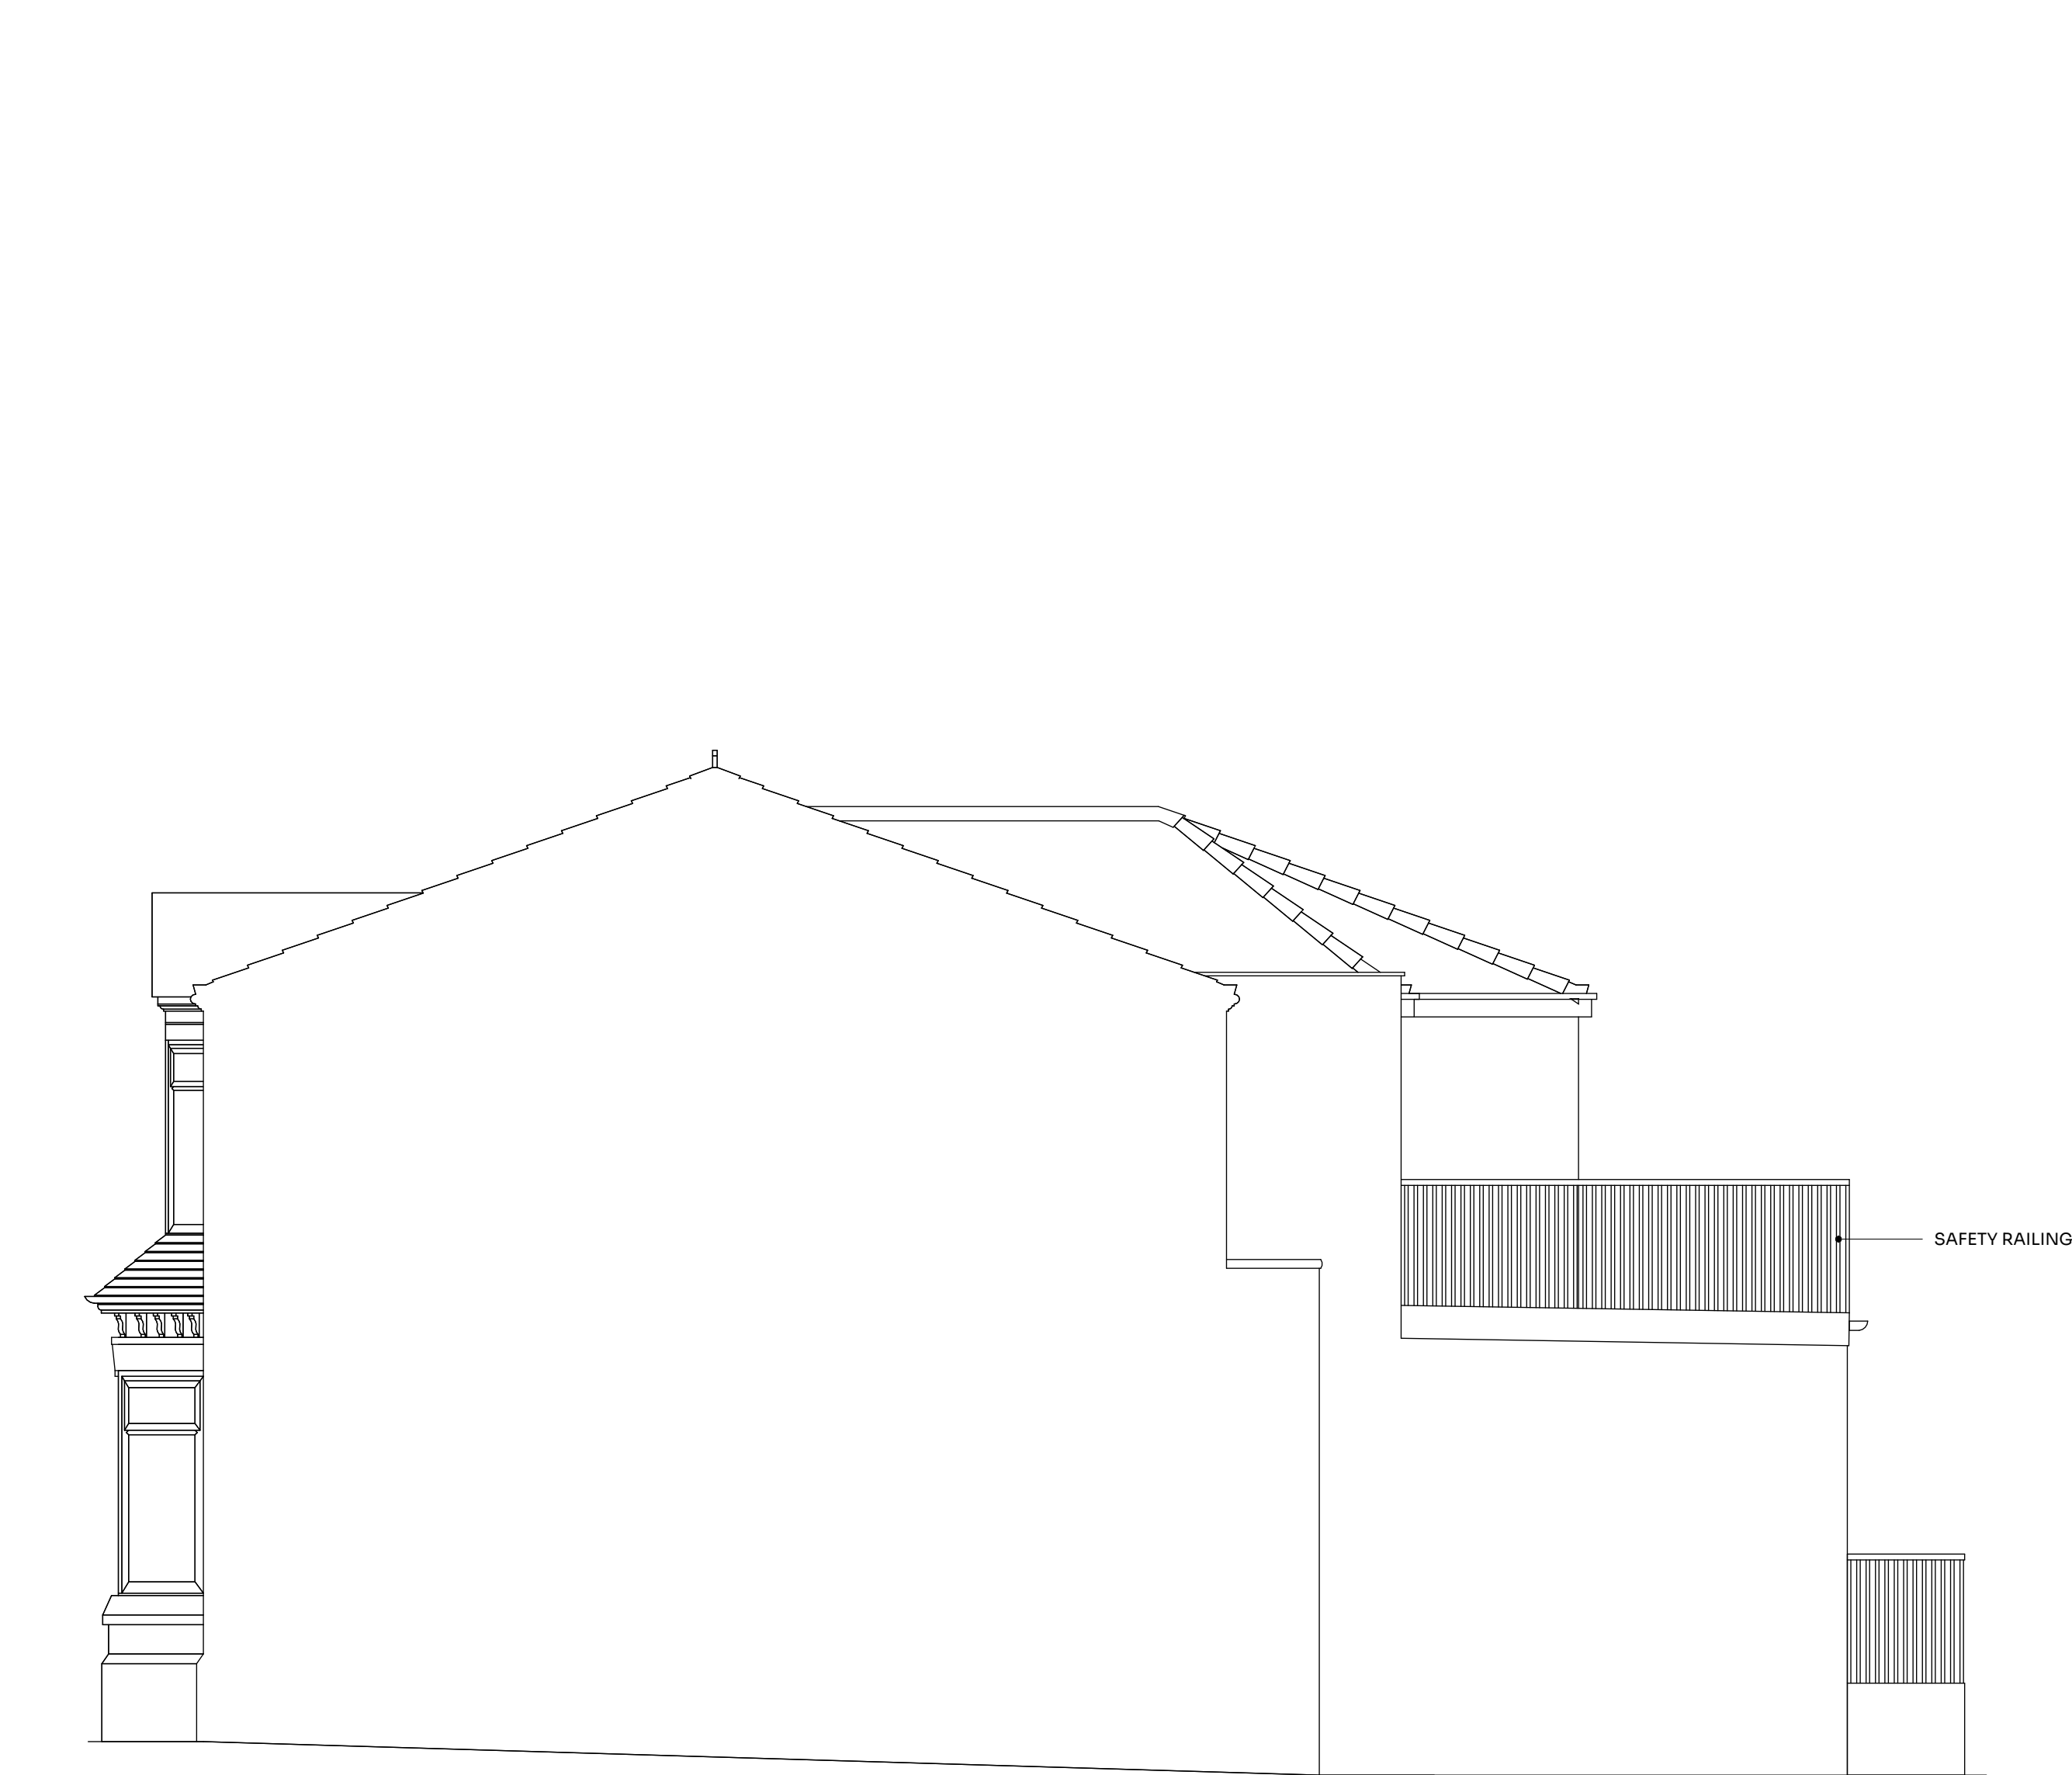


3 Right Elevation
1: 50




4 Front Elevation
1: 50

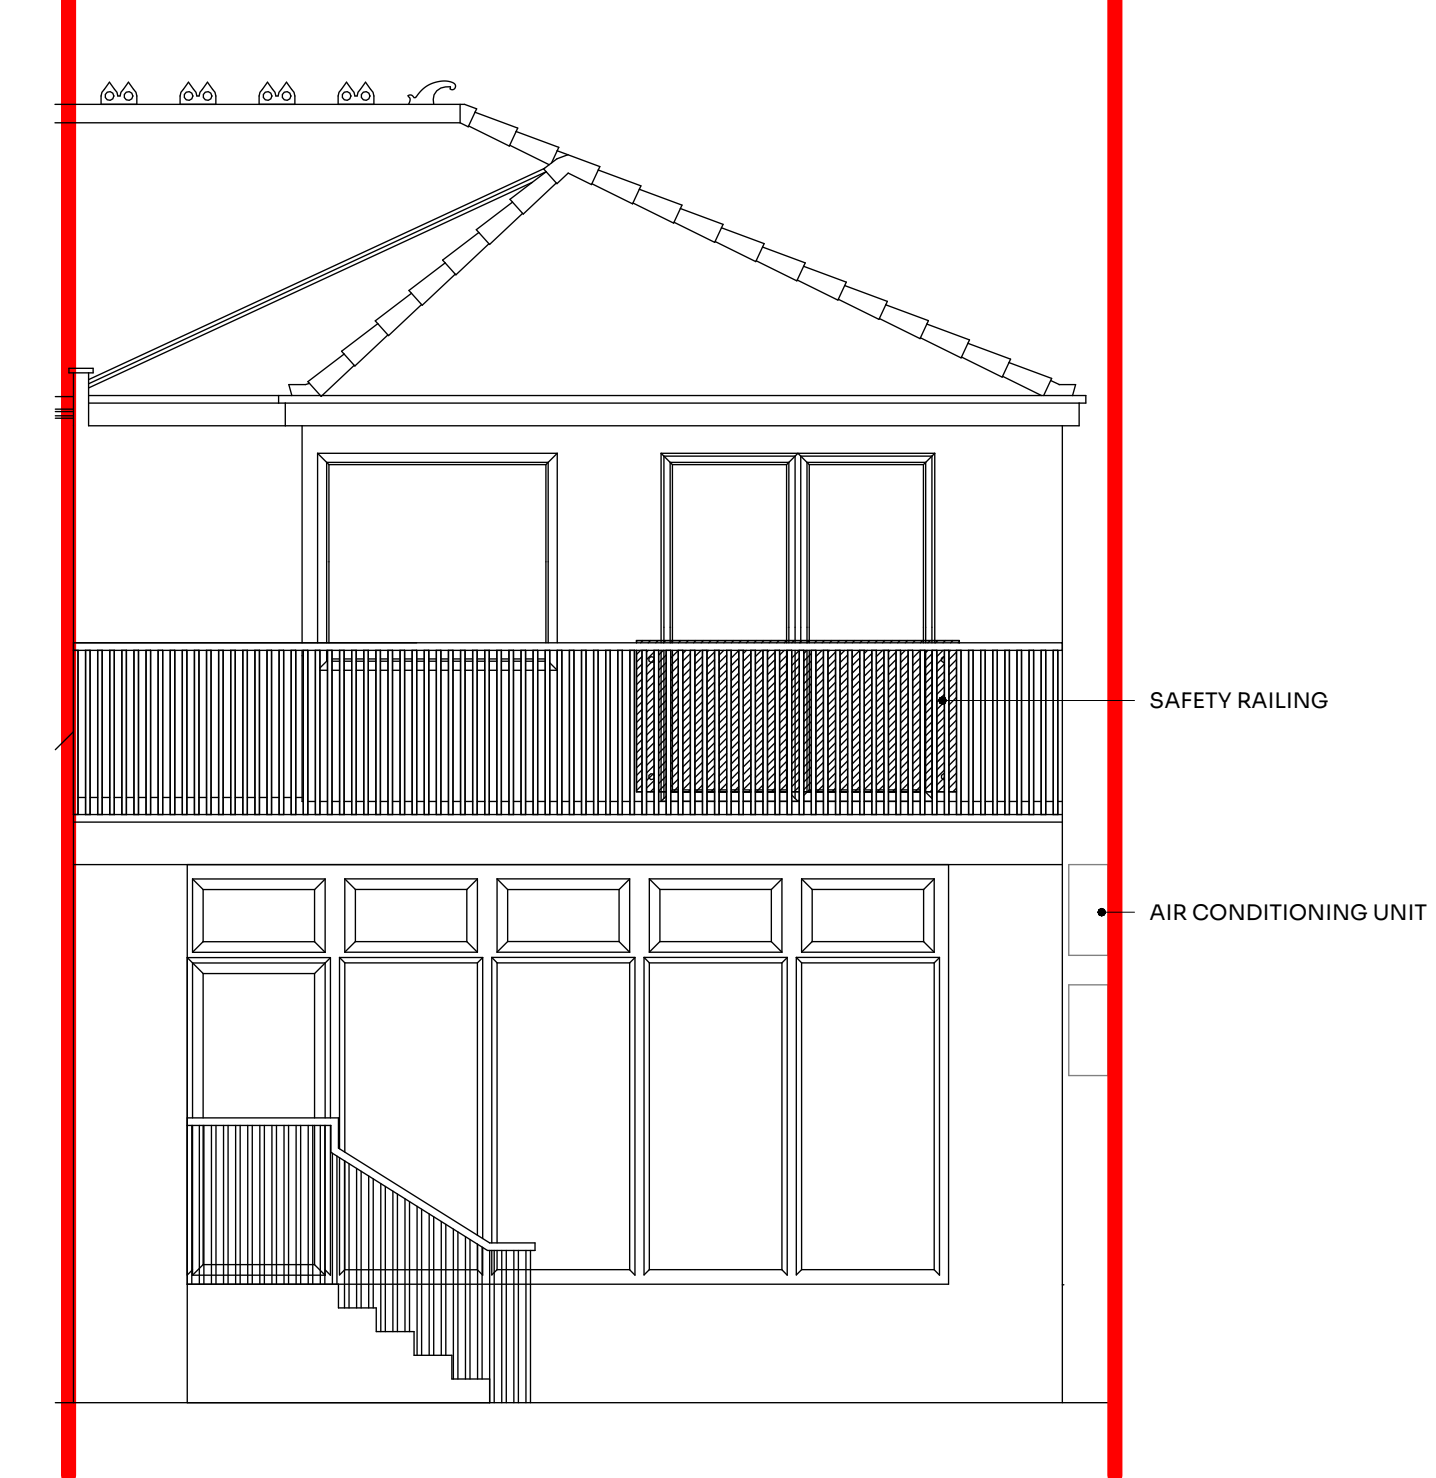

5 Rear Elevation
1: 50

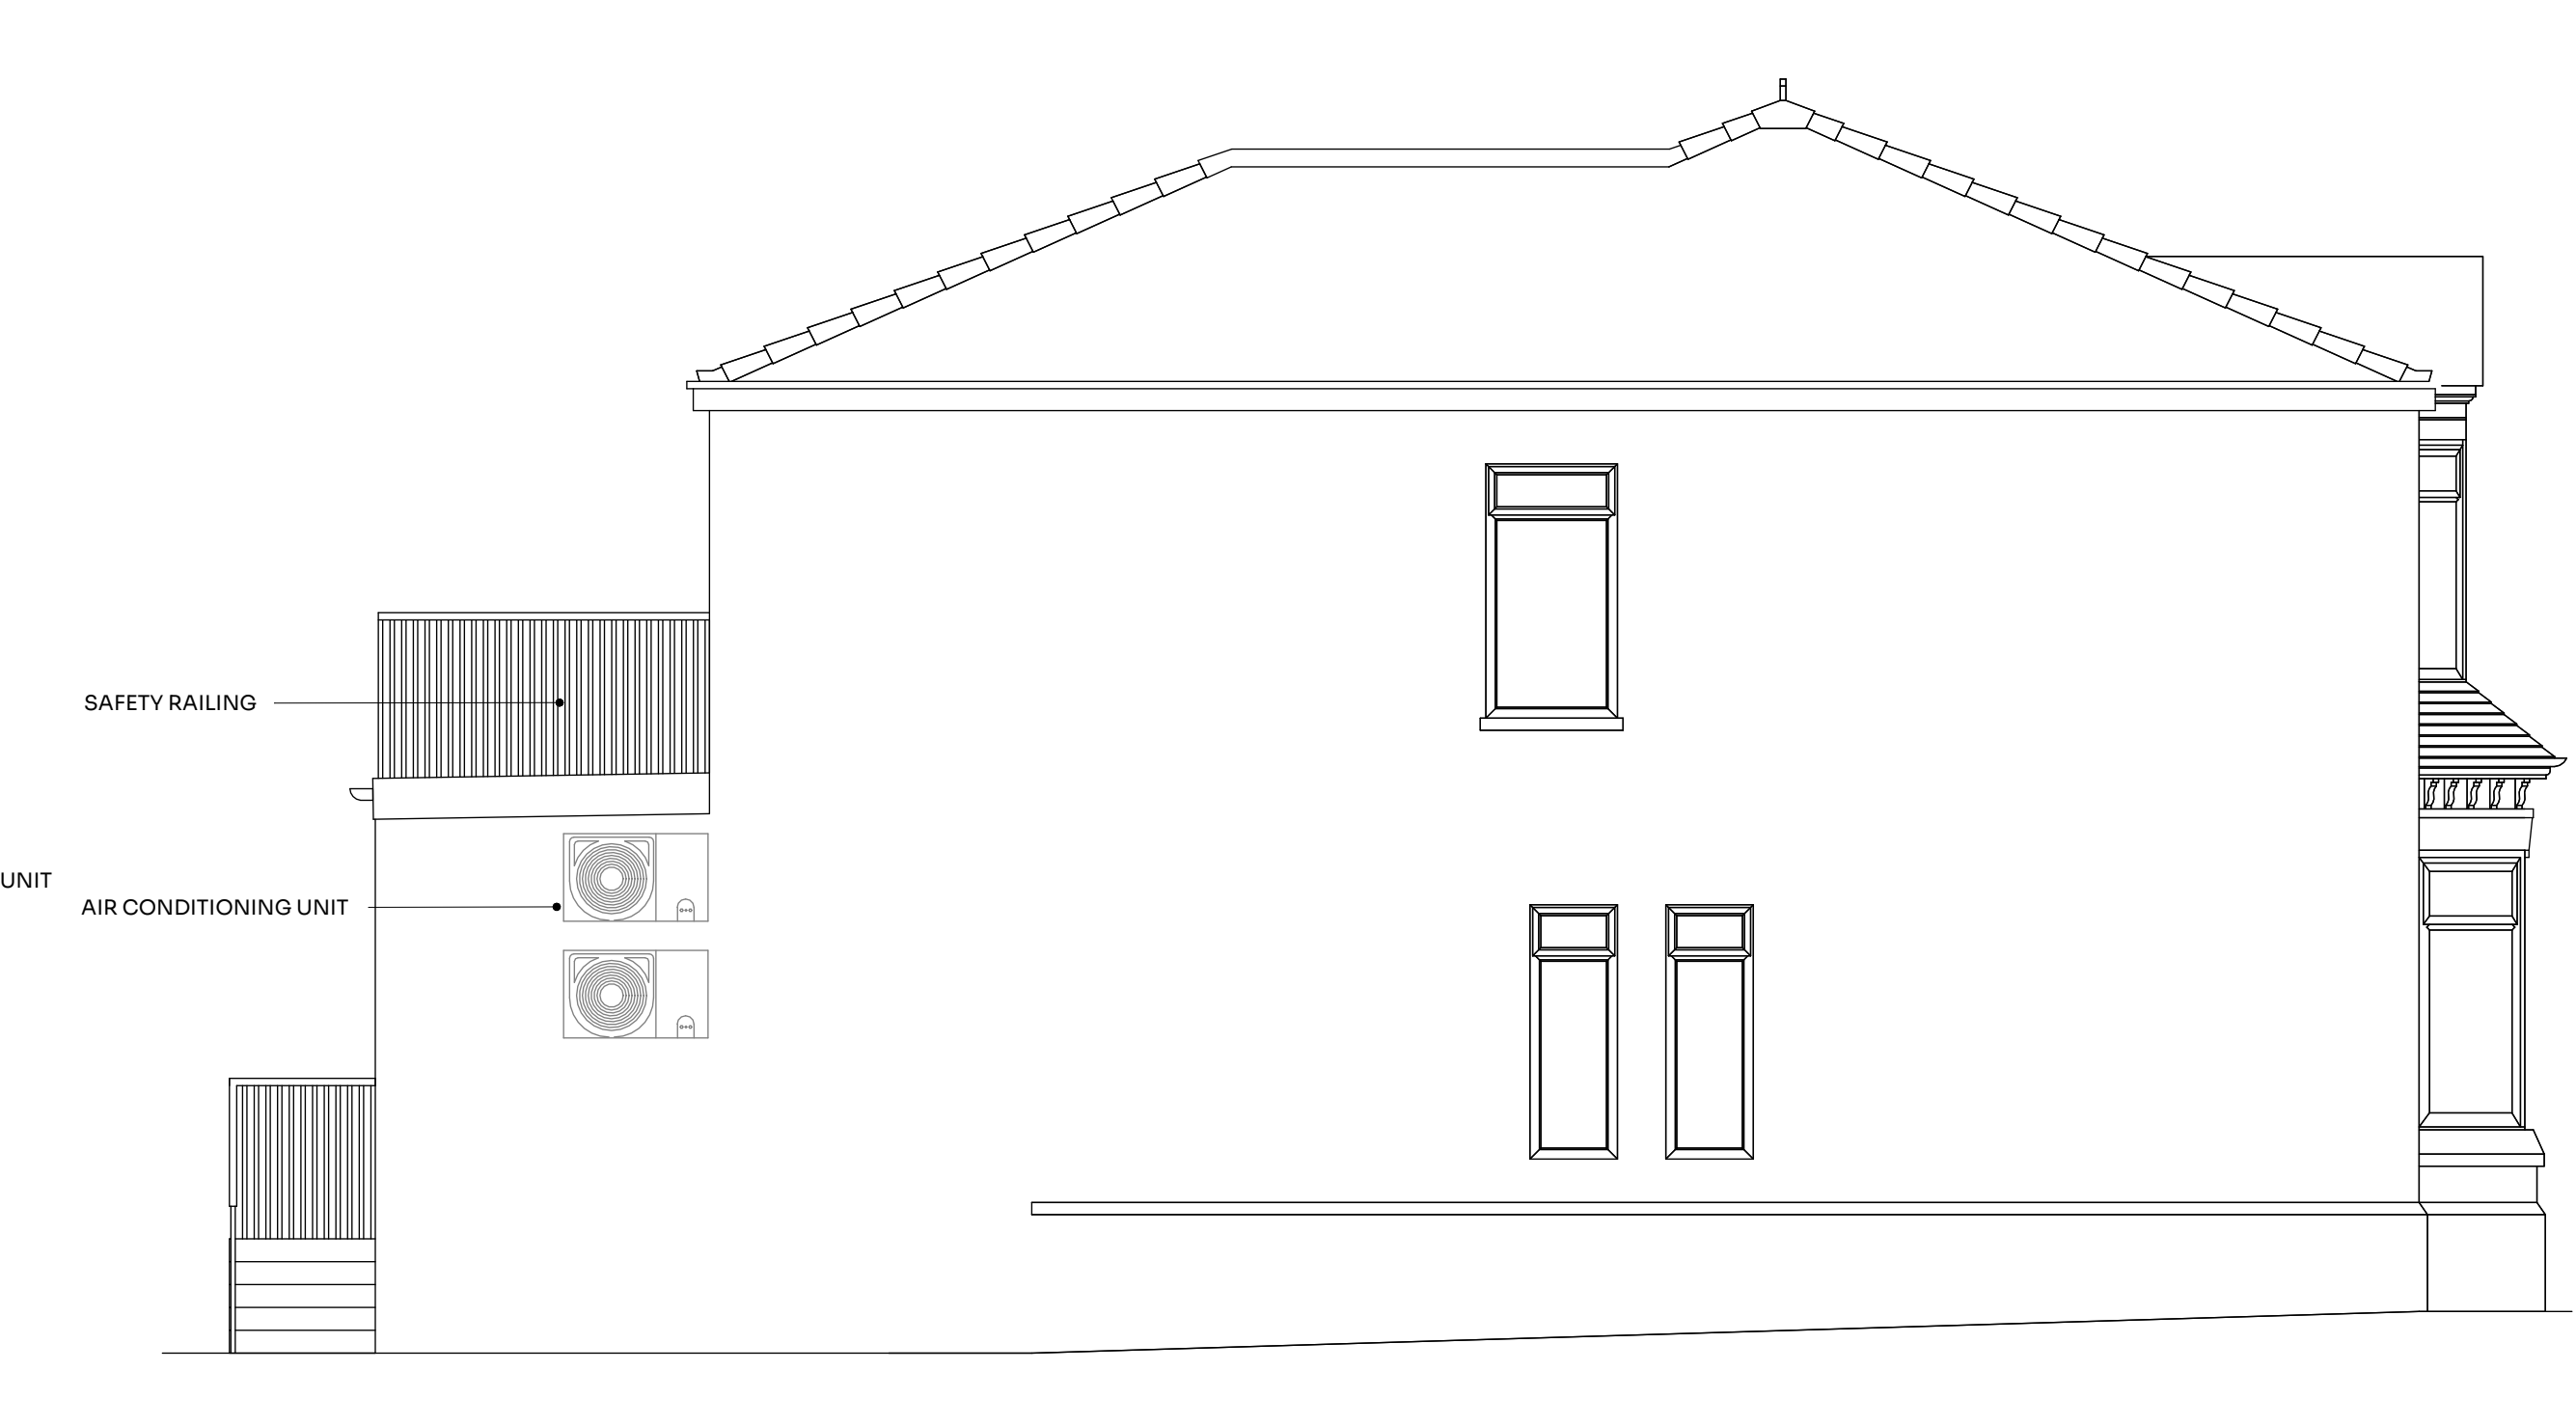

6 Left Elevation
1: 50

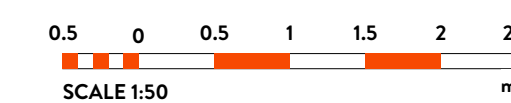

North

PL1	First Issue for Planning	JC	02 08 23
PL2	Issued for Planning	AL	22 08 23
PL3	Issued for Planning	AL	25 08 23
PL4	Issued for Planning	AL	31 01 24
PL5	Issued for Planning	AL	19 02 24

REV	Details	By	Date
-----	---------	----	------

Stamp: **AS BUILT**

JCD ARCHITECTURE + PLANNING CIAT CERTIFIED
studio@jcdesigngroup.co.uk 0161 698 2954

Project No: **JC82**

Project: **No. 52 Albert Ave**

Drawing No: **A1.3** Revision: **PL5**

Title: **AS BUILT PLANS AND ELEVATIONS**

Project Address: **52 Albert Ave Prestwich, Manchester M25 0LX**

Scale on A1: 1: 50 Drawn by: AL Checked by: JC

General Notes
This drawing must be read in conjunction with JCD's specification and all other relevant documentation and drawings.

All dimensions are to be checked on site with any discrepancies reported to the designer prior to the work being carried out.

JCD accept no liability for any expense, loss or damage of whatsoever nature and however arising from any variation made to this drawing or in the execution of the work to which it relates which has not been referred to them and their approval obtained.

This drawing is copyright and is sent to you in confidence. It must not be copied, used or disclosed in whole or in part to third parties without our written permission. It remains the property of JCD and must be returned on request.

© JCD Design Group Ltd