

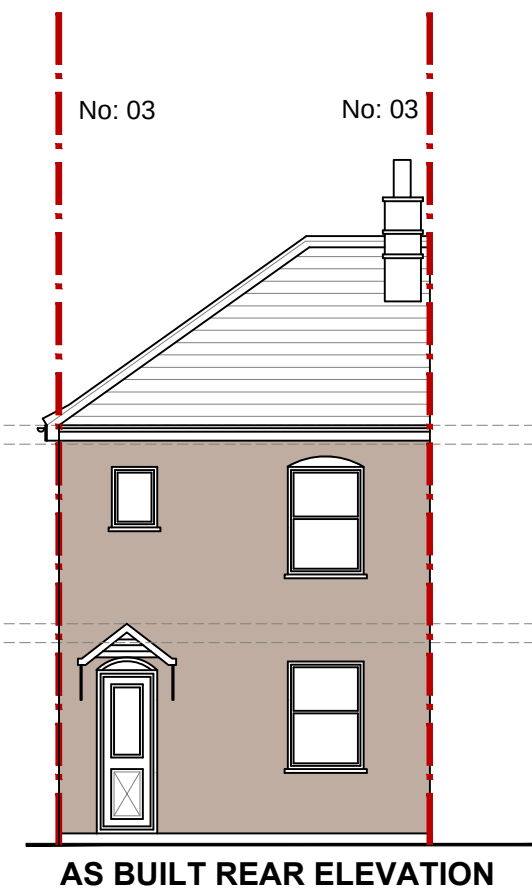
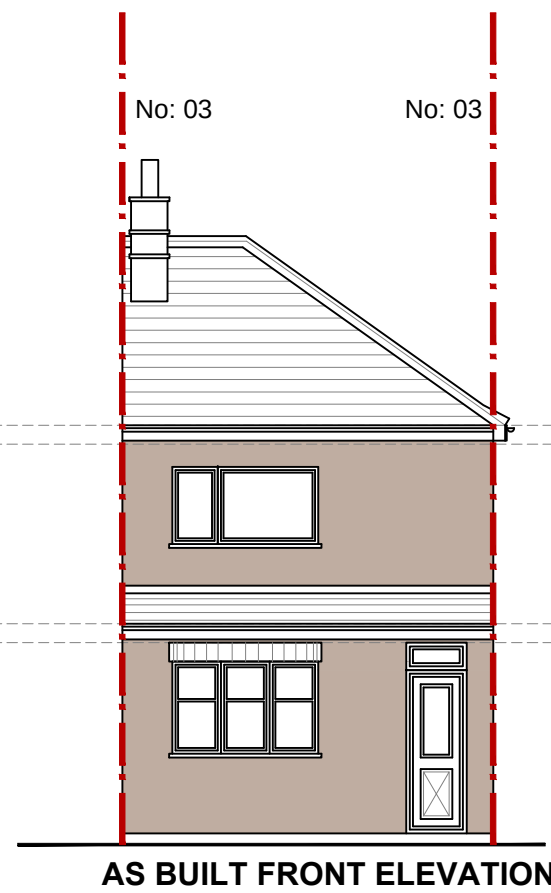


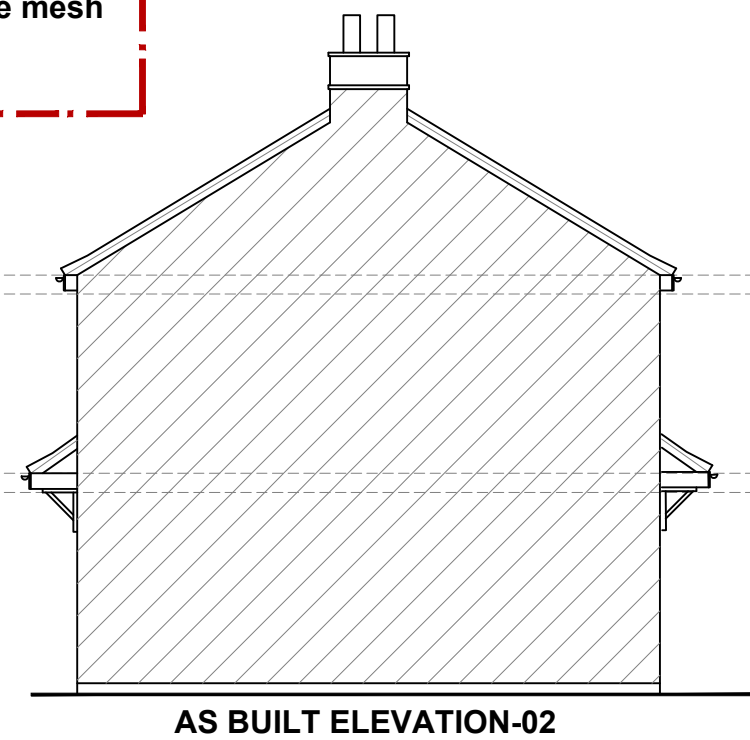

- Existing prepared substrate
- Adhesive insulation panel 90 MM
- Reinforced coat with glassfibre mesh
- Silicone Finish Render
- Paint Coat

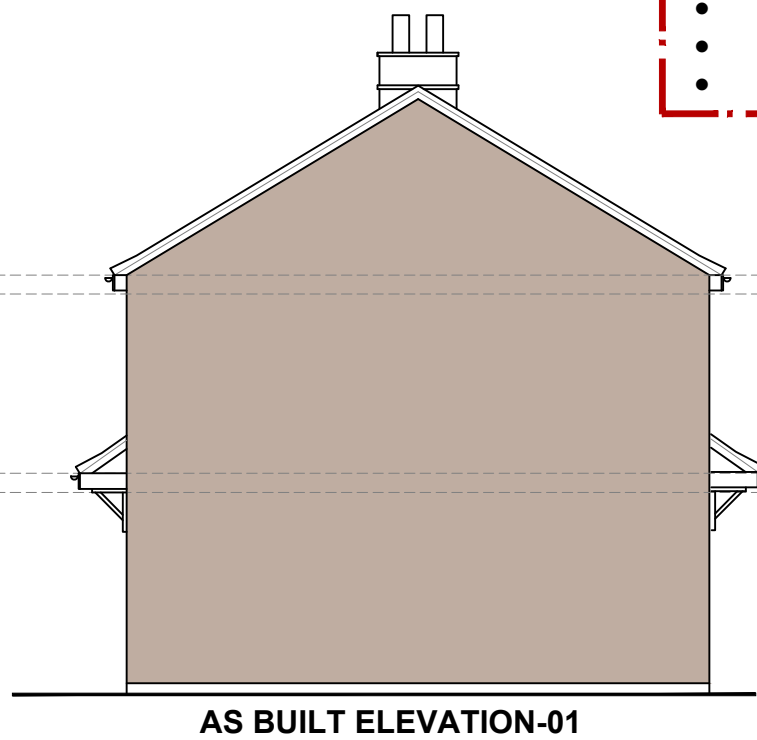

			CLIENT IZ ENERGY	PROJECT 03 STATTER STREET BURY BL9 8AZ	SCALE 1:100@A3	DRAWING NO.	REV.	AARKZ Design Associates		
					DATE JUN 22	DRAWN WN	04			
					DRAWING TITLE AS BUILT ELEVATIONS				0 1 2 3 4 5 Meters @ 1:100 @ A3	
REV	DATE	NOTES							186 FOREST ROAD, LOUGHTON, IG10 1EG TEL: 0750 645 9645 Email: Info@Aarkzdesign.co.uk WWW.AARKZDESIGN.CO.UK	