

- LEVEL ROOF
4970
- LEVEL 1
2590
- LEVEL 0
0



3 Front - Existing
1 : 100



4 Left Side - Existing
1 : 100




5 Rear - Existing
1 : 100




6 Right Side - Existing
1 : 100

Flat A
1 Bedroom/ 2 Persons
52.5m²


Flat B
1 Bedroom/ 1 Person
47.2m²

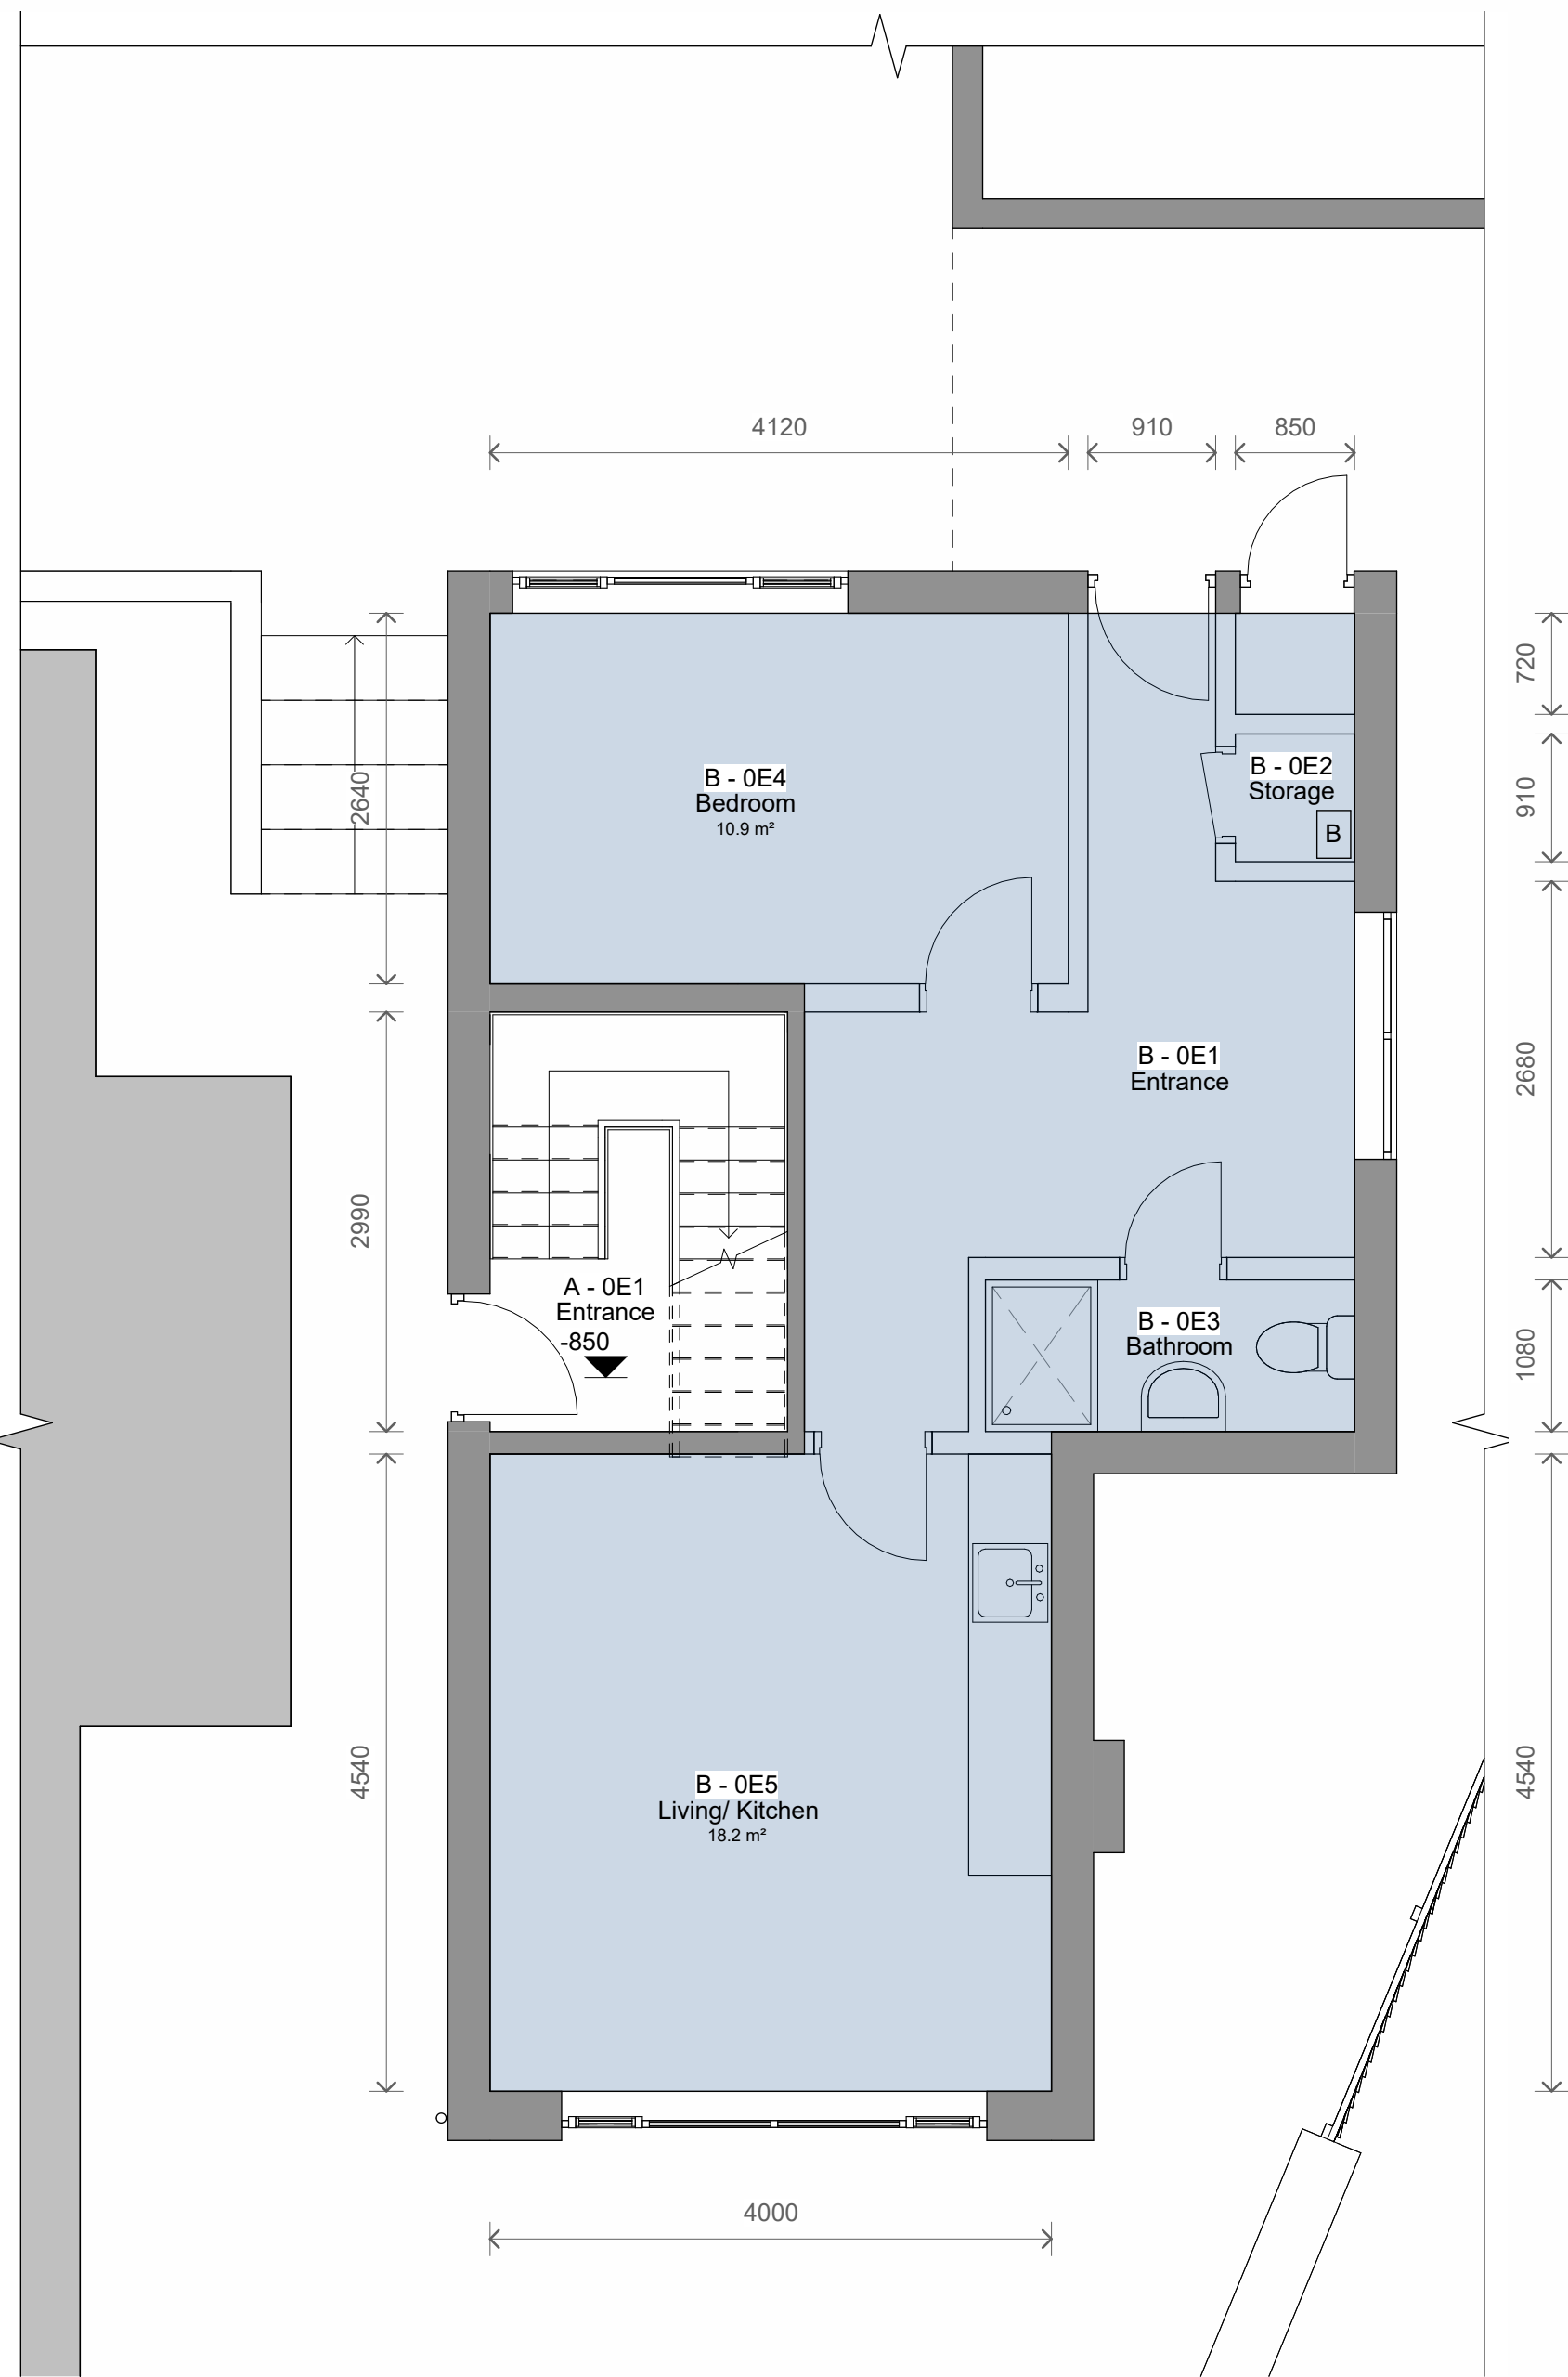

1 Level 0 - As Built
1 : 50

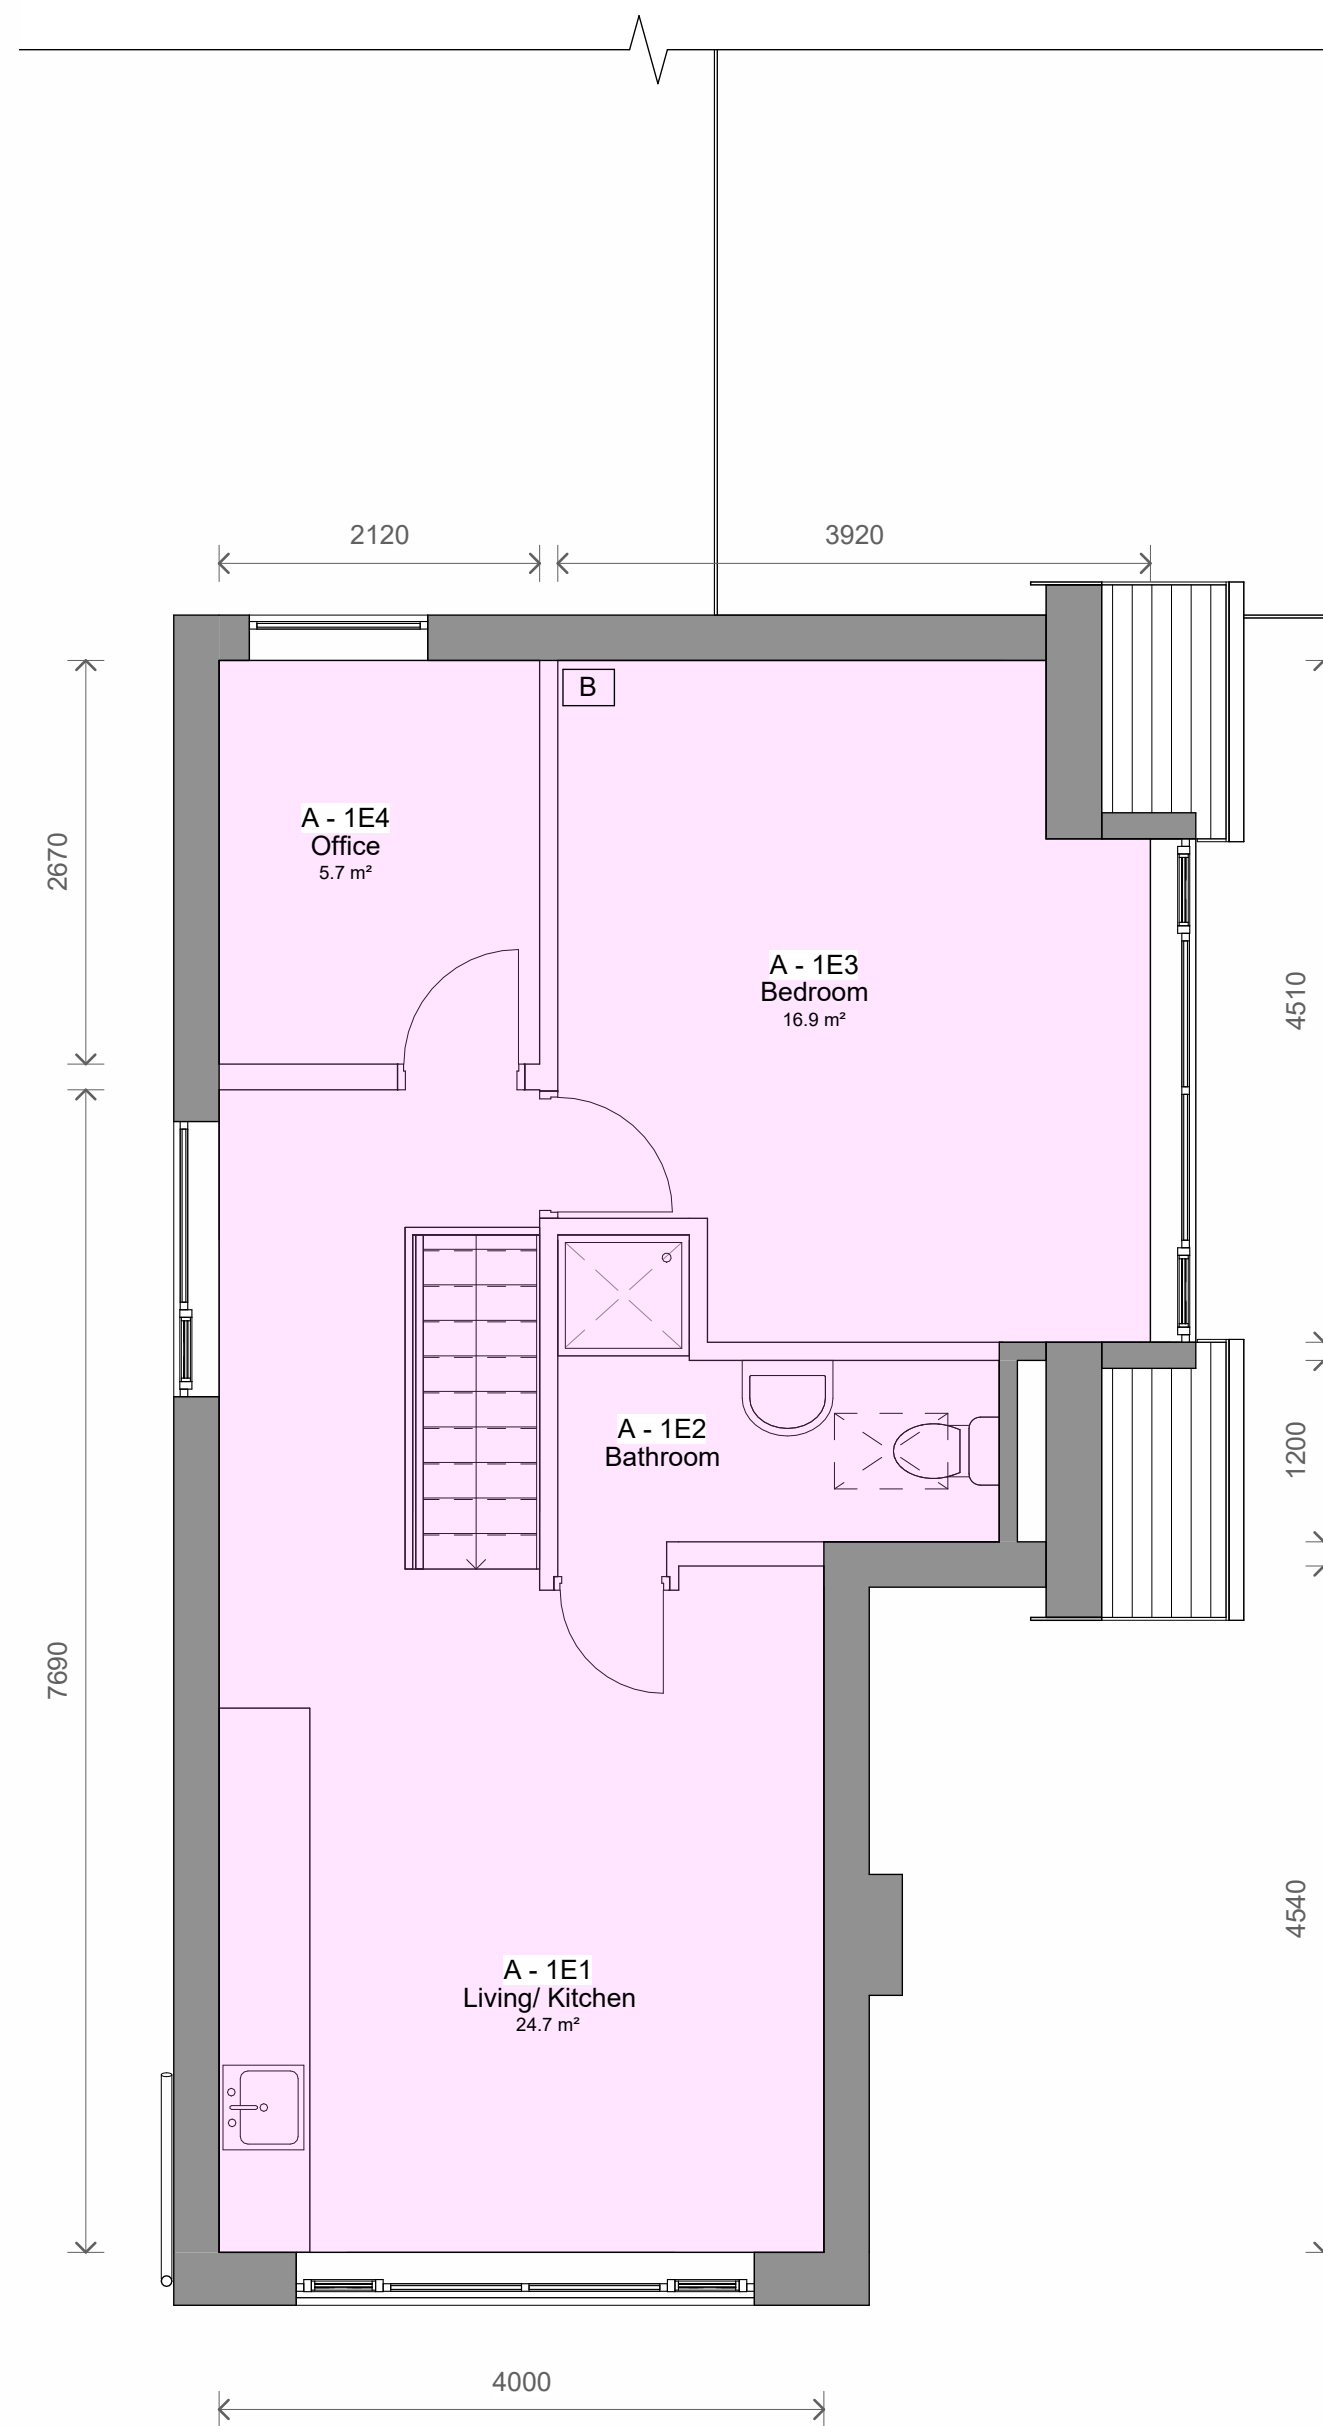


2 Level 1 - As Built
1 : 50

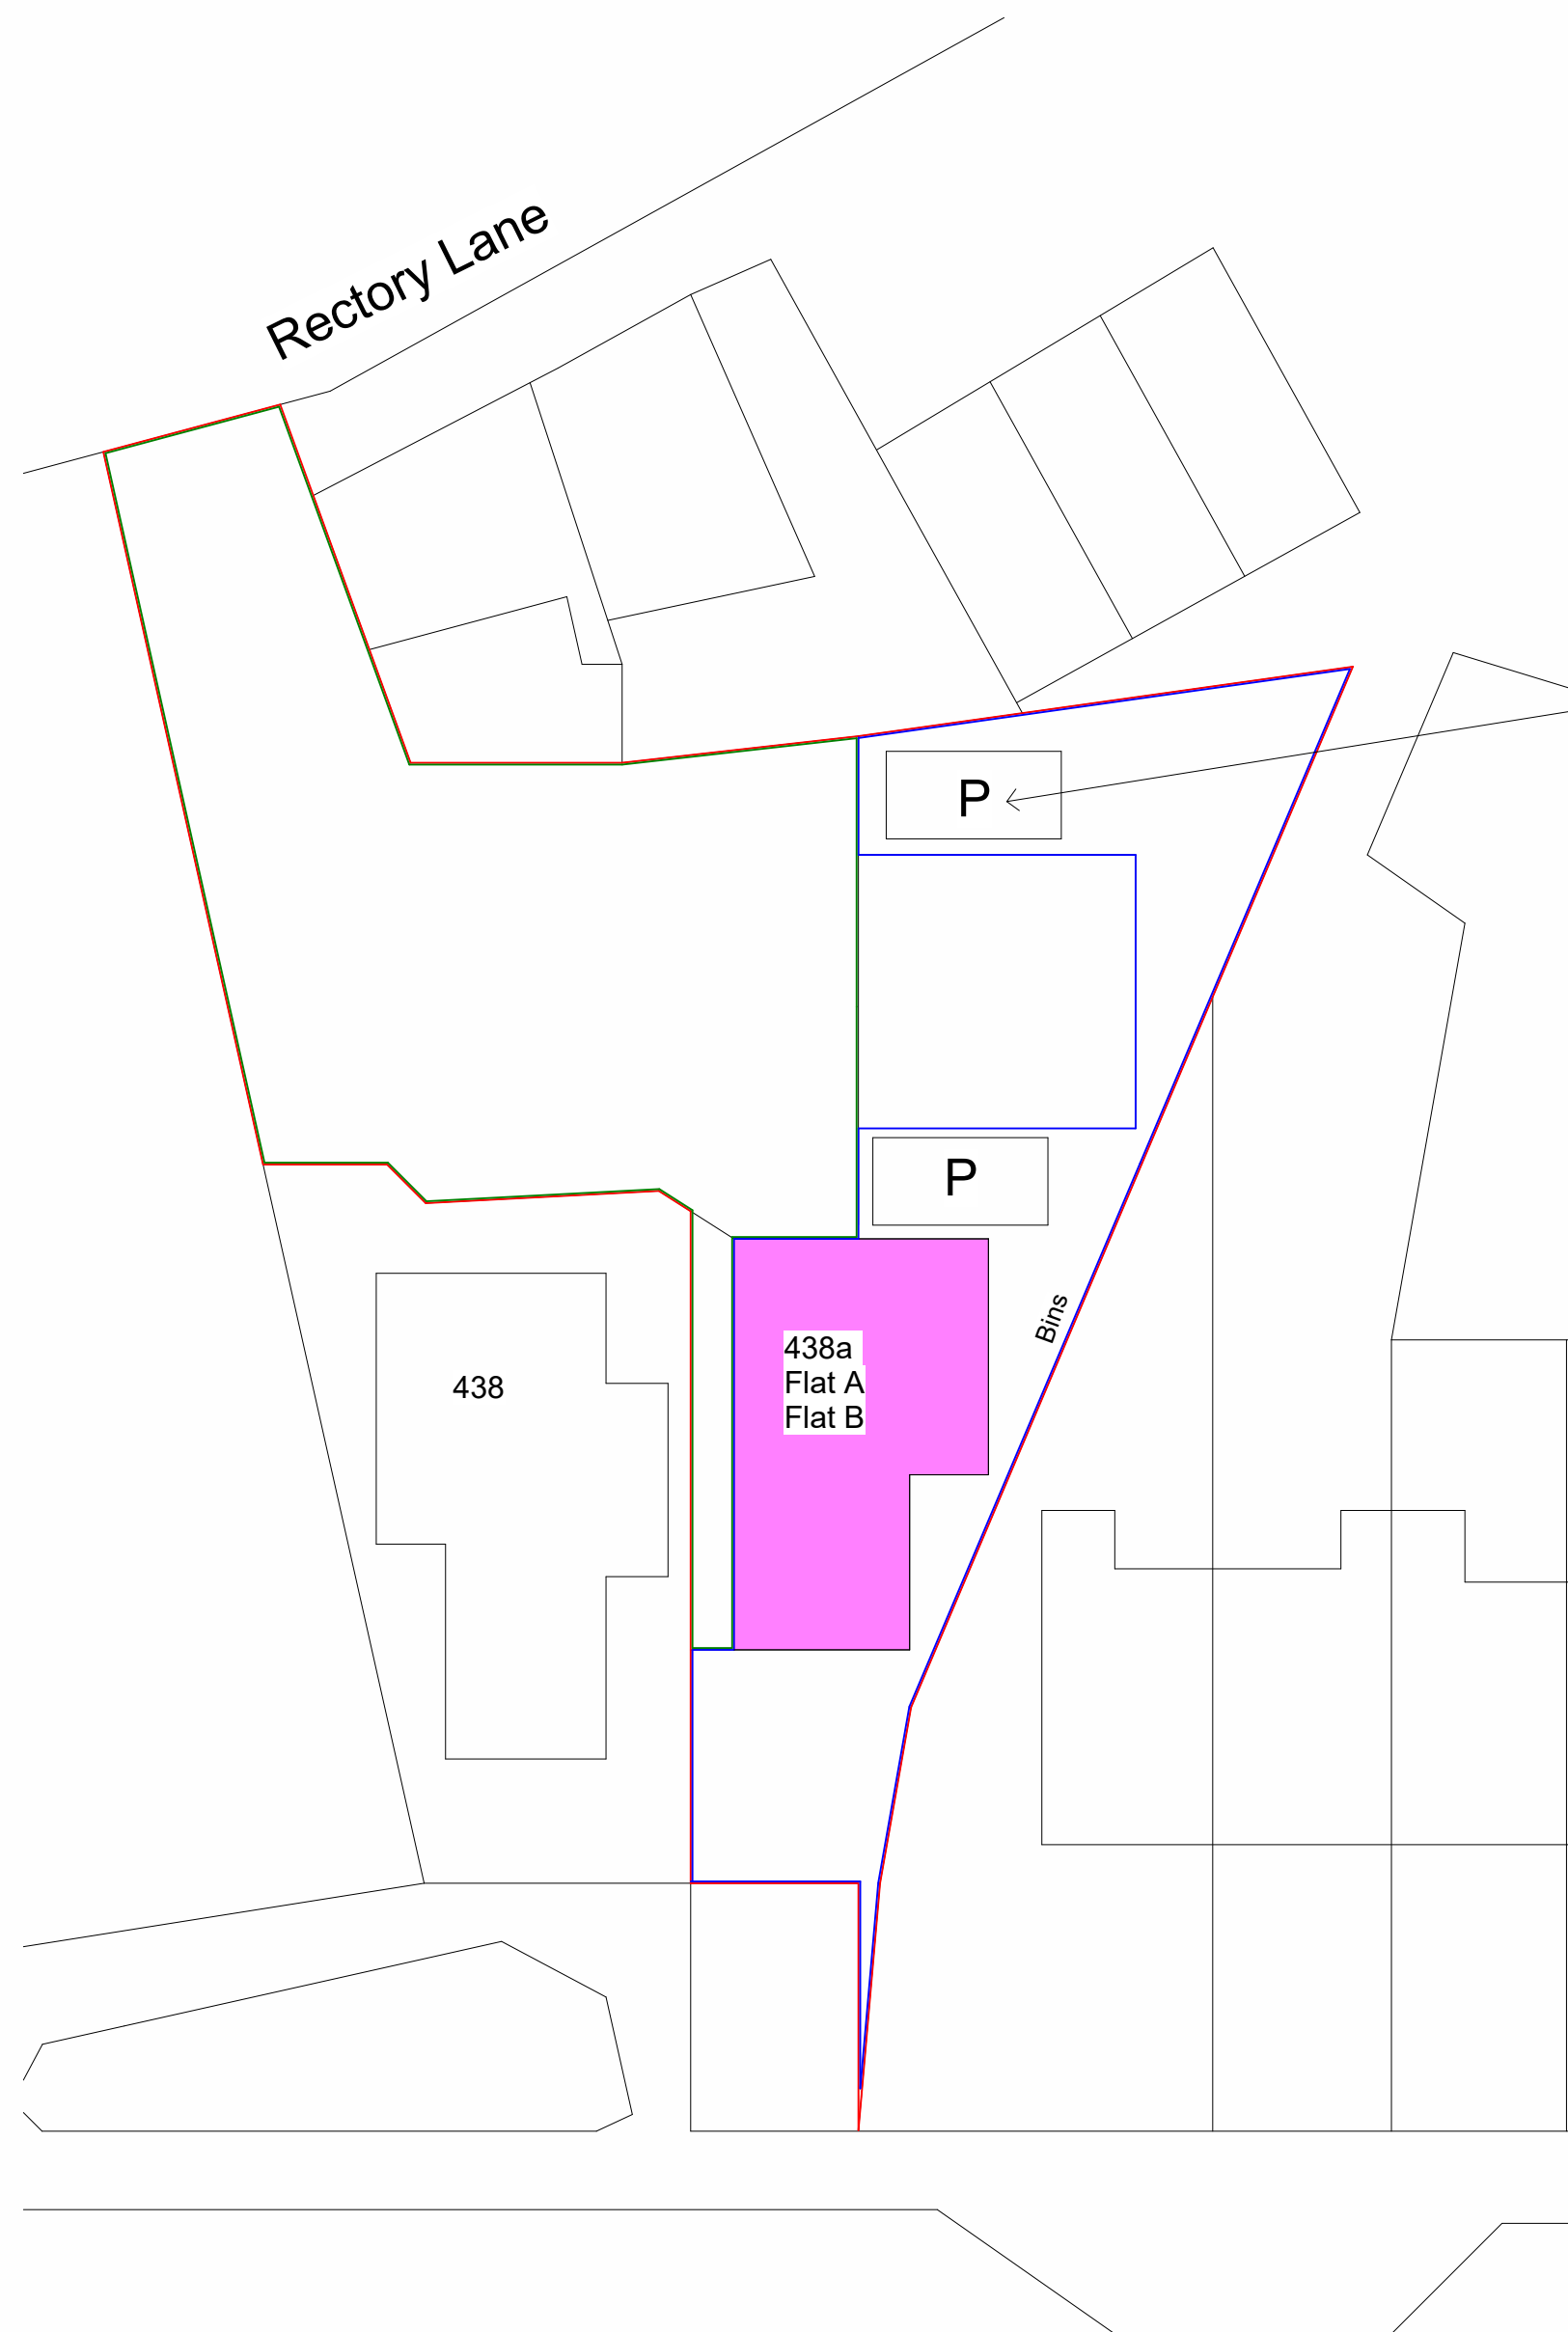

Proposed parking spot

Site Ownership
Right of Way Access

Bury New Road

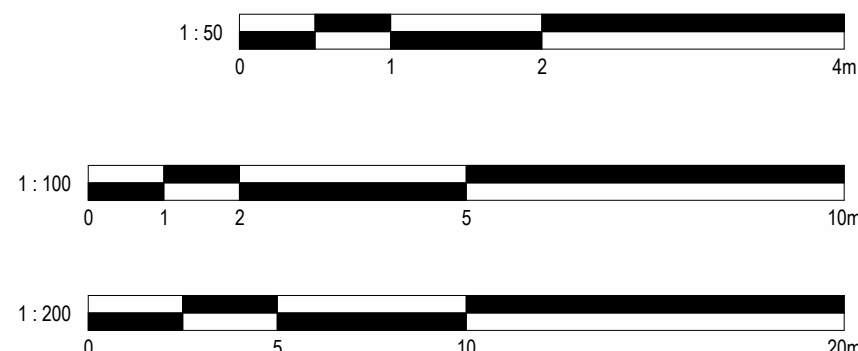

7 Site
1 : 200

4	PLANNING	10/10/2024	JB
3	PLANNING	07/10/2024	JB
2	PLANNING	24/09/2024	JB
1	Revised Plans - Site	20/08/2024	SG
No.	Description	Date	Initial

PROJECT
438a Flat A and B, Bury New Road

TITLE
As Built Plans and Elevations

STATUS
DESIGN

DRAWN BY	DATE	SCALE (@ A1)
JB	05/08/2024	As indicated

PROJECT NUMBER	DRAWING NUMBER	REV
GSS24113	002	4

GOLD SKETCH
S T U D I O S
www.goldsketch.co.uk info@goldsketch.co.uk 0161 792 9595

NOTES
© COPYRIGHT - ALL RIGHTS RESERVED.
THIS DRAWING AND ANY PARTS BEING REPRODUCED WITHOUT PRIOR WRITTEN CONSENT.
DRAWING TO BE USED FOR THE STATUS INDICATED ONLY.
ALL DIMENSIONS AND SETTING OUT SHALL BE CHECKED AND CONFIRMED ON SITE. ANY DISCREPANCIES TO BE REPORTED TO THE
ARCHITECT IMMEDIATELY. THE CONTRACTOR SHALL BE RESPONSIBLE FOR THE ACCURACY OF THE INFORMATION PROVIDED.
LEGISLATION RELEVANT CODES OF PRACTICE AND BRITISH STANDARDS. ALL DIMENSIONS ON THIS DRAWING ARE IN MILLIMETRES UNLESS
OTHERWISE STATED.