




Pic 1



Pic 2

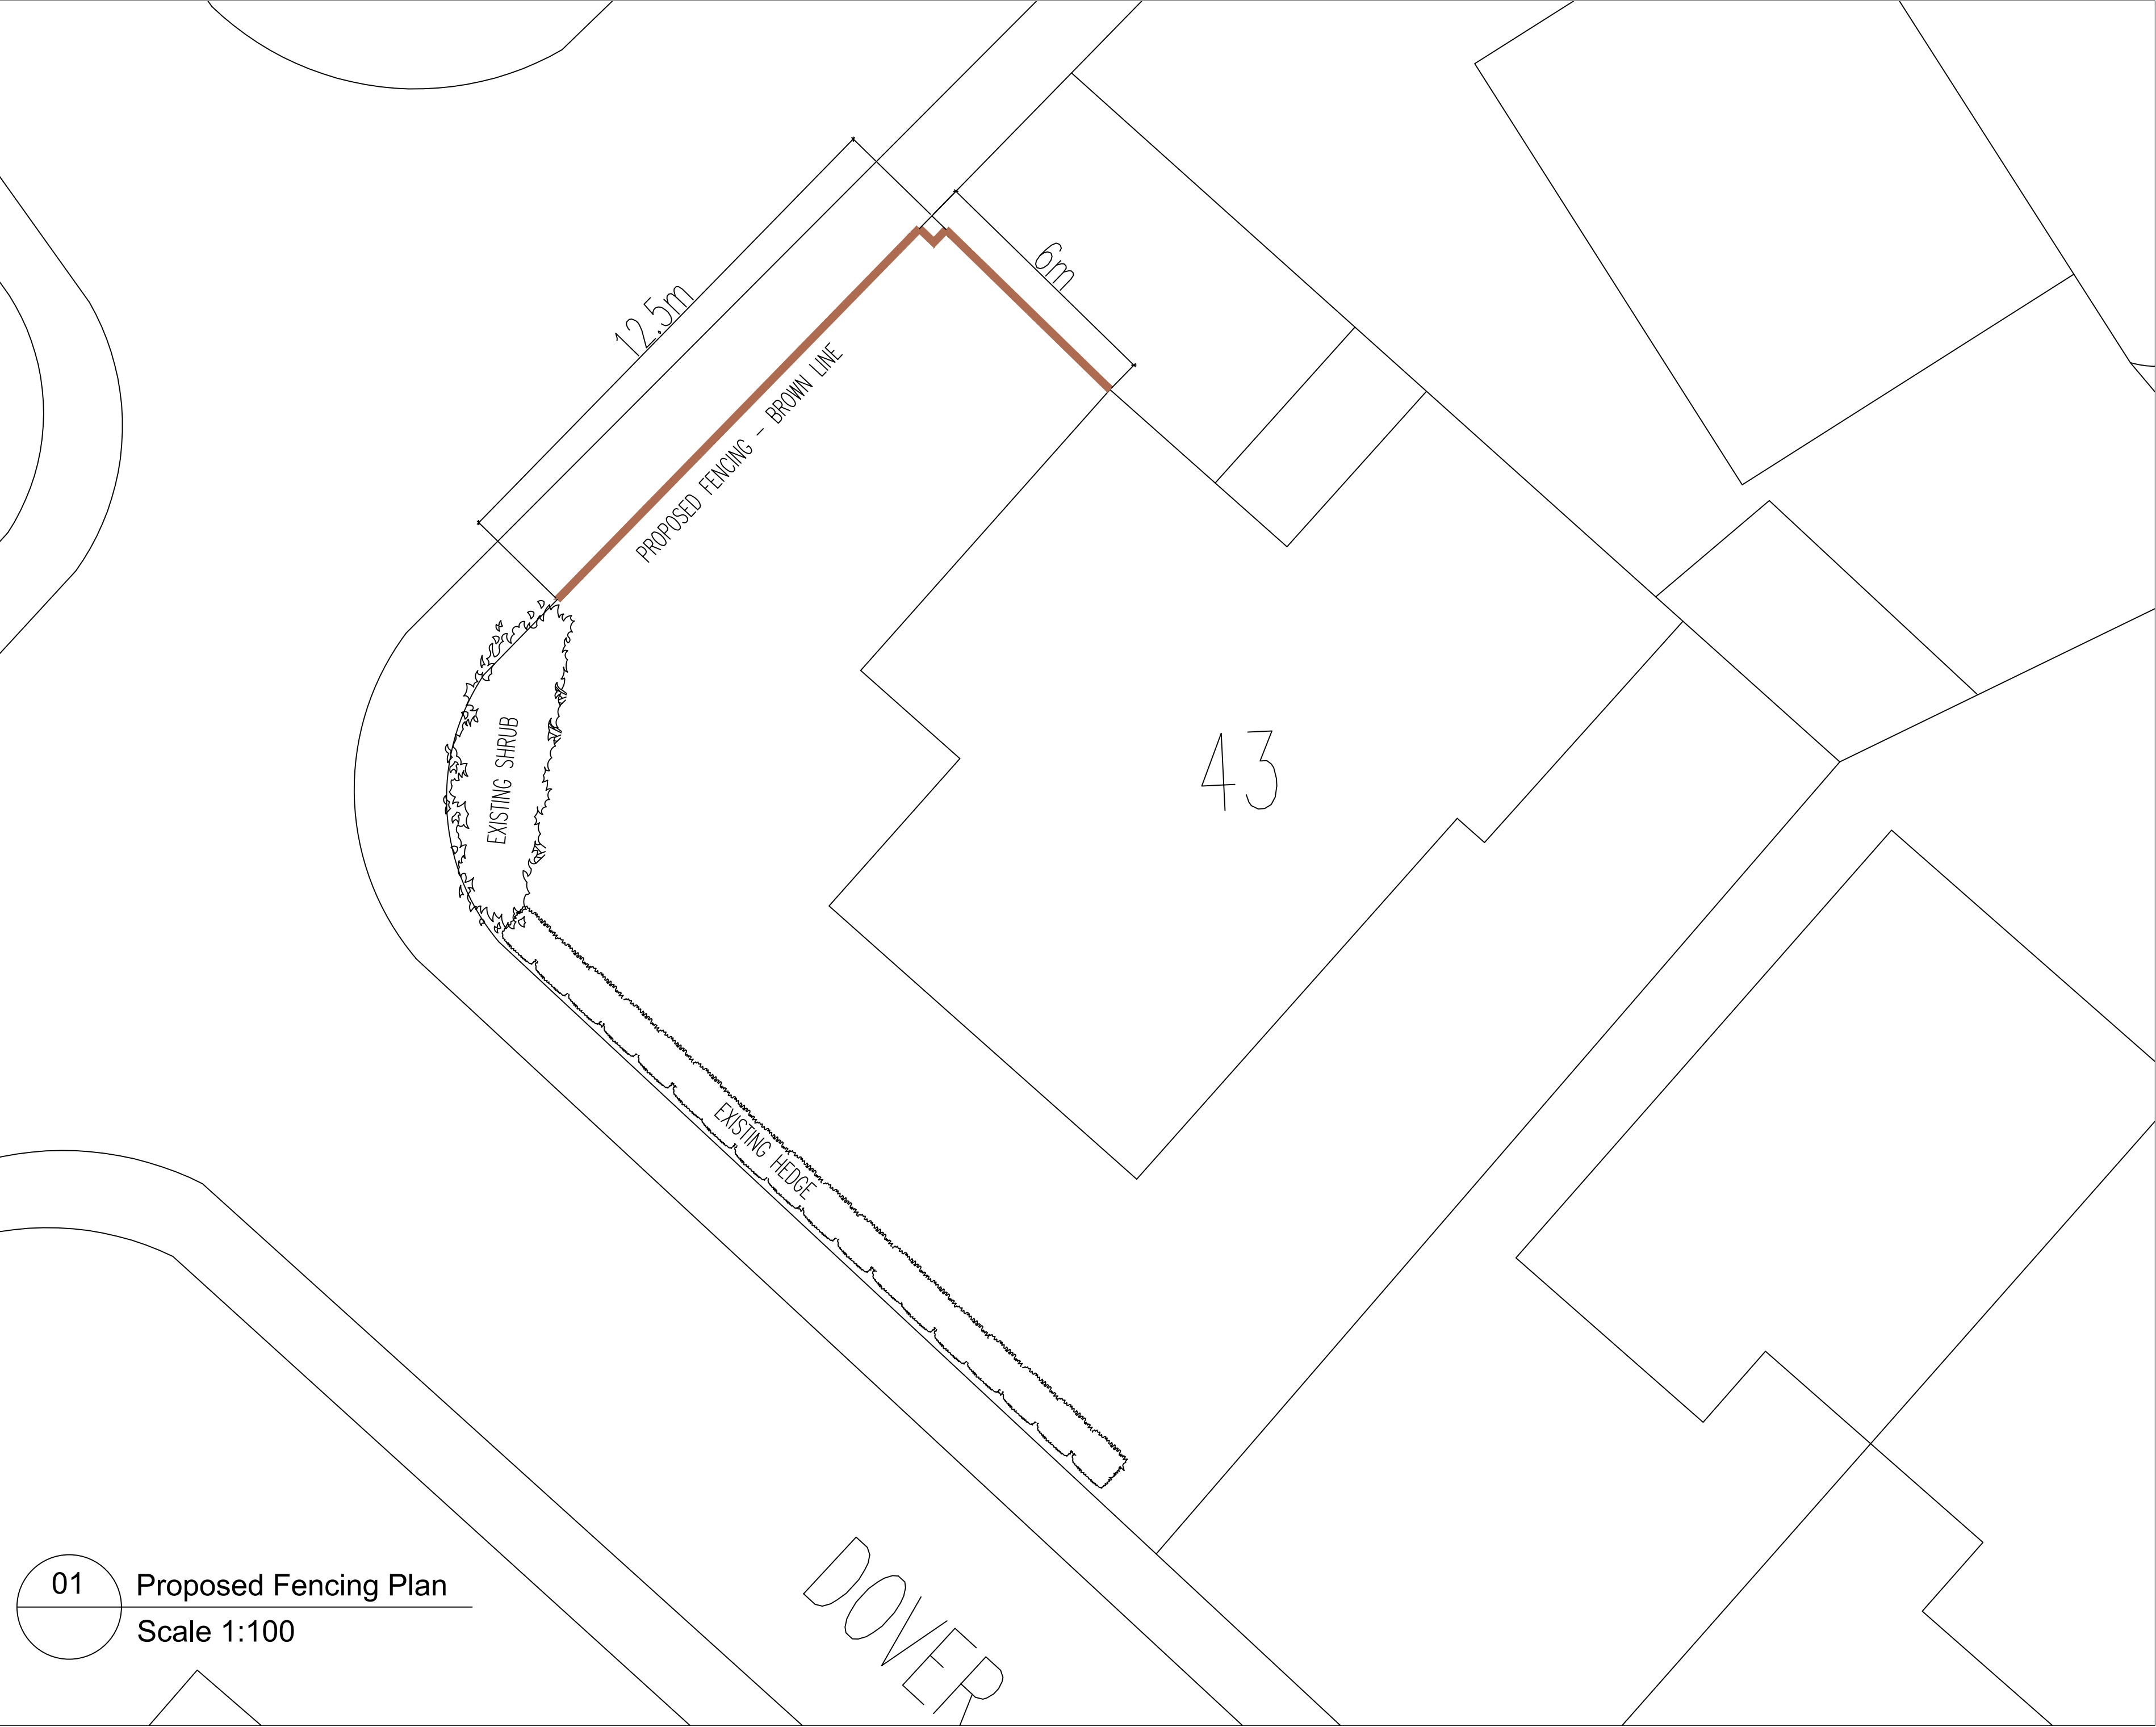

Pic 3

Photos show similar fencing heights which are within 300m of the property:
Pic 1 - Stretton Road (100m away)
Pic 2 - Caernarvon Close (10m away)
Pic 3 - Kensington Close (300m away)

The photo below is of the fencing which has been installed at 43 Vernon Road.



Notes Copyright in all documents and drawings prepared by the architectural designer and any works executed from these documents and drawings shall, unless otherwise agreed, remain the property of the designer and must not be reproduced by, lent or disclosed to, a third party without the written consent of Zach Thorp.



Do not scale off this drawing

All dimensions are to be checked on site and any discrepancies to be referred to the designer before proceeding. All levels to be checked on site All discrepancies between information shown on the drawings and the information in the specification to be referred to the designer prior to proceeding. All component sizes and references to be checked before ordering

Position of existing drain runs to be confirmed prior to proceeding and drains checked as necessary.

All relevant boundary positions are to be checked prior to proceeding

Building regulation drawings can be used for building estimates, however for an accurate quote builders must attend site as these drawings do not account for all aspects of the building works.

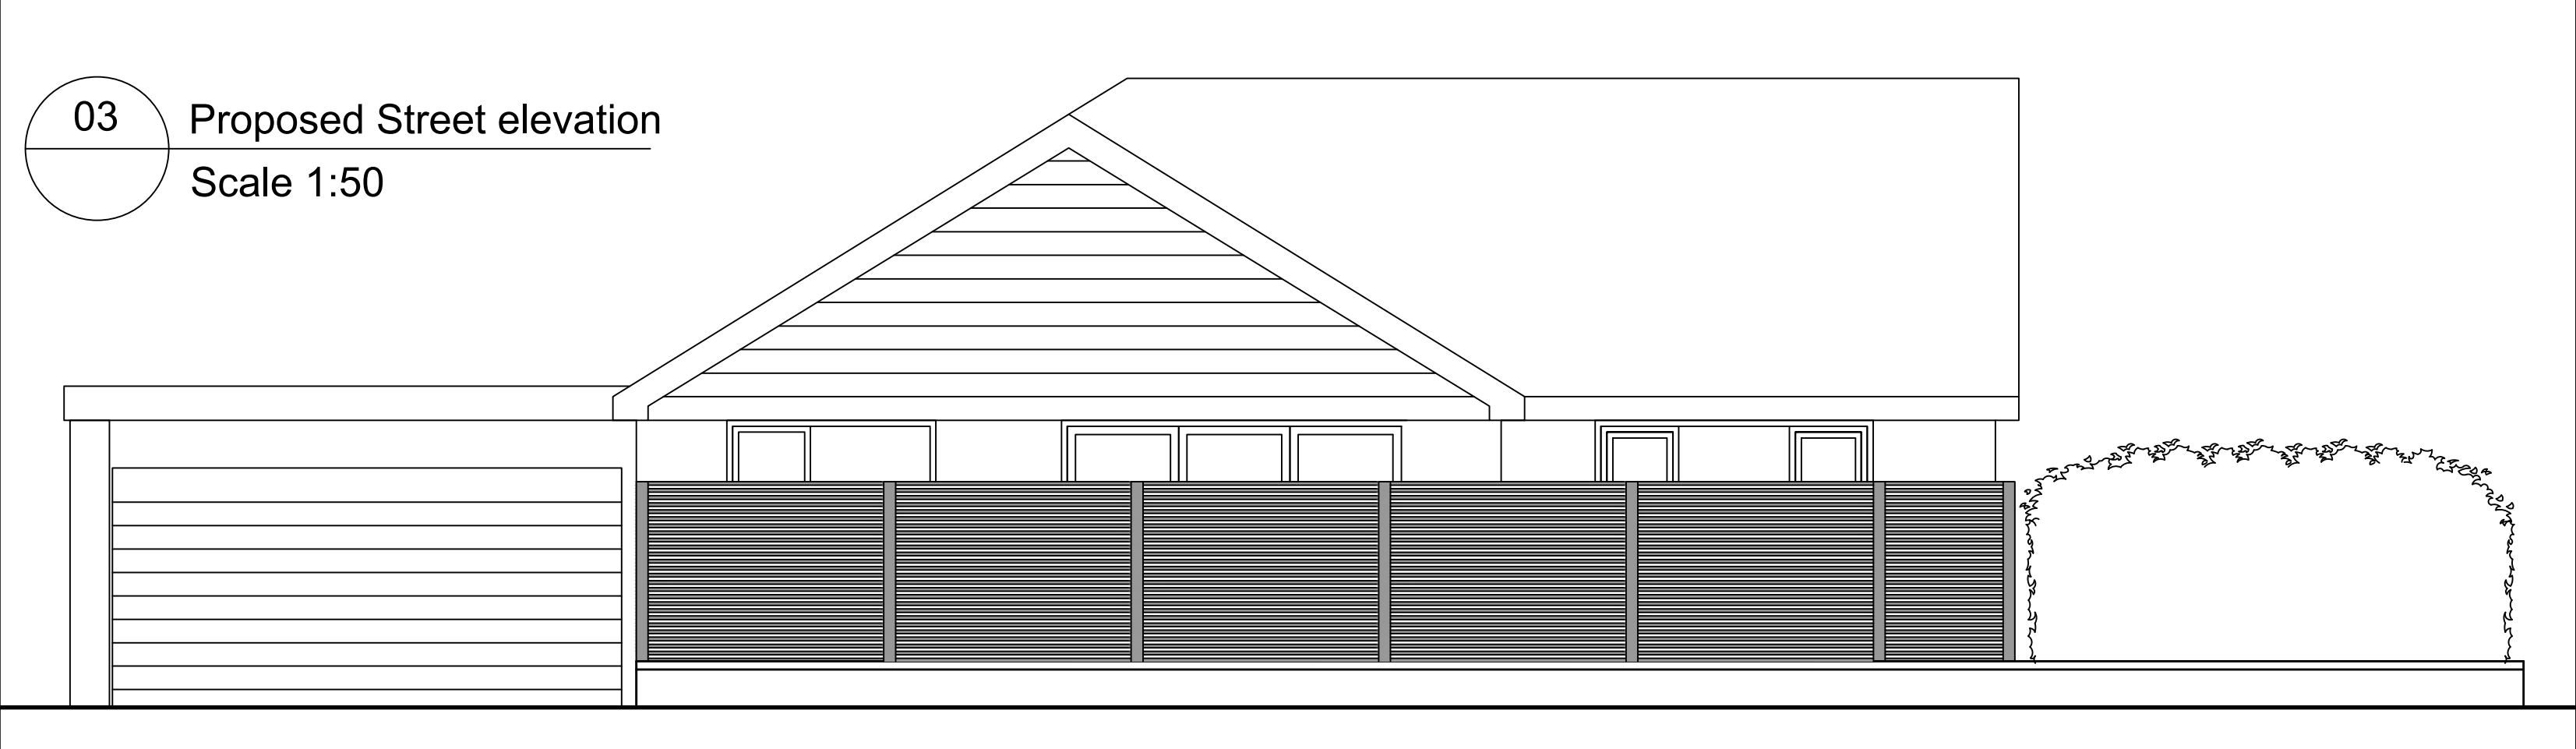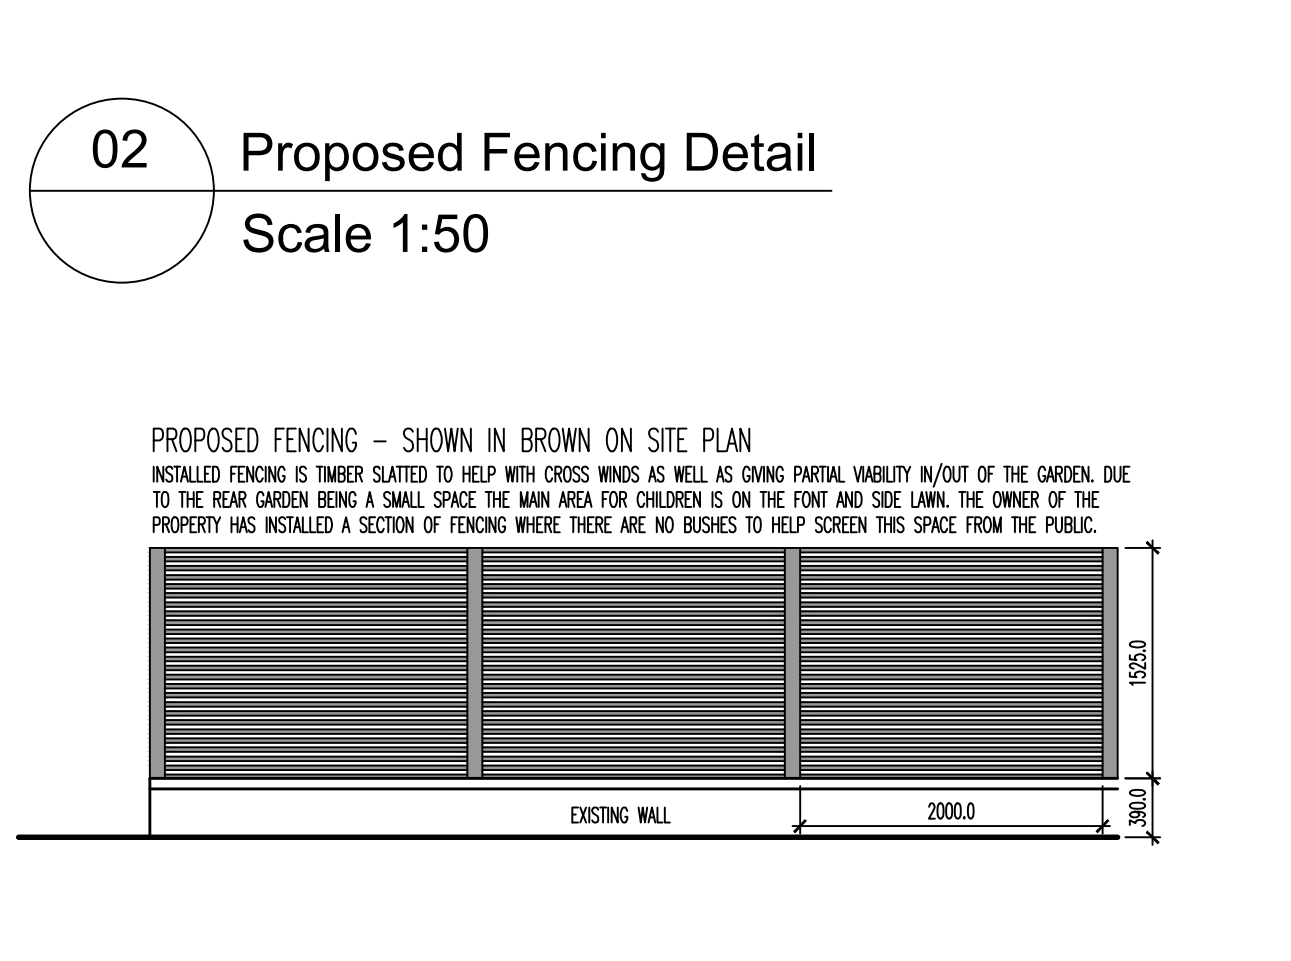

Rev	Description	Date	By	Chk
Status				
Survey		Purpose for Issue		
☐ Tender		☐		
☒ As Built		☐		
Client				
Rebecca Taylor				
43 Vernon Road, Greenmount, BL8 4DD				
Contract				
Proposed Fencing				
Drawing				
Proposed Plans and Elevations				
Drawing No. ZT22-196-06				
Scales		Revision /		
1:50		Date Feb '23		
Drawn ZTT		Checked		