



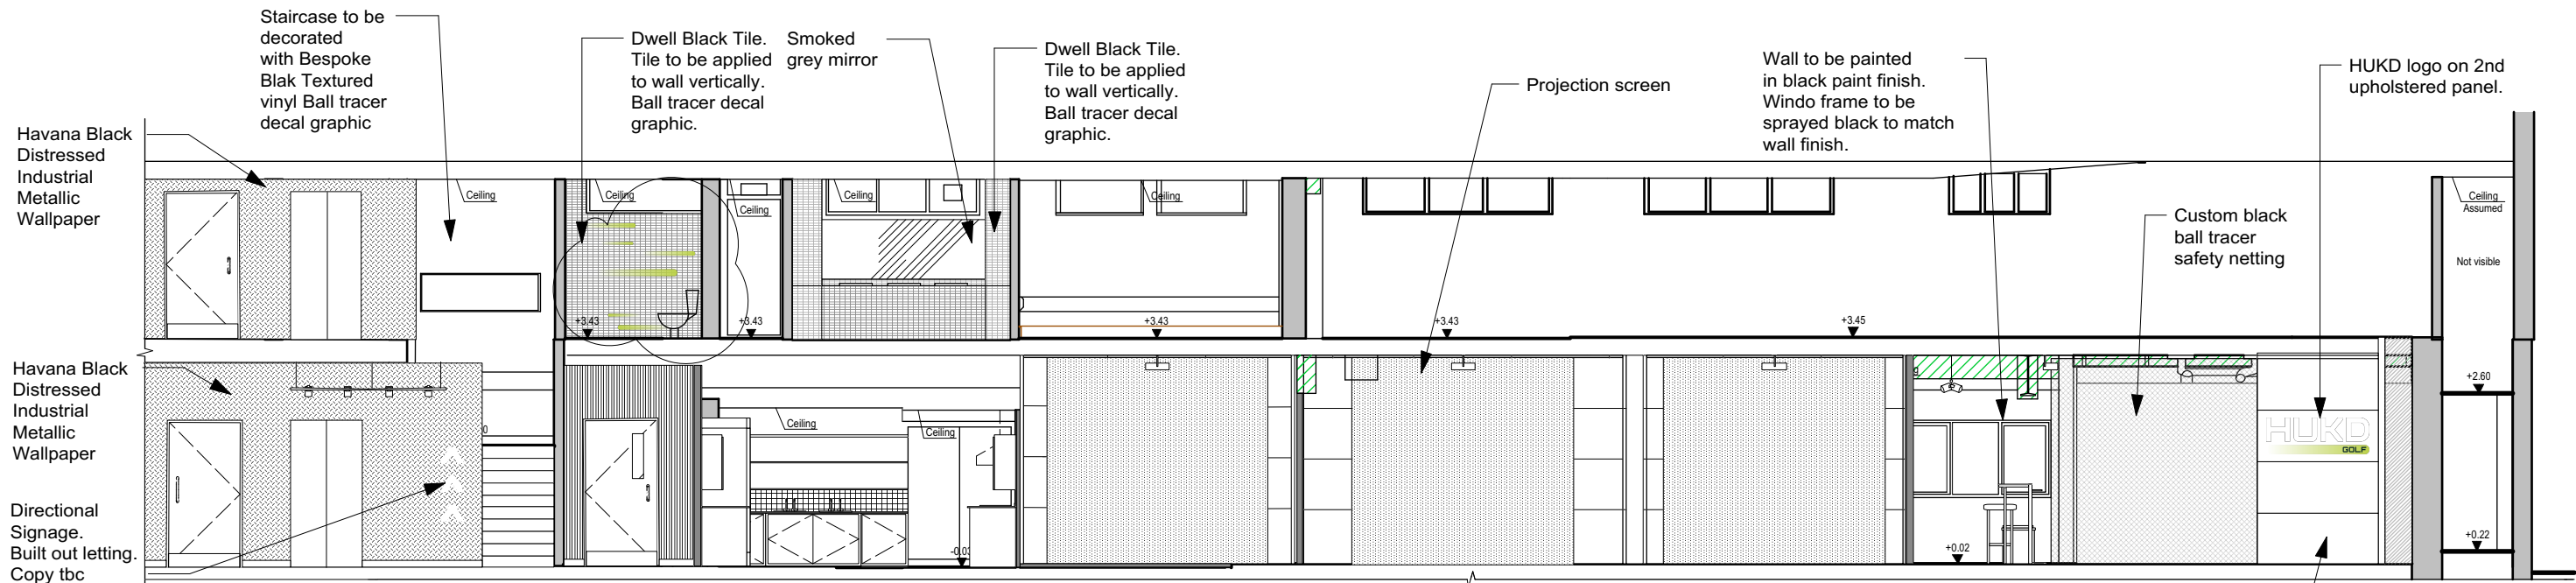

1 Proposed AA Elevation
Scale: 1:100

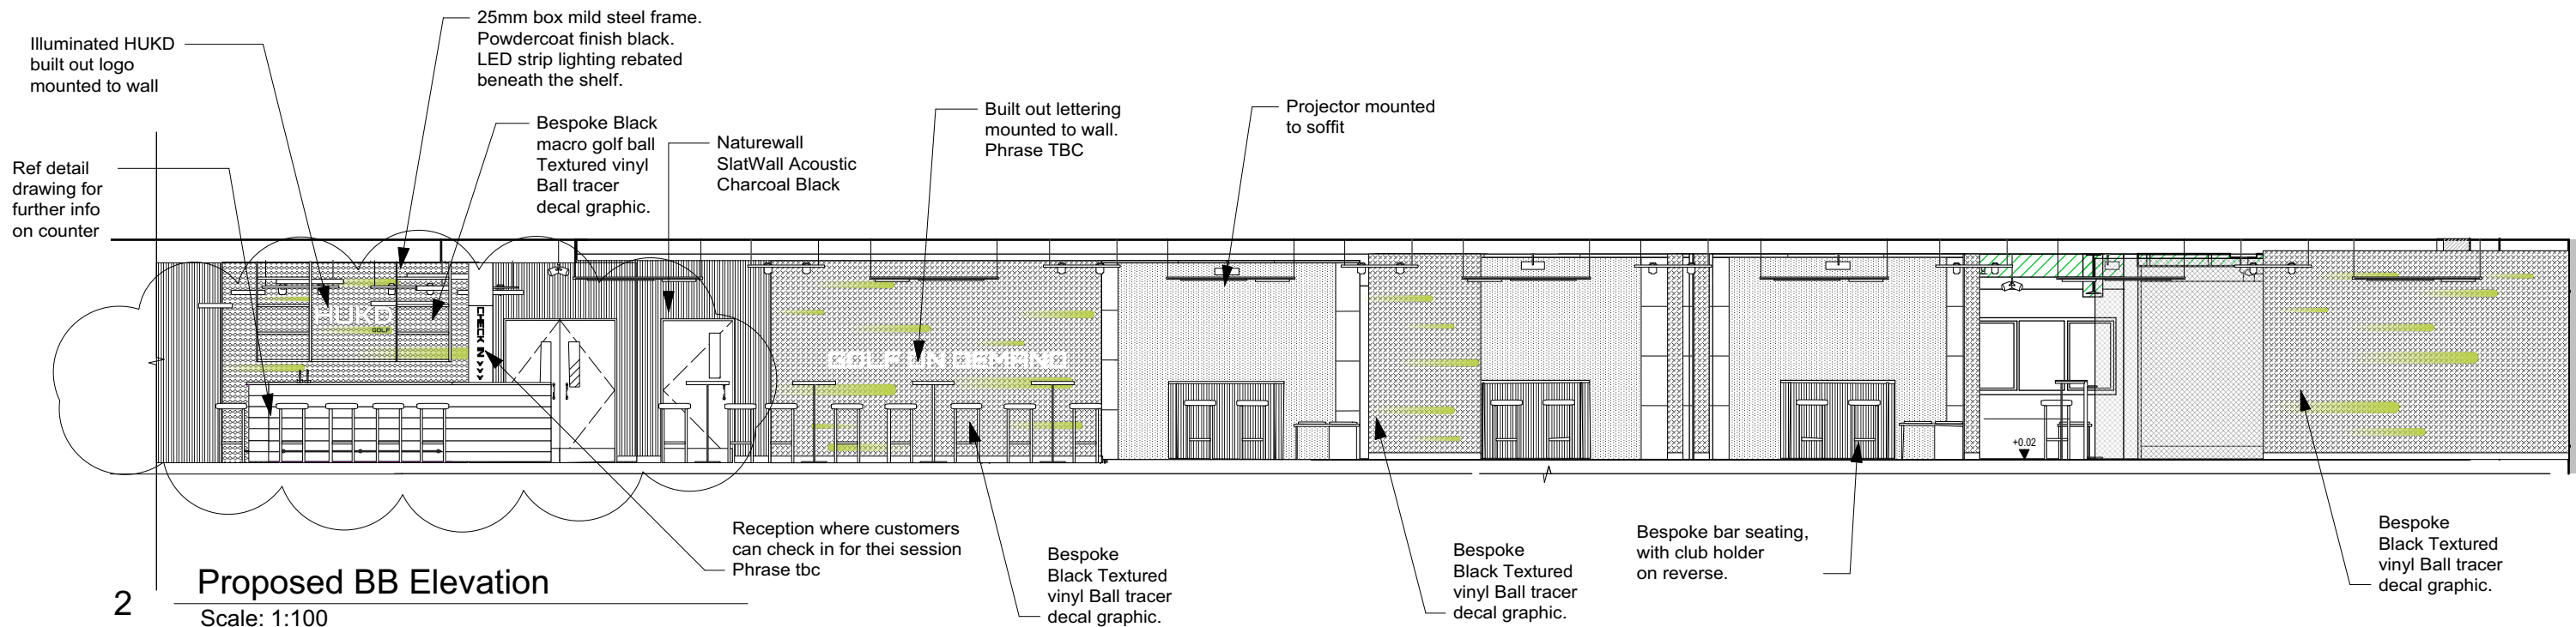

2 Proposed BB Elevation
Scale: 1:100

NOTES

1. This drawing indicates elements of the proposed sites interior and fascia" design, (where applicable)", for approval and/or tender purposes only. The Contractor shall be responsible for all quantities, locations, positions and final details of all related construction information, furniture, fittings and equipment. The Contractor shall obtain final approval from the project manager/ design team on all such constructional and working information before the work commences.

2. All indicative mechanical and electrical services are as shown on the consultant engineers' drawings and are described in the M&E Performance Specification. All construction information/drawings are to be read in conjunction with and coordinated with the principal M & E sub-contractors drawings and the consultant engineer's drawings and performance specification. Any anomalies are to be brought to the attention of the project manager/ design team before work commences.

No dimensions to be scaled from this drawing, all dimensions are to be checked by the contractor on site prior to manufacture and any discrepancies reported to the designer who will advise any necessary action.

Spread Of Flame:

All walls and ceilings to comply with minimum class 1 spread of flame and class 0 on escape routes. All partitions and lining, wallboard to be 12.5mm unless otherwise stated.

Partitions & Doors:

1/2 hr f.r partitions to comprise 70mm timber or metal studs with single layer of 12.5mm plasterboard each side. Partition to continue to underside of structural soffit where required for fire separation and to be fire stopped. 1 hr f.r partitions to comprise 70mm timber to metal studs with single layer of 15mm fireline plasterboard each side with plaster skin facing. Partition to continue to underside of structural soffit where required for fire separation and be fire stopped. 30min fire resisting doorsets to be FD30S with

automatic closer (except where door to be locked shut). Integral smoke seal, luminescent strips and signage both sides to read "fire door kept shut" or in case of an electrical cupboard "fire door keep locked". All to comply with BS9999. Vision panel to comply with part M of the building regulations.

Doors leading to off-sales area to be protected by magnetic locks with keypad operation, linked to intruder alarm with manual override function and fall safe to swing free on activation of fire alarm. All internal doors to have a minimum of 800mm clear opening.

KEY

PURPOSE OF DRAWING

☐ PRELIMINARY	☒ CONSTRUCTION
☐ INFO - ONLY	☐ PLANNING
☐ APPROVAL	☐ BUILDING REGULATIONS
☐ TENDER	☐ RECORD DRAWING

REVISIONS

19/07/22

A

PARTITION WALL ALTERATION

PROJECT HUKD_BURY

LOCATION HUKD, LINK HOUSE, 35 WALMERSLEY ROAD, BURY

TITLE PROPOSED GROUND FLOOR, ELEVATIONS A-B

DWG NO VT289_13

REV A

SCALE 1:100 @ A3

DATE 19/07/22

DWG BY VRT

CHECK BY -