



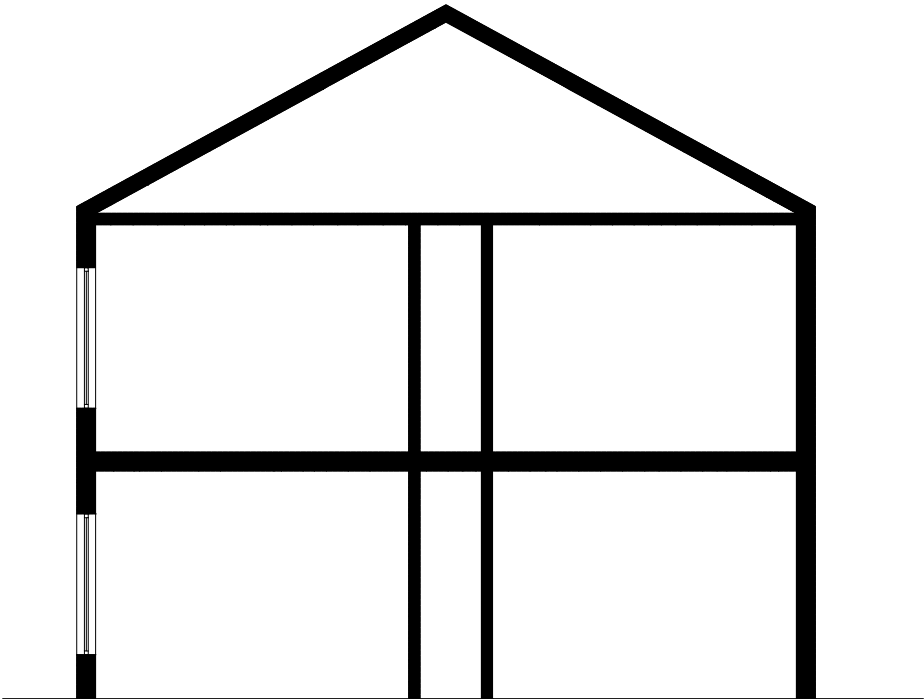

TYPICAL SECTION (BEFORE WORKS)
(scale 1/100)

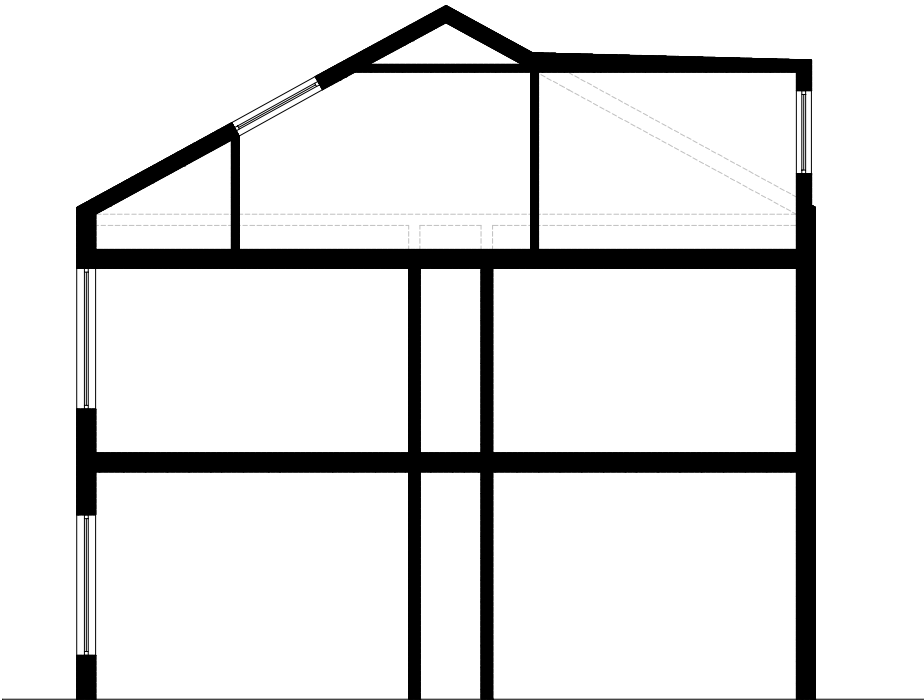

TYPICAL SECTION (AFTER WORKS)
(scale 1/100)

REVISION / DESCRIPTION	DRAWN	CHECKED	DATE	PROJECT TITLE	PROJECT NUMBER	DRAWING TITLE	SCALE	DATE	REVISION
				104 AINSCOUGH ROAD BURY BL9 OLS	20191008	ORIGINAL SECTION AND AS BUILT SECTION	1/100 @A4	29/11/22	-
- GRANT ERSKINE ARCHITECTS LTD SHALL HAVE NO RESPONSIBILITY FOR ANY USE MADE OF THIS DOCUMENT OTHER THAN FOR THAT WHICH IT WAS PREPARED AND ISSUED. - ALL DIMENSIONS SHOULD BE CHECKED ON SITE. - DO NOT SCALE FROM THIS DRAWING. - ANY DRAWING ERRORS OR DIVERGENCES SHOULD BE BROUGHT TO THE ATTENTION OF GRANT ERSKINE ARCHITECTS LTD AT THE ADDRESS SHOWN BELOW.				DRAWING No. (20)A004					

GRANT
ERSKINE
ARCHITECTS

Suite 5, 3rd Floor
61 Mosley Street
Manchester
M2 3HZ

07974 099796
0161 236 9761

gpe@granterskinearchitects.com
www.granterskinearchitects.com

Grant Erskine Architects Limited Reg. No. 07477118