



- Existing prepared substrate
- Adhesive insulation panel 90 MM
- Reinforced coat with glassfibre mesh
- Silicone Finish Render
- Paint Coat

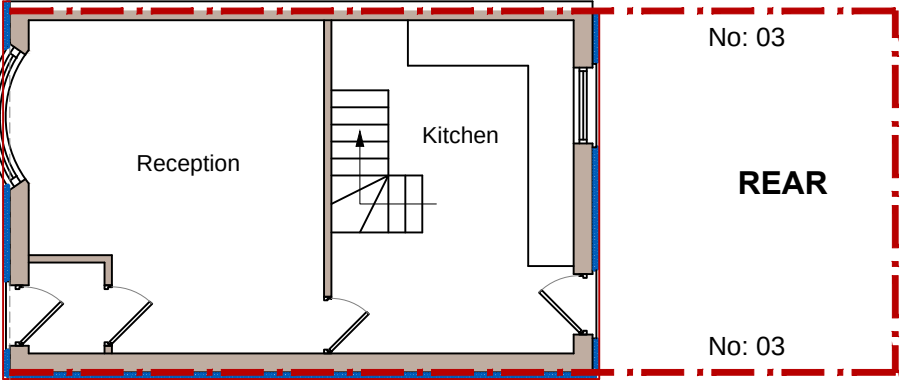

AS BUILT GROUND FLOOR PLAN

STATTER

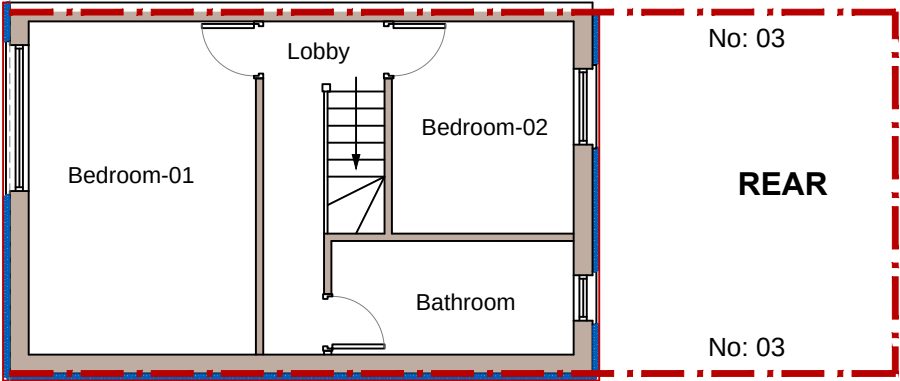

AS BUILT FIRST FLOOR PLAN

			CLIENT IZ ENERGY	PROJECT 03 STATTER STREET BURY BL9 8AZ	SCALE 1:100@A3	DRAWING NO.	REV.	AARKZ Design Associates		
					DATE JUN 22	DRAWN WN	03			
					DRAWING TITLE AS BUILT PLANS				012345 Meters @ 1:100 @ A3	
REV	DATE	NOTES								
186 FOREST ROAD, LOUGHTON, IG10 1EG TEL: 0750 645 9645 Email: Info@Aarkzdesign.co.uk WWW.AARKZDESIGN.CO.UK										