
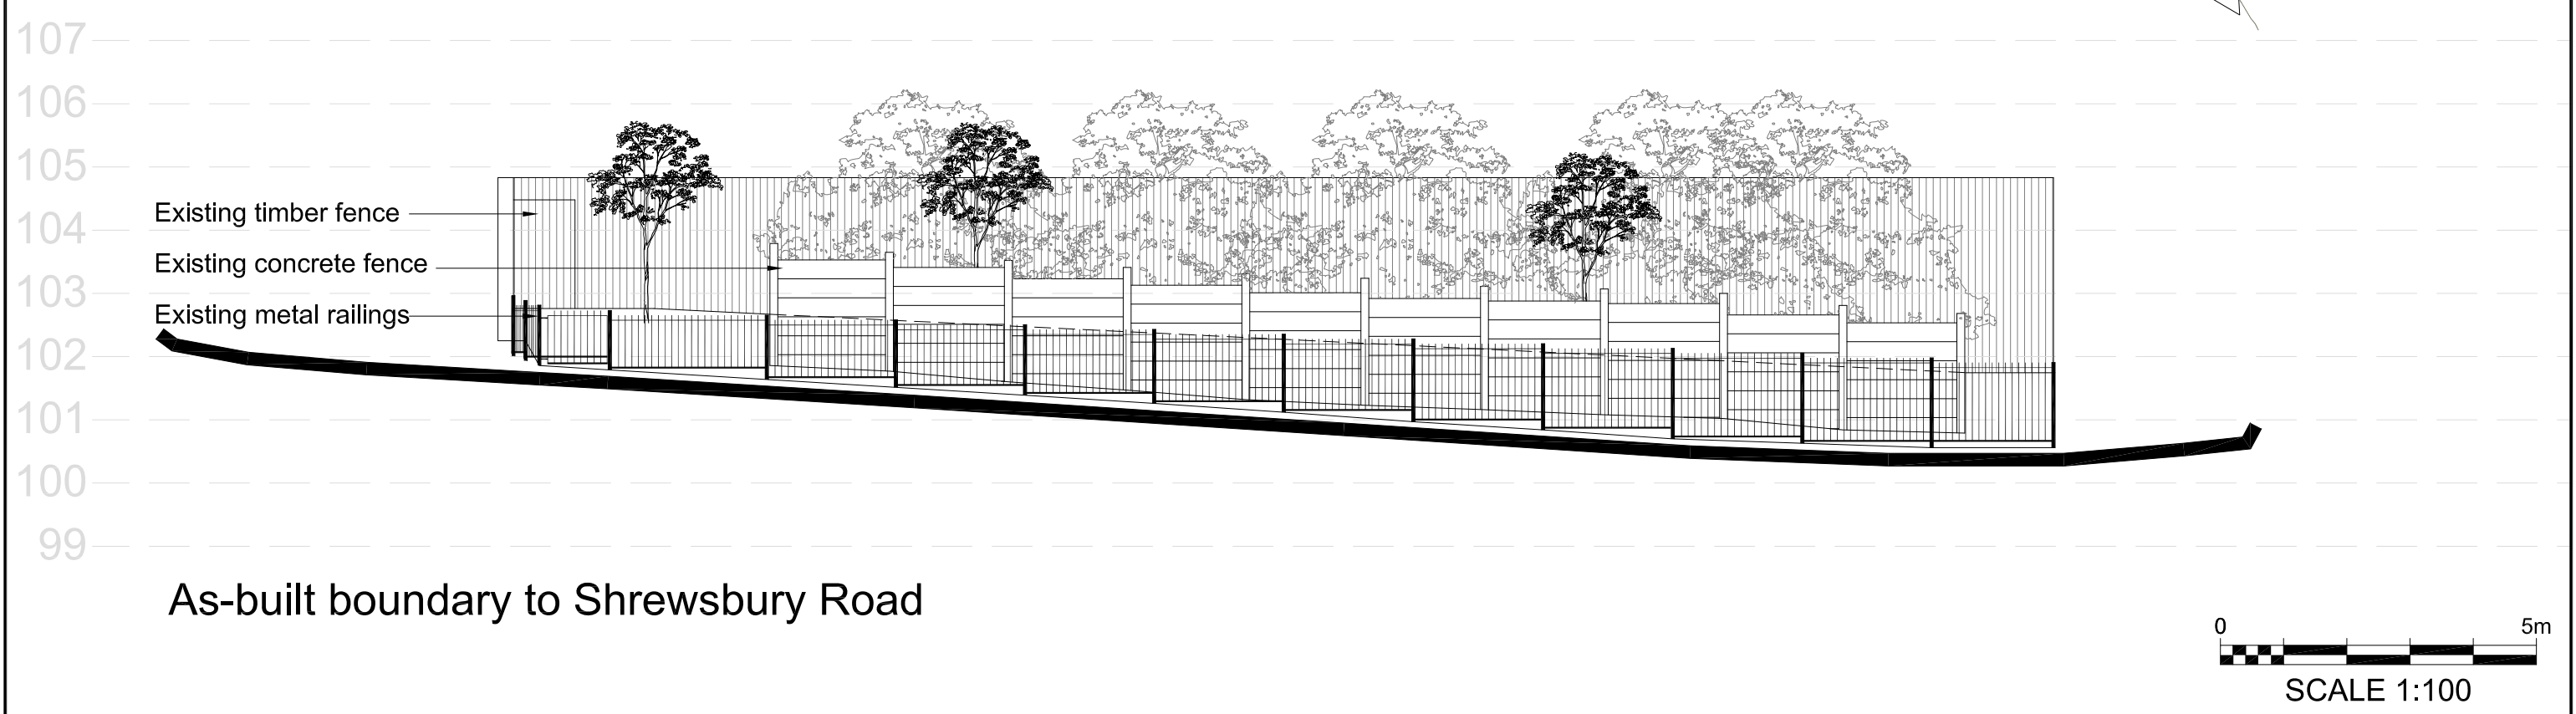


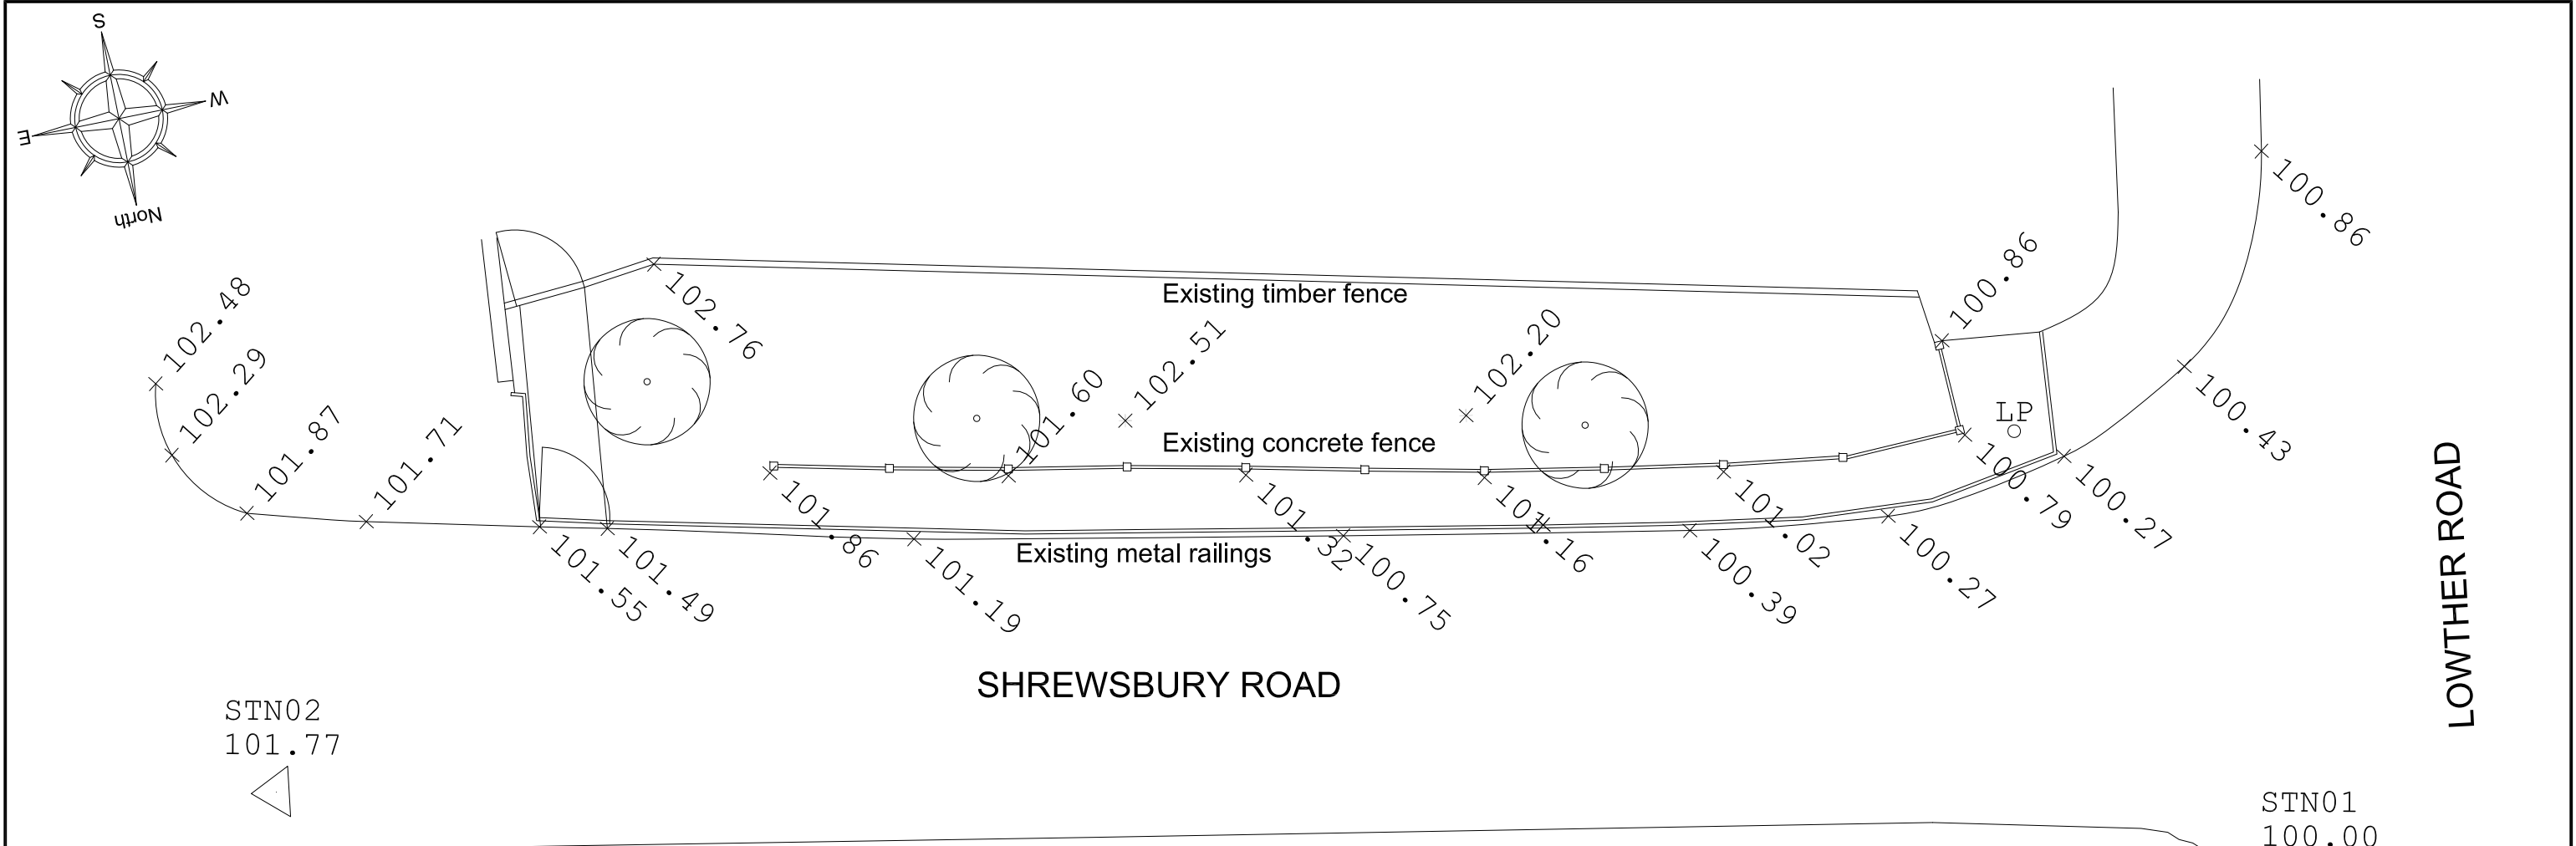

				 HOWARD & SEDDON A.R.I.B.A. CHARTERED ARCHITECTS 64 WASHWAY ROAD SALE, CHESHIRE, M33 7RE TEL NO. 0161 - 973 8296 FAX NO. 0161 - 962 3485 E-MAIL : ADMIN@HOWARDANDEDSON.CO.UK	PROJECT	SHREWSBURY HOUSE LOWTHER ROAD, PRESTWICH MANCHESTER, M25 9QG	TITLE	AS-BUILT BOUNDARY DETAILS	DRAWN RW	13,767/30	
					DATE 14.07.20						
A	FIRST ISSUE	RW	14.07.20		CLIENT		MR ANTHONY JACOBS		SCALE 1:100 (A3)	AMENDMENT A	
REV	DESCRIPTION	BY	DATE								